

# *P & I Design Ltd*

Process Instrumentation Consultancy & Design

2 Reed Street, Gladstone Industrial Estate,  
Thornaby, TS17 7AF, United Kingdom.  
Tel. +44 (0)1642 617444 Fax. +44 (0)1642 616447  
Web Site: www.pidesign.co.uk

## **INTER TERMINALS IMMINGHAM LTD**

### **EAST TERMINAL**

### **4 EAST RAIL LOADING I/E**

### **DOCUMENTATION MANUAL**

<b>Rev</b>	<b>Date</b>	<b>By</b>	<b>Checked</b>	<b>Approved</b>	<b>Description</b>	<b>Client Ref.</b>
A	15.04.99	D.Smith	DRR	DRR	Original Issue	
B	26.07.99	D.Smith	DRR	DRR	As Built	
C	26.04.11	D.B.Faulkner	MM	MM	Mabanaft Modifications (SI760)	
D	06.12.11	D. Smith	MM	MM	General Update	Document No. <b>SI039001_MNL</b>
E	24.01.17	D. Smith	MM	MM	GOMC Batching System Update	
F	12.06.17	D. Smith	MM	MM	Control Panel Layout Update	

*IF NOT SIGNED THIS DOCUMENT IS UNCONTROLLED*

## Contents

1. Reports
2. Specifications
3. Drawings and Schedules
4. Installation, Testing & Handover
  - 4.1 Installation & Testing Procedures
  - 4.2 Calibration & Test Certificates
  - 4.3 Handover Certificates
5. Manufacturers' Documentation
  - 5.1 RGS
  - 5.2 Endress & Hauser



## Register Control System

<u>Register No</u>	<u>Description</u>	<u>Issue</u>
SI039001_RGD	Drawing Register	E
SI039000_SPC	Specification Register	B
SI039001_REG	Report Register	C
SI039002_REG	PICAL Register	A



**CLIENT:**  
Inter Terminals Immingham Ltd  
East Terminal

REV	DATE	BY	CHKD	APPD
A	15.4.99	AJH	DRR	DRR
B	06.07.99	AJH	DRR	DRR
C	06.12.11	DS	MM	MM
D	24.01.17	MM	PP	MM
E	12.06.17	DS	MM	MM

**CLIENT REF.**  
4 East Rail Loading  
**P & I REF.**  
SI039001\_RGD  
**SHT 1 OF 1**

DRAWING NO	REV	DESCRIPTION
------------	-----	-------------

**Drawings**

SI039001_DWG	F	4 East Rail Loading System Cable Overview
SI039002_DWG	F	4 East Rail Loading System Logic Drawing 1 (001 to 120)
SI039003_DWG	C	4 East Rail Loading System Logic Drawing 2 (121 to 240)
SI039004_DWG	C	4 East Rail Loading System Logic Drawing 3 (241 to 360)
SI039005_DWG	C	4 East Rail Loading System Logic Drawing 4 (361 to 480)
SI039006_DWG	C	4 East Rail Loading System Logic Drawing 5 (481 to 600)
SI039007_DWG	D	4 East Rail Loading System Logic Drawing 6 (601 to 720)
SI039008_DWG	D	4 East Rail Loading System Logic Drawing 7 (721 to 840)
SI039009_DWG	C	4E Rail Loading Offloading Pump 1 MCC Wiring
SI039012_DWG	F	4E Rail Loading MUX 1 & 2 Panel Loop Sheet
SI039013_DWG	F	4E Rail Loading MUX 3 & 4 Panel Loop Sheet
SI039014_DWG	E	4E Rail Loading Danload to PC Comms Diagram
SI039015_DWG	B	4E Rail Loading Mercury Keypad Comms Diagram
SI039016_DWG	F	4E Rail Loading Control Panel Layout
SI039017_DWG	A	Pump Local JB Terminal Arrangement
SI039018_DWG	A	DC Junction Box Layout
SI039019_DWG	A	AC Junction Box Layout
SI039020_DWG	D	Operators Control Panel Layout
SI039022_DWG	B	4 East Rail Loading System Logic Drawing 8 (841 to 960)
SI478006_DWG	I	P2-25 Pump MCC Diagram
SI760001_DWG	E	4E Rail Loading System – P2-25 JB Interconnection Details
SI760002_DWG	B	4E Rail Loading System – P5-12 JB Interconnection Details
SI760005_DWG	B	4E Rail Loading System – Tank 601, 602 & 603 Valve Loop Sheet

**Schedules**

SI039100_SCH	E	4 East Rail Loading Cable Schedule
SI760001_SCH	A	4E Rail Loading Cable Schedule
SI760002_SCH	A	600 Series ROSOVs Cable Schedule
SI760100_SCH	B	4E Rail Loading trip Matrix

***P & I Design Ltd.***

**CLIENT:**  
 Immingham Storgae Co Ltd  
 ISCo East Terminal

***Instrument Specification Register***

<b>ISSUE</b>	<b>DATE</b>	<b>BY</b>	<b>CHKD</b>	<b>APPD</b>	<b>CLIENT REF.</b>
A	09.04.99	AJH	DRR	DRR	4 East Rail Loading
B	25.04.11	DBF	MM	MM	<b>P &amp; I REF.</b> SI039000_SPC SHT 1 OF 2

<b>P&amp;I REF.</b>	<b>REVISION</b>					<b>SUPPLIER</b>	<b>TAG No.</b>	<b>ITEM</b>
	<b>ISSUE 0</b>	<b>A</b>	<b>B</b>	<b>C</b>	<b>D</b>			
SI039001_SPC		B				CEAG	N/A	Isolators
SI039002_SPC		A				Allen West	N/A	Loading Pump Stop/Start
SI039004_SPC		B				CEAG	N/A	Control Panel
SI039005_SPC		A				Allen West	N/A	ESD
SI039006_SPC		A				RS	N/A	Alarm Sounder
SI039007_SPC		A				J Hemy Systems	N/A	Junction Box
SI039008_SPC		A				J Hemy Systems	N/A	Junction Box
SI039009_SPC		A				RGS	XSV1	Actuator
SI039009_SPC		A				RGS	XSV2	Actuator
SI039009_SPC		A				RGS	XSV3	Actuator
SI039009_SPC		A				RGS	XSV4	Actuator
SI039009_SPC		A				RGS	XSV5	Actuator
SI039009_SPC		A				RGS	XSV6	Actuator
SI039009_SPC		A				RGS	XSV7	Actuator
SI039009_SPC		A				RGS	XSV8	Actuator
SI039009_SPC		A				RGS	XSV9	Actuator
SI039009_SPC		A				RGS	XSV10	Actuator
SI039009_SPC		A				RGS	XSV11	Actuator
SI039009_SPC		A				RGS	XSV12	Actuator
SI039010_SPC		A				Bartec	N/A	MUX Panel Heater
SI039011_SPC		A				Coutant Lambda	N/A	Power Supply
SI039012_SPC		A				MTL	N/A	MUX
SI039013_SPC		A				Mitsubishi	N/A	Main Processor
SI039014_SPC		B				CEAG	N/A	Isolator
SI039015_SPC		A				Armah	N/A	Control Panel
SI039016_SPC		A				Armah	N/A	Control Panel
SI039017_SPC		A				J Hemy Systems	N/A	Enclosure
SI760001_SPC		A				Endress & Hauser		LS2-25 P5-25 Low Suction Level Switch
SI760002_SPC		B				RGS	XSV1	Gantry North Siding Loading Point 1 Solenoid

***P & I Design Ltd.***

***Instrument Specification Register***

**CLIENT:**

Immingham Storgae Co Ltd  
ISCo East Terminal

ISSUE	DATE	BY	CHKD	APPD	CLIENT REF.
A	09.04.99	AJH	DRR	DRR	4 East Rail Loading
B	25.04.11	DBF	MM	MM	<b>P &amp; I REF.</b> SI039000_SPC SHT 2 OF 2

P&I REF.	REVISION					SUPPLIER	TAG No.	ITEM
	ISSUE 0	A	B	C	D			
SI760002_SPC			B			RGS	XSV2	Gantry North Siding Loading Point 2 Solenoid
SI760002_SPC			B			RGS	XSV3	Gantry North Siding Loading Point 3 Solenoid
SI760002_SPC			B			RGS	XSV4	Gantry North Siding Loading Point 4 Solenoid
SI760002_SPC			B			RGS	XSV5	Gantry North Siding Loading Point 5 Solenoid
SI760002_SPC			B			RGS	XSV6	Gantry North Siding Loading Point 6 Solenoid
SI760002_SPC			B			RGS	XSV7	Gantry South Siding Loading Point 7 Solenoid
SI760002_SPC			B			RGS	XSV8	Gantry South Siding Loading Point 8 Solenoid
SI760002_SPC			B			RGS	XSV9	Gantry South Siding Loading Point 9 Solenoid
SI760002_SPC			B			RGS	XSV10	Gantry South Siding Loading Point 10 Solenoid
SI760002_SPC			B			RGS	XSV11	Gantry South Siding Loading Point 11 Solenoid
SI760002_SPC			B			RGS	XSV12	Gantry South Siding Loading Point 12 Solenoid
SI760002_SPC			B			RGS	XSVESD	Gantry ESD Solenoid

**CLIENT:**

Immingham Storage Co Ltd  
ISCo East Terminal

ISSUE	DATE	BY	CHKD	APPD	CLIENT REF.
A	09.04.99	AJH	DRR	DRR	4 East Rail Loading
B	06.07.99	AJH	DRR	DRR	<b>P &amp; I REF.</b>
C	26.04.11	DBF	MM	MM	SI039001_REG <b>SHT 1 OF 1</b>

REPORT NO	REVISION					DATE	DESCRIPTION
	ISSUE	0	A	B	C		
SI760001_RPT			B			08.09.10	4 East Rail Loading Modifications User Requirement Specification
SI760001_INS			A			30.09.10	4 East Rail Loading Modifications Installation Specification
SI760002_INS			A			02.12.10	600 Series ROSOVs Installation Specification

**CLIENT:**  
Immingham Storage Co Ltd  
ISCo East Terminal

<b>REV</b>	<b>DATE</b>	<b>BY</b>	<b>CHKD</b>	<b>APPD</b>	<b>CLIENT REF.</b>
A	24.12.10	DBF	MM	MM	4 East Rail Loading

**P & I REF.**  
SI039002\_REG  
**SHT 1 OF 1**

<u><b>Cert No.</b></u>	<u><b>Tag. No.</b></u>	<u><b>Instrument Type</b></u>	<u><b>Service</b></u>
LS2-25-0	LS2-25	Dry Run Protection	Pump P2-25 Protection



# *P & I Design Ltd*

Process Instrumentation Consultancy & Design

2 Reed Street, Gladstone Industrial Estate,  
Thornaby, TS17 7AF, United Kingdom.  
Tel. +44 (0) 1642 617444 Fax. +44 (0) 1642 616447  
Web Site: www.pidesign.co.uk

## **IMMINGHAM STORAGE LTD**

### **EAST TERMINAL**

#### **4 EAST RAIL LOADING MODIFICATIONS**

#### **INSTRUMENT/ELECTRICAL CONTROL SYSTEM**

#### **USER REQUIREMENT SPECIFICATION**

<b>Rev</b>	<b>Date</b>	<b>By</b>	<b>Checked</b>	<b>Approved</b>	<b>Description</b>	<b>Client Ref.</b>
A	19.08.10	D.B.Faulkner	MM	MM	Issued for Comments (P0100001_RPT_A)	<b>Document No. SI760001_RPT</b>
B	08.09.10	D.B.Faulkner	MM	MM	Client Comments Incorporated	
						<b>Page 1 of 6</b>

*IF NOT SIGNED THIS DOCUMENT IS UNCONTROLLED*

## Contents

1	INTRODUCTION.....	3
2	INSTRUMENTATION AND CONTROL.....	3
2.1	Valves.....	3
2.2	Pumps.....	4
2.3	Interfaces.....	5

## Revision History

- A Original issue as P0100001\_RPT\_A - 4 East Rail Loading System Modifications User Requirement Specification.
  
- B Client comments incorporated following site meeting 02.09.10 to review P0100001\_RPT\_A - 4 East Rail Loading System Modifications User Requirement Specification.



## 1 INTRODUCTION

This report details the user requirement specification for the instrument / electrical control system modifications to the 4 East rail loading system located in the 4 East area at Immingham Storage Company's East Terminal.

The tanks within the scope of this project are

- Arcton tanks T615, T616 and T618
- 'Bund R tanks T601, T602 and T603

There will be 12 individually operable loading points covering the following systems

- 6 off 4 East rail loading north side
- 6 off 4 East rail loading south side

This report should be read in conjunction with SI760100\_SCH - 4 East rail Loading Trip Matrix

## 2 INSTRUMENTATION AND CONTROL

The facility will be provided for each 4 East rail loading point to be operated from the gantry top. The system will be designed as a two man operation. No batching system or flowmeter will be provided; rail loading will be to mechanical dip only. It will be possible to simultaneously load multiple rail cars on each siding.

### 2.1 Valves

The loading actuated valves will be air to open, fail safe closed (spring return). Operation of an open/close selector switch from the gantry top will open and close the associated valve. Position feedback of the valve will be indicated by a local beacon mounted on the actuator. 4 East rail Loading ESD, site fire alarm, 4 East ESD or high level in any 4 East rail tanker will close all loading valves unconditionally.

**NOTE** - Following 4 East rail loading ESD, site fire alarm, 4 East ESD or high level in any 4 East rail tanker a reset (once systems healthy) will be required from the gantry control panel, 4 East rail loading actuated valves selected to open will automatically reopen.

An additional actuated common ESD valve will be located upstream of all loading points. The actuated ESD valve will be air to open, fail safe closed (spring return). Operation of an open/close selector switch local to the valve will open and close the ESD valve. Position feedback of the valve will be indicated by a local beacon mounted on the actuator. 4 East rail loading ESD, site fire alarm, 4 East ESD or high level in any 4 East rail tanker will close the ESD valve unconditionally. This valve is intended to be left open under normal operation and will exercise on weekly site fire alarm system testing.

No provision will be provided at 4 East rail gantry to operate delivery tank automated export valves on tanks 601, 602, 603, 615, 616 and 618. The export valve system will have no interface with 4 East rail loading.



## 2.2 Pumps

4 East rail loading pumps will be provided in bund R and the Arcton pump raft. P2-25 will deliver from bund R tanks 601, 602 and 603, P5-12 will deliver from Arcton tanks 615, 616 and 618. Each pump will be operated manually from the 4 East rail gantry. Start, stop and running indication will be provided on the gantry top via 3 control stations, one each at the buffer end, centre and the far end of the gantry. The pumps will be protected from low suction and high discharge temperature. P2-25 pump will be tripped by the 2 East ESD, 4 East ESD, site fire alarm system, 4 East rail loading ESD system or any 4 East rail car high level.

P5-12 pump is dual purpose, the pump can be selected to “4 East Rail Loading” or “Stripping” duty at the MCC compartment located in No.5 switchroom. In the “4 East Rail Loading” duty the start, stop and running indications located at the 4 East rail gantry will be active and the local and MCC start disabled, the pump will be tripped by the 2 East ESD, 4 East ESD, site fire alarm system, 4 East rail loading ESD system or any 4 East rail car high level. In “Stripping” duty the 4 East rail gantry start, stop and running indication will be disabled and the local start and MCC start will be active, the pump will be tripped by the 2 East ESD or site fire alarm system. The 4 East ESD, 4 East rail loading ESD and 4 East rail car high levels will not be active in “stripping” duty. The local stop and MCC stop will be active in both modes.

**NOTE** – Physical pipe routing will prevent P5-12 delivering to the 4 East rail gantry whilst selected to “stripping”, however if the pump is physically lined up to 4 East rail gantry and selected to “stripping” it will start by operation of the local and MCC start pushbuttons, but be unable to be stopped at the 4 East rail gantry. Operational procedures and labelling will be put in place to prevent this.

No control system interlocking of the delivery pumps to prevent both running simultaneously will be provided.

P5-13 sump pump will be provided in the Arcton pump raft. The pump will be manually started and stop automatically on low level being detected or manual stop. The pump will be protected from high discharge temperature. No provision to start the pump from outside the pump raft will be provided. The pump will not be interlocked with the ESD system or the site fire alarm system.



## 2.3 Interfaces

The 4 East rail loading system will have the following interfaces.

### 4 East RAIL LOADING GANTRY

**Gantry Local** Open/close selector switches will be provided for each loading actuated valve and will be mounted on the gantry top. Valve position indication will be via visual beacons mounted on the valve actuator.

6 off 4 East rail loading ESD pushbuttons will be provided, located at each end of the gantry and in the centre on the ground floor and gantry top.

The following facilities will be provided on the local operator panel -

- A red lamp, illuminated when 4 East rail loading ESD, 4 East ESD or Site Fire Alarm is operated and required resetting.
- A red lamp, illuminated when a high level is detected.
- A horn activated when a 4 East rail loading ESD or high level is detected.
- A lamp test facility.
- A ESD/High level reset facility.
- A horn silence facility.

The following facilities will be provided at each end of the gantry and in the centre on the gantry top -

- 4 East rail loading pumps P2-25 and P5-12 start pushbuttons.
- 4 East rail loading pumps P2-25 and P5-12 momentary stop pushbuttons
- 4 East rail loading pumps P2-25 and P5-12 red lamps, illuminated when the pump is running.

### 4 EAST SWITCHROOM

**Control Panel** The following facilities will be provided -

- A 4 East rail loading ESD pushbutton.
- A red lamp, illuminated when 4 East rail loading ESD, 4 East ESD or Site Fire Alarm is operated and required resetting.
- An individual red lamp per loading point, illuminated when associated high level is detected.
- A lamp test facility.

### 3 EAST CONTROL ROOM

**Annunciator** “2 East ESD Operated” red window  
“4 East ESD Operated” red window  
“4 East Rail Gantry ESD Operated” red window  
“Site Fire” red window



### 2.3 *Interfaces Continued...*

**Radio System** “2 East Emergency Shutdown”, “4 East Emergency Shutdown”, “4 East Rail Loading Emergency Shutdown”, “Site Fire” broadcast on terminal radio system in line with other critical alarms.

**SCADA** No Provision

#### **700 SWITCHROOM MCC**

**MCC** No Provision for controls or indication at P2-25 MCC Compartment.

#### **No.5 SWITCHROOM MCC**

**MCC** The following facilities will be provided on the front of 4 East rail loading delivery pump P5-12 MCC compartment.

- Start pushbutton.
- Stay put stop pushbutton.
- A red lamp, illuminated when the pump is running.
- A green lamp, illuminated when the pump is stopped.
- An amber lamp, illuminated when the pump is in fault.
- An amber lamp, illuminated when the pump is low suction.
- An amber lamp, illuminated when the pump is high discharge temperature.
- Auto/off/manual selector switch.
- 4 East Rail Loading/Stripping selector switch.

The following facilities will be provided on the front of the Arcton pump raft sump pump P5-13 MCC compartment.

- Start pushbutton.
- Stay put stop pushbutton.
- A red lamp, illuminated when the pump is running.
- A green lamp, illuminated when the pump is stopped.
- An amber lamp, illuminated when the pump is in fault, sump low level or high discharge temperature.

#### **BUND R PUMP RAFT**

The following facilities will be provided located within 1 metre of the pumps -

- Loading pump P2-25 Start pushbutton and momentary stop pushbutton.

#### **ARCTON PUMP RAFT**

The following facilities will be provided located within 1 metre of the pumps -

- Loading pump P5-12 Start pushbutton and momentary stop pushbutton.
- Sump pump P5-13 Start pushbutton and stay put stop pushbutton.



***P & I Design Ltd.***

***Instrument Specification***

<b>CLIENT:</b> Simon Storage (Immingham East)	<b>REV</b>	<b>DATE</b>	<b>BY</b>	<b>CHKD</b>	<b>APPD</b>	<b>CLIENT REF.</b> FINA Rail Loading
	A	07.04.99	AJH	DRR	DRR	<b>P &amp; I REF.</b> SI039001.SPC
	B	09.04.99	AJH	DRR	DRR	<b>SHT 1 OF 3</b>

<b>ITEM:</b>	Electrical Component	
<b>GENERAL</b>	Tag Number Service Area Classification	See Sheet 2 Danload 240VAC Isolators Zone 1 IIB T3
<b>UNIT</b>	Type Supply Case Connections Mounting Enclosure Class Electrical Classification	Ex-Safety Switch (6-pole, 20A) 240VAC Glass fibre reinforced polyester Terminals Surface IP66 EEx ed IIC T6
<b>OUTPUT</b>	Type	
<b>OPTIONS</b>		Unit to be supplied with:- 1. 2 x 20mm entries (Bottom). 2. 1 x wall Mounting Kit
<b>MANUFACTURERS DATA</b>	Supplier B Model Number	CEAG 2 off GHG 262 2601 R0005 (Isolator) 2 off GHG 610 1953 R0018 (Wall Mounting Kit)
<b>DOCUMENTATION</b>	See attached Documentation Specification	

***P & I Design Ltd.***

***Instrument Specification***

**CLIENT:**  
Simon Storage (Immingham East)

REV	DATE	BY	CHKD	APPD
A	07.04.99	AJH	DRR	DRR
B	09.04.99	AJH	DRR	DRR

**CLIENT REF.**  
FINA Rail Loading  
**P & I REF.**  
SI039001.SPC  
**SHT 2 OF 3**

N/A                      Isolator to be fitted with tag:-  
                                  “North Siding Danload Isolator”

N/A                      Isolator to be fitted with tag:-  
                                  “South Siding Danload Isolator”



**CLIENT:**  
Simon Storage (Immingham East)

<b>REV</b>	<b>DATE</b>	<b>BY</b>	<b>CHKD</b>	<b>APPD</b>
A	07.04.99	AJH	DRR	DRR
B	09.04.99	AJH	DRR	DRR

**CLIENT REF.**  
FINA Rail Loading  
**P & I REF.**  
SI039001.SPC  
**SHT 3 OF 3**

<u>Item</u>	<u>Quantity</u>	<u>Description</u>
1.		<b>APPROVAL DOCUMENTATION</b> To be supplied before manufacture commences
2.		<b>GENERAL ARRANGEMENT DRAWING</b> Cross-sectioned to show all details necessary for repair and maintenance purposes.
3.		<b>MATERIALS TEST CERTIFICATES</b> a. Mechanical. b. Chemical analysis.
4.		<b>ITEMISED PARTS LIST</b> Cross-referenced with G.A. drawing(s) and illustrating manufacturers references for all proprietary items such as bearings, oilseals, mechanical seals, etc.
5.		<b>RECOMMEND SPARES QUOTATION</b> a. Two years service. b. Commissioning only.
6.		<b>INSTALLATION, OPERATING AND MAINTENANCE MANUALS</b> To include calibration instructions where applicable.
7.		<b>SOFTWARE</b> a. Programming manual. b. Operating manual.
8.		<b>PRESSURE VESSELS</b> Calculation sheets, spark test certificates (for lined vessels),hydraulic test certificates.
9.		<b>ELECTRICAL</b> a. Schematic and circuit diagrams. b. Certificates of conformity (to include EMC Directive 89/336/EEC). c. Hazardous area certification.
	1	
	1	
10.		<b>INSTRUMENTATION</b> a. Certificates of conformity (to include EMC Directive 89/336/EEC). b. Calibration certificates. c. Hazardous area certification.
11.		<b>SPECIAL REQUIREMENTS</b> Year 2000 Certificate of Compliance

**IMPORTANT NOTICE:**

Vendors acceptance of this order is conditional on the provision of the Documentation.

Should the vendor not wish to supply the whole or part of the details herein requested, he shall state in writing any exceptions with the quotation or order acceptance.

P & I Design reserve the right to cancel any order where the documentation does not comply with P & I requirements. No item will be paid in full until documentation specified has been received.

***P & I Design Ltd.***

***Instrument Specification***

<b>CLIENT:</b> Simon Storage (Immingham East)	<b>REV</b> <b>DATE</b> <b>BY</b> <b>CHKD</b> <b>APPD</b> <b>CLIENT REF.</b> A   09.04.99   AJH   DRR   DRR   FINA Rail Loading <b>P &amp; I REF.</b> SI039002.SPC <b>SHT 1 OF 2</b>
--	---

**ITEM:**                      Electrical  
                                    Component

**GENERAL**                      Tag Number                      N/A  
                                    Service                              FINA DERV Rail Loading Pump Stop/Start  
                                    Area Classification                Zone 1 IIB T3

**UNIT**                              Type                                  Access Control Station  
                                    Supply                                240Vac  
                                    Case                                  Base:Marine Bronze, Cover:Black Polyester  
                                    Connections                        Terminals  
                                    Mounting                             Surface  
                                    Enclosure Class                    IP66  
                                    Electrical Classification         EExde

**OUTPUT**                      Type

**OPTIONS**                              Unit to be supplied with:-  
    1 off Mushroom headed stop button labelled  
    ‘STOP’.  
    1 off Momentary pushbutton labelled ‘START’.  
    1 x 20mm entry holes (bottom)

**MANUFACTURERS**                      Supplier                              Allen West  
**DATA**                                      Model Number                        NA203002A3F

**DOCUMENTATION**                      See attached Documentation Specification

**CLIENT:**  
Simon Storage (Immingham East)

**REV DATE BY CHKD APPD**  
A 09.04.99 AJH DRR DRR

**CLIENT REF.**  
FINA Rail Loading  
**P & I REF.**  
SI039002.SPC  
**SHT 2 OF 2**

**Documentation Requirement**

<b>Item</b>	<b>Quantity</b>	<b>Description</b>
1.		<b>APPROVAL DOCUMENTATION</b> To be supplied before manufacture commences
2.		<b>GENERAL ARRANGEMENT DRAWING</b> Cross-sectioned to show all details necessary for repair and maintenance purposes.
3.		<b>MATERIALS TEST CERTIFICATES</b> a. Mechanical. b. Chemical analysis.
4.		<b>ITEMISED PARTS LIST</b> Cross-referenced with G.A. drawing(s) and illustrating manufacturers references for all proprietary items such as bearings, oilseals, mechanical seals, etc.
5.		<b>RECOMMEND SPARES QUOTATION</b> a. Two years service. b. Commissioning only.
6.		<b>INSTALLATION, OPERATING AND MAINTENANCE MANUALS</b> To include calibration instructions where applicable.
7.		<b>SOFTWARE</b> a. Programming manual. b. Operating manual.
8.		<b>PRESSURE VESSELS</b> Calculation sheets, spark test certificates (for lined vessels),hydraulic test certificates.
9.		<b>ELECTRICAL</b> a. Schematic and circuit diagrams. b. Certificates of conformity (to include EMC Directive 89/336/EEC). c. Hazardous area certification.
	1	
	1	
10.		<b>INSTRUMENTATION</b> a. Certificates of conformity (to include EMC Directive 89/336/EEC). b. Calibration certificates. c. Hazardous area certification.
11.		<b>SPECIAL REQUIREMENTS</b> Year 2000 Certificate of Compliance

**IMPORTANT NOTICE:**

Vendors acceptance of this order is conditional on the provision of the Documentation.  
Should the vendor not wish to supply the whole or part of the details herein requested, he shall state in writing any exceptions with the quotation or order acceptance.

P & I Design reserve the right to cancel any order where the documentation does not comply with P & I requirements. No item will be paid in full until documentation specified has been received.

**CLIENT:**

Simon Storage (Immingham East)

REV	DATE	BY	CHKD	APPD	CLIENT REF.
A	10/03/99	AJH	DRR	DRR	FINA Rail Loading
B	06/04/99	AJH	DRR	DRR	<b>P &amp; I REF.</b> SI039004.SPC <b>SHT 1 OF 2</b>

**ITEM:**

Electrical  
Component

**GENERAL**

	B	Tag Number	N/A
		Service	FINA DERV Rail Loading Operator Control Panel
		Area Classification	Zone 1 IIB T3

**UNIT**

		Type	Control Unit c/w terminals, indicator lamps and switches.
		Supply	24VDC
		Case	Manufacturers Standard
		Connections	Terminals
		Mounting	Surface
		Enclosure Class	IP66
		Electrical Classification	EEx de IIC T6

**OUTPUT**

	B	Type	Box to include 26 off SAK2.5 EEx'e' terminals and the following EEx'de' controls:-
			1 x Mushroom head stay-put-stop pushbutton 1N/O & 1N/C contact
			1 x 2-position selector switch, 1N/O contact in each position.
			3 x Momentary Pushbuttons 1N/O & 1N/C contact
	B		5 x Lamps, 24VDC (Red)
			1 x Lamp, 24VDC (Green)
	B		1 x Lamp, 24VDC (Amber)
			Enclosure to be drilled for the following gland entries:-
			1 x 25mm (bottom)

**OPTIONS**

For internal,external layout & label details see drawing SI039020.

**MANUFACTURERS DATA**

Supplier	CEAG
Model Number	1 off GHG448 with built in components

**DOCUMENTATION**

See attached Documentation Specification

**CLIENT:**  
Simon Storage (Immingham East)

REV	DATE	BY	CHKD	APPD
A	10/03/99	AJH	DRR	DRR
B	06/04/99	AJH	DRR	DRR

**CLIENT REF.**  
FINA Rail Loading  
**P & I REF.**  
SI039004.SPC  
**SHT 2 OF 2**

<u>Item</u>	<u>Quantity</u>	<u>Description</u>
1.		<b>APPROVAL DOCUMENTATION</b> To be supplied before manufacture commences
2.		<b>GENERAL ARRANGEMENT DRAWING</b> Cross-sectioned to show all details necessary for repair and maintenance purposes.
3.		<b>MATERIALS TEST CERTIFICATES</b> a. Mechanical. b. Chemical analysis.
4.		<b>ITEMISED PARTS LIST</b> Cross-referenced with G.A. drawing(s) and illustrating manufacturers references for all proprietary items such as bearings, oilseals, mechanical seals, etc.
5.		<b>RECOMMEND SPARES QUOTATION</b> a. Two years service. b. Commissioning only.
6.		<b>INSTALLATION, OPERATING AND MAINTENANCE MANUALS</b> To include calibration instructions where applicable.
7.		<b>SOFTWARE</b> a. Programming manual. b. Operating manual.
8.		<b>PRESSURE VESSELS</b> Calculation sheets, spark test certificates (for lined vessels),hydraulic test certificates.
9.		<b>ELECTRICAL</b> a. Schematic and circuit diagrams. b. Certificates of conformity (to include EMC Directive 89/336/EEC). c. Hazardous area certification.
	1	
	1	
10.		<b>INSTRUMENTATION</b> a. Certificates of conformity (to include EMC Directive 89/336/EEC). b. Calibration certificates. c. Hazardous area certification.
11.		<b>SPECIAL REQUIREMENTS</b> Year 2000 Certificate of Compliance

**IMPORTANT NOTICE:**

Vendors acceptance of this order is conditional on the provision of the Documentation.  
Should the vendor not wish to supply the whole or part of the details herein requested, he shall state in writing any exceptions with the quotation or order acceptance.  
P & I Design reserve the right to cancel any order where the documentation does not comply with P & I requirements. No item will be paid in full until documentation specified has been received.

***P & I Design Ltd.***

***Instrument Specification***

**CLIENT:**  
Simon Storage (Immingham East)

**REV DATE BY CHKD APPD**  
A 09.04.99 AJH DRR DRR

**CLIENT REF.**  
FINA Rail Loading  
**P & I REF.**  
SI039005.SPC  
**SHT 1 OF 2**

**ITEM:** Electrical  
Component

**GENERAL** Tag Number N/A  
Service Loading System ESD  
Area Classification Zone 1 IIB T3

**UNIT** Type Access Control Station  
Supply 24Vdc  
Case Base:Marine Bronze, Cover:Black Polyester  
Connections Terminals  
Mounting Surface  
Enclosure Class IP66  
Electrical Classification EExde

**OUTPUT** Type

**OPTIONS** Unit to be supplied with:-  
1. 1 off Mushroom headed stop button labelled  
'ESD'.

Unit to be drilled for the following entries:-  
1. 1 x 20mm (Bottom)

**MANUFACTURERS DATA** Supplier Allen West  
Model Number 3 Off NA101003F

**DOCUMENTATION** See attached Documentation Specification

**CLIENT:**  
Simon Storage (Immingham East)

**REV DATE BY CHKD APPD**  
A 09.04.99 AJH DRR DRR

**CLIENT REF.**  
FINA Rail Loading  
**P & I REF.**  
SI039005.SPC  
**SHT 2 OF 2**

<u>Item</u>	<u>Quantity</u>	<u>Description</u>
1.		<b>APPROVAL DOCUMENTATION</b> To be supplied before manufacture commences
2.		<b>GENERAL ARRANGEMENT DRAWING</b> Cross-sectioned to show all details necessary for repair and maintenance purposes.
3.		<b>MATERIALS TEST CERTIFICATES</b> a. Mechanical. b. Chemical analysis.
4.		<b>ITEMISED PARTS LIST</b> Cross-referenced with G.A. drawing(s) and illustrating manufacturers references for all proprietary items such as bearings, oilseals, mechanical seals, etc.
5.		<b>RECOMMEND SPARES QUOTATION</b> a. Two years service. b. Commissioning only.
6.		<b>INSTALLATION, OPERATING AND MAINTENANCE MANUALS</b> To include calibration instructions where applicable.
7.		<b>SOFTWARE</b> a. Programming manual. b. Operating manual.
8.		<b>PRESSURE VESSELS</b> Calculation sheets, spark test certificates (for lined vessels),hydraulic test certificates.
9.		<b>ELECTRICAL</b> a. Schematic and circuit diagrams. b. Certificates of conformity (to include EMC Directive 89/336/EEC). c. Hazardous area certification.
	1	
	1	
10.		<b>INSTRUMENTATION</b> a. Certificates of conformity (to include EMC Directive 89/336/EEC). b. Calibration certificates. c. Hazardous area certification.
11.		<b>SPECIAL REQUIREMENTS</b> Year 2000 Certificate of Compliance

**IMPORTANT NOTICE:**

Vendors acceptance of this order is conditional on the provision of the Documentation.  
Should the vendor not wish to supply the whole or part of the details herein requested, he shall state in writing any exceptions with the quotation or order acceptance.  
P & I Design reserve the right to cancel any order where the documentation does not comply with P & I requirements. No item will be paid in full until documentation specified has been received.

***P & I Design Ltd.***

***Instrument Specification***

**CLIENT:**  
Simon Storage (Immingham East)

REV	DATE	BY	CHKD	APPD
A	09.04.99	AJH	DRR	DRR

**CLIENT REF.**  
FINA Rail Loading  
**P & I REF.**  
SI039006.SPC  
**SHT 1 OF 2**

**ITEM:** Electrical Component

GENERAL		
	Tag Number	N/A
	Service	Alarm Sounder
	Area Classification	Zone 1 IIB T3

UNIT		
	Type	Hazardous Area Audiable Sounder
	Supply	24Vdc
	Case	Aluminium Alloy
	Connections	Terminals
	Mounting	Surface
	Enclosure Class	IP67
	Electrical Classification	N/A

OUTPUT		
	Type	107 dB, 11 tone selectable

**OPTIONS**

MANUFACTURERS DATA		
	Supplier	RS
	Model Number	627-598

**DOCUMENTATION** See attached Documentation Specification



**CLIENT:**  
Simon Storage (Immingham East)

**REV DATE BY CHKD APPD**  
A 09.04.99 AJH DRR DRR

**CLIENT REF.**  
FINA Rail Loading  
**P & I REF.**  
SI039006.SPC  
**SHT 2 OF 2**

<u>Item</u>	<u>Quantity</u>	<u>Description</u>
1.		<b>APPROVAL DOCUMENTATION</b> To be supplied before manufacture commences
2.		<b>GENERAL ARRANGEMENT DRAWING</b> Cross-sectioned to show all details necessary for repair and maintenance purposes.
3.		<b>MATERIALS TEST CERTIFICATES</b> a. Mechanical. b. Chemical analysis.
4.		<b>ITEMISED PARTS LIST</b> Cross-referenced with G.A. drawing(s) and illustrating manufacturers references for all proprietary items such as bearings, oilseals, mechanical seals, etc.
5.		<b>RECOMMEND SPARES QUOTATION</b> a. Two years service. b. Commissioning only.
6.		<b>INSTALLATION, OPERATING AND MAINTENANCE MANUALS</b> To include calibration instructions where applicable.
7.		<b>SOFTWARE</b> a. Programming manual. b. Operating manual.
8.		<b>PRESSURE VESSELS</b> Calculation sheets, spark test certificates (for lined vessels),hydraulic test certificates.
9.		<b>ELECTRICAL</b> a. Schematic and circuit diagrams. b. Certificates of conformity (to include EMC Directive 89/336/EEC). c. Hazardous area certification.
	1	
	1	
10.		<b>INSTRUMENTATION</b> a. Certificates of conformity (to include EMC Directive 89/336/EEC). b. Calibration certificates. c. Hazardous area certification.
11.		<b>SPECIAL REQUIREMENTS</b> Year 2000 Certificate of Compliance

**IMPORTANT NOTICE:**

Vendors acceptance of this order is conditional on the provision of the Documentation.

Should the vendor not wish to supply the whole or part of the details herein requested, he shall state in writing any exceptions with the quotation or order acceptance.

P & I Design reserve the right to cancel any order where the documentation does not comply with P & I requirements. No item will be paid in full until documentation specified has been received.

***P & I Design Ltd.***

***Instrument Specification***

**CLIENT:**  
Simon Storage (Immingham East)

**REV DATE BY CHKD APPD**  
A 09.04.99 AJH DRR DRR

**CLIENT REF.**  
FINA Rail Loading  
**P & I REF.**  
SI039007.SPC  
**SHT 1 OF 2**

**ITEM:** Electrical Component

**GENERAL** Tag Number N/A  
Service FINA DERV DC JB  
Area Classification Zone 1 IIB T3

**UNIT** Type Sheet Steel Enclosure  
Supply 24VDC  
Case Zinc Sprayed (6mm gland plates)  
Connections See OPTIONS  
Mounting Surface  
Enclosure Class IP66  
Electrical Classification EEx'e'

**OUTPUT** Type 24Vdc power & comms.

**OPTIONS** Enclosure to be fitted with the following:-

1. 1 x Vertical row of 62 off SAK2.5 EEx'e' terminals.
2. 2 x Vertical rows of 50 off SAK2.5 EEx'e' terminals.
3. 2 x Earth rails & 55 ZB4 earth clamps.

Enclosure to be drilled for the following entries:-

1. 2 x 40mm. (Top)
2. 3 x 20mm, plugged. (Top)
3. 4 x 25mm. (Top)
4. 26 x 20mm, 4 plugged. (Bottom)

Enclosure to be fitted with the label:-  
"FINA DERV RAIL LOADING DC JUNCTION BOX"

See drawing SI039018 for details

**MANUFACTURERS DATA** Supplier J Hemy Systems  
Model Number KLIPPON TB13EEx'e'

**DOCUMENTATION** See attached Documentation Specification

**CLIENT:**  
Simon Storage (Immingham East)

**REV DATE BY CHKD APPD**  
A 09.04.99 AJH DRR DRR

**CLIENT REF.**  
FINA Rail Loading  
**P & I REF.**  
SI039007.SPC  
**SHT 2 OF 2**

**Documentation Requirement**

<b>Item</b>	<b>Quantity</b>	<b>Description</b>
1.		<b>APPROVAL DOCUMENTATION</b> To be supplied before manufacture commences
2.		<b>GENERAL ARRANGEMENT DRAWING</b> Cross-sectioned to show all details necessary for repair and maintenance purposes.
3.		<b>MATERIALS TEST CERTIFICATES</b> a. Mechanical. b. Chemical analysis.
4.		<b>ITEMISED PARTS LIST</b> Cross-referenced with G.A. drawing(s) and illustrating manufacturers references for all proprietary items such as bearings, oilseals, mechanical seals, etc.
5.		<b>RECOMMEND SPARES QUOTATION</b> a. Two years service. b. Commissioning only.
6.		<b>INSTALLATION, OPERATING AND MAINTENANCE MANUALS</b> To include calibration instructions where applicable.
7.		<b>SOFTWARE</b> a. Programming manual. b. Operating manual.
8.		<b>PRESSURE VESSELS</b> Calculation sheets, spark test certificates (for lined vessels),hydraulic test certificates.
9.		<b>ELECTRICAL</b> a. Schematic and circuit diagrams. b. Certificates of conformity (to include EMC Directive 89/336/EEC). c. Hazardous area certification.
	1	
	1	
10.		<b>INSTRUMENTATION</b> a. Certificates of conformity (to include EMC Directive 89/336/EEC). b. Calibration certificates. c. Hazardous area certification.
11.		<b>SPECIAL REQUIREMENTS</b> Year 2000 Certificate of Compliance

**IMPORTANT NOTICE:**

Vendors acceptance of this order is conditional on the provision of the Documentation.  
Should the vendor not wish to supply the whole or part of the details herein requested, he shall state in writing any exceptions with the quotation or order acceptance.

P & I Design reserve the right to cancel any order where the documentation does not comply with P & I requirements. No item will be paid in full until documentation specified has been received.



**CLIENT:**  
Simon Storage (Immingham East)

**REV DATE BY CHKD APPD**  
A 09.04.99 AJH DRR DRR

**CLIENT REF.**  
FINA Rail Loading  
**P & I REF.**  
SI039008.SPC  
**SHT 2 OF 2**

<u>Item</u>	<u>Quantity</u>	<u>Description</u>
1.		<b>APPROVAL DOCUMENTATION</b> To be supplied before manufacture commences
2.		<b>GENERAL ARRANGEMENT DRAWING</b> Cross-sectioned to show all details necessary for repair and maintenance purposes.
3.		<b>MATERIALS TEST CERTIFICATES</b> a. Mechanical. b. Chemical analysis.
4.		<b>ITEMISED PARTS LIST</b> Cross-referenced with G.A. drawing(s) and illustrating manufacturers references for all proprietary items such as bearings, oilseals, mechanical seals, etc.
5.		<b>RECOMMEND SPARES QUOTATION</b> a. Two years service. b. Commissioning only.
6.		<b>INSTALLATION, OPERATING AND MAINTENANCE MANUALS</b> To include calibration instructions where applicable.
7.		<b>SOFTWARE</b> a. Programming manual. b. Operating manual.
8.		<b>PRESSURE VESSELS</b> Calculation sheets, spark test certificates (for lined vessels),hydraulic test certificates.
9.		<b>ELECTRICAL</b> a. Schematic and circuit diagrams. b. Certificates of conformity (to include EMC Directive 89/336/EEC). c. Hazardous area certification.
	1	
	1	
10.		<b>INSTRUMENTATION</b> a. Certificates of conformity (to include EMC Directive 89/336/EEC). b. Calibration certificates. c. Hazardous area certification.
11.		<b>SPECIAL REQUIREMENTS</b> Year 2000 Certificate of Compliance

**IMPORTANT NOTICE:**

Vendors acceptance of this order is conditional on the provision of the Documentation.

Should the vendor not wish to supply the whole or part of the details herein requested, he shall state in writing any exceptions with the quotation or order acceptance.

P & I Design reserve the right to cancel any order where the documentation does not comply with P & I requirements. No item will be paid in full until documentation specified has been received.

**P & I Design Ltd.**

**Instrument Specification**

<b>CLIENT:</b> Simon Storage (Immingham East)	<b>REV</b> <b>DATE</b> <b>BY</b> <b>CHKD</b> <b>APPD</b>	<b>CLIENT REF.</b> FINA Rail Loading <b>P &amp; I REF.</b> SI039009.SPC <b>SHT 1 OF 3</b>
	A   09.04.99   AJH   DRR   DRR	

**ITEM:** Solenoid Valve  
Direct

**GENERAL**   Tag Number   See Sheet 2  
Service   See Sheet 2  
Area Classification   Zone 1 IIB T3

**BODY**   Type   Standard  
Number of Ways   3  
Action   Normally Closed : Spring Return  
Construction   Manufacturers Standard  
Connections: Size/Type   1/8" / BSP screwed female  
Mounting   Direct Mounted

**SOLENOID**   Type   Flameproof  
Voltage   24v dc  
Enclosure Class   IP65  
Electrical Classification   EExd IIC T4  
Electrical Connection   20mm ET, Klippon Terminal Strip

**OPTIONS**

**PROCESS DATA**   Fluid   Instrument Air  
Pressure Max.   80psig  
Oper. Diff. Max./Min.   80psi  
Temperature Oper.   Max. allowable ambient temp 65°C

**MANUFACTURERS DATA**   Supplier   RGS  
Model Number   12 off EPA 100/Exd/TB

**DOCUMENTATION**   See Attached Documentation Specification

**TAG No.**  
XSV1

**SERVICE**  
XCV1 Actuator

**RANGE**   **COMMENTS**

XSV-##A1.SPC

***P & I Design Ltd.***

***Instrument Specification***

**CLIENT:**  
Simon Storage (Immingham East)

REV	DATE	BY	CHKD	APPD
A	09.04.99	AJH	DRR	DRR

**CLIENT REF.**  
FINA Rail Loading  
**P & I REF.**  
SI039009.SPC  
**SHT 2 OF 3**

XSV2	XCV2 Actuator
XSV3	XCV3 Actuator
XSV4	XCV4 Actuator
XSV5	XCV5 Actuator
XSV6	XCV6 Actuator
XSV7	XCV7 Actuator
XSV8	XCV8 Actuator
XSV9	XCV9 Actuator
XSV10	XCV10 Actuator
XSV11	XCV11 Actuator
XSV12	XCV12 Actuator

###-FMA1.SPC

***Documentation Requirement***

**Item      Quantity      Description**

**CLIENT:**  
Simon Storage (Immingham East)

**REV DATE BY CHKD APPD**  
A 09.04.99 AJH DRR DRR

**CLIENT REF.**  
FINA Rail Loading  
**P & I REF.**  
SI039009.SPC  
**SHT 3 OF 3**

1. **APPROVAL DOCUMENTATION**  
To be supplied before manufacture commences
2. **GENERAL ARRANGEMENT DRAWING**  
Cross-sectioned to show all details necessary for repair and maintenance purposes.
3. **MATERIALS TEST CERTIFICATES**
  - a. Mechanical.
  - b. Chemical analysis.
4. **ITEMISED PARTS LIST**  
Cross-referenced with G.A. drawing(s) and illustrating manufacturers references for all proprietary items such as bearings, oilseals, mechanical seals, etc.
5. **RECOMMEND SPARES QUOTATION**
  - a. Two years service.
  - b. Commissioning only.
6. **INSTALLATION, OPERATING AND MAINTENANCE MANUALS**  
To include calibration instructions where applicable.
7. **SOFTWARE**
  - a. Programming manual.
  - b. Operating manual.
8. **PRESSURE VESSELS**  
Calculation sheets, spark test certificates (for lined vessels),hydraulic test certificates.
9. **ELECTRICAL**
  - a. Schematic and circuit diagrams.
  - 1 b. Certificates of conformity (to include EMC Directive 89/336/EEC).
  - 1 c. Hazardous area certification.
10. **INSTRUMENTATION**
  - a. Certificates of conformity (to include EMC Directive 89/336/EEC).
  - b. Calibration certificates.
  - c. Hazardous area certification.
11. **SPECIAL REQUIREMENTS**  
Year 2000 Certificate of Compliance

**IMPORTANT NOTICE:**

Vendors acceptance of this order is conditional on the provision of the Documentation.

Should the vendor not wish to supply the whole or part of the details herein requested, he shall state in writing any exceptions with the quotation or order acceptance.

P & I Design reserve the right to cancel any order where the documentation does not comply with P & I requirements. No item will be paid in full until documentation specified has been received.



***P & I Design Ltd.***

***Instrument Specification***

**CLIENT:**  
Simon Storage (Immingham East)

REV	DATE	BY	CHKD	APPD
A	09.04.99	AJH	DRR	DRR

**CLIENT REF.**  
FINA Rail Loading  
**P & I REF.**  
SI039010.SPC  
**SHT 1 OF 2**

**pITEM:** Electrical  
Component

<b>GENERAL</b>	Tag Number	N/A
	Service	Field Mounted MUX Panel Heater
	Area Classification	Zone 1 IIB T3

<b>UNIT</b>	Type	Explosion Protected Mini Heater
	Supply	240VAC, 6W
	Case	Anodised Aluminium
	Connections	2 x Individual Conductors
	Mounting	Surface via 2 x 3.2mm Ø holes.
	Enclosure Class	IP66
	Electrical Classification	EExd IIC T5

**OUTPUT** Type

**OPTIONS**

<b>MANUFACTURERS DATA</b>	Supplier	BARTEC
	Model Number	2 off 27-2301-3806

**DOCUMENTATION** See attached Documentation Specification

**CLIENT:**  
Simon Storage (Immingham East)

**REV DATE BY CHKD APPD**  
A 09.04.99 AJH DRR DRR

**CLIENT REF.**  
FINA Rail Loading  
**P & I REF.**  
SI039010.SPC  
**SHT 2 OF 2**

<u>Item</u>	<u>Quantity</u>	<u>Description</u>
1.		<b>APPROVAL DOCUMENTATION</b> To be supplied before manufacture commences
2.		<b>GENERAL ARRANGEMENT DRAWING</b> Cross-sectioned to show all details necessary for repair and maintenance purposes.
3.		<b>MATERIALS TEST CERTIFICATES</b> a. Mechanical. b. Chemical analysis.
4.		<b>ITEMISED PARTS LIST</b> Cross-referenced with G.A. drawing(s) and illustrating manufacturers references for all proprietary items such as bearings, oilseals, mechanical seals, etc.
5.		<b>RECOMMEND SPARES QUOTATION</b> a. Two years service. b. Commissioning only.
6.		<b>INSTALLATION, OPERATING AND MAINTENANCE MANUALS</b> To include calibration instructions where applicable.
7.		<b>SOFTWARE</b> a. Programming manual. b. Operating manual.
8.		<b>PRESSURE VESSELS</b> Calculation sheets, spark test certificates (for lined vessels),hydraulic test certificates.
9.		<b>ELECTRICAL</b> a. Schematic and circuit diagrams. b. Certificates of conformity (to include EMC Directive 89/336/EEC). c. Hazardous area certification.
	1	
	1	
10.		<b>INSTRUMENTATION</b> a. Certificates of conformity (to include EMC Directive 89/336/EEC). b. Calibration certificates. c. Hazardous area certification.
11.		<b>SPECIAL REQUIREMENTS</b> Year 2000 Certificate of Compliance

**IMPORTANT NOTICE:**

Vendors acceptance of this order is conditional on the provision of the Documentation.

Should the vendor not wish to supply the whole or part of the details herein requested, he shall state in writing any exceptions with the quotation or order acceptance.

P & I Design reserve the right to cancel any order where the documentation does not comply with P & I requirements. No item will be paid in full until documentation specified has been received.

***P & I Design Ltd***

***Instrument Specification***

**CLIENT:**  
Simon Storage (Immingham East)

**REV DATE BY CHKD APPD**  
A 08.04.99 AJH DRR DRR

**CLIENT REF.**  
FINA Rail Loading  
**P & I REF.**  
SI039011.SPC  
**SHT 1 OF 2**

**ITEM:** Power Supply

**GENERAL** Tag Number N/A  
Service Logic Panel PSU

**UNIT** Type Switch Mode  
Supply Single phase, 240VAC  
Case Metal with fine ventilating grid  
Connections Terminals  
Mounting DIN rail  
Enclosure Class N/A

**OUTPUT** Type Voltage  
Indication LED's  
GREEN = 'Vout OK'.  
RED = 'Vout < 2v below SP'  
RED Flashes = 'Vout < approx. 14V'

Output: Voltage 24Vdc  
Amperes 10A  
Channels 1

**PROTECTION** Short Circuit External Fuse  
Over Voltage Internal Protection  
Over Current Limit

**OPTIONS**

**MANUFACTURERS** Supplier Coutant Lambda  
**DATA** Model Number DRP 240-1

**DOCUMENTATION** See Attached Documentation Specification

**CLIENT:**  
Simon Storage (Immingham East)

**REV DATE BY CHKD APPD**  
A 08.04.99 AJH DRR DRR

**CLIENT REF.**  
FINA Rail Loading  
**P & I REF.**  
SI039011.SPC  
**SHT 2 OF 2**

<u>Item</u>	<u>Quantity</u>	<u>Description</u>
1.		<b>APPROVAL DOCUMENTATION</b> To be supplied before manufacture commences
2.		<b>GENERAL ARRANGEMENT DRAWING</b> Cross-sectioned to show all details necessary for repair and maintenance purposes.
3.		<b>MATERIALS TEST CERTIFICATES</b> a. Mechanical. b. Chemical analysis.
4.		<b>ITEMISED PARTS LIST</b> Cross-referenced with G.A. drawing(s) and illustrating manufacturers references for all proprietary items such as bearings, oilseals, mechanical seals, etc.
5.		<b>RECOMMEND SPARES QUOTATION</b> a. Two years service. b. Commissioning only.
6.		<b>INSTALLATION, OPERATING AND MAINTENANCE MANUALS</b> To include calibration instructions where applicable.
7.		<b>SOFTWARE</b> a. Programming manual. b. Operating manual.
8.		<b>PRESSURE VESSELS</b> Calculation sheets, spark test certificates (for lined vessels),hydraulic test certificates.
9.	1	<b>ELECTRICAL</b> a. Schematic and circuit diagrams. b. Certificates of conformity (to include EMC Directive 89/336/EEC). c. Hazardous area certification.
10.		<b>INSTRUMENTATION</b> a. Certificates of conformity (to include EMC Directive 89/336/EEC). b. Calibration certificates. c. Hazardous area certification.
11.		<b>SPECIAL REQUIREMENTS</b> Year 2000 Certificate of Compliance

**IMPORTANT NOTICE:**

Vendors acceptance of this order is conditional on the provision of the Documentation.

Should the vendor not wish to supply the whole or part of the details herein requested, he shall state in writing any exceptions with the quotation or order acceptance.

P & I Design reserve the right to cancel any order where the documentation does not comply with P & I requirements. No item will be paid in full until documentation specified has been received.

**P & I Design Ltd.**

**Instrument Specification**

<b>CLIENT:</b> Simon Storage (Immingham East)	<b>REV</b> A <b>DATE</b> 09.04.99	<b>BY</b> AJH	<b>CHKD</b> DRR	<b>APPD</b> DRR	<b>CLIENT REF.</b> FINA Rail Loading <b>P &amp; I REF.</b> SI039012.SPC <b>SHT 1 OF 2</b>
--	-----------------------------------	---------------	-----------------	-----------------	---

**ITEM:** Multiplexer System (Digital)

**GENERAL**  
Tag Number N/A  
Service North & South Siding MUX  
Area Classification Zone 1 IIB T3

**RECEIVER**  
Supply 24Vdc  
No. of Channels 16  
Contact Outputs : Type Relay (Energised when input 'closed')  
Rating 240V, 1A, 120VA, ac: 50V, 0.1A, 5W, dc.  
Indication Outputs : Type LED x 16  
Fault Outputs : Type MUX (LED & Relay), Highway (Relay)  
Housing : Material Moulded Polycarbonate  
Enclosure Class General Purpose  
Electrical Classification Safe Area  
Electrical Connection Terminals  
Mounting DIN Rail

**TRANSMITTER**  
Supply Loop powered Via MTL 3052 Isolator  
No. of Channels 16  
Field Inputs : Type Contact Inputs  
Rating 'Closed' if > 2.1 mA, 'Open' if < 1.2mA  
Operating Range 0.5km typically  
Housing : Material Moulded Polycarbonate  
Enclosure Class IP67  
Electrical Classification EExia IIC T6  
Electrical Connection Terminals  
Mounting DIN Rail

**OPTIONS**

**MANUFACTURERS DATA**  
Supplier MTL  
Model Number 4 off Receiver: MTL825B  
4 off Transmitter: MTL821B  
4 off Isolator: MTL3052

**DOCUMENTATION** See attached Documentation Specification

**CLIENT:**  
Simon Storage (Immingham East)

**REV DATE BY CHKD APPD**  
A 09.04.99 AJH DRR DRR

**CLIENT REF.**  
FINA Rail Loading  
**P & I REF.**  
SI039012.SPC  
**SHT 2 OF 2**

**Documentation Requirement**

<b>Item</b>	<b>Quantity</b>	<b>Description</b>
1.		<b>APPROVAL DOCUMENTATION</b> To be supplied before manufacture commences
2.		<b>GENERAL ARRANGEMENT DRAWING</b> Cross-sectioned to show all details necessary for repair and maintenance purposes.
3.		<b>MATERIALS TEST CERTIFICATES</b> a. Mechanical. b. Chemical analysis.
4.		<b>ITEMISED PARTS LIST</b> Cross-referenced with G.A. drawing(s) and illustrating manufacturers references for all proprietary items such as bearings, oilseals, mechanical seals, etc.
5.		<b>RECOMMEND SPARES QUOTATION</b> a. Two years service. b. Commissioning only.
6.		<b>INSTALLATION, OPERATING AND MAINTENANCE MANUALS</b> To include calibration instructions where applicable.
7.		<b>SOFTWARE</b> a. Programming manual. b. Operating manual.
8.		<b>PRESSURE VESSELS</b> Calculation sheets, spark test certificates (for lined vessels),hydraulic test certificates.
9.		<b>ELECTRICAL</b> a. Schematic and circuit diagrams. b. Certificates of conformity (to include EMC Directive 89/336/EEC). c. Hazardous area certification.
	1	
	1	
10.		<b>INSTRUMENTATION</b> a. Certificates of conformity (to include EMC Directive 89/336/EEC). b. Calibration certificates. c. Hazardous area certification.
11.		<b>SPECIAL REQUIREMENTS</b> Year 2000 Certificate of Compliance
	1	

**IMPORTANT NOTICE:**

Vendors acceptance of this order is conditional on the provision of the Documentation.  
Should the vendor not wish to supply the whole or part of the details herein requested, he shall state in writing any exceptions with the quotation or order acceptance.  
P & I Design reserve the right to cancel any order where the documentation does not comply with P & I requirements. No item will be paid in full until documentation specified has been received.



***P & I Design Ltd.***

***Instrument Specification***

**CLIENT:**  
Simon Storage (Immingham East)

**REV DATE BY CHKD APPD**  
A 09.04.99 AJH DRR DRR

**CLIENT REF.**  
FINA Rail Loading  
**P & I REF.**  
SI039013.SPC  
**SHT 2 OF 3**

**ITEM:** PLC System (Compact)  
Main Processor

**GENERAL** Service FINA DERV Rail Loading System

**I/O CAPACITY**

**INPUTS**

Analogue: No. None  
Type None

Digital : No. 64  
Type 24Vdc Sink

**OUTPUTS**

Analogue: No. None  
Type None

Digital : No. 64  
Type Relay

Connections Screwed Terminals

**OPTIONS** To include RS485 Comms module.

**MANUFACTURERS DATA** Supplier Mitsubishi  
Model Number PLC - FX2N - 128 – MR  
COMMS – FX2N-485/bd

**DOCUMENTATION** See Attached Documentation Specification



**CLIENT:**  
Simon Storage (Immingham East)

**REV DATE BY CHKD APPD**  
A 09.04.99 AJH DRR DRR

**CLIENT REF.**  
FINA Rail Loading  
**P & I REF.**  
SI039013.SPC  
**SHT 3 OF 3**

<u>Item</u>	<u>Quantity</u>	<u>Description</u>
1.		<b>APPROVAL DOCUMENTATION</b> To be supplied before manufacture commences
2.		<b>GENERAL ARRANGEMENT DRAWING</b> Cross-sectioned to show all details necessary for repair and maintenance purposes.
3.		<b>MATERIALS TEST CERTIFICATES</b> a. Mechanical. b. Chemical analysis.
4.		<b>ITEMISED PARTS LIST</b> Cross-referenced with G.A. drawing(s) and illustrating manufacturers references for all proprietary items such as bearings, oilseals, mechanical seals, etc.
5.		<b>RECOMMEND SPARES QUOTATION</b> a. Two years service. b. Commissioning only.
6.		<b>INSTALLATION, OPERATING AND MAINTENANCE MANUALS</b> To include calibration instructions where applicable.
7.		<b>SOFTWARE</b> a. Programming manual. b. Operating manual.
8.		<b>PRESSURE VESSELS</b> Calculation sheets, spark test certificates (for lined vessels),hydraulic test certificates.
9.	1	<b>ELECTRICAL</b> a. Schematic and circuit diagrams. b. Certificates of conformity (to include EMC Directive 89/336/EEC). c. Hazardous area certification.
10.		<b>INSTRUMENTATION</b> a. Certificates of conformity (to include EMC Directive 89/336/EEC). b. Calibration certificates. c. Hazardous area certification.
11.	1	<b>SPECIAL REQUIREMENTS</b> Year 2000 Certificate of Compliance

**IMPORTANT NOTICE:**

Vendors acceptance of this order is conditional on the provision of the Documentation.  
Should the vendor not wish to supply the whole or part of the details herein requested, he shall state in writing any exceptions with the quotation or order acceptance.  
P & I Design reserve the right to cancel any order where the documentation does not comply with P & I requirements. No item will be paid in full until documentation specified has been received.

***P & I Design Ltd.***

***Instrument Specification***

**CLIENT:**

Simon Storage (Immingham East)

REV	DATE	BY	CHKD	APPD
A	09.04.99	AJH	DRR	DRR
B	09.04.99	AJH	DRR	DRR

**CLIENT REF.**

FINA Rail Loading

**P & I REF.**

SI039014.SPC

**SHT 1 OF 3**

**ITEM:**

Electrical  
Component

**GENERAL**

Tag Number  
Service  
Area Classification

See Sheet 2  
Mux Heater 240VAC Isolator  
Zone 1 IIB T3

**UNIT**

Type  
Supply  
Case  
Connections  
Mounting  
Enclosure Class  
Electrical Classification

Ex-Safety Switch (3-pole, 10A)  
240VAC  
Glass fibre reinforced polyester  
Terminals  
Surface  
IP66  
EEx ed IIC T6

**OUTPUT**

Type

**OPTIONS**

Unit to be supplied with:-  
1. 2 x 20mm entries (Bottom).  
2. 1 x wall mounting kit

**MANUFACTURERS  
DATA**

B Supplier  
Model Number

CEAG  
1 off GHG 261 0005 R0005 (Isolator)  
1 off GHG 610 1953 R001 (Wall Mounting Kit)

**DOCUMENTATION**

See attached Documentation Specification

**TAG No.**

**SERVICE**

**RANGE**

ZZ#-ECA1.SPC  
**COMMENTS**

***P & I Design Ltd.***

***Instrument Specification***

**CLIENT:**  
Simon Storage (Immingham East)

REV	DATE	BY	CHKD	APPD
A	09.04.99	AJH	DRR	DRR
B	09.04.99	AJH	DRR	DRR

**CLIENT REF.**  
FINA Rail Loading  
**P & I REF.**  
SI039014.SPC  
**SHT 2 OF 3**

N/A                      Isolator to be fitted with tag:-  
                                  “Mux Heaters Isolator”

**CLIENT:**  
Simon Storage (Immingham East)

REV	DATE	BY	CHKD	APPD
A	09.04.99	AJH	DRR	DRR
B	09.04.99	AJH	DRR	DRR

**CLIENT REF.**  
FINA Rail Loading  
**P & I REF.**  
SI039014.SPC  
**SHT 3 OF 3**

<u>Item</u>	<u>Quantity</u>	<u>Description</u>
1.		<b>APPROVAL DOCUMENTATION</b> To be supplied before manufacture commences
2.		<b>GENERAL ARRANGEMENT DRAWING</b> Cross-sectioned to show all details necessary for repair and maintenance purposes.
3.		<b>MATERIALS TEST CERTIFICATES</b> a. Mechanical. b. Chemical analysis.
4.		<b>ITEMISED PARTS LIST</b> Cross-referenced with G.A. drawing(s) and illustrating manufacturers references for all proprietary items such as bearings, oilseals, mechanical seals, etc.
5.		<b>RECOMMEND SPARES QUOTATION</b> a. Two years service. b. Commissioning only.
6.		<b>INSTALLATION, OPERATING AND MAINTENANCE MANUALS</b> To include calibration instructions where applicable.
7.		<b>SOFTWARE</b> a. Programming manual. b. Operating manual.
8.		<b>PRESSURE VESSELS</b> Calculation sheets, spark test certificates (for lined vessels),hydraulic test certificates.
9.		<b>ELECTRICAL</b> a. Schematic and circuit diagrams. b. Certificates of conformity (to include EMC Directive 89/336/EEC). c. Hazardous area certification.
	1	
	1	
10.		<b>INSTRUMENTATION</b> a. Certificates of conformity (to include EMC Directive 89/336/EEC). b. Calibration certificates. c. Hazardous area certification.
11.		<b>SPECIAL REQUIREMENTS</b> Year 2000 Certificate of Compliance

**IMPORTANT NOTICE:**

Vendors acceptance of this order is conditional on the provision of the Documentation.

Should the vendor not wish to supply the whole or part of the details herein requested, he shall state in writing any exceptions with the quotation or order acceptance.

P & I Design reserve the right to cancel any order where the documentation does not comply with P & I requirements. No item will be paid in full until documentation specified has been received.

**P & I Design Ltd.**

**Instrument Specification**

<b>CLIENT:</b> Simon Storage (Immingham East)	<b>REV</b> <b>DATE</b> <b>BY</b> <b>CHKD</b> <b>APPD</b> <b>CLIENT REF.</b> A   08.04.99   AJH   DRR   DRR   FINA Rail Loading <b>P &amp; I REF.</b> SI039015.SPC <b>SHT 1 OF 3</b>
--	---

<b>ITEM</b>	Control Panel	
<b>GENERAL</b>	Specification	See Specification PNL-##A2.SPC Manufacture of Instrument Control Cubicles & Panels
	Tag Number	N/A
	Service	FINA DERV Rail Loading Logic Panel
	Area Classification	Safe Area
<b>MECHANICAL</b>	Refer to Drawing Number	SI039016
	Type	RITTAL ES 5084.600
	Panel	
	IP Rating	55
	Dimensions	1000(W) x 1800(H) x 400(D) + 100(H) plinth.
	Colour	
	Internal	RAL7032
	External	RAL7032
	Mounting Plates	Unpainted Aluminium
	Plinth	Black
	Gland Plates	
	Location	Bottom
	Number	1
	Dimensions	875(W) x 275(D)
<b>TERMINATION</b>	Terminals	
	Type	
	DC Fused	N/A
	AC Fused	N/A
	DC Power Distribution	Klippon ASK1
	AC Power Distribution	Klippon ASK1
	Earth	EK2.5 & Earth Bars
	Digital Signals	Klippon SAKR
	Analogue Signals	N/A
	Thermocouples	N/A
	Screen Earth Bar	Screen Earth Bar & 20ZB4 Earth Clamps
	Crimps	
	Type	Twin Grip
	Ferrules	
	Type	Critchley Z type
	Tube fittings	
	Type	N/A
<b>TUBE</b>	Type	
	Size	
	Supply	N/A
	Input/Output	N/A

**CLIENT:**  
Simon Storage (Immingham East)

**REV DATE BY CHKD APPD**  
A 08.04.99 AJH DRR DRR

**CLIENT REF.**  
FINA Rail Loading  
**P & I REF.**  
SI039015.SPC  
**SHT 2 OF 3**

<b>ITEM</b>	Control Panel	
<b>CABLE</b>	Type	Stranded copper conductors to BS6231
	Electrical 440V/240V ac	
	Size	Suitably rated with minimum 2.5mm <sup>2</sup>
	Colour	Phase Colours
	Instrument 240V ac Supplies	
	Size	Minimum 1.5mm <sup>2</sup>
	Colour	
	Live	Brown
	Neutral	Blue
	Earth	Green/Yellow
	Instrument 110V ac Supplies	
	Size	Minimum 1.5mm <sup>2</sup>
	Colour	
	Live	N/A
	Neutral	N/A
	Earth	N/A
	24V dc Supplies	
	Size	Suitably rated with minimum 1mm <sup>2</sup>
	Colour	
	Positive	Red
	0V.	Black
	Digital switched ac	
	Size	1.5mm <sup>2</sup>
	Colour	Brown
	Digital switched dc	
	Size	1.0mm <sup>2</sup>
	Colour	White
	Analogue	
	Size	N/A
	Colour	N/A
	PLC I/O Multicore	
	No. of Cores	N/A
	Size	N/A
	Thermocouple Compensating	
	Type	N/A
	Size	N/A

**OPTIONS**

**MANUFACTURERS DATA** Supplier Armah – RITTAL ES5084.600

**DOCUMENTATION** See attached Documentation Specification

**CLIENT:**  
Simon Storage (Immingham East)

**REV DATE BY CHKD APPD**  
A 08.04.99 AJH DRR DRR

**CLIENT REF.**  
FINA Rail Loading  
**P & I REF.**  
SI039015.SPC  
**SHT 3 OF 3**

<u>Item</u>	<u>Quantity</u>	<u>Description</u>
1.		<b>APPROVAL DOCUMENTATION</b> To be supplied before manufacture commences
2.		<b>GENERAL ARRANGEMENT DRAWING</b> Cross-sectioned to show all details necessary for repair and maintenance purposes.
3.		<b>MATERIALS TEST CERTIFICATES</b> a. Mechanical. b. Chemical analysis.
4.		<b>ITEMISED PARTS LIST</b> Cross-referenced with G.A. drawing(s) and illustrating manufacturers references for all proprietary items such as bearings, oilseals, mechanical seals, etc.
5.		<b>RECOMMEND SPARES QUOTATION</b> a. Two years service. b. Commissioning only.
6.		<b>INSTALLATION, OPERATING AND MAINTENANCE MANUALS</b> To include calibration instructions where applicable.
7.		<b>SOFTWARE</b> a. Programming manual. b. Operating manual.
8.		<b>PRESSURE VESSELS</b> Calculation sheets, spark test certificates (for lined vessels),hydraulic test certificates.
9.		<b>ELECTRICAL</b> a. Schematic and circuit diagrams. b. Certificates of conformity (to include EMC Directive 89/336/EEC). c. Hazardous area certification.
	1	
10.		<b>INSTRUMENTATION</b> a. Certificates of conformity (to include EMC Directive 89/336/EEC). b. Calibration certificates. c. Hazardous area certification.
11.		<b>SPECIAL REQUIREMENTS</b> Year 2000 Certificate of Compliance

**IMPORTANT NOTICE:**

Vendors acceptance of this order is conditional on the provision of the Documentation.  
Should the vendor not wish to supply the whole or part of the details herein requested, he shall state in writing any exceptions with the quotation or order acceptance.  
P & I Design reserve the right to cancel any order where the documentation does not comply with P & I requirements. No item will be paid in full until documentation specified has been received.

**P & I Design Ltd.**

**Instrument Specification**

<b>CLIENT:</b> Simon Storage (Immingham East)	<b>REV</b> <b>DATE</b> <b>BY</b> <b>CHKD</b> <b>APPD</b> <b>CLIENT REF.</b> A   08.04.99   AJH   DRR   DRR   FINA Rail Loading <b>P &amp; I REF.</b> SI039016.SPC <b>SHT 1 OF 3</b>
--	---

<b>ITEM</b>	Control Panel	
<b>GENERAL</b>	Specification	See Specification PNL-##A2.SPC Manufacture of Instrument Control Cubicles & Panels
	Tag Number	N/A
	Service	FINA DERV Rail Loading Pump MCC
	Area Classification	Safe Area
<b>MECHANICAL</b>	Refer to Drawing Number	SI039009
	Type	TBA
	Panel	
	IP Rating	IP55
	Dimensions	TBA
	Colour	
	Internal	RAL7032
	External	RAL7032
	Mounting Plates	Unpainted Aluminium
	Plinth	N/A
	Gland Plates	
	Location	TBA
	Number	TBA
	Dimensions	TBA
<b>TERMINATION</b>	Terminals	
	Type	
	DC Fused	N/A
	AC Fused	GEC Redspot or equivalent
	DC Power Distribution	Klippon ASK1
	AC Power Distribution	Klippon ASK1
	Earth	EK2.5
	Digital Signals	Klippon SAKR
	Analogue Signals	N/A
	Thermocouples	N/A
	Screen Earth Bar	N/A
	Crimps	
	Type	Twin Grip
	Ferrules	
	Type	Critchley Z type
	Tube fittings	
	Type	N/A
<b>TUBE</b>	Type	
	Size	
	Supply	N/A
	Input/Output	N/A



**CLIENT:**  
Simon Storage (Immingham East)

**REV DATE BY CHKD APPD**  
A 08.04.99 AJH DRR DRR

**CLIENT REF.**  
FINA Rail Loading  
**P & I REF.**  
SI039016.SPC  
**SHT 2 OF 3**

<b>ITEM</b>	Control Panel	
<b>CABLE</b>	Type	Stranded copper conductors to BS6231
	Electrical 440V/240V ac	
	Size	Suitably rated with minimum 2.5mm <sup>2</sup>
	Colour	Phase Colours
	Instrument 240V ac Supplies	
	Size	Minimum 1.5mm <sup>2</sup>
	Colour	
	Live	Brown
	Neutral	Blue
	Earth	Green/Yellow
	Instrument 110V ac Supplies	
	Size	Minimum 1.5mm <sup>2</sup>
	Colour	
	Live	N/A
	Neutral	N/A
	Earth	N/A
	24V dc Supplies	
	Size	Suitably rated with minimum 1mm <sup>2</sup>
	Colour	
	Positive	Red
	0V.	Black
	Digital switched ac	
	Size	1.5mm <sup>2</sup>
	Colour	Brown
	Digital switched dc	
	Size	1.0mm <sup>2</sup>
	Colour	White
	Analogue	
	Size	N/A
	Colour	N/A
	PLC I/O Multicore	
	No. of Cores	N/A
	Size	N/A
	Thermocouple Compensating	
	Type	N/A
	Size	N/A

**OPTIONS**

**MANUFACTURERS DATA** Supplier Armah – TBA

**DOCUMENTATION** See attached Documentation Specification

**CLIENT:**  
Simon Storage (Immingham East)

**REV DATE BY CHKD APPD**  
A 08.04.99 AJH DRR DRR

**CLIENT REF.**  
FINA Rail Loading  
**P & I REF.**  
SI039016.SPC  
**SHT 3 OF 3**

<u>Item</u>	<u>Quantity</u>	<u>Description</u>
1.		<b>APPROVAL DOCUMENTATION</b> To be supplied before manufacture commences
2.		<b>GENERAL ARRANGEMENT DRAWING</b> Cross-sectioned to show all details necessary for repair and maintenance purposes.
3.		<b>MATERIALS TEST CERTIFICATES</b> a. Mechanical. b. Chemical analysis.
4.		<b>ITEMISED PARTS LIST</b> Cross-referenced with G.A. drawing(s) and illustrating manufacturers references for all proprietary items such as bearings, oilseals, mechanical seals, etc.
5.		<b>RECOMMEND SPARES QUOTATION</b> a. Two years service. b. Commissioning only.
6.		<b>INSTALLATION, OPERATING AND MAINTENANCE MANUALS</b> To include calibration instructions where applicable.
7.		<b>SOFTWARE</b> a. Programming manual. b. Operating manual.
8.		<b>PRESSURE VESSELS</b> Calculation sheets, spark test certificates (for lined vessels),hydraulic test certificates.
9.	1	<b>ELECTRICAL</b> a. Schematic and circuit diagrams. b. Certificates of conformity (to include EMC Directive 89/336/EEC). c. Hazardous area certification.
10.		<b>INSTRUMENTATION</b> a. Certificates of conformity (to include EMC Directive 89/336/EEC). b. Calibration certificates. c. Hazardous area certification.
11.		<b>SPECIAL REQUIREMENTS</b> Year 2000 Certificate of Compliance

**IMPORTANT NOTICE:**

Vendors acceptance of this order is conditional on the provision of the Documentation.  
Should the vendor not wish to supply the whole or part of the details herein requested, he shall state in writing any exceptions with the quotation or order acceptance.  
P & I Design reserve the right to cancel any order where the documentation does not comply with P & I requirements. No item will be paid in full until documentation specified has been received.



***P & I Design Ltd.***

***Instrument Specification***

**CLIENT:**  
Simon Storage (Immingham East)

REV	DATE	BY	CHKD	APPD
A	15/04/99	AJH	DRR	DRR

**CLIENT REF.**  
FINA Rail Loading  
**P & I REF.**  
SI039017.SPC  
**SHT 2 OF 3**

Box 1 to be fitted with label:

**MUX 1&2 PANEL**

Box 2 to be fitted with label:

**MUX 3&4 PANEL**

Both panels to be fitted with labels indicating I.S. circuits together with the EEx'e' certification label.

**CLIENT:**  
Simon Storage (Immingham East)

**REV DATE BY CHKD APPD**  
A 15/04/99 AJH DRR DRR

**CLIENT REF.**  
FINA Rail Loading  
**P & I REF.**  
SI039017.SPC  
**SHT 3 OF 3**

<u>Item</u>	<u>Quantity</u>	<u>Description</u>
1.		<b>APPROVAL DOCUMENTATION</b> To be supplied before manufacture commences
2.		<b>GENERAL ARRANGEMENT DRAWING</b> Cross-sectioned to show all details necessary for repair and maintenance purposes.
3.		<b>MATERIALS TEST CERTIFICATES</b> a. Mechanical. b. Chemical analysis.
4.		<b>ITEMISED PARTS LIST</b> Cross-referenced with G.A. drawing(s) and illustrating manufacturers references for all proprietary items such as bearings, oilseals, mechanical seals, etc.
5.		<b>RECOMMEND SPARES QUOTATION</b> a. Two years service. b. Commissioning only.
6.		<b>INSTALLATION, OPERATING AND MAINTENANCE MANUALS</b> To include calibration instructions where applicable.
7.		<b>SOFTWARE</b> a. Programming manual. b. Operating manual.
8.		<b>PRESSURE VESSELS</b> Calculation sheets, spark test certificates (for lined vessels),hydraulic test certificates.
9.		<b>ELECTRICAL</b> a. Schematic and circuit diagrams. b. Certificates of conformity (to include EMC Directive 89/336/EEC). c. Hazardous area certification.
	1	
	1	
10.		<b>INSTRUMENTATION</b> a. Certificates of conformity (to include EMC Directive 89/336/EEC). b. Calibration certificates. c. Hazardous area certification.
11.		<b>SPECIAL REQUIREMENTS</b> Year 2000 Certificate of Compliance

**IMPORTANT NOTICE:**

Vendors acceptance of this order is conditional on the provision of the Documentation.

Should the vendor not wish to supply the whole or part of the details herein requested, he shall state in writing any exceptions with the quotation or order acceptance.

P & I Design reserve the right to cancel any order where the documentation does not comply with P & I requirements. No item will be paid in full until documentation specified has been received.

**CLIENT:**  
Simon Storage  
ISCO East

**REV DATE BY CHKD APPD**  
A 09.09.10 DBF MM MM

**CLIENT REF.**

**P & I REF.**  
SI760001\_SPC  
SHT 1 OF 2

**ITEM:** Level Switch  
(Tuning Fork)

**GENERAL** Tag Number LS2-25  
Service Pump Dry Run Protection  
Area Classification Zone 1 IIB T4

**DETECTOR ELEMENT** Type Vibrating Fork  
Location Classification Zone 0 for wetted parts  
Material: Wetted Parts 316L Stainless Steel  
Seals n/a  
Connections: Size 2"  
Type Flanged  
Rating ANSI 150  
Mounting: Position Vertical  
Probe Length 200mm

**HOUSING** Material Aluminium housing with separate connection compartment  
Enclosure Class IP 66  
Electrical Classification ATEX II 1/2 G EEx de IIC T6  
Certificate Reference KEMA 00ATEX2035  
Electrical Connection M20

**TRANSMISSION** Type Relay output  
Supply 19-253V ac, 19-55 Vdc  
Output 2 x Relay, SP Changeover  
Load I max 6 Amps  
Action De-energise on alarm (uncovered) & power failure  
Electrical Connection Terminals  
Insert FEL 54

**OPTIONS** 1) Temperature Spacer

**PROCESS DATA** Fluid Light Oils  
Temperature Max./Min. 65°C / 0°C  
Temperature Normal. Ambient  
Pressure Max./Min. 10 Barg / 0 Barg  
Pressure Normal. Up to 10 Barg  
Specific Gravity 0.9

**MANUFACTURERS DATA** Supplier Endress & Hauser  
Model Number FTL51-IAE2JB(200mm)4G7A

**DOCUMENTATION** See Attached Documentation Specification

**CLIENT:**  
Simon Storage  
ISCO East

**REV DATE BY CHKD APPD**  
A 09.09.10 DBF MM MM

**CLIENT REF.**  
**P & I REF.**  
SI760001\_SPC  
SHT 2 OF 2

**Documentation Requirement**

<b>Item</b>	<b>Quantity</b>	<b>Description</b>
1.	n/a	<b>APPROVAL DOCUMENTATION</b> To be supplied before manufacture commences
2.	n/a	<b>GENERAL ARRANGEMENT DRAWING</b> Cross-sectioned to show all details necessary for repair and maintenance purposes.
3.	n/a n/a	<b>MATERIALS TEST CERTIFICATES</b> a. Mechanical. b. Chemical analysis.
4.	n/a	<b>ITEMISED PARTS LIST</b> Cross-referenced with G.A. drawing(s) and illustrating manufacturers references for all proprietary items such as bearings, oilseals, mechanical seals, etc.
5.	1 n/a	<b>RECOMMEND SPARES QUOTATION</b> a. Two years service. b. Commissioning only.
6.	1 1	<b>INSTALLATION, OPERATING AND MAINTENANCE MANUALS</b> To include calibration instructions where applicable. a. Paper Copy b. Electronic copy (Preferably Adobe Acrobat)
7.	n/a n/a	<b>SOFTWARE</b> a. Programming manual. b. Operating manual.
8.	n/a	<b>PRESSURE VESSELS</b> Calculation sheets, spark test certificates (for lined vessels),hydraulic test certificates.
9.	n/a n/a n/a	<b>ELECTRICAL</b> a. Schematic and circuit diagrams. b. Certificates of conformity (to include EMC Directive 89/336/EEC). c. Hazardous area certification.
10.	1 n/a 1	<b>INSTRUMENTATION</b> a. Certificates of conformity (to include EMC Directive 89/336/EEC). b. Calibration certificates. c. Hazardous area certification.
11.	-	<b>SPECIAL REQUIREMENTS</b> PFD Data for Safety Instrument Systems as defined in BS EN 61508 & BS EN 61511

**IMPORTANT NOTICE:**

**Vendors acceptance of this order is conditional on the provision of the Documentation.**

**Should the vendor not wish to supply the whole or part of the details herein requested, he shall state in writing any exceptions with the quotation or order acceptance.**

**P & I Design reserve the right to cancel any order where the documentation does not comply with P & I requirements. No item will be paid in full until documentation specified has been received.**

**P & I Design Ltd.**

**Instrument Specification**

**CLIENT:**  
Immingham Storage Co Ltd  
ISCo East Terminal

REV	DATE	BY	CHKD	APPD
A	14/09/10	DBF	MM	MM
B	23/12/10	DBF	MM	MM

**CLIENT REF.**  
4 East Rail Gantry  
**P & I REF.**  
SI760002\_SPC  
**SHT 1 OF 3**

**ITEM:** Solenoid Valve  
Direct

**GENERAL** Tag Number See Sheet No. 2  
Service See Sheet No. 2  
Area Classification Zone 1 IIB T4

**BODY** Type Direct  
Number of Ways 3/2  
Action Spring Return, Internal Pilot Air Feed  
Construction Aluminium Body, Brass Jet, Stainless Steel Spring.  
Connections:Size/Type 1/8" BSP (0.06 Cv, 62 L/min)  
Mounting Remote

**SOLENOID** Type Class F Coil  
Voltage 24 VDC  
Enclosure Class IP66  
Electrical Classification Ex II 2 G EExd IIC T6  
B ATEX Certification Baseefa 06 ATEX 0123  
Electrical Connection M20 x 1.5

**OPTIONS** No Options

**PROCESS DATA** Fluid Air  
Pressure Max. 8 Bar  
Oper. Diff. Max./Min. 3 to 8 Bar  
Temperature Oper. Ambient

**MANUFACTURERS DATA** B Supplier RGS  
Model Number E13AX0D00BA

**DOCUMENTATION** See Attached Documentation Specification



**CLIENT:**

Immingham Storage Co Ltd  
ISCo East Terminal

REV	DATE	BY	CHKD	APPD
A	14/09/10	DBF	MM	MM
B	23/12/10	DBF	MM	MM

**CLIENT REF.**

4 East Rail Gantry

**P & I REF.**

SI760002\_SPC

**SHT 2 OF 3**

**COMMENTS**

**TAG No.**

XSV1  
XSV2  
XSV3  
XSV4  
XSV5  
XSV6  
XSV7  
XSV8  
XSV9  
XSV10  
XSV11  
XSV12  
XSVESD

**SERVICE**

4 East Rail Gantry North Siding Loading Point 1  
4 East Rail Gantry North Siding Loading Point 2  
4 East Rail Gantry North Siding Loading Point 3  
4 East Rail Gantry North Siding Loading Point 4  
4 East Rail Gantry North Siding Loading Point 5  
4 East Rail Gantry North Siding Loading Point 6  
4 East Rail Gantry South Siding Loading Point 7  
4 East Rail Gantry South Siding Loading Point 8  
4 East Rail Gantry South Siding Loading Point 9  
4 East Rail Gantry South Siding Loading Point 10  
4 East Rail Gantry South Siding Loading Point 11  
4 East Rail Gantry South Siding Loading Point 12  
4 East Rail Gantry ESD

**Revision History**

Rev A	Original Issue
Rev B	ATEX Update


<b>CLIENT:</b> Immingham Storage Co Ltd ISCo East Terminal	<b>REV</b> A B	<b>DATE</b> 14/09/10 23/12/10	<b>BY</b> DBF DBF	<b>CHKD</b> MM MM	<b>APPD</b> MM MM	<b>CLIENT REF.</b> 4 East Rail Gantry <b>P &amp; I REF.</b> SI760002_SPC SHT 3 OF 3
--	----------------------	-------------------------------------	-------------------------	-------------------------	-------------------------	---

**Documentation Requirement**

<b>Item</b>	<b>Quantity</b>	<b>Description</b>
1.	n/a	<b>APPROVAL DOCUMENTATION</b> To be supplied before manufacture commences
2.	n/a	<b>GENERAL ARRANGEMENT DRAWING</b> Cross-sectioned to show all details necessary for repair and maintenance purposes.
3.	n/a n/a	<b>MATERIALS TEST CERTIFICATES</b> a. Mechanical. b. Chemical analysis.
4.	n/a	<b>ITEMISED PARTS LIST</b> Cross-referenced with G.A. drawing(s) and illustrating manufacturers references for all proprietary items such as bearings, oilseals, mechanical seals, etc.
5.	1	<b>RECOMMEND SPARES QUOTATION</b> a. Two years service. b. Commissioning only.
6.	1	<b>INSTALLATION, OPERATING AND MAINTENANCE MANUALS</b> To include calibration instructions where applicable. 1 a. Paper Copy b. Electronic copy (Preferably Adobe Acrobat)
7.	n/a	<b>SOFTWARE</b> a. Programming manual. n/a b. Operating manual.
8.	n/a	<b>PRESSURE VESSELS</b> Calculation sheets, spark test certificates (for lined vessels),hydraulic test certificates.
9.	n/a n/a n/a	<b>ELECTRICAL</b> a. Schematic and circuit diagrams. b. Certificates of conformity (to include EMC Directive 89/336/EEC). c. Hazardous area certification.
10.	1 n/a 1	<b>INSTRUMENTATION</b> a. Certificates of conformity (to include EMC Directive 89/336/EEC). b. Calibration certificates. c. Hazardous area certification.
11.	n/a	<b>SPECIAL REQUIREMENTS</b>

**IMPORTANT NOTICE:**

Vendors acceptance of this order is conditional on the provision of the Documentation.  
Should the vendor not wish to supply the whole or part of the details herein requested, he shall state in writing any exceptions with the quotation or order acceptance.  
P & I Design reserve the right to cancel any order where the documentation does not comply with P & I requirements. No item will be paid in full until documentation specified has been received.

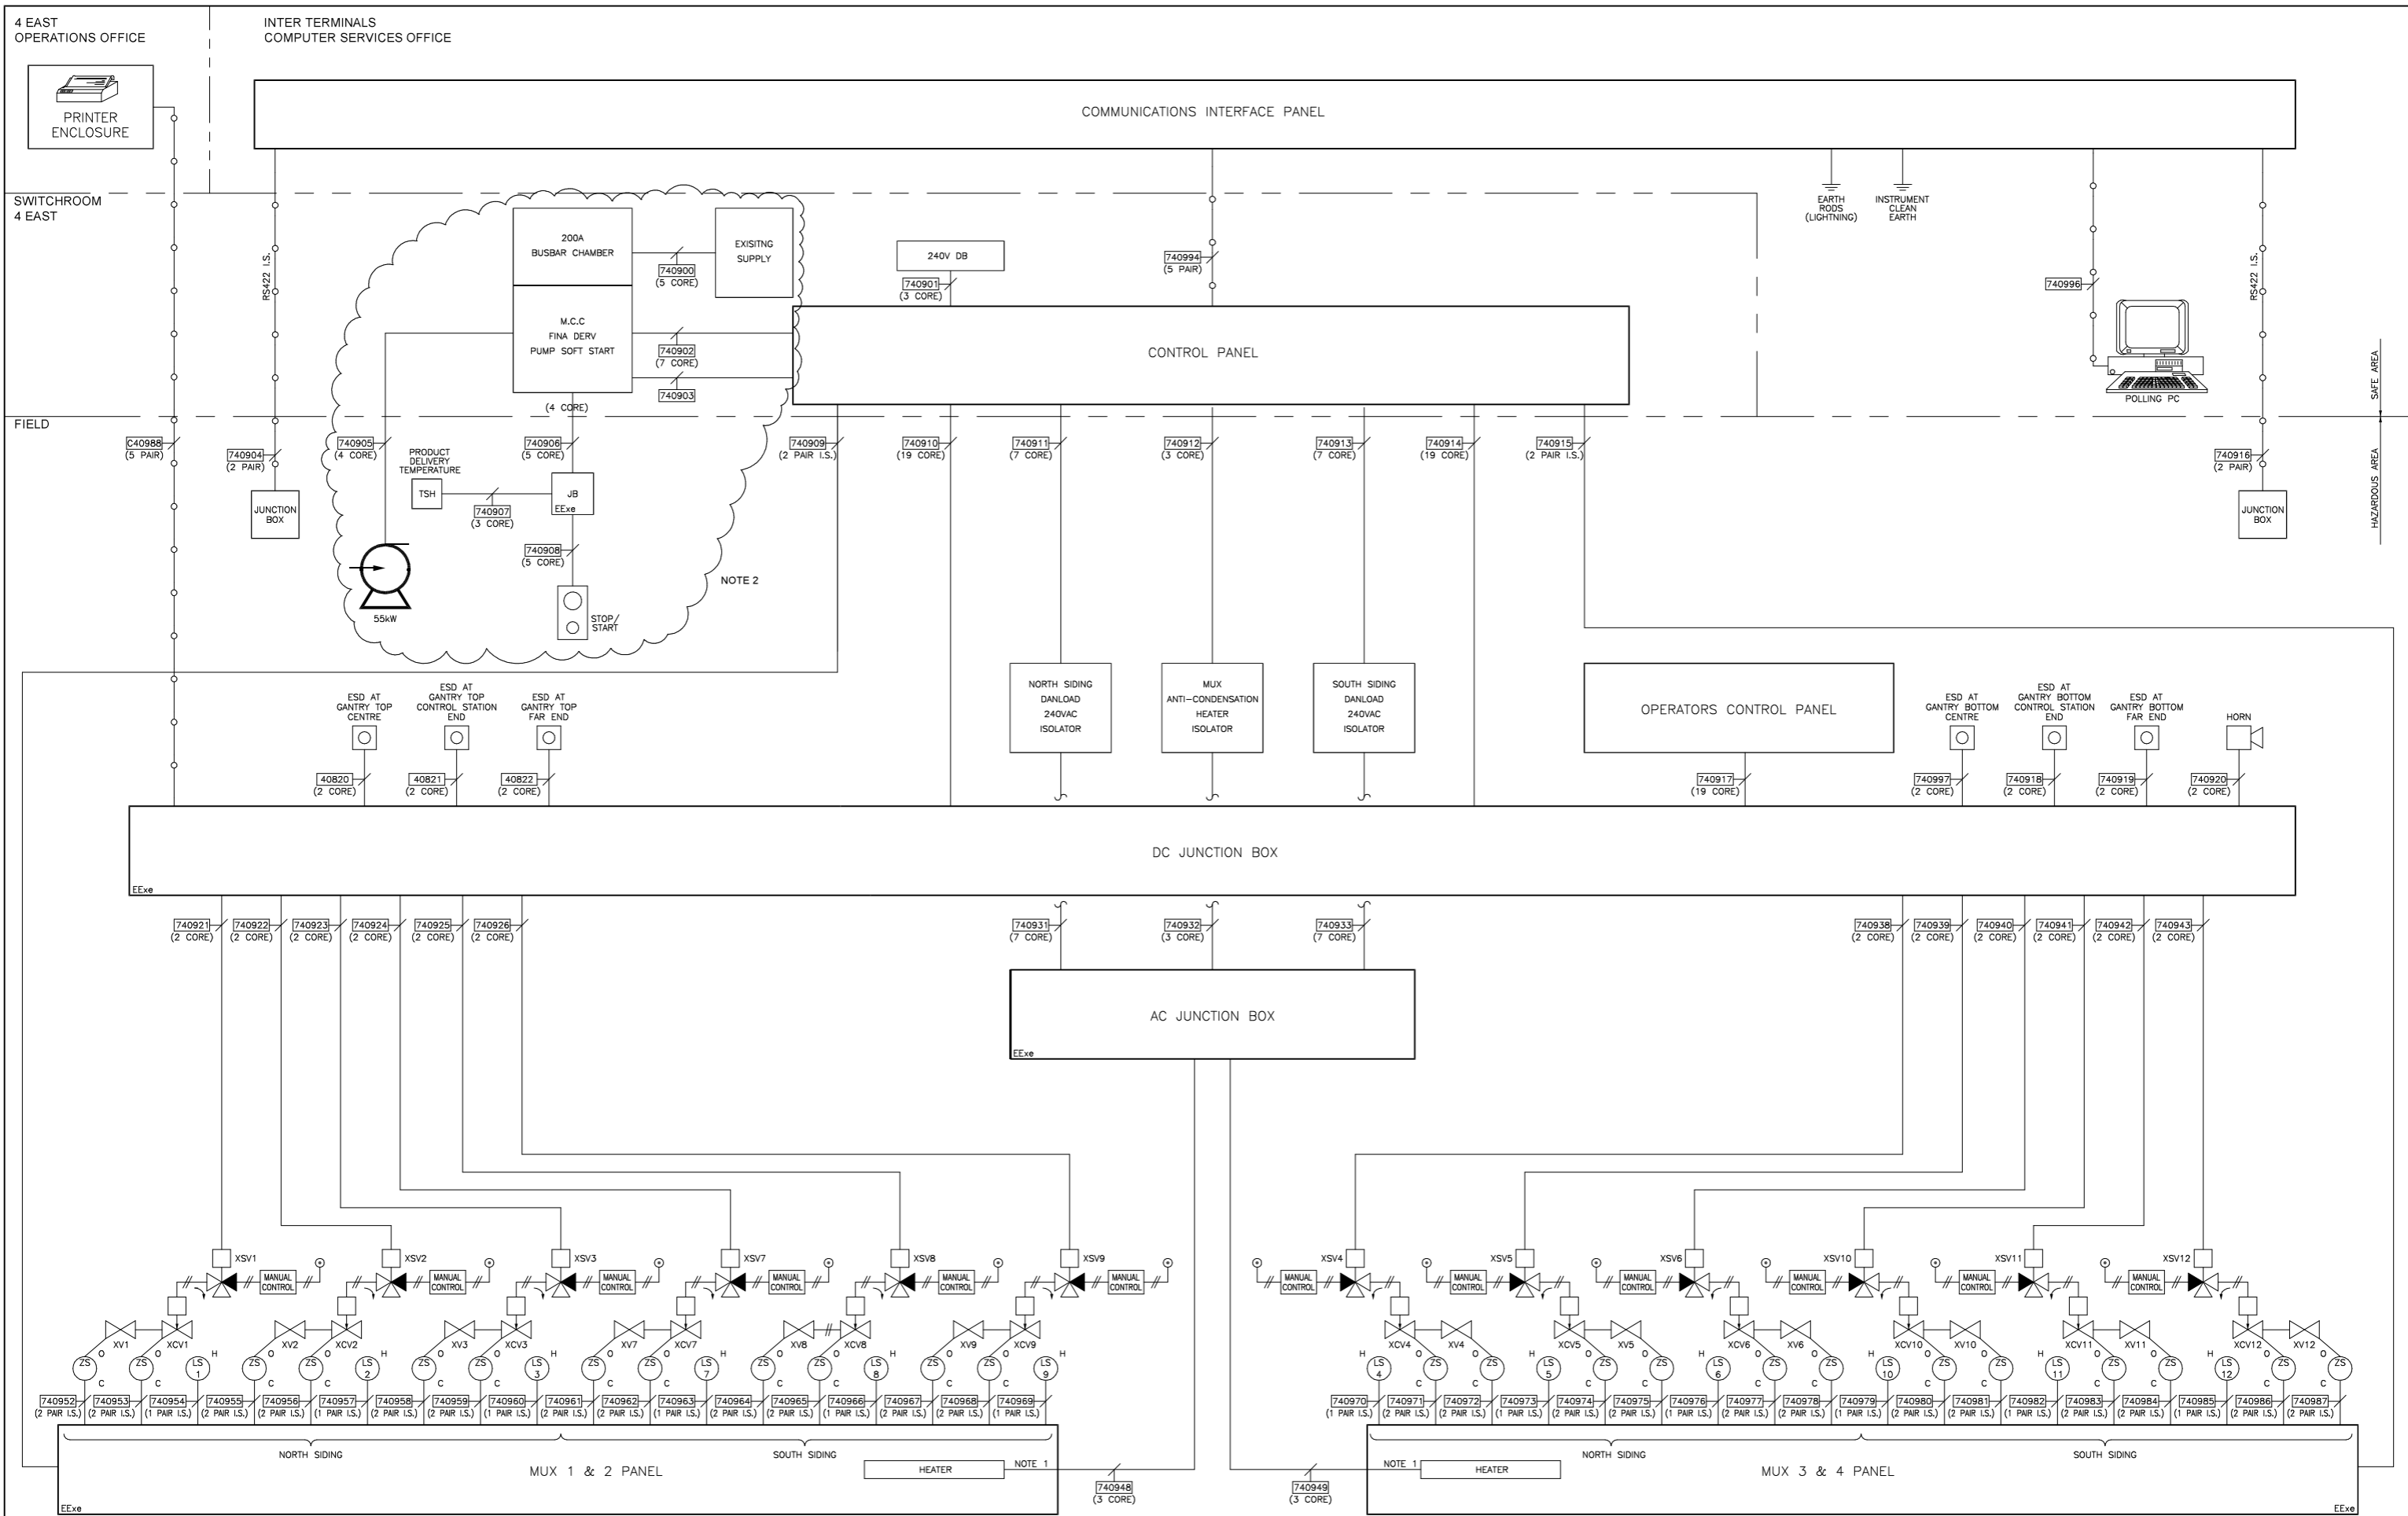


- NOTES
- VIA SAK2.5 EEx'e' TERMINALS
  - DECOMMISSIONED BATCHING SYSTEM.

IF NOT SIGNED THIS DOCUMENT IS UNCONTROLLED


REV	DATE	BY	DRN	CHK'D	APP'D	DESCRIPTION
A	18/02/99	D.R.R	A.J.H	P.J.P	P.J.P	ORIGINAL ISSUE
B	07/04/99	A.J.H	D.R.R	D.R.R	D.R.R	GENERAL UPDATE
C	02/07/99	D.P.	A.J.H	D.R.R	D.R.R	EARTH RODS UPDATED
D	17/09/10	D.B.F	P.P.	M.M.	M.M.	SI760 MODIFICATIONS
E	11/01/11	D.B.F	P.P.	M.M.	M.M.	AS BUILT
F	24/01/17	P.P.	P.P.	M.M.	M.M.	AS BUILT - 16062 PROJECT

PLANT	IMMINGHAM STORAGE Co. - EAST TERMINAL
TITLE	4-EAST RAIL LOADING SYSTEM OVERVIEW
Inter Terminals Immingham Ltd Immingham East Terminal N.E. Lincolnshire DN40 2QW	
CLIENT DRG. No.	P&I DRG No. SI039001_DWG


LEGEND OF GRAPHICAL SYMBOLS (ALL CONTACTS SHOWN IN THE DE-ENERGISED STATE)

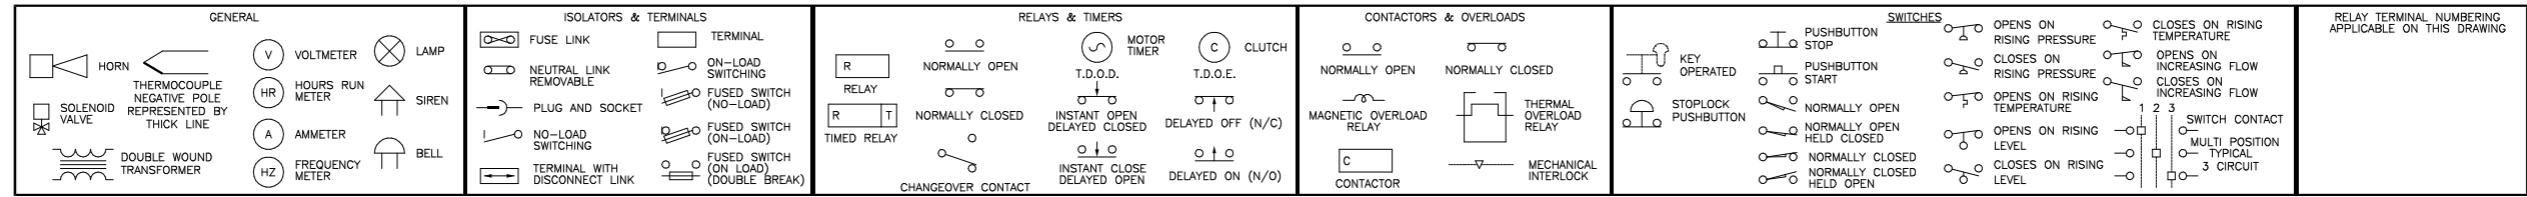


POWER DISTRIBUTION

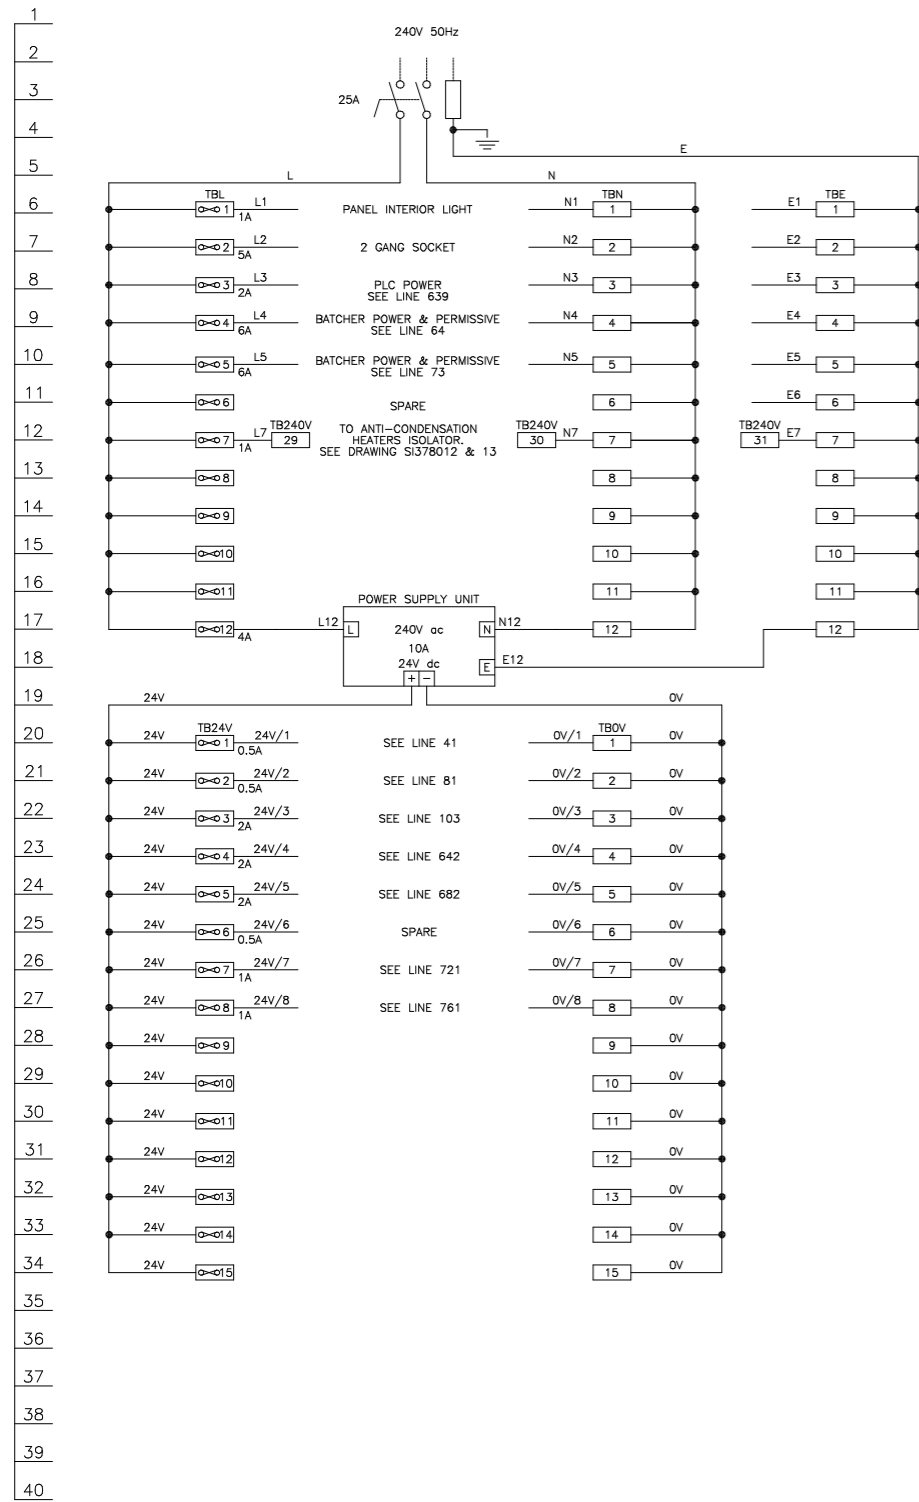


LEVEL

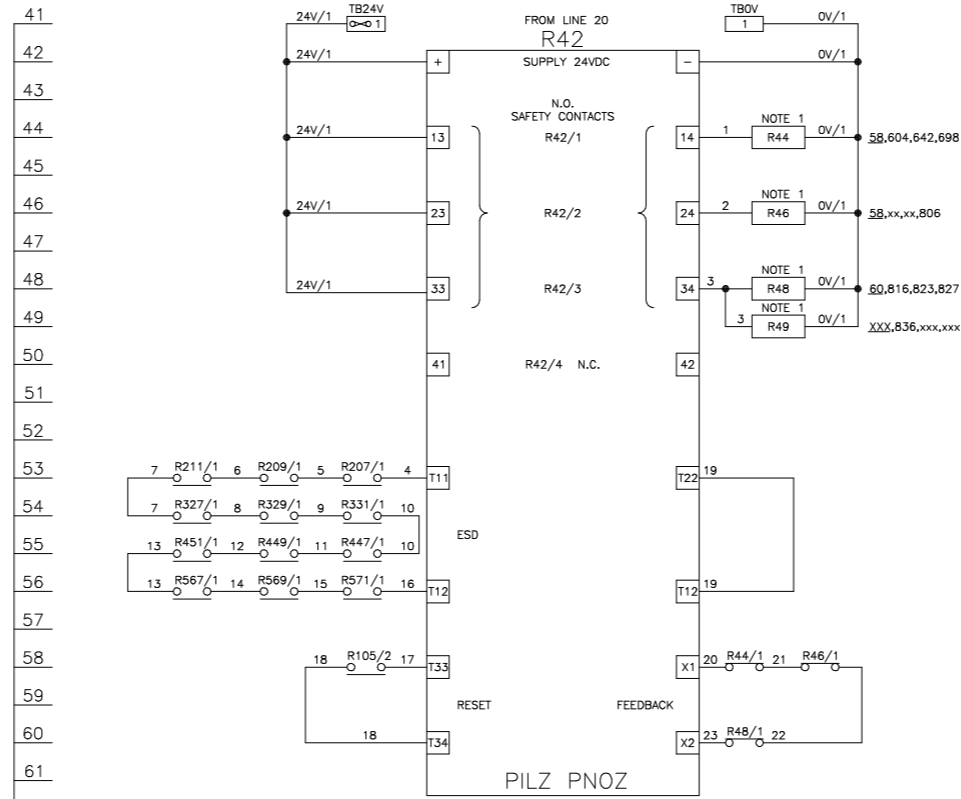


ESD

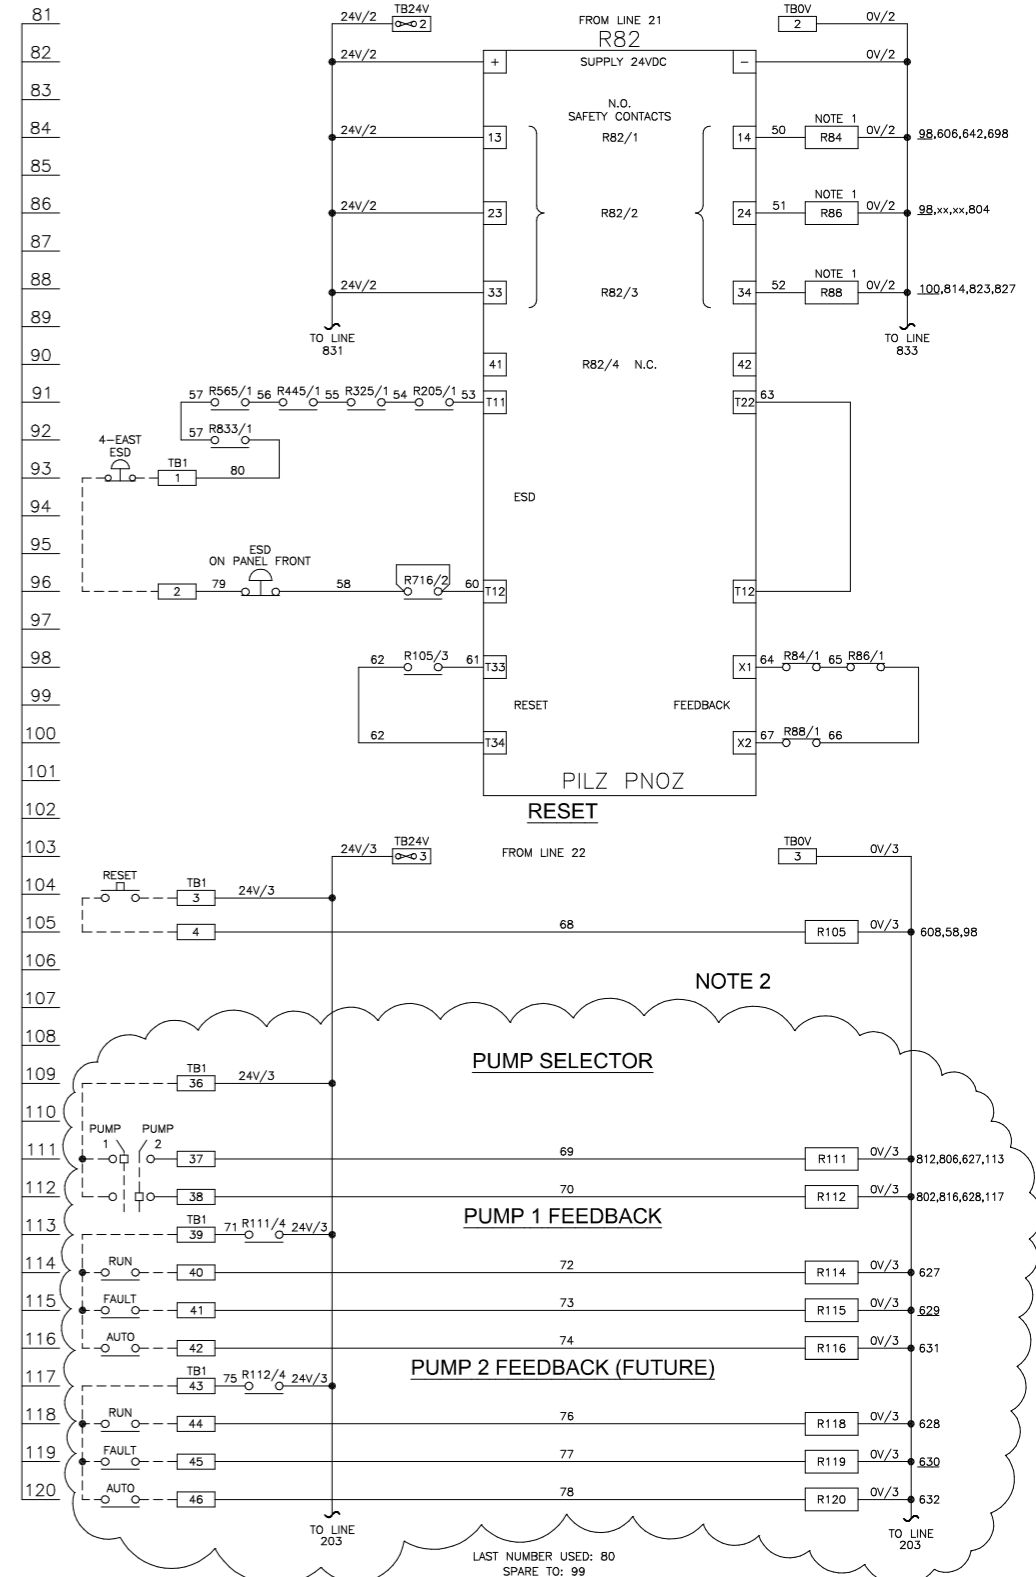

NORTH SIDING BATCHER POWER (240V)

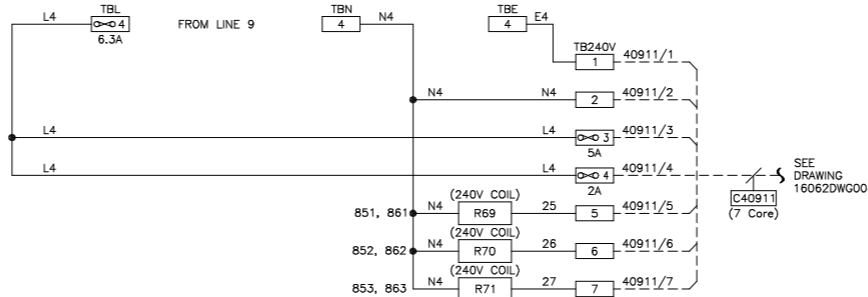

SOUTH SIDING BATCHER POWER (240V)

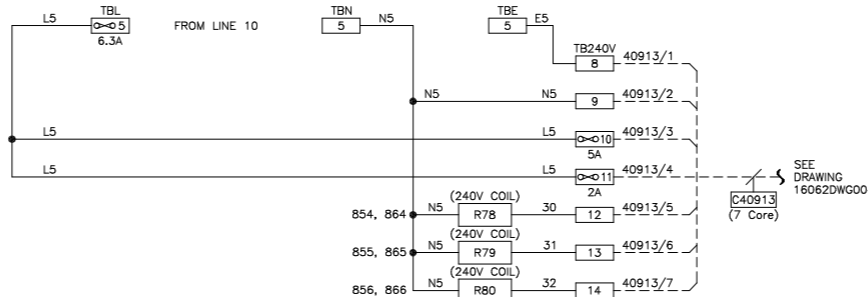

LAST NUMBER USED: 32  
SPARE TO: 49

LAST NUMBER USED: 80  
SPARE TO: 99

- NOTES**  
 1. OMRON G7S-4A2B GUIDED CONTACT RELAY (RS260-4373)  
 2. DECOMMISSIONED BATCHING SYSTEM. INPUTS NOT USED IN PLC

IF NOT SIGNED THIS DOCUMENT IS UNCONTROLLED

REV	DATE	BY	DRN	CHK'D	APP'D	DESCRIPTION
A	07/04/99	A.J.H.	A.J.H.	D.R.R.	D.R.R.	ORIGINAL ISSUE
B	14/03/99	A.J.H.	A.J.H.	D.R.R.	D.R.R.	GENERAL UPDATE
C	01/07/99	D.P.	A.J.H.	D.R.R.	D.R.R.	PANEL TEST MODS
D	14/09/10	D.B.F.	P.P.	M.M.	M.M.	SI760 MODIFICATIONS
E	11/01/11	D.B.F.	P.P.	D.B.F.	M.M.	AS BUILT
F	04/01/17	P.P.	P.P.	D.R.P.	M.M.	AS BUILT - 16062 PROJECT


PLANT	INTER TERMINALS IMMINGHAM LTD - EAST TERMINAL
TITLE	4-EAST RAIL LOADING SYSTEM PANEL LOGIC DRAWING 1
CLIENT DRG. No.	P&I DRG No. SI039002_DWG

inter terminals  
 Inter Terminals Immingham Ltd  
 Immingham East Terminal  
 Immingham Dock Immingham  
 N.E. Lincolnshire  
 DN40 2QW


P & I Design Ltd  
 Tel. 01642 617444  
 www.pidesign.co.uk

SHEET 1 OF 1

LEGEND OF GRAPHICAL SYMBOLS (ALL CONTACTS SHOWN IN THE DE-ENERGISED STATE)

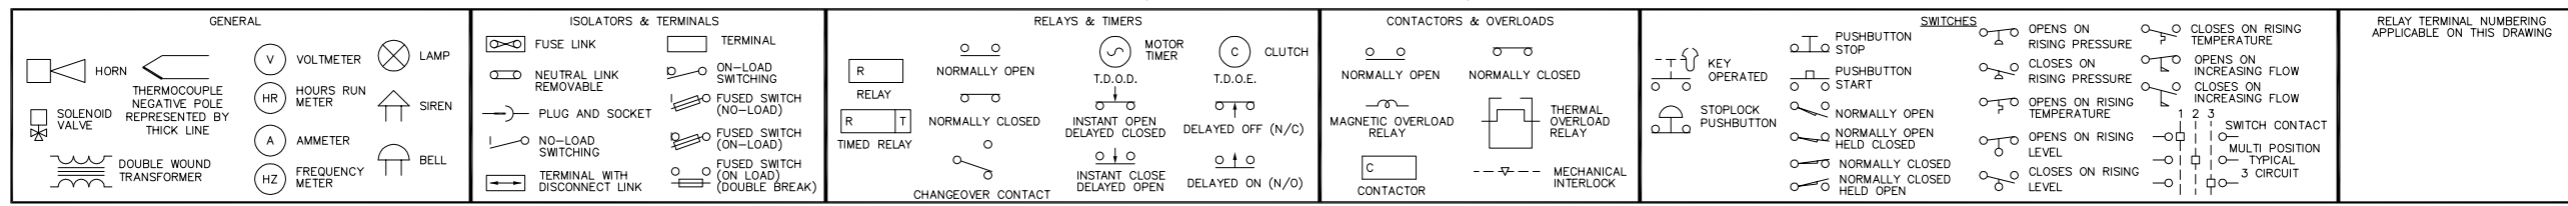

**MUX 1 (NORTH SIDING)**

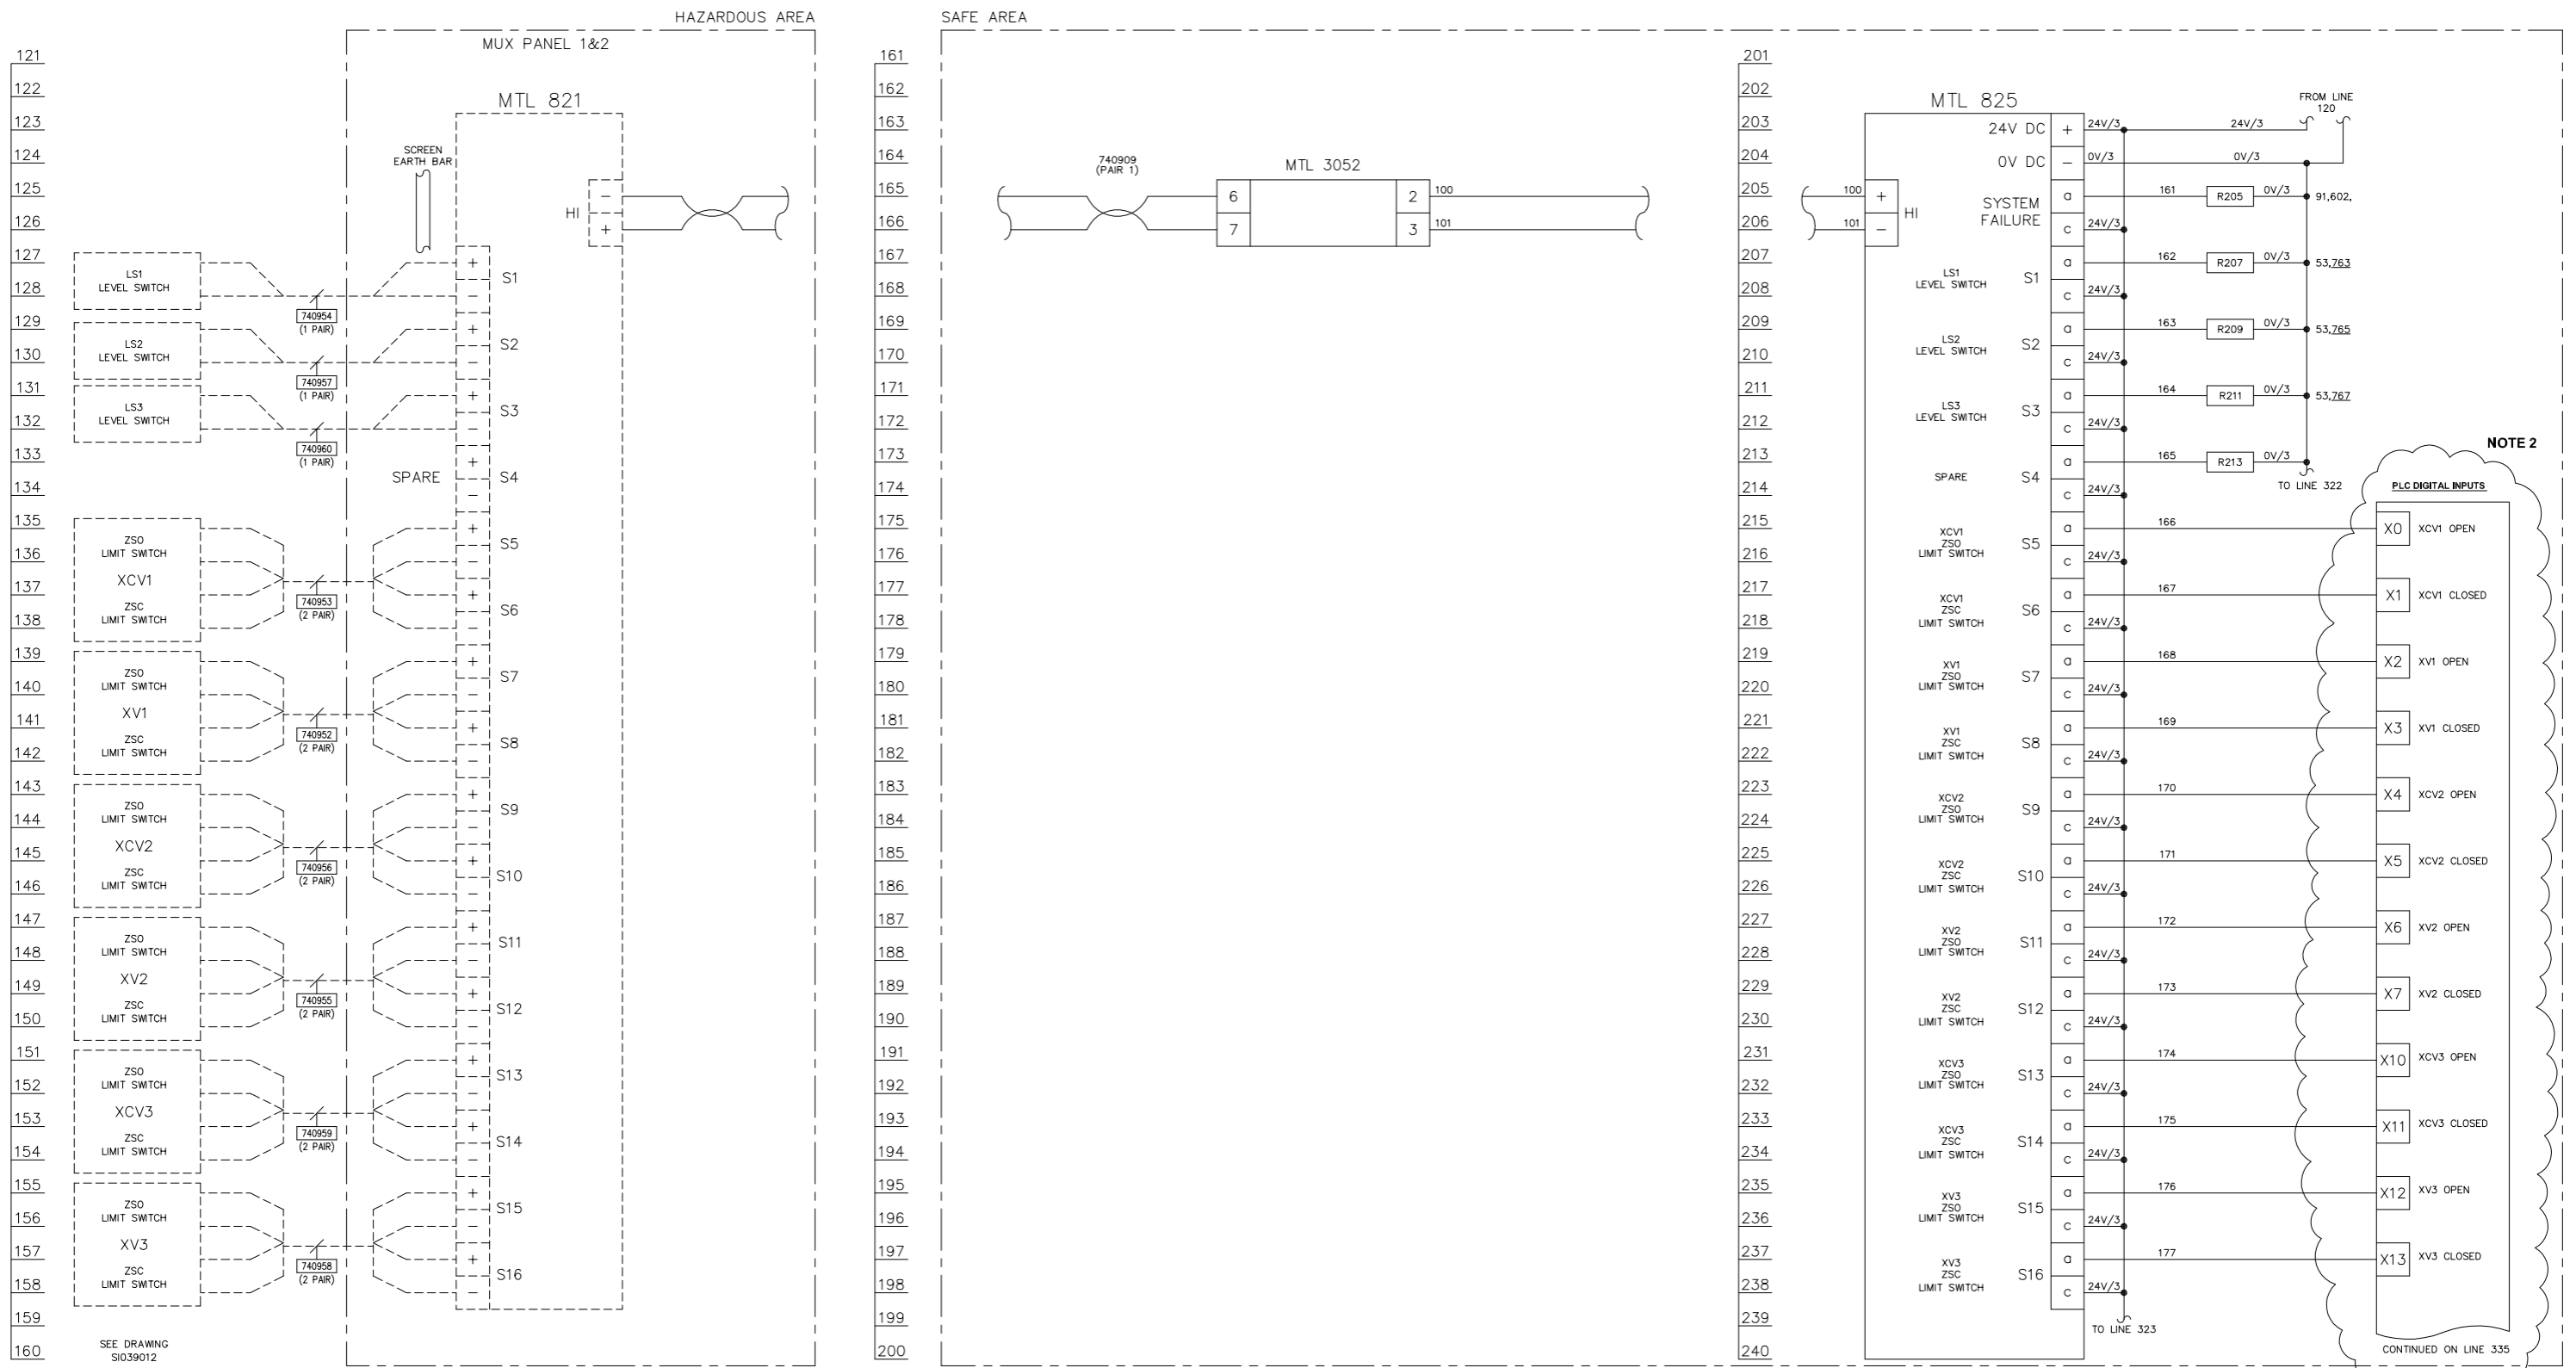

LAST NUMBER USED: 101  
 SPARE TO: 160

LAST NUMBER USED: 177  
 SPARE TO: 199

- NOTES**  
 1. SCREEN EARTHS NOT SHOWN FOR CLARITY.  
 2. DECOMMISSIONED BATCHING SYSTEM. INPUTS NOT USED IN PLC




IF NOT SIGNED THIS DOCUMENT IS UNCONTROLLED


REV	DATE	BY	DRN	CHK'D	APP'D	DESCRIPTION
A	07/04/99	A.J.H	A.J.H	D.R.R	D.R.R	ORIGINAL ISSUE
B	07/07/99	A.J.H	A.J.H	D.R.R	D.R.R	COMMS POLARITY REVERSED
C	14/09/10	D.B.F	P.P.	M.M.	M.M.	SI760 MODIFICATIONS

PLANT	IMMINGHAM STORAGE Co. - EAST TERMINAL
TITLE	4-EAST RAIL LOADING SYSTEM PANEL LOGIC DRAWING 2
CLIENT DRG. No.	IMMINGHAM STORAGE Co. Ltd. IMMINGHAM EAST TERMINAL, IMMINGHAM DOCK, IMMINGHAM, SOUTH HUMBERSIDE
P&I DESIGN	P & I Design Ltd Tel. 01642 617444 www.pidesign.co.uk
SHEET 1 OF 1	
P&I DRG No.	SI039003_DWG

LEGEND OF GRAPHICAL SYMBOLS (ALL CONTACTS SHOWN IN THE DE-ENERGISED STATE)

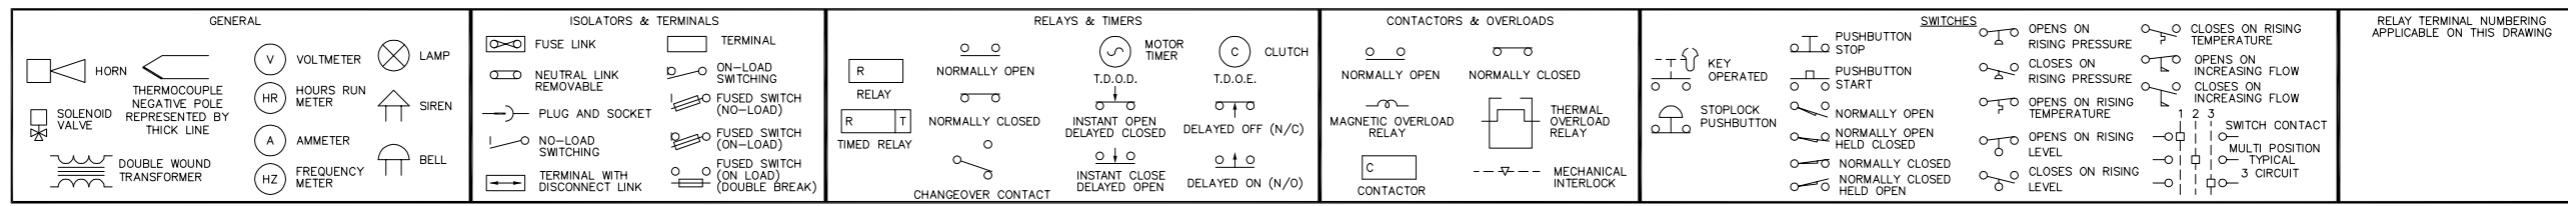

**MUX 2 (SOUTH SIDING)**

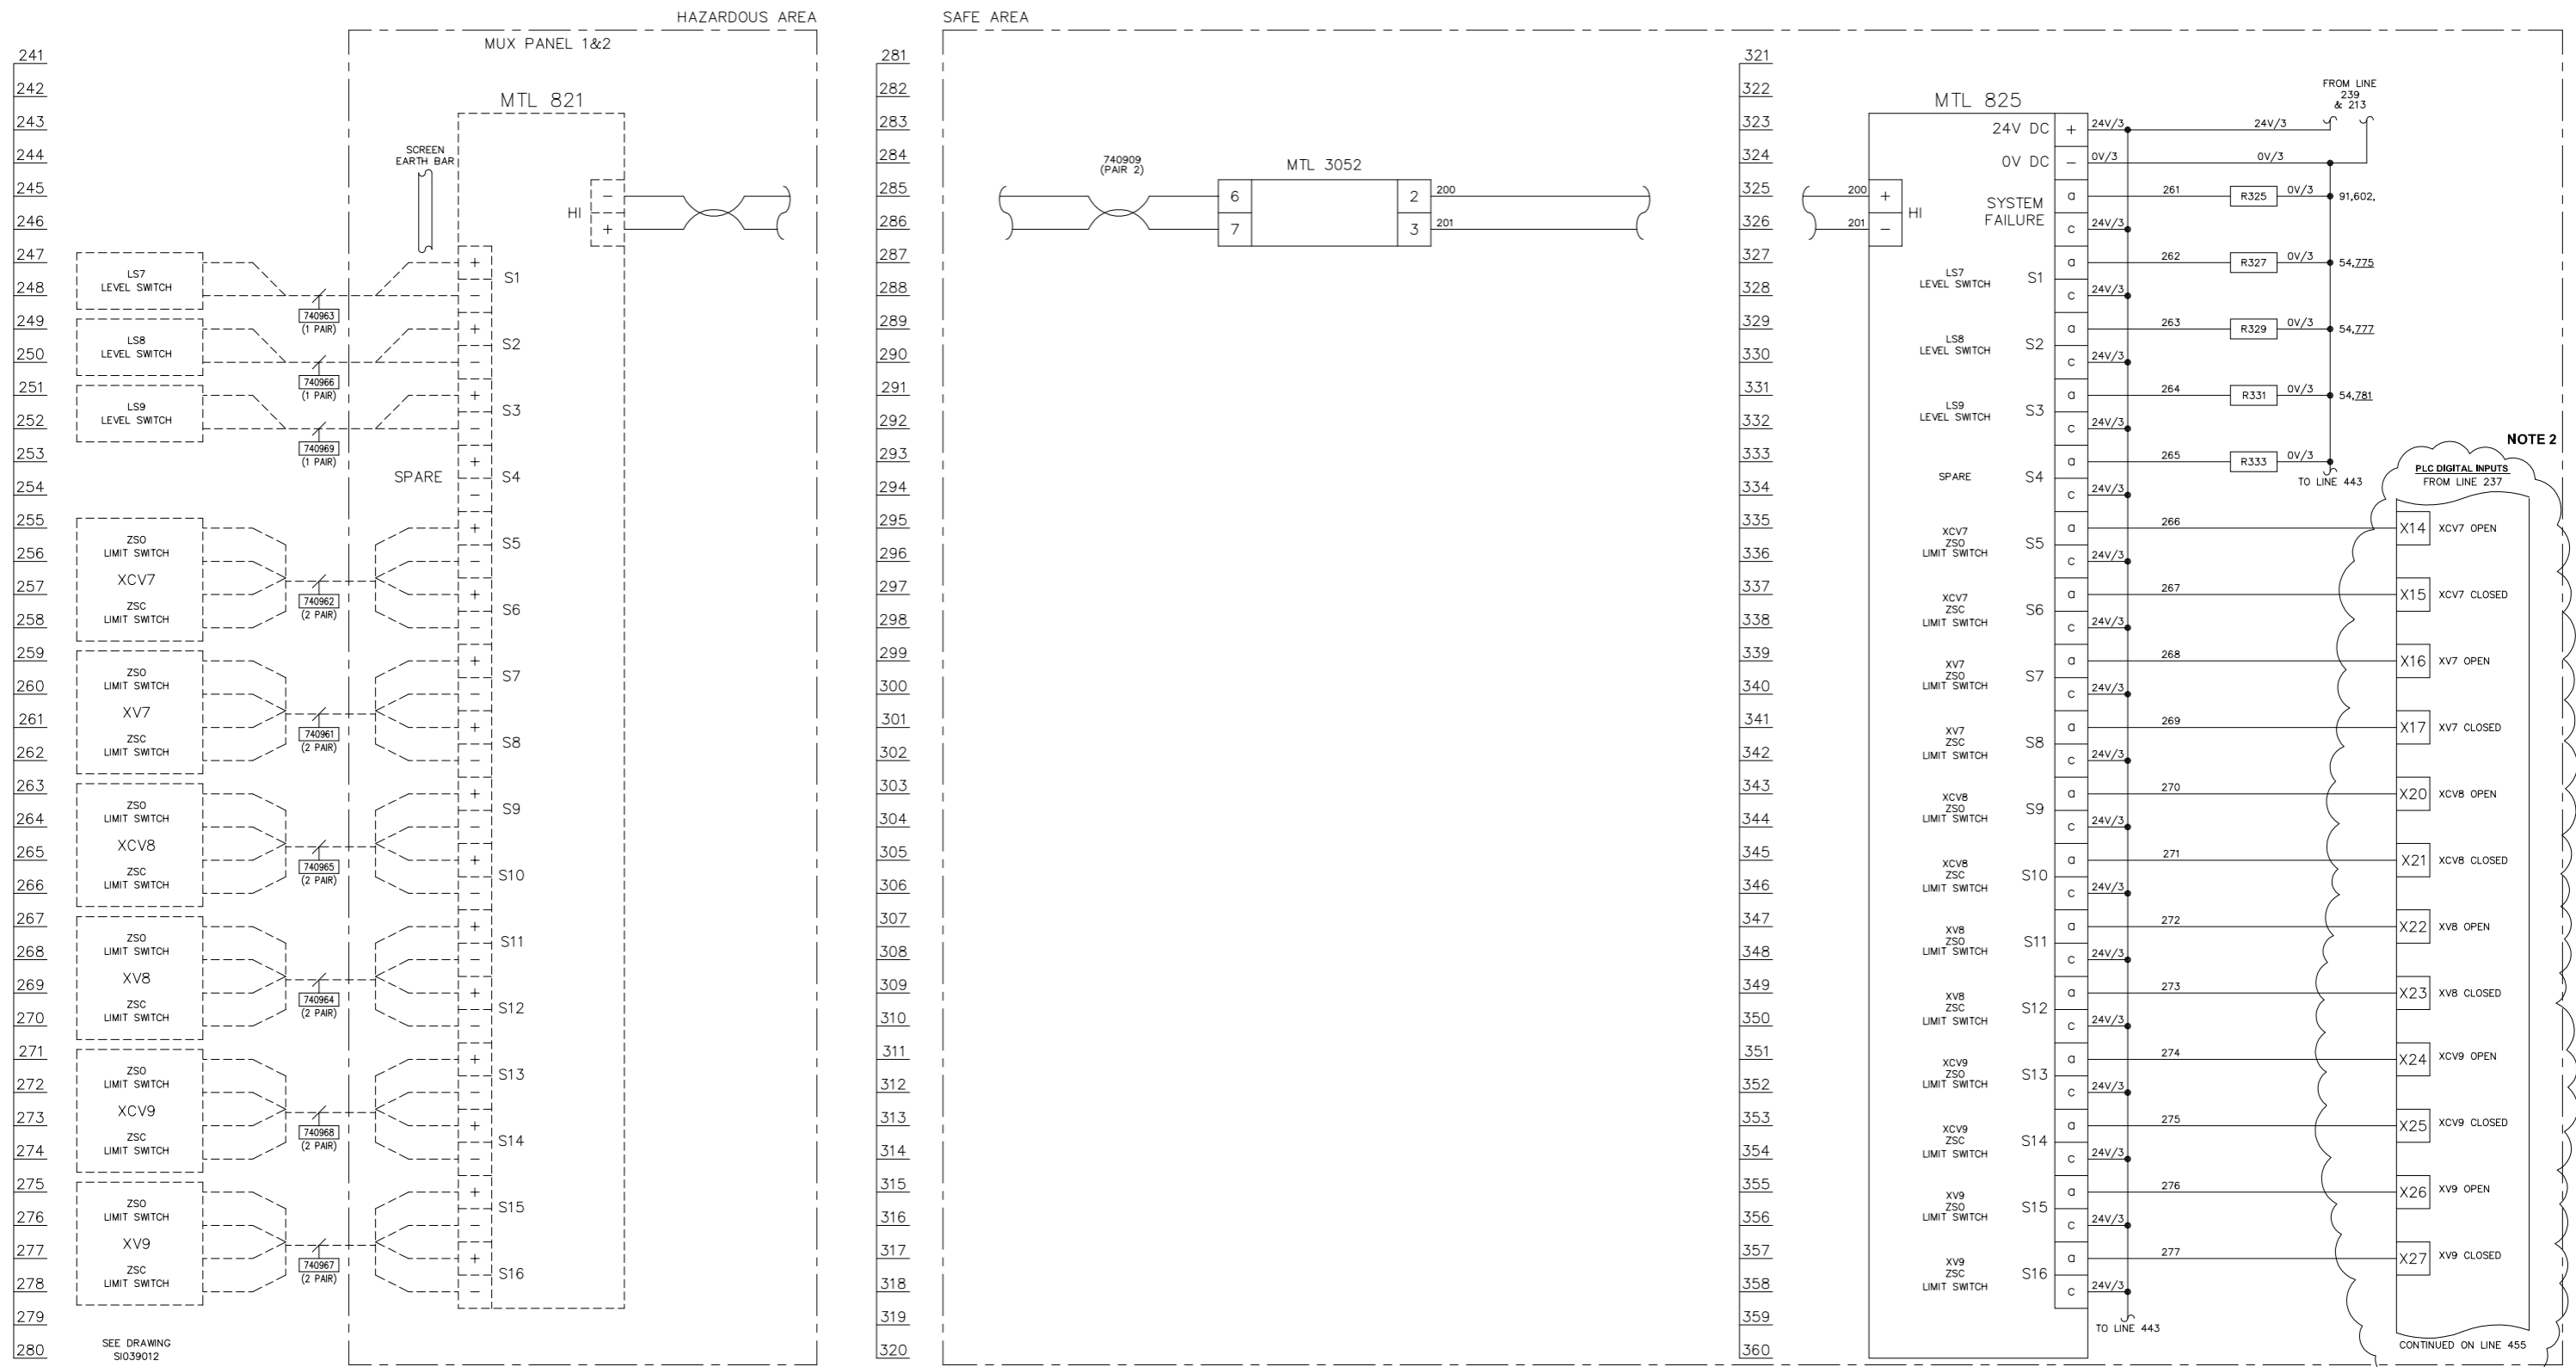


- NOTES**
- SCREEN EARTHS NOT SHOWN FOR CLARITY.
  - DECOMMISSIONED BATCHING SYSTEM. INPUTS NOT USED IN PLC




IF NOT SIGNED THIS DOCUMENT IS UNCONTROLLED						
REV	DATE	BY	DRN	CHK'D	APP'D	DESCRIPTION
A	04/03/99	A.J.H	A.J.H	P.J.P	P.J.P	D.R.R D.R.R ORIGINAL ISSUE
B	02/07/99	A.J.H	A.J.H	D.R.R	D.R.R	D.R.R D.R.R COMMS POLARITY REVERSED
C	14/09/10	D.B.F	P.P.	M.M.	M.M.	SI760 MODIFICATIONS

PLANT	IMMINGHAM STORAGE Co. - EAST TERMINAL
TITLE	4-EAST RAIL LOADING SYSTEM PANEL LOGIC DRAWING 3
CLIENT DRG. No.	P&I DESIGN P&I DESIGN Ltd Tel. 01642 617444 www.ptdesign.co.uk
	SHEET 1 OF 1
	P&I DRG No. SIO39004_DWG

LEGEND OF GRAPHICAL SYMBOLS (ALL CONTACTS SHOWN IN THE DE-ENERGISED STATE)

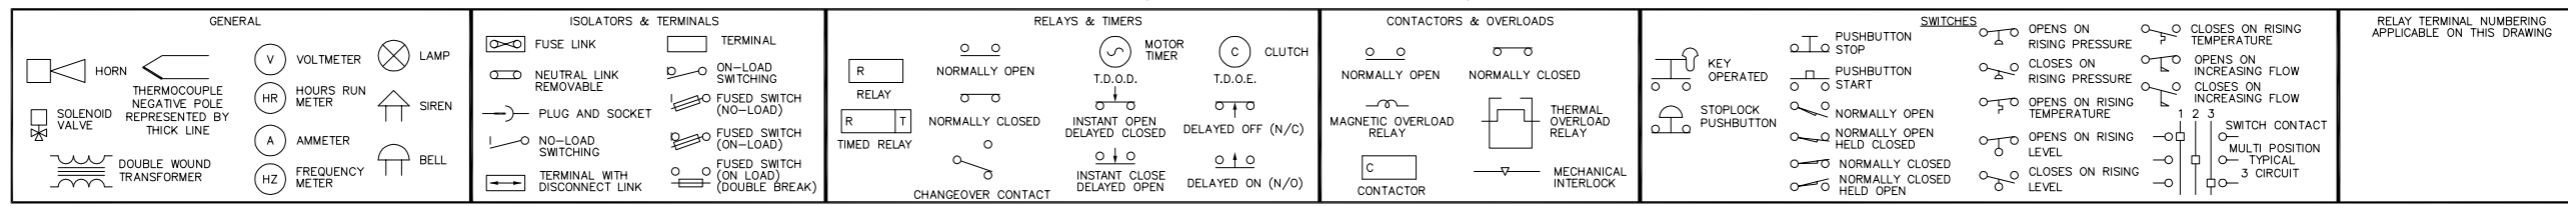

**MUX 3 (NORTH SIDING)**

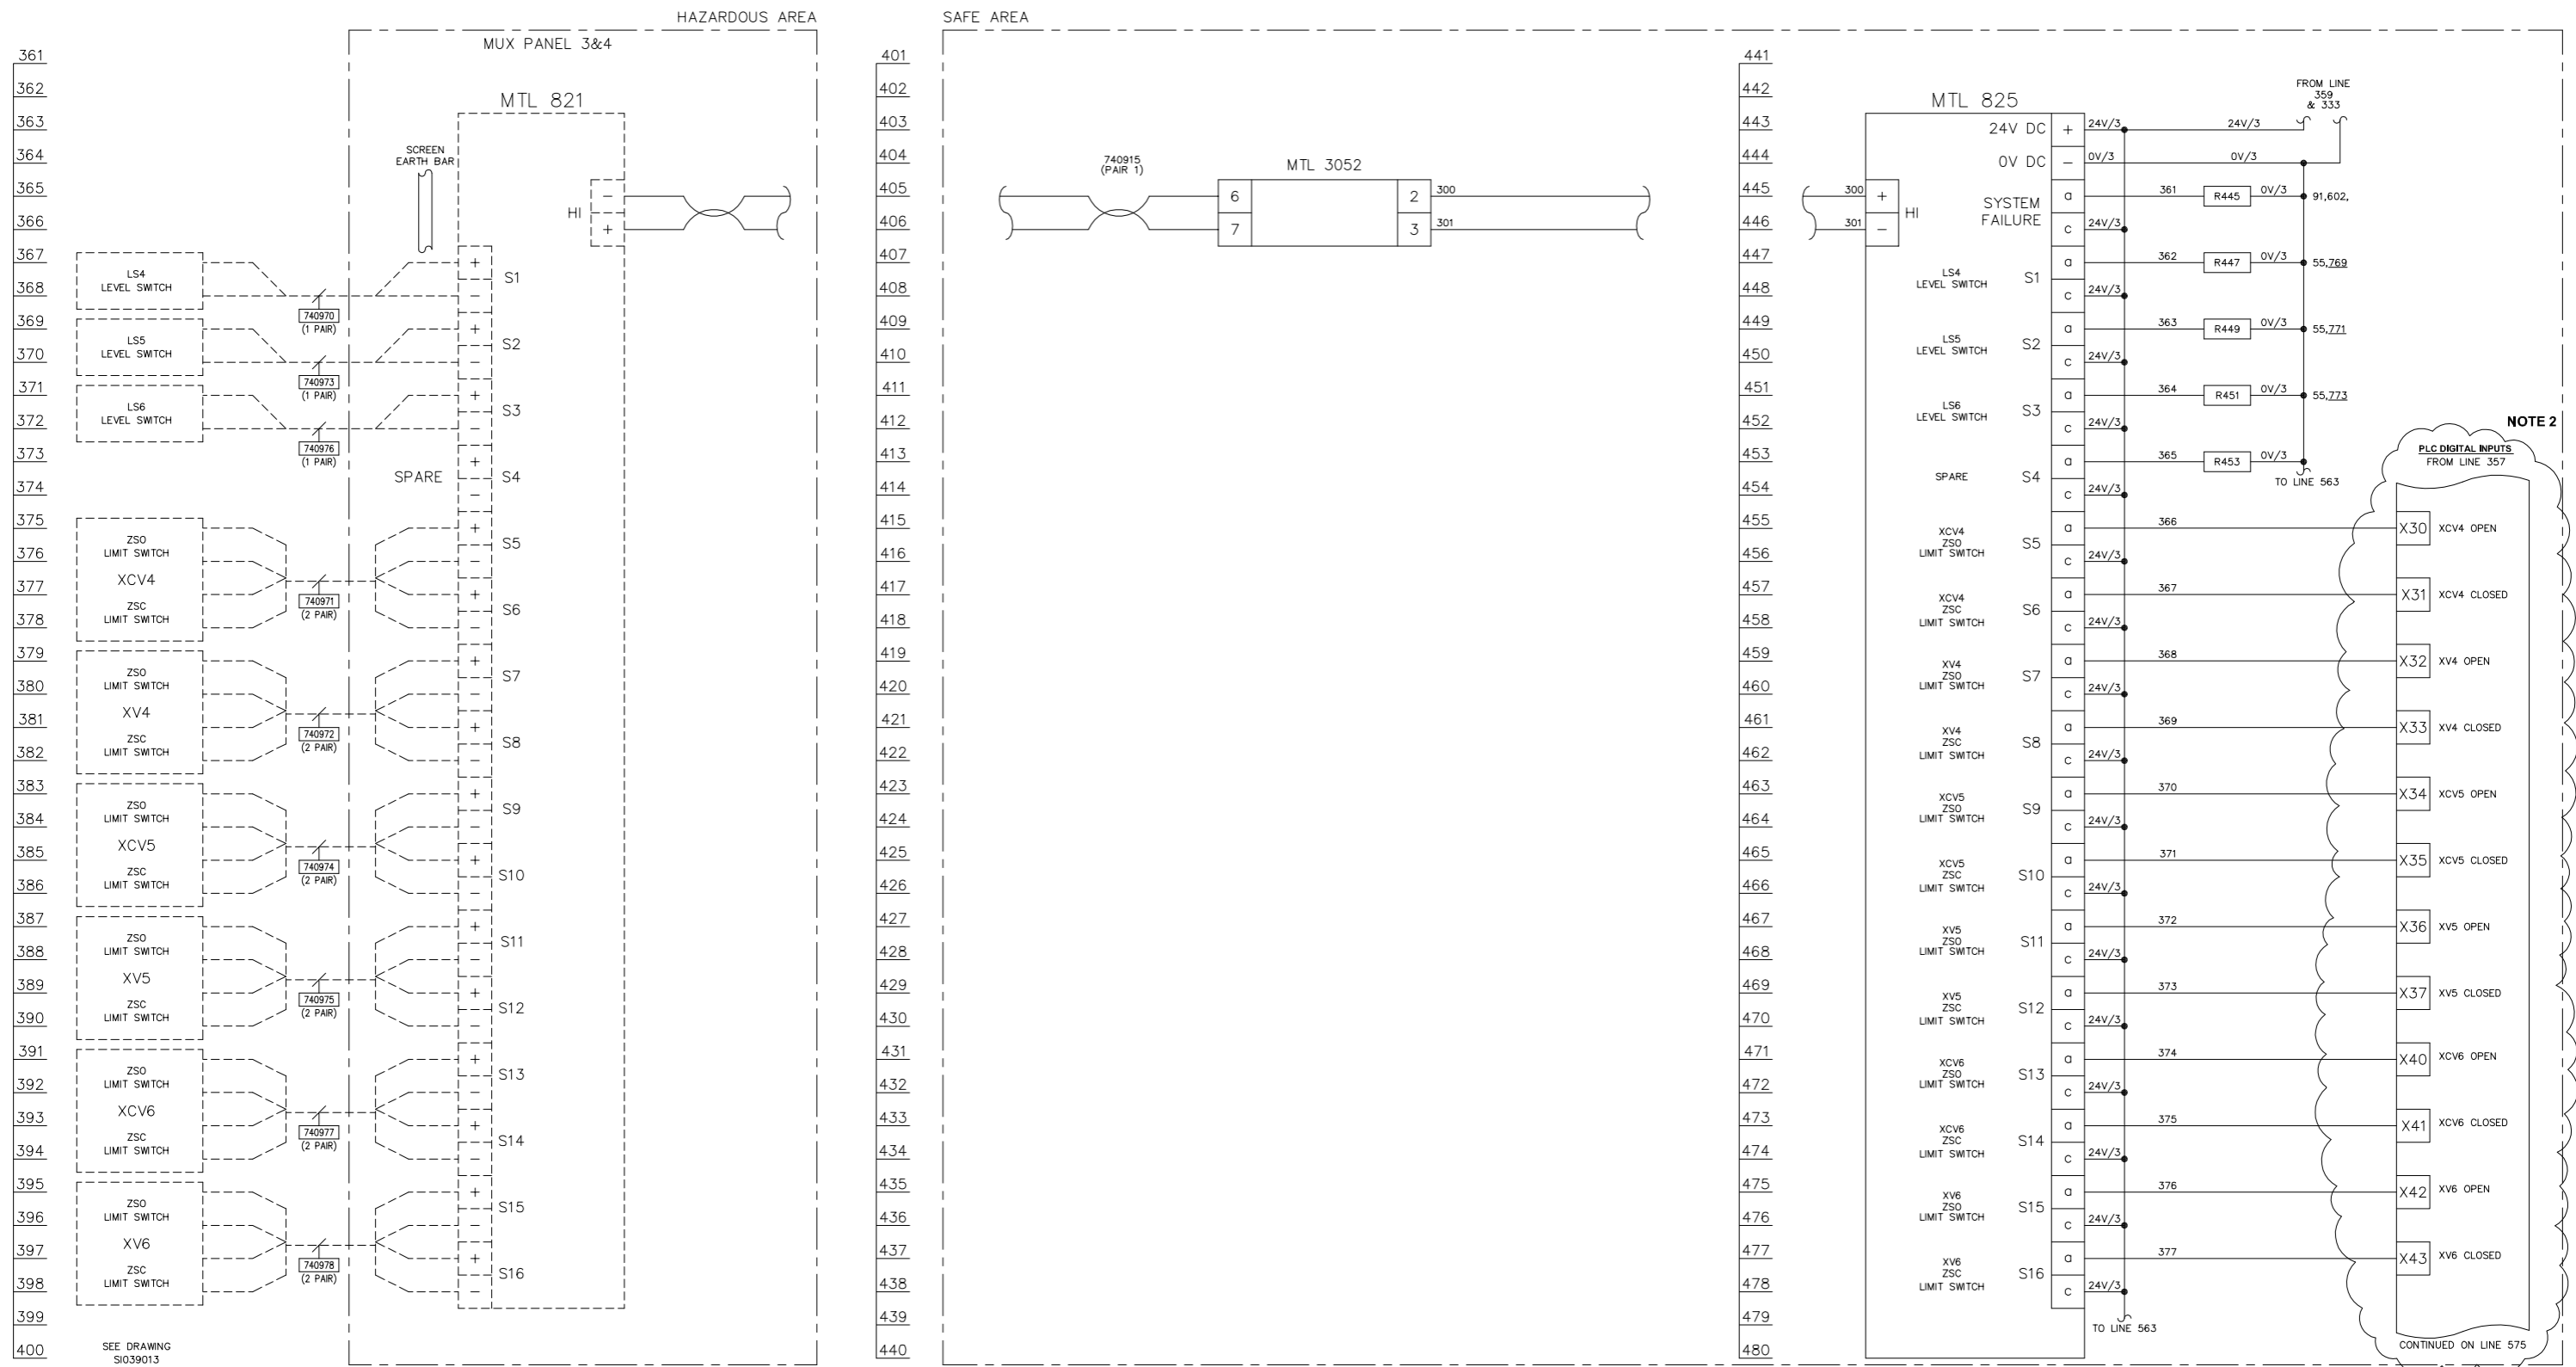

LAST NUMBER USED: 301  
 SPARE TO: 360

LAST NUMBER USED: 377  
 SPARE TO: 399


- NOTES**  
 1. SCREEN EARTHS NOT SHOWN FOR CLARITY.  
 2. DECOMMISSIONED BATCHING SYSTEM. INPUTS NOT USED IN PLC




IF NOT SIGNED THIS DOCUMENT IS UNCONTROLLED						
REV	DATE	BY	DRN	CHK'D	APP'D	DESCRIPTION
A	04/03/99	A.J.H.	A.J.H.	P.J.P.	P.J.P.	D.R.R. D.R.R. ORIGINAL ISSUE
B	07/07/99	D.P.	A.J.H.	D.R.R.	D.R.R.	COMMS POLARITY REVERSED
C	14/09/10	D.B.F.	P.P.	M.M.	M.M.	SI760 MODIFICATIONS

PLANT	IMMINGHAM STORAGE Co. - EAST TERMINAL
TITLE	4-EAST RAIL LOADING SYSTEM PANEL LOGIC DRAWING 4
CLIENT DRG. No.	P&I DESIGN P&I Design Ltd Tel. 01642 617444 www.ptdesign.co.uk
	SHEET 1 OF 1
	P&I DRG No. SI039005_DWG

LEGEND OF GRAPHICAL SYMBOLS (ALL CONTACTS SHOWN IN THE DE-ENERGISED STATE)

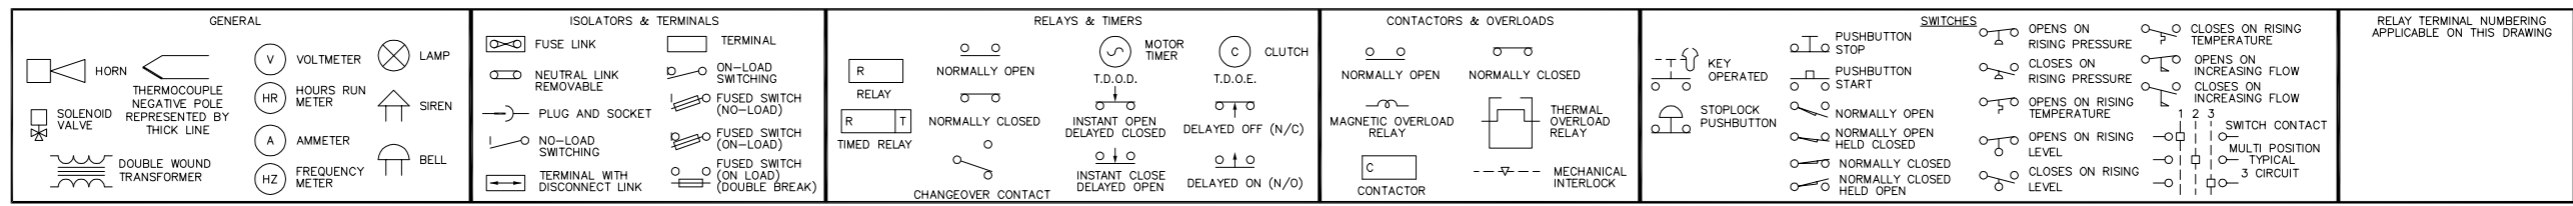

**MUX 4 (SOUTH SIDING)**

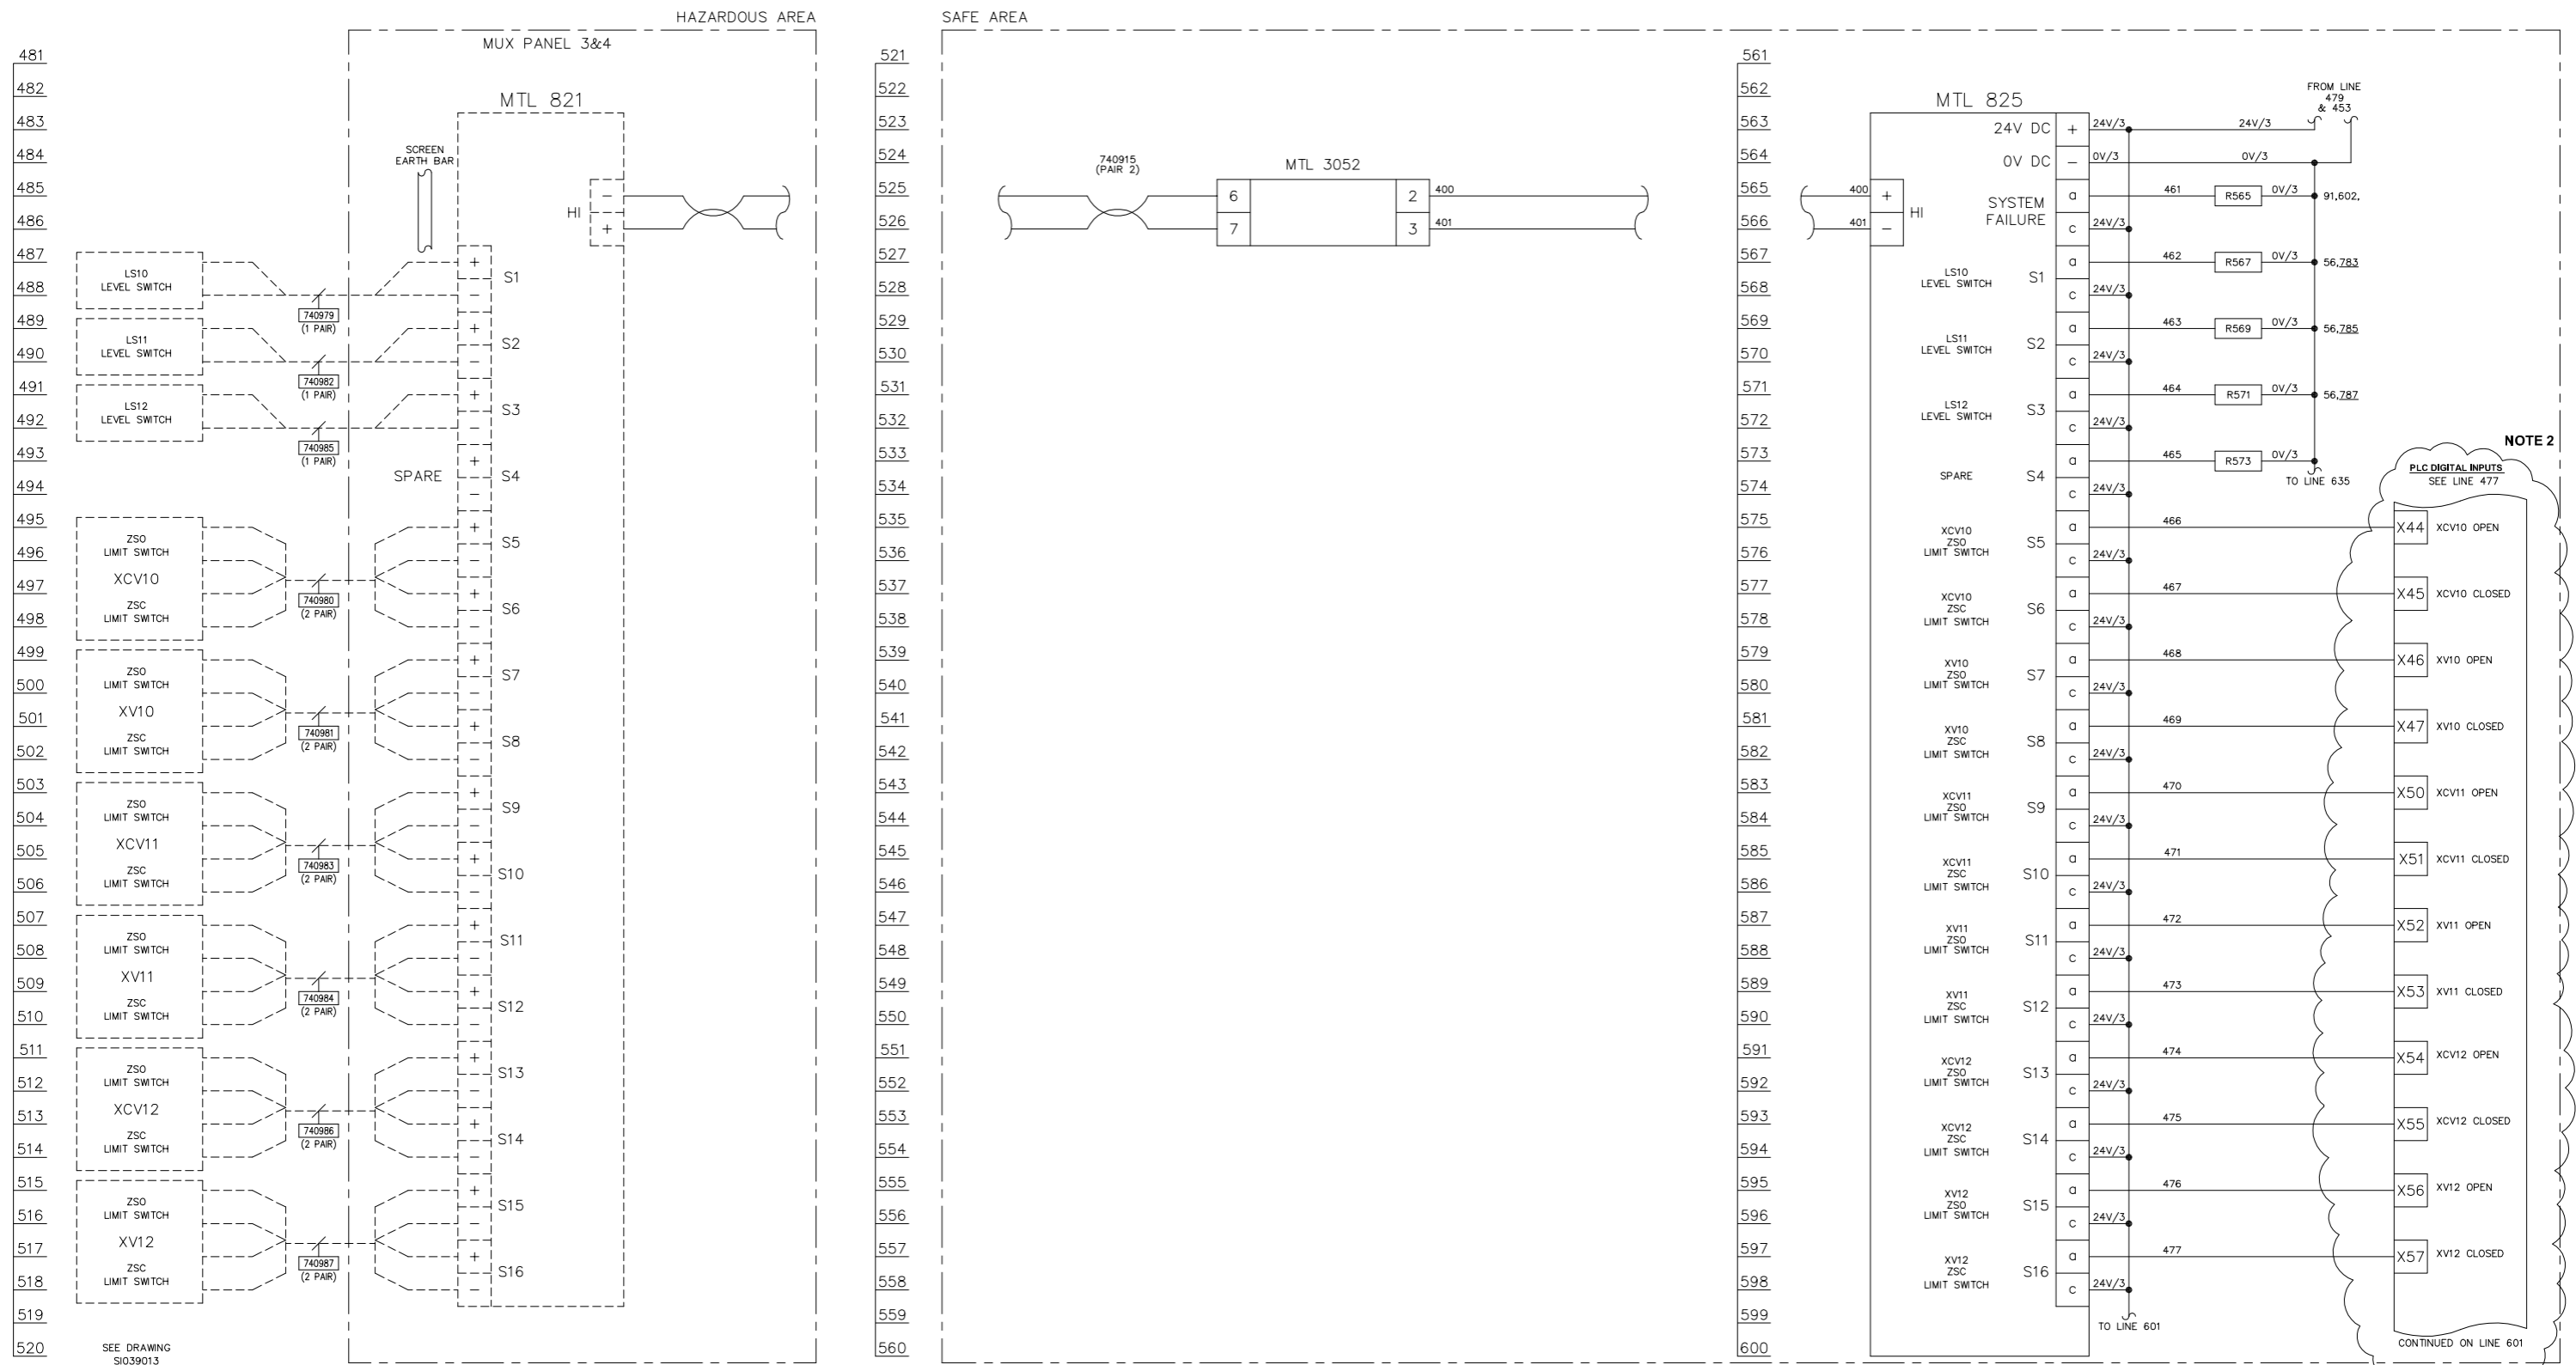

LAST NUMBER USED: 401  
 SPARE TO: 460

LAST NUMBER USED: 477  
 SPARE TO: 499

- NOTES**  
 1. SCREEN EARTHS NOT SHOWN FOR CLARITY.  
 2. DECOMMISSIONED BATCHING SYSTEM. INPUTS NOT USED IN PLC




IF NOT SIGNED THIS DOCUMENT IS UNCONTROLLED						
REV	DATE	BY	DRN	CHK'D	APP'D	DESCRIPTION
A	11/03/99	A.J.H.	A.J.H.	P.J.P.	P.J.P.	D.R.R. D.R.R. ORIGINAL ISSUE
B	07/07/99	D.P.	A.J.H.	D.R.R.	D.R.R.	COMMS POLARITY REVERSED
C	14/09/10	D.B.F.	P.P.	M.M.	M.M.	SI760 MODIFICATIONS


PLANT	IMMINGHAM STORAGE Co. - EAST TERMINAL		
TITLE	4-EAST RAIL LOADING SYSTEM PANEL LOGIC DRAWING 5		
		IMMINGHAM STORAGE Co. Ltd. IMMINGHAM EAST TERMINAL, IMMINGHAM DOCK, IMMINGHAM, SOUTH HUMBERSIDE	
	P & I Design Ltd Tel. 01642 617444 www.ptdesign.co.uk		
SHEET 1 OF 1		CLIENT DRG. No. P&I DRG No. SI039006_DWG	



LEGEND OF GRAPHICAL SYMBOLS (ALL CONTACTS SHOWN IN THE DE-ENERGISED STATE)

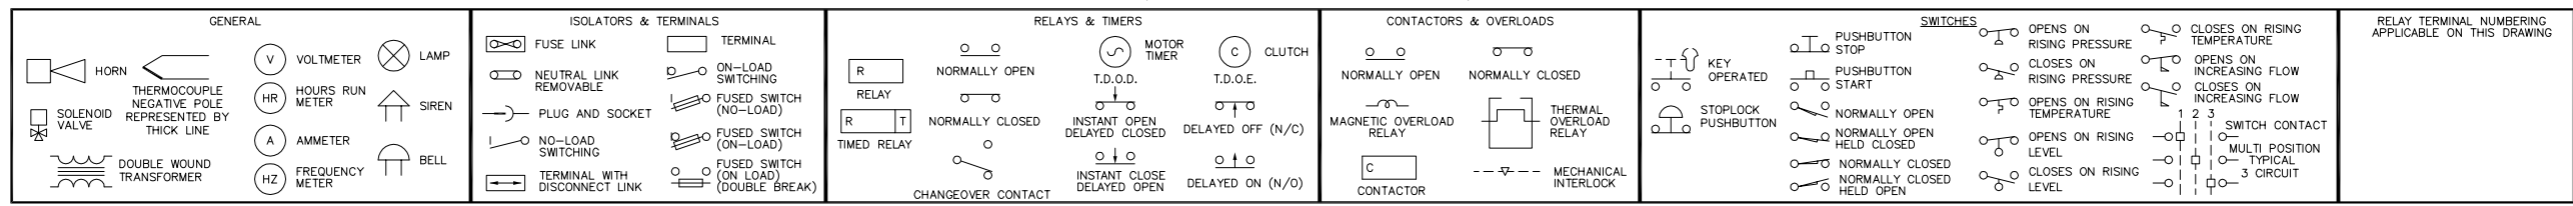


PLC DIGITAL INPUTS

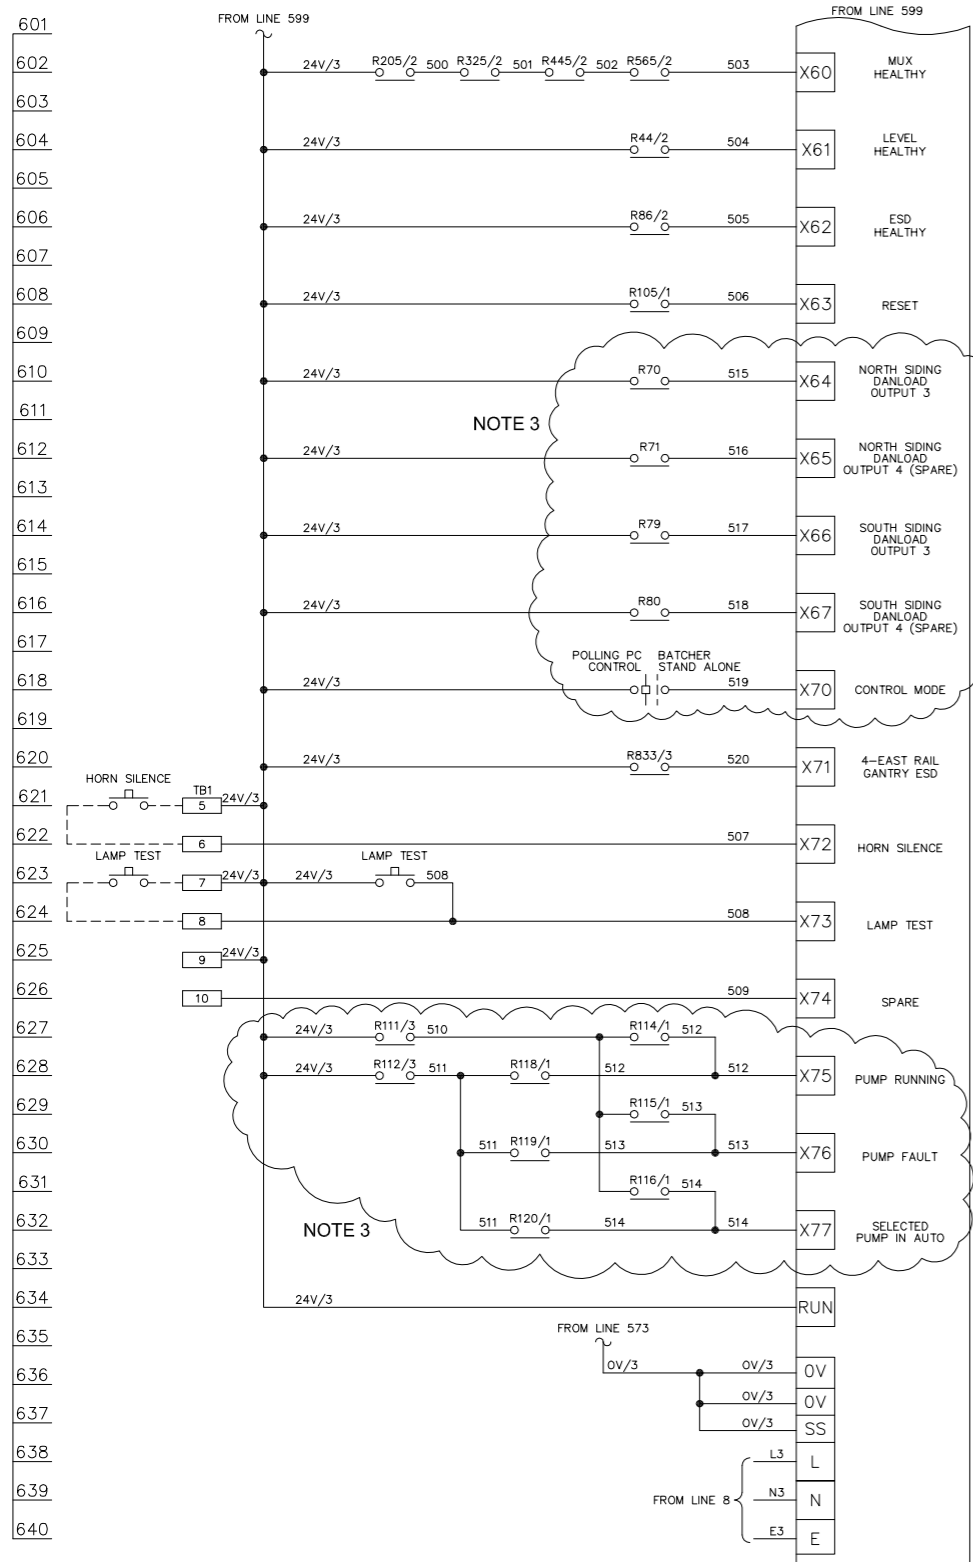


LAST NUMBER USED: 520  
 SPARE TO: 569

PLC DIGITAL OUTPUTS

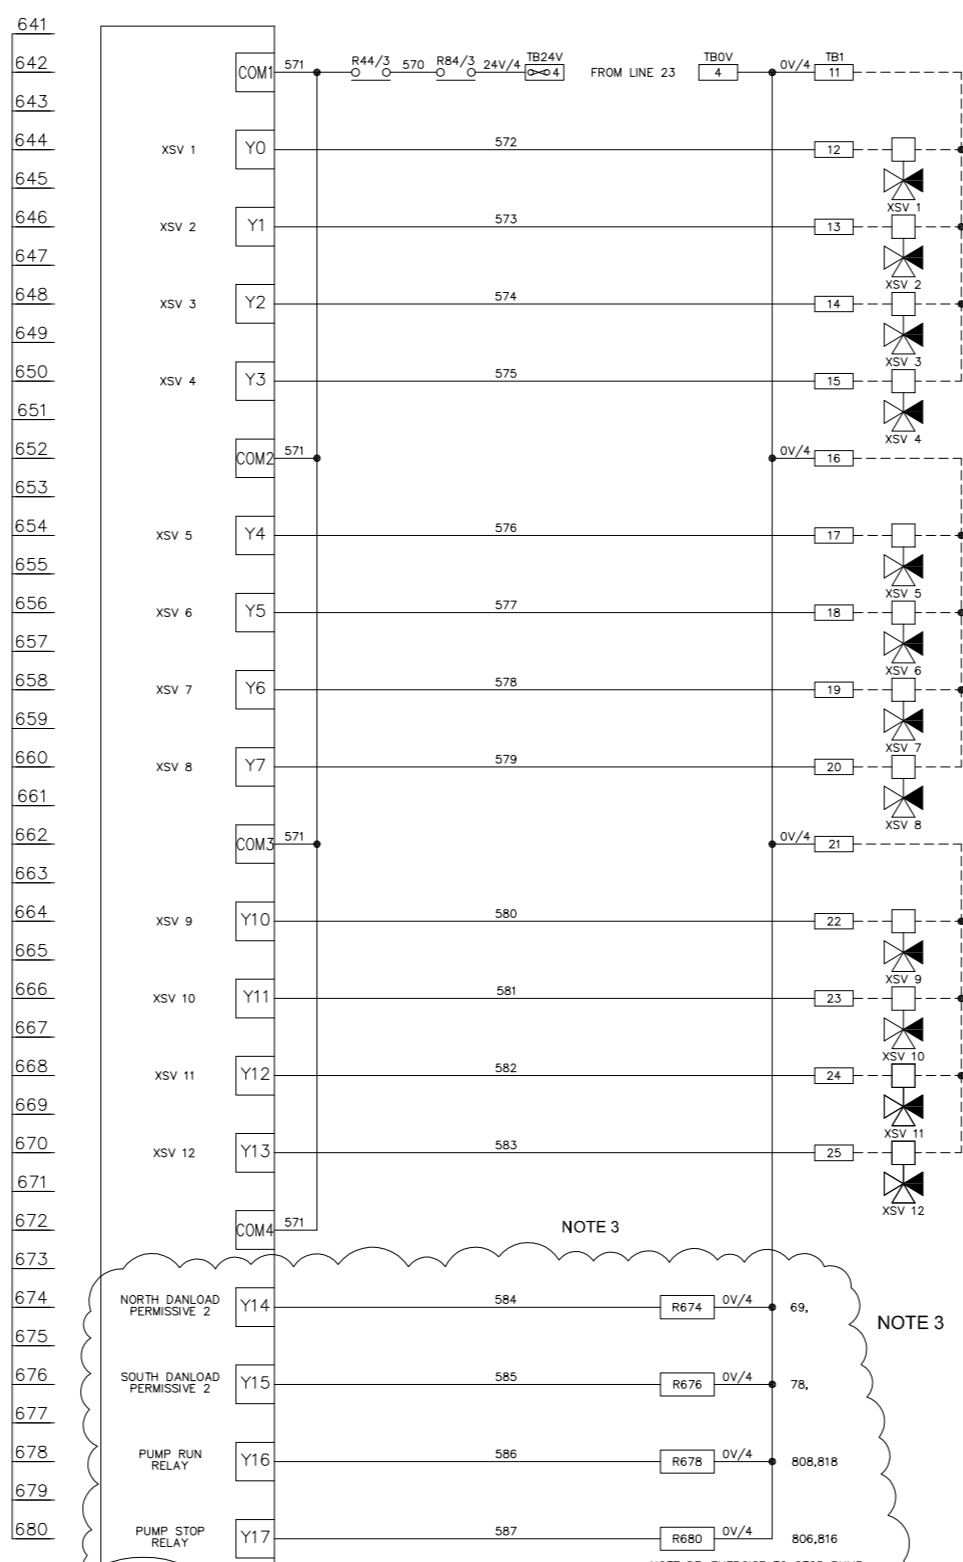

LAST NUMBER USED: 587  
 SPARE TO: 619

PLC DIGITAL OUTPUTS

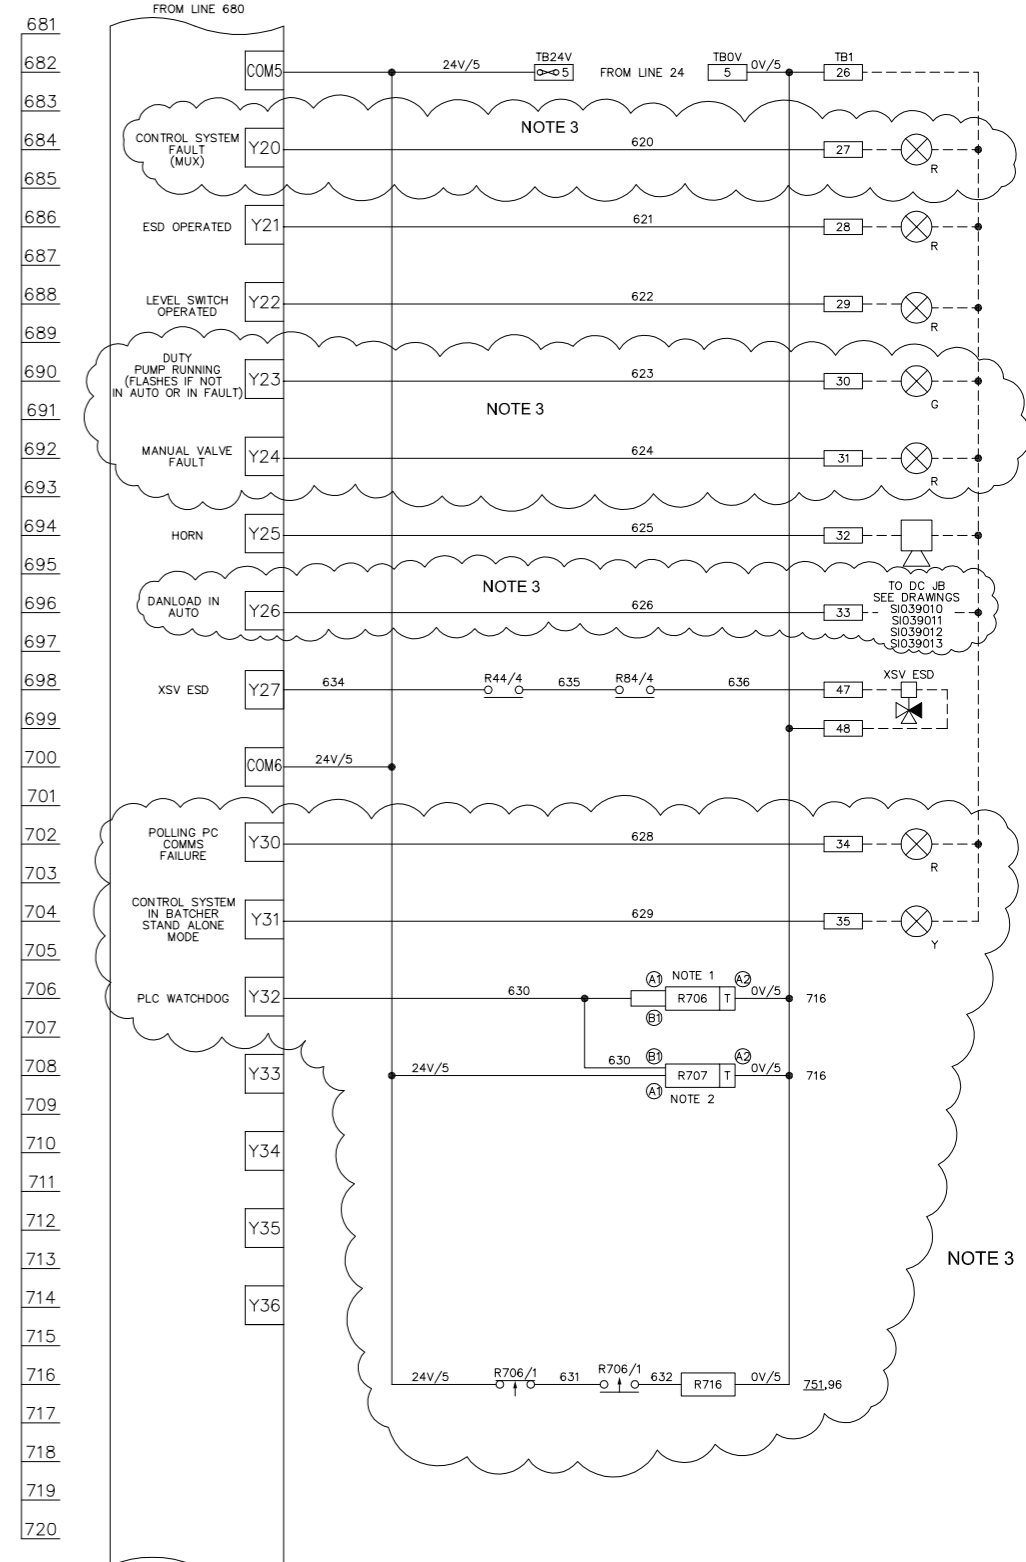

LAST NUMBER USED: 636  
 SPARE TO: 679

- NOTES  
 1. TIMER RELAY OMRON M3DE-M1 MODE A SET @ 1 SEC.  
 2. TIMER RELAY OMRON M3DE-M1 MODE D SET @ 1 SEC  
 3. DECOMMISSIONED BATCHING SYSTEM. INPUTS NOT USED IN PLC



IF NOT SIGNED THIS DOCUMENT IS UNCONTROLLED

REV	DATE	BY	DRN	CHK'D	APP'D	DESCRIPTION
A	07/04/99	A.J.H	A.J.H	D.R.R	D.R.R	ORIGINAL ISSUE
B	02/07/99	D.P.	A.J.H	D.R.R	D.R.R	PANEL TEST MODS
C	14/09/10	D.B.F	P.P.	M.M.	M.M.	SI760 MODIFICATIONS
D	11/01/11	D.B.F	P.P.	M.M.	M.M.	AS BUILT


PLANT	IMMINGHAM STORAGE Co. - EAST TERMINAL
TITLE	4-EAST RAIL LOADING SYSTEM PANEL LOGIC DRAWING 6
CLIENT DRG. No.	P&I DRG No. SIO39007_DWG

IMMINGHAM STORAGE Co. Ltd. IMMINGHAM EAST TERMINAL, IMMINGHAM DOCK, IMMINGHAM, SOUTH HUMBERSIDE


P & I DESIGN  
 P & I Design Ltd  
 Tel. 01642 617444  
 www.ptdesign.co.uk

SHEET 1 OF 1


LEGEND OF GRAPHICAL SYMBOLS (ALL CONTACTS SHOWN IN THE DE-ENERGISED STATE)

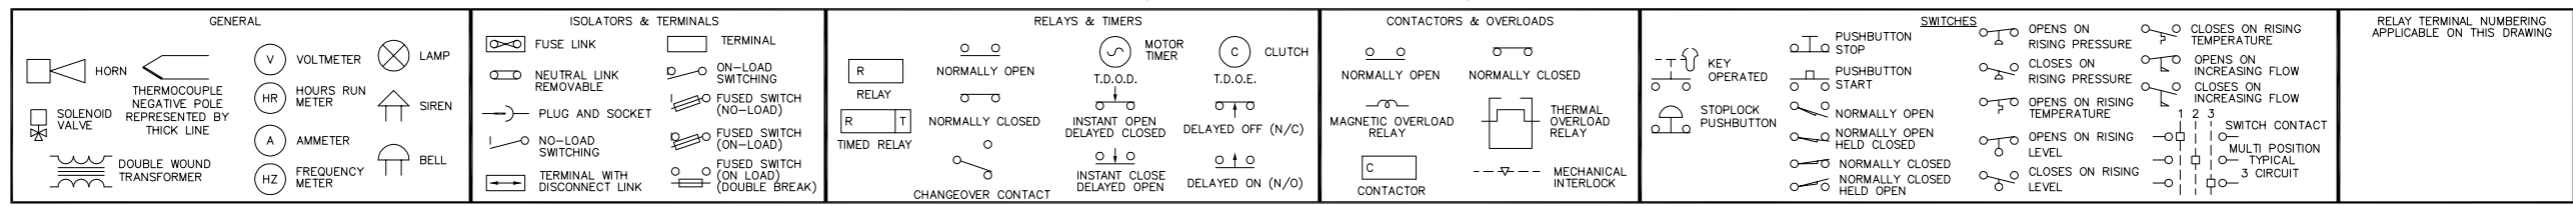


PLC DIGITAL OUTPUTS

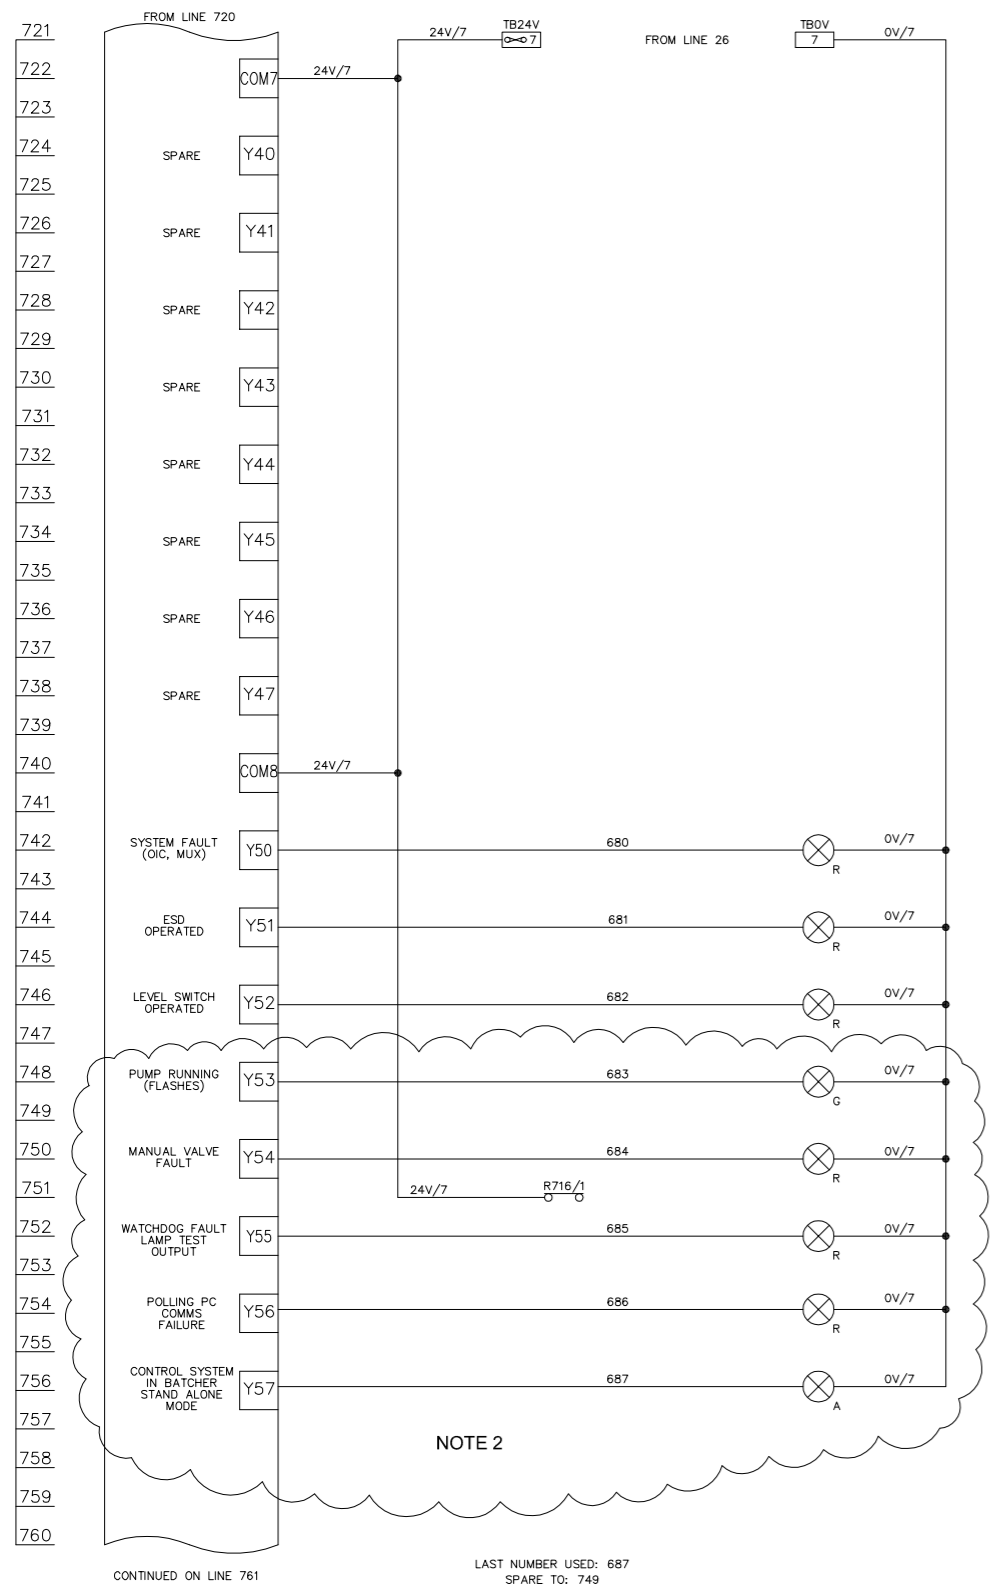

PLC DIGITAL OUTPUTS

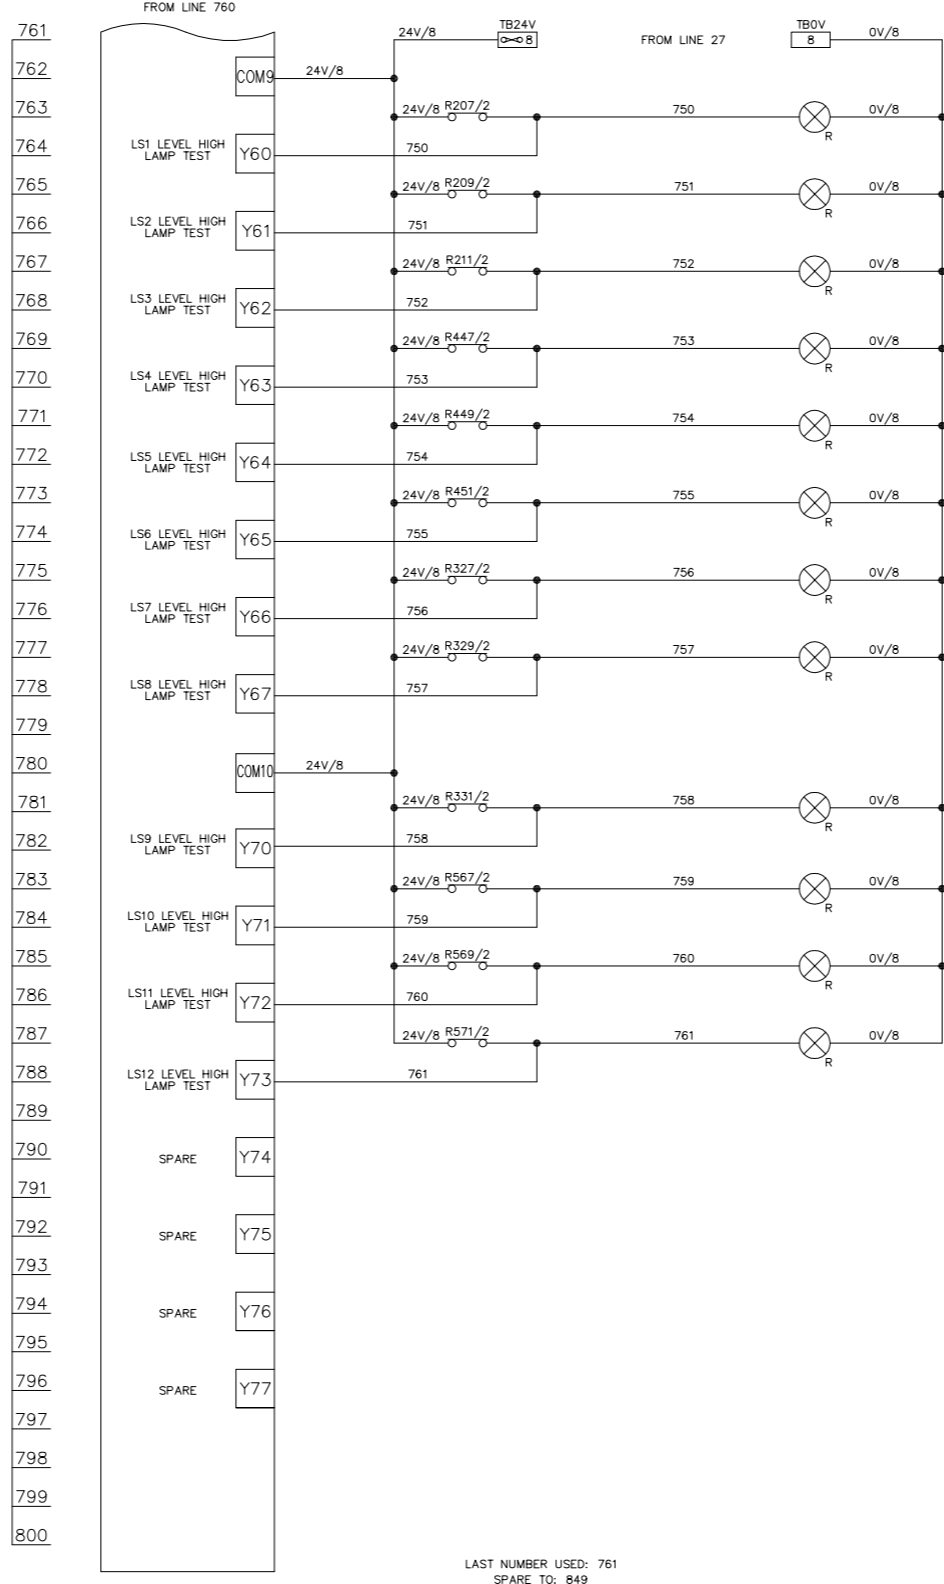

PUMP CONTROLS (240V)

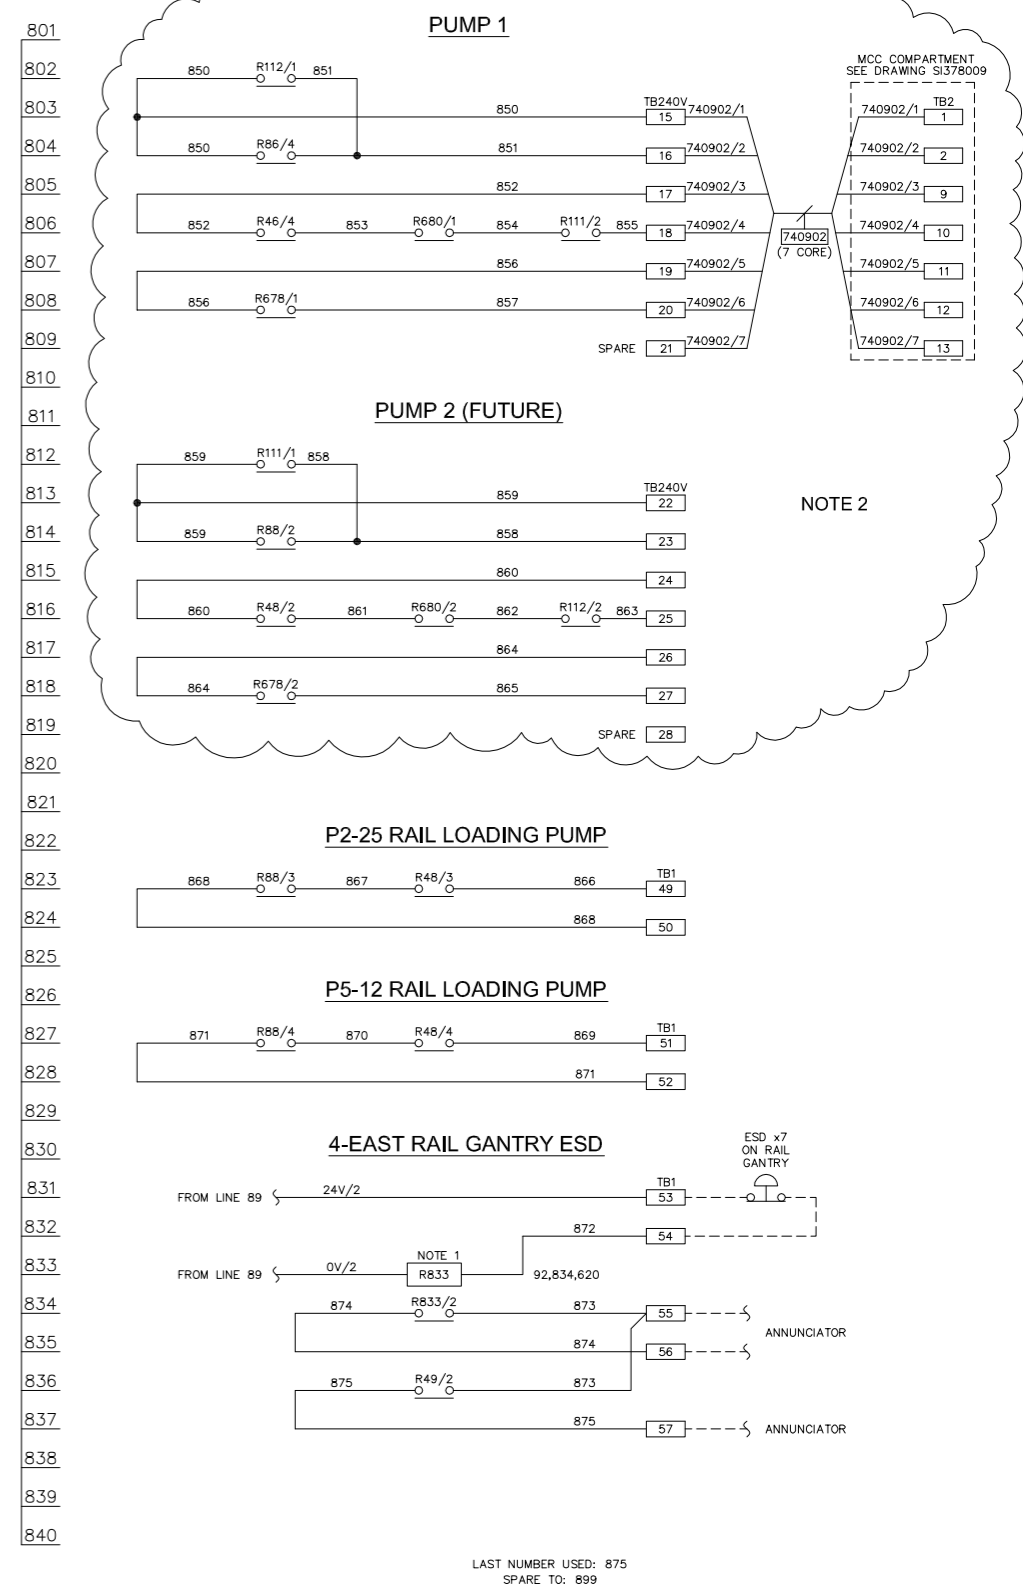

- NOTES
- OMRON G7S-4A2B GUIDED CONTACT RELAY (RS260-4373).
  - DECOMMISSIONED BATCHING SYSTEM. INPUTS NOT USED IN PLC




IF NOT SIGNED THIS DOCUMENT IS UNCONTROLLED							PLANT	IMMINGHAM STORAGE Co. - EAST TERMINAL
REV	DATE	BY	DRN	CHK'D	APP'D	DESCRIPTION	TITLE	4-EAST RAIL LOADING SYSTEM PANEL LOGIC DRAWING 7
A	07/04/99	A.J.H.	A.J.H.	D.R.R.	D.R.R.	D.R.R.	D.R.R.	ORIGINAL ISSUE
B	02/07/99	D.P.	A.J.H.	D.R.R.	D.R.R.	D.R.R.	D.R.R.	PANEL TEST MODS
C	14/09/10	D.B.F.	P.P.	M.M.	M.M.	M.M.	M.M.	SI760 MODIFICATIONS
D	11/01/11	D.B.F.	P.P.	M.M.	M.M.	M.M.	M.M.	AS BUILT

CLIENT DRG. No. P&I DRG No. SI039008\_DWG



SHEET 1 OF 1  
 P&I Design Ltd  
 Tel. 01642 617444  
 www.pidesign.co.uk

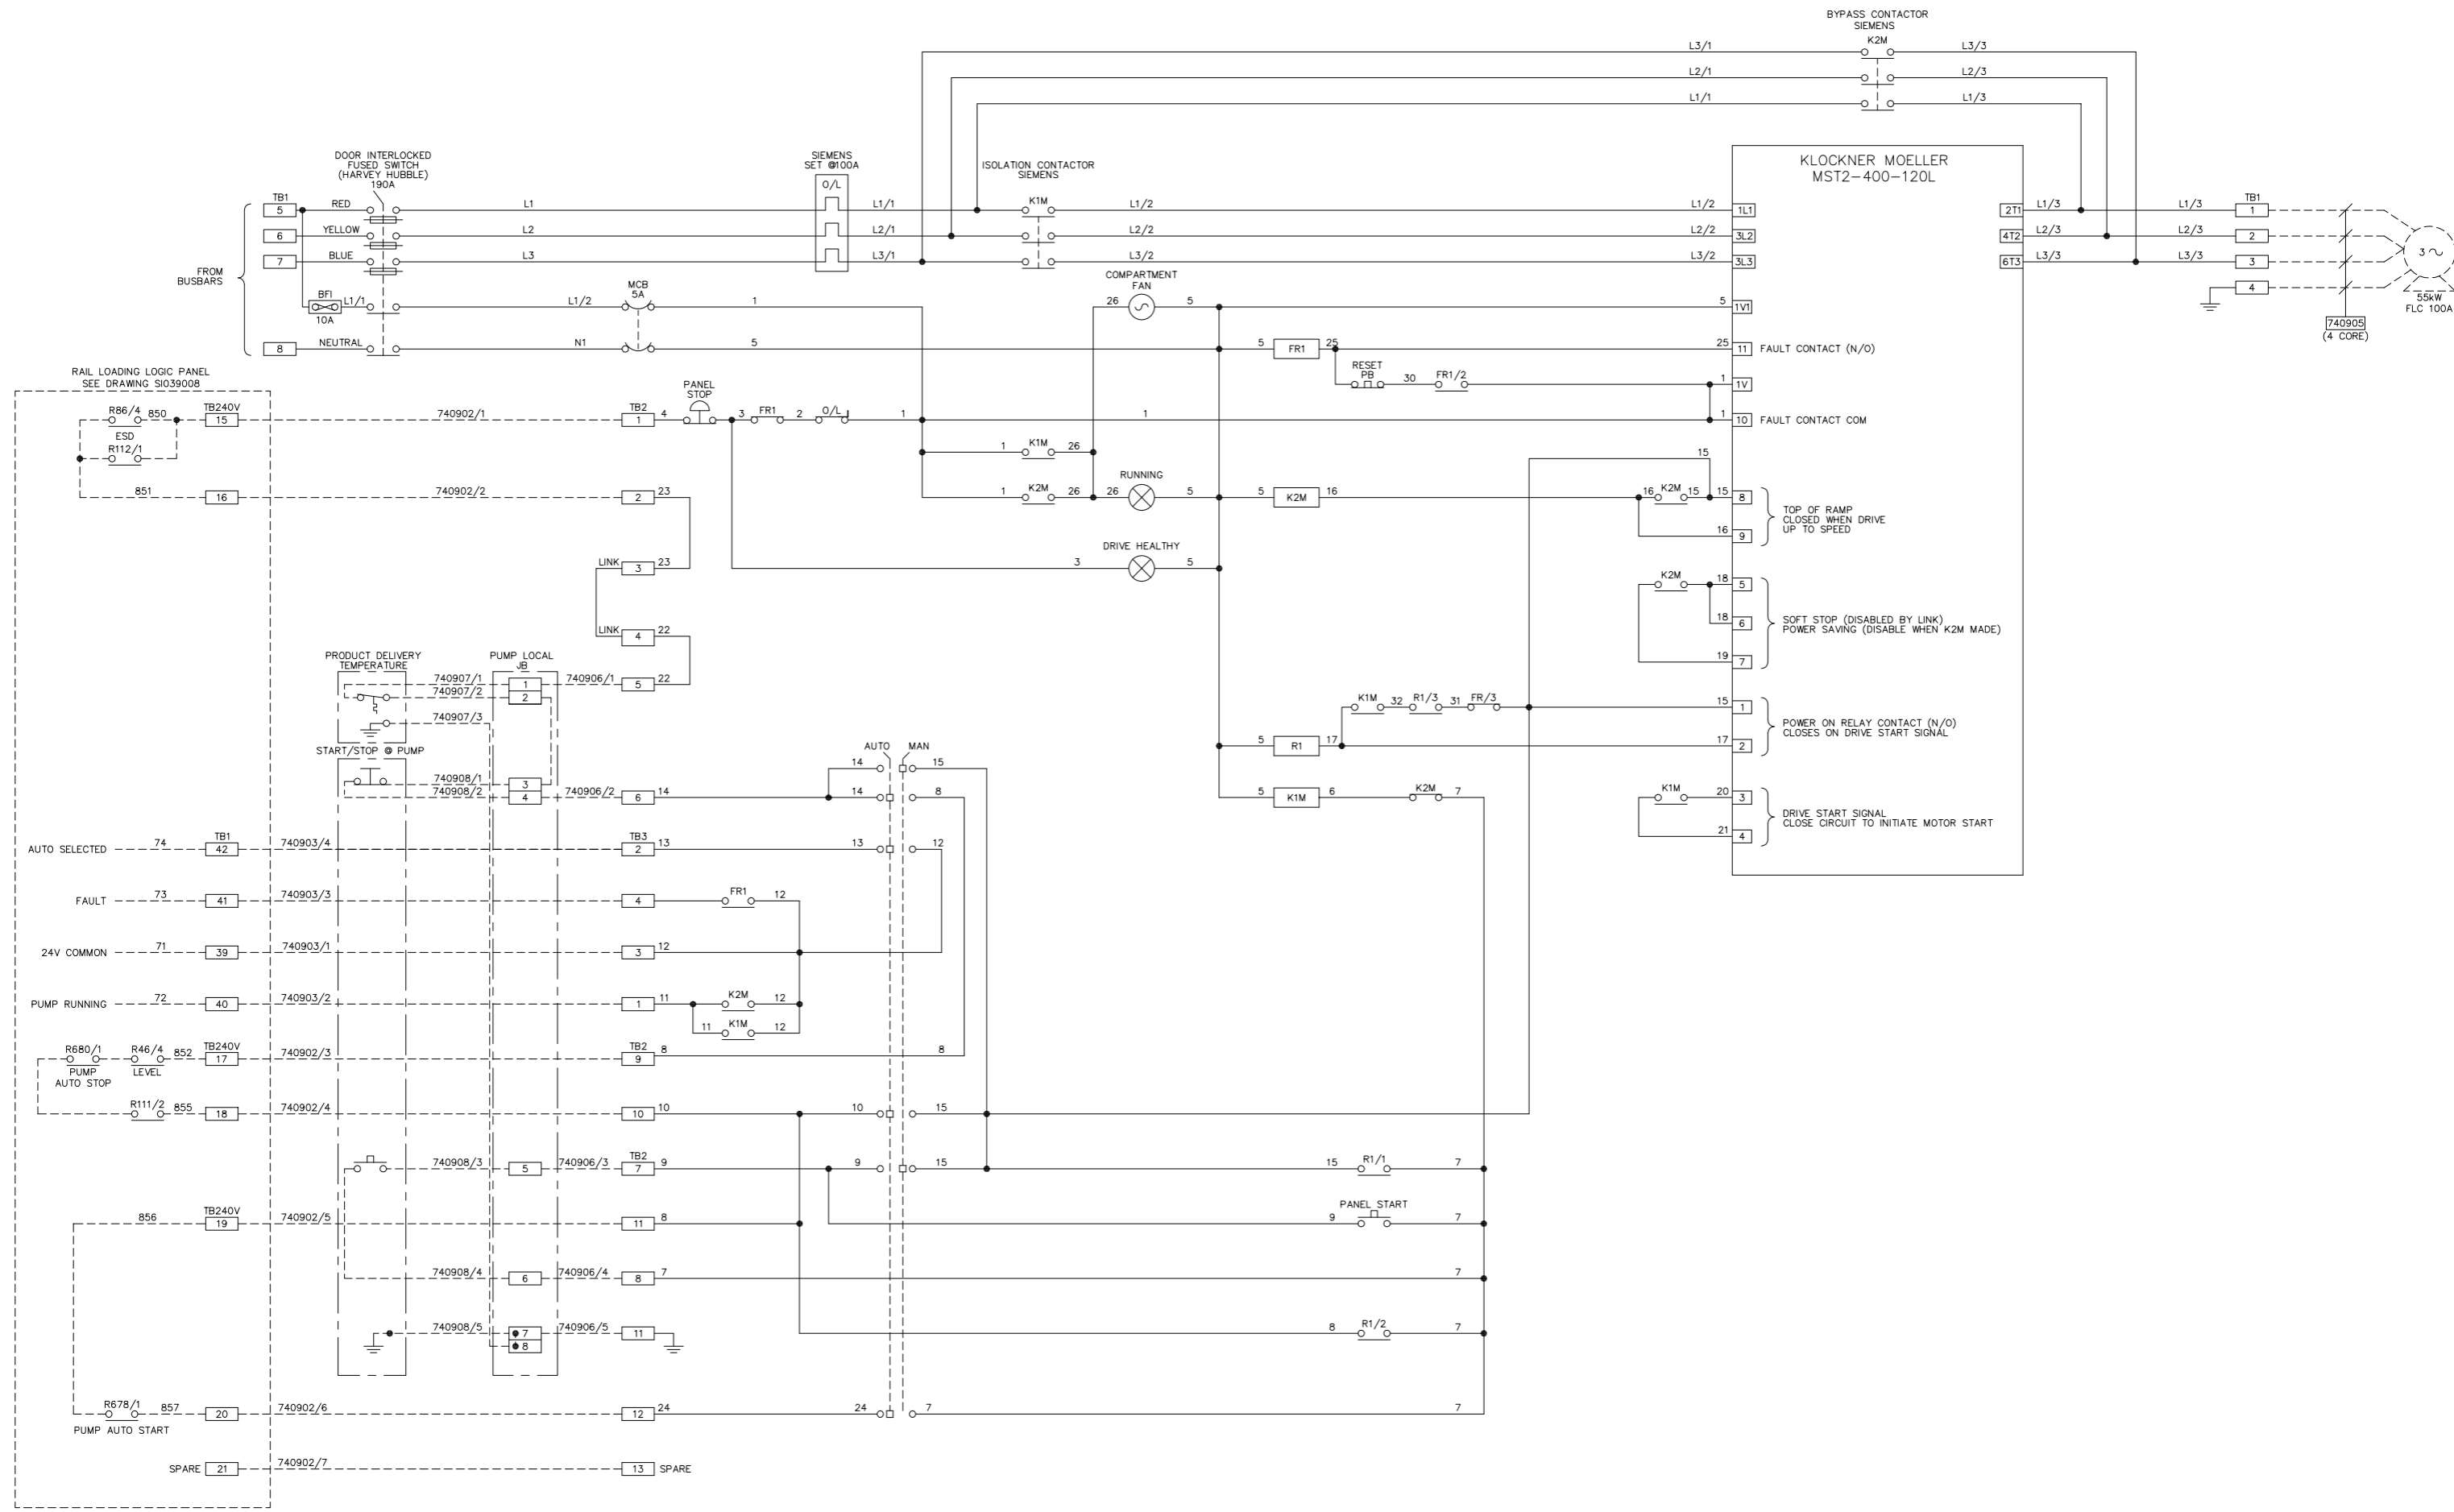


**NOTES:**  
 CABLE COLOURS: 3Φ - PHASE COLOURS TO SUIT MOTOR LOAD  
 240V - BROWN 2.5mm<sup>2</sup>  
 NEUTRAL - BLUE 2.5mm<sup>2</sup>  
 24VDC - RED 1.5mm<sup>2</sup>  
 0VDC - BLACK 1.5mm<sup>2</sup>  
 24V DC SWITCHED - WHITE 1.0mm<sup>2</sup>

**GENERAL**  
 - - - - - EXTERNAL WIRING

REV	DATE	BY	DRN	CHK'D	APP'D	DESCRIPTION	PLANT	FINA DERV RAIL LOADING SYSTEM
A	04/03/99	A.J.H	A.J.H	P.J.P	P.J.P	ORIGINAL ISSUE	TITLE	DERV OFFLOADING PUMP 1 MCC DIAGRAM
B	09/04/99	A.J.H	A.J.H	D.R.R	D.R.R	TEMP SWITCH EARTH ADDED		
C	02/07/99	D.P.	A.J.H	D.R.R	D.R.R	SOFT STARTER MODS		

<b>Simon Storage</b>	<b>Terminals</b>	IMMINGHAM STORAGE Co Ltd, IMMINGHAM EAST TERMINAL, IMMINGHAM DOCK, IMMINGHAM, SOUTH HUMBERSIDE	<b>P &amp; I DESIGN</b>
CLIENT DRG. No.		SHEET 01 OF 01 P&I DRG No. SI039009	

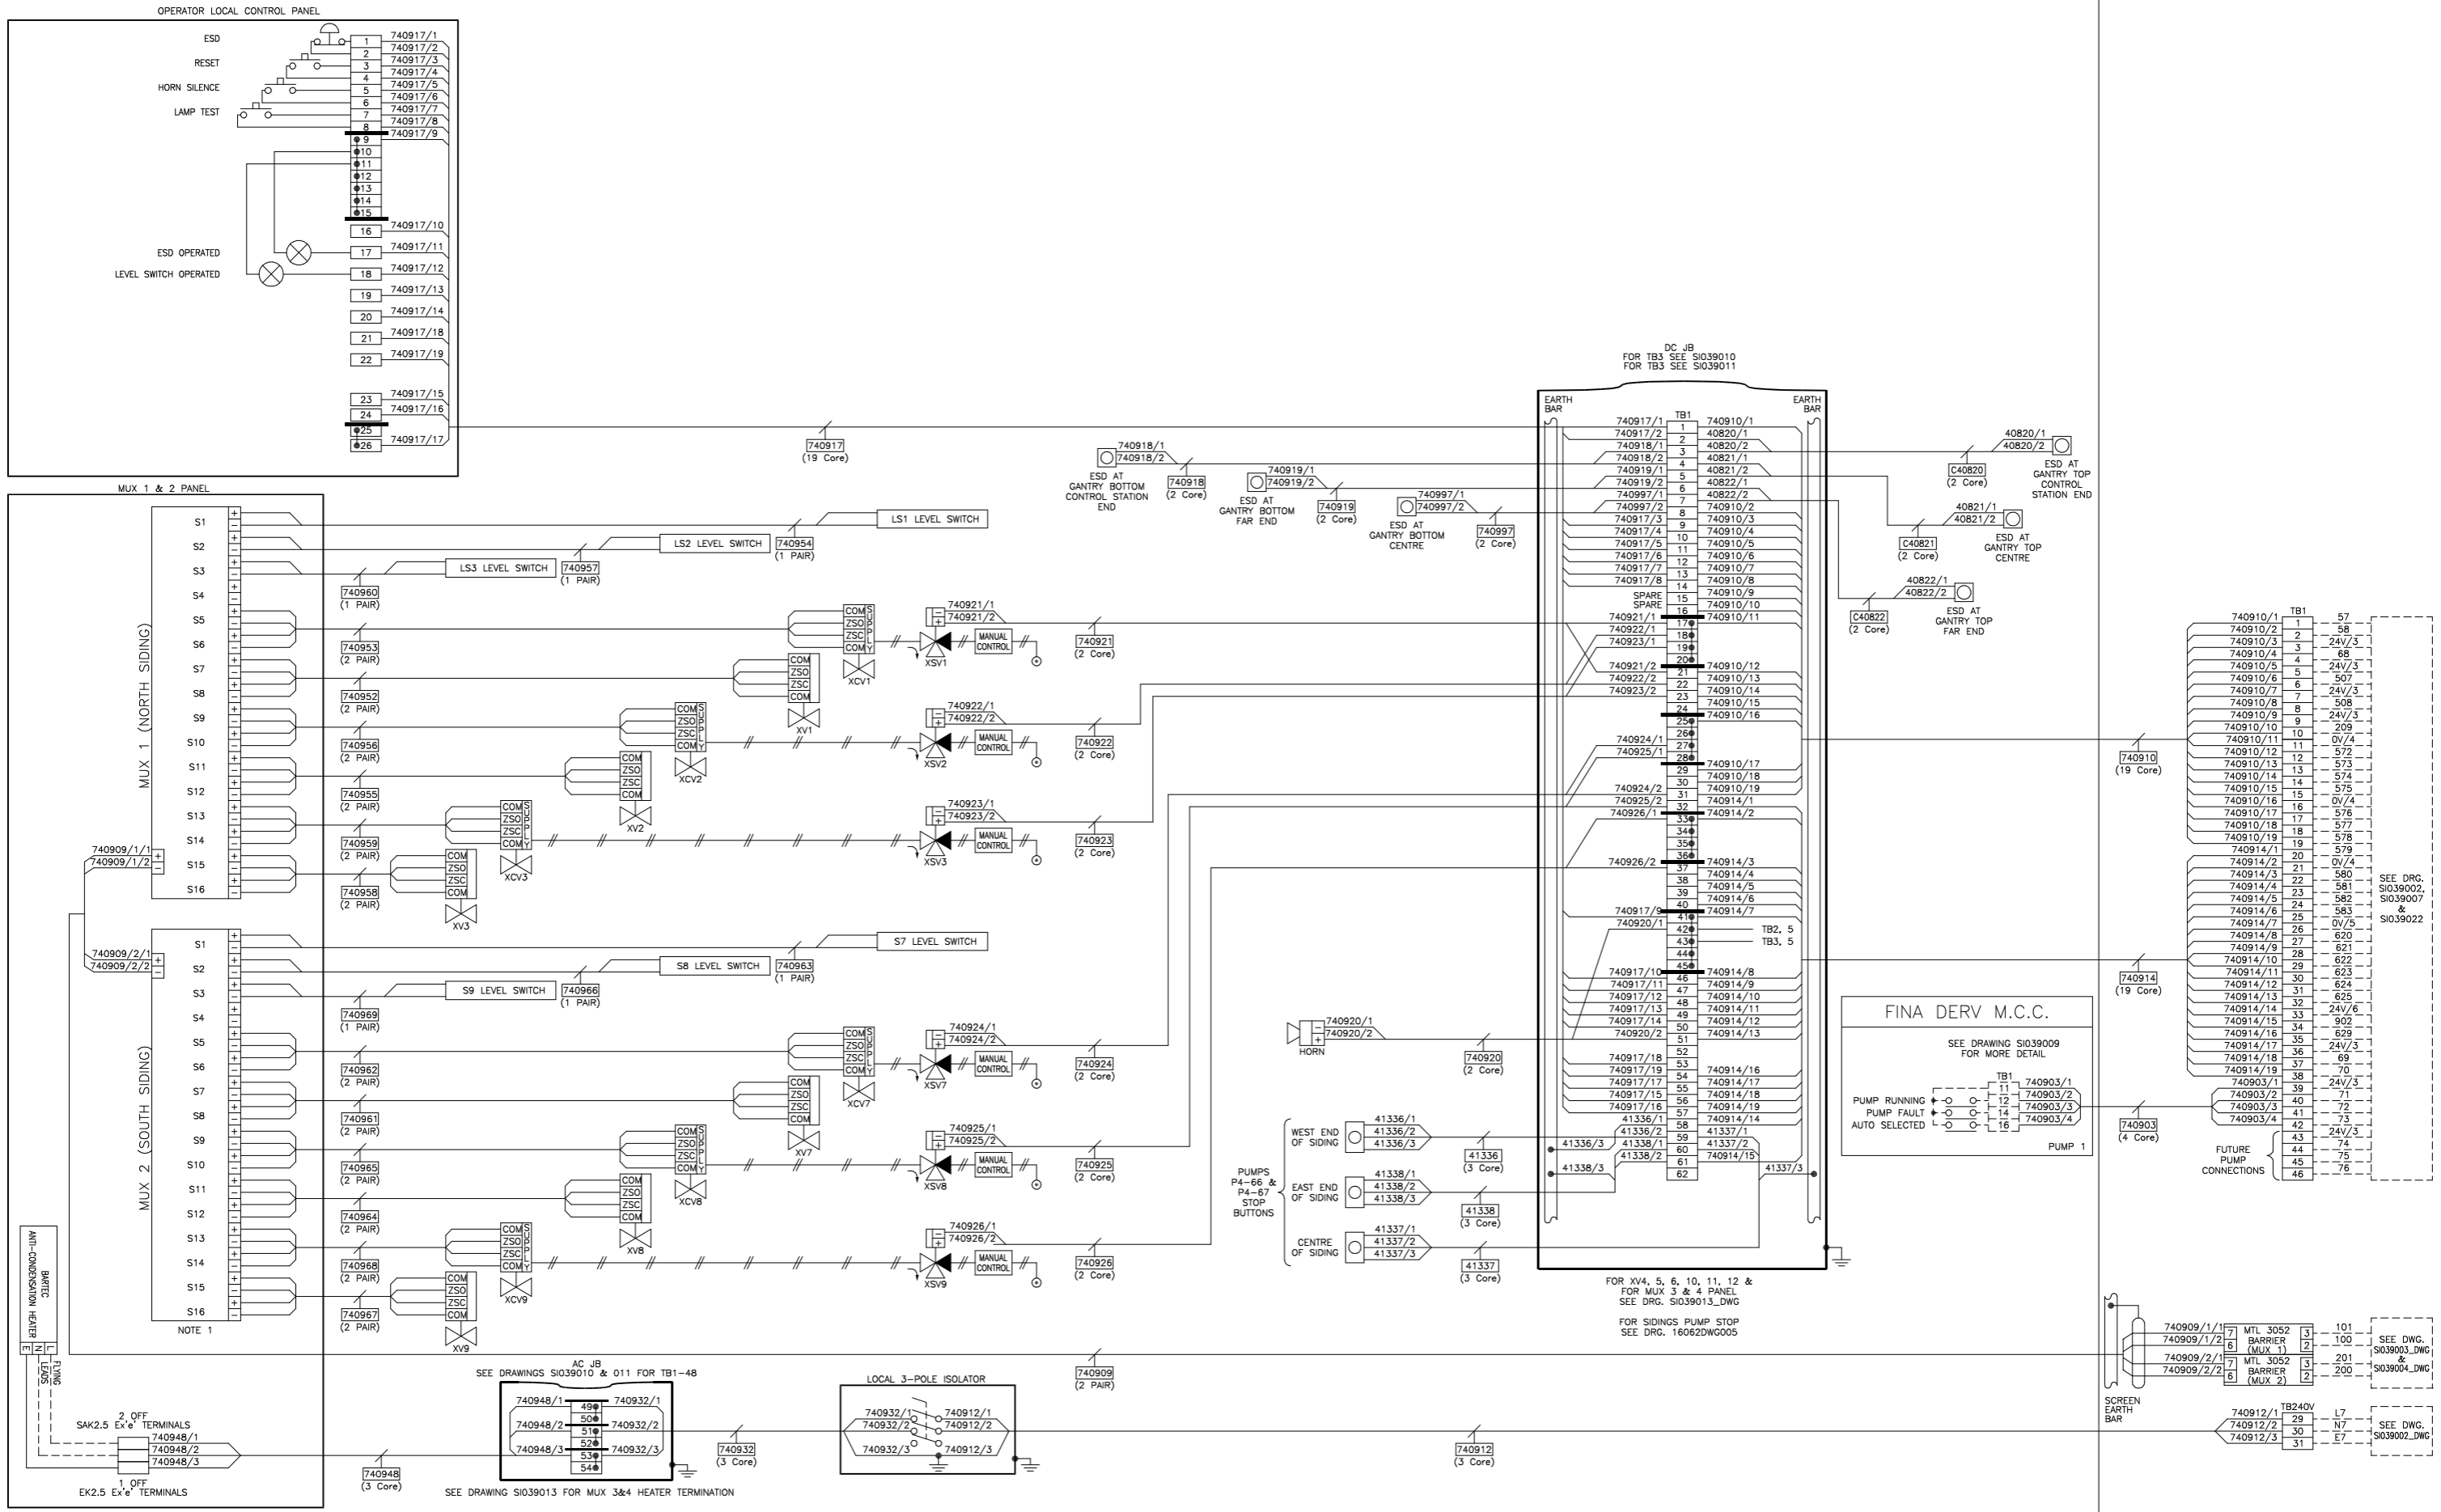

NOTE 1: SEE DRAWING SIO39003 & 4 FOR MORE DETAIL.

AC JB: SEE DRAWINGS SIO39010 & 011 FOR TB1-48.

LOCAL 3-POLE ISOLATOR: SEE DRAWING SIO39013 FOR MUX 3&4 HEATER TERMINATION.

FOR X4, 5, 6, 10, 11, 12 & FOR MUX 3 & 4 PANEL SEE DRG. SIO39013\_DWG

FOR SIDINGS PUMP STOP SEE DRG. 16062DWG005

IF NOT SIGNED THIS DOCUMENT IS UNCONTROLLED

SAFETY PROTECTION	FLAMEPROOF & INCREASED SAFETY		CERTIFIED EQUIPMENT			CERTIFIED EQUIPMENT		
	REQUIRED	ACHIEVED	TAG No.	CERTIFICATE No.	CERTIFICATION AUTHORITY	TAG No.	CERTIFICATE No.	CERTIFICATION AUTHORITY
AREA CLASS	ZONE 1	XXXX						
GAS GROUP	II B	XXXX						
TEMPERATURE CLASS	T3	XXXX						

NOTES

- ALL SCREENS NOT SHOWN FOR CLARITY.
- FOR COMMUNICATION INTERCONNECTIONS SEE DRAWING SIO39014.
- LIMIT SWITCH BOXES NOT ON VALVES.

REV	DATE	BY	DRN	CHK'D	APP'D	DESCRIPTION
A	08/04/99	A.J.H.	A.J.H.	D.R.R.	D.R.R.	ORIGINAL ISSUE
B	15/04/99	A.J.H.	A.J.H.	D.R.R.	D.R.R.	MUX BOX UPDATED
C	02/07/99	D.P.	A.J.H.	D.R.R.	D.R.R.	GENERAL UPDATE
D	14/09/10	D.B.F.	P.P.	M.M.	M.M.	SI760 MODIFICATIONS
E	12/05/11	D.B.F.	P.P.	M.M.	M.M.	AS BUILT
F	24/01/17	P.P.	P.P.	M.M.	M.M.	AS BUILT - 16062 PROJECT



PLANT: IMMINGHAM STORAGE CO. - EAST TERMINAL

TITLE: 4-EAST RAIL LOADING SYSTEM MUX 1 & 2 PANEL LOOP

**inter terminals**  
Inter Terminals (Immingham) Ltd  
Immingham East Terminal  
Immingham Dock Immingham  
N.E. Lincolnshire  
DN40 2QW

**P & I Design Ltd**  
Tel. 01642 617444  
www.pidesign.co.uk

SHEET 1 OF 1  
P&I DRG No. SIO39012\_DWG

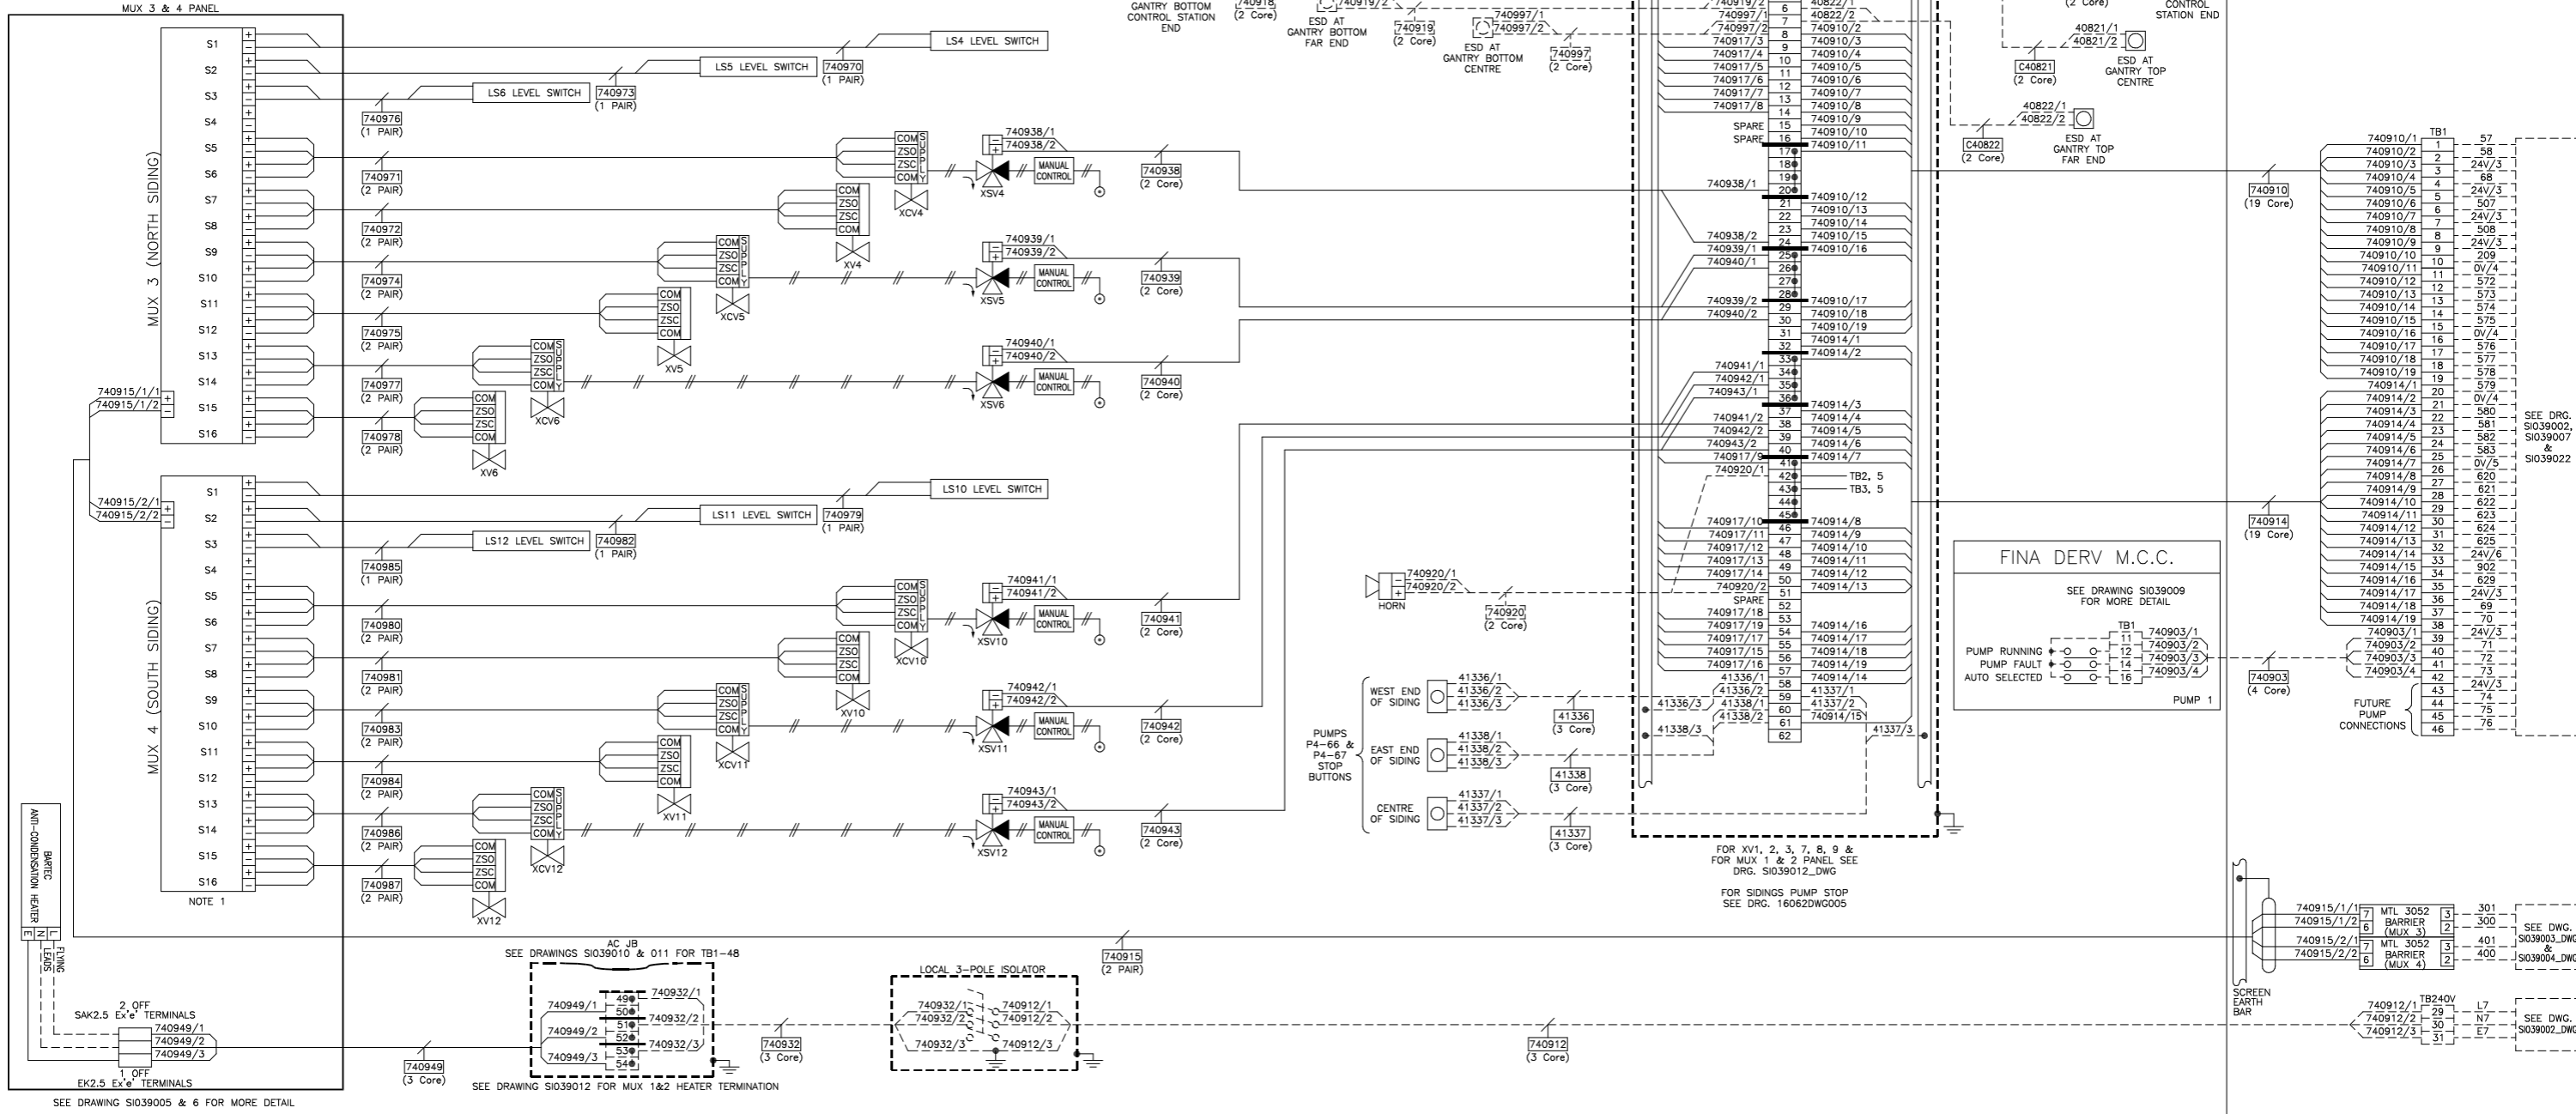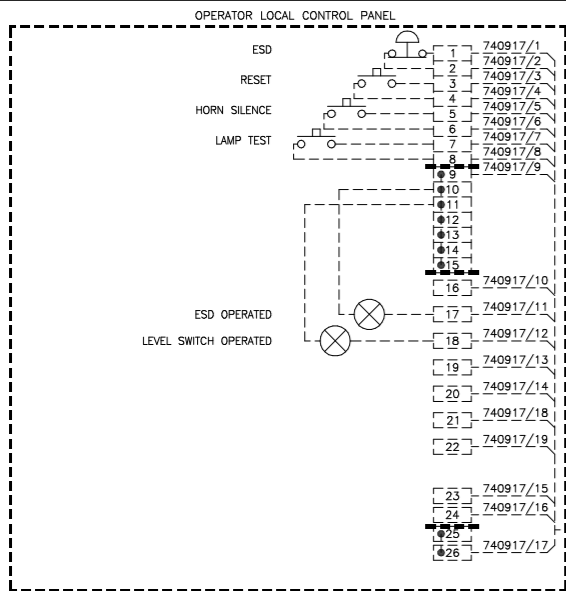

- NOTES
1. ALL SCREENS NOT SHOWN FOR CLARITY.
  2. FOR COMMUNICATION INTERCONNECTIONS SEE DRAWING SIO39014.
  3. LIMIT SWITCH BOXES NOT ON VALVES.

IF NOT SIGNED THIS DOCUMENT IS UNCONTROLLED

REV	DATE	BY	DRN	CHK'D	APP'D	DESCRIPTION
A	08/04/99	A.J.H	A.J.H	D.R.R	D.R.R	ORIGINAL ISSUE
B	15/04/99	A.J.H	A.J.H	D.R.R	D.R.R	MUX BOX UPDATED
C	02/07/99	D.P.	A.J.H	D.R.R	D.R.R	GENERAL UPDATE
D	14/09/10	D.B.F	P.P.	M.M.	M.M.	SI760 MODIFICATIONS
E	12/05/11	D.B.F	P.P.	M.M.	M.M.	AS BUILT
F	24/01/17	P.P.	P.P.	M.M.	M.M.	AS BUILT - 16062 PROJECT

SAFETY PROTECTION	FLAMEPROOF & INCREASED SAFETY		CERTIFIED EQUIPMENT			CERTIFIED EQUIPMENT		
	REQUIRED	ACHIEVED	TAG No.	CERTIFICATE No.	CERTIFICATION AUTHORITY	TAG No.	CERTIFICATE No.	CERTIFICATION AUTHORITY
AREA CLASS	ZONE 1	XXXX						
GAS GROUP	IIB	XXXX						
TEMPERATURE CLASS	T3	XXXX						

PLANT IMMINGHAM STORAGE CO. - EAST TERMINAL

TITLE 4-EAST RAIL LOADING SYSTEM MUX 3 & 4 PANEL LOOP

inter terminals  
Inter Terminals Immingham Ltd  
Immingham East Terminal  
Immingham Dock Immingham  
N.E. Lincolnshire  
DN40 2QW

P & I Design Ltd  
Tel. 01642 617444  
www.pidesign.co.uk

SHEET 1 OF 1  
P&I DRG No. SIO39013\_DWG

RAIL LOADING SIDING

COMMUNICATIONS INTERFACE PANEL


DANLOAD 6000

DC JUNCTION BOX

LOGIC PANEL

LINE TERMINATION CABINET

PROTOCOL MANAGEMENT UNIT

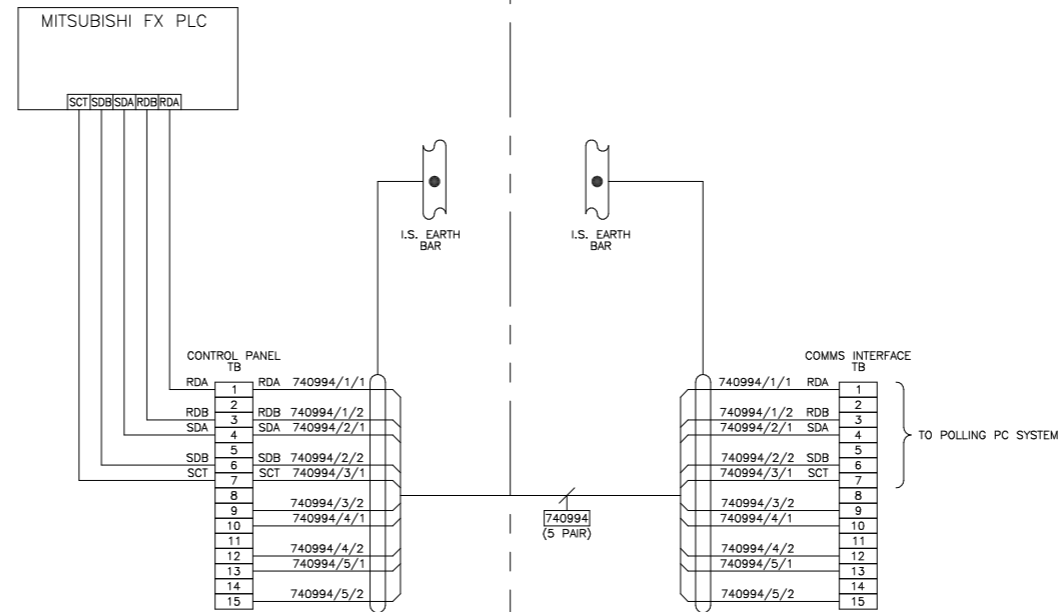

HAZARDOUS AREA SAFE AREA

NOTES

1.

IF NOT SIGNED THIS DOCUMENT IS UNCONTROLLED

REV	DATE	BY	DRN	CHK'D	APP'D	DESCRIPTION
A	07/04/99	A.J.H	A.J.H	D.R.R	D.R.R	ORIGINAL ISSUE
B	13/07/99	A.J.H	A.J.H	D.R.R	D.R.R	CABLE 740994 ADDED
C	14/09/10	D.B.F	P.P.	M.M.	M.M.	SI760 MODIFICATIONS
D	11/01/11	D.B.F	P.P.	M.M.	M.M.	AS BUILT
E	24/01/17	P.P.	P.P.	M.M.	M.M.	AS BUILT -- 16062 PROJECT

PLANT	IMMINGHAM STORAGE Co. - EAST TERMINAL
TITLE	4-EAST RAIL LOADING SYSTEM DANLOAD TO PC COMMUNICATIONS DIAGRAM
Inter Terminals Immingham Ltd Immingham East Terminal Immingham Dock Immingham N.E. Lincolnshire DN40 2QW	Tel. 01642 617444 www.pidesign.co.uk
CLIENT DRG. No.	P&I DRG No. SI039014 DWG



FIELD

COMMUNICATIONS INTERFACE PANEL


PC

LINE TERMINATION CABINET


PROTOCOL MANAGEMENT UNIT

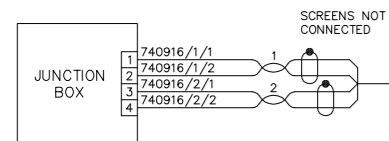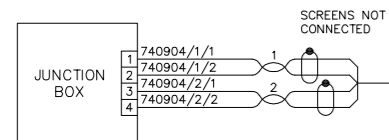

RS422 I.S.  
740904  
(2 PAIR)


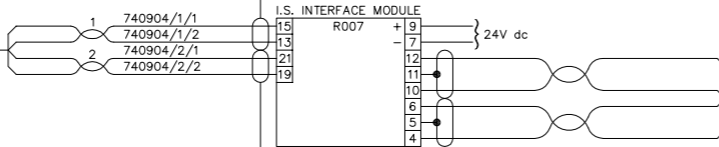


RS422 I.S.  
740916  
(2 PAIR)

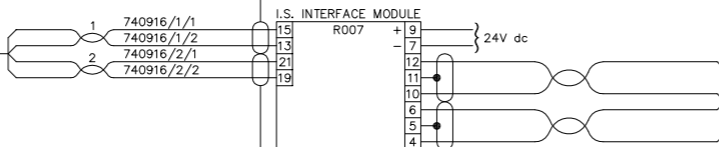

RS422

RS422

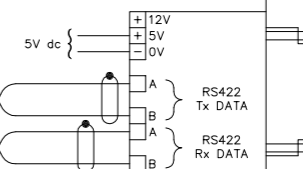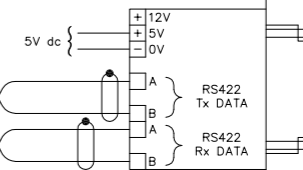


HAZARDOUS AREA SAFE AREA


IF NOT SIGNED THIS DOCUMENT IS UNCONTROLLED

REV	DATE	BY	DRN	CHK'D	APP'D	DESCRIPTION
A	07/04/99	A.J.H	A.J.H	D.R.R	D.R.R	AS BUILT
B	11/01/11	D.B.F	P.P.	M.M.	M.M.	AS BUILT (MERCURY 2 REMOVED)


PLANT	IMMINGHAM STORAGE Co. - EAST TERMINAL
TITLE	4-EAST RAIL LOADING SYSTEM MERCURY KEYPAD COMMS LOOP DIAGRAM
CLIENT DRG. No.	P&I DRG No. SI039015_DWG

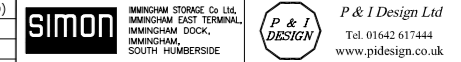

SAFETY PROTECTION			CERTIFIED EQUIPMENT			
INTRINSIC SAFETY	REQUIRED	ACHIEVED	TAG No.	CERTIFICATE No.	CERTIFICATION	AUTHORITY
AREA CLASS	ZONE 1	ZONE 0	R007	Ex 91C2017	[Ex ia] IIC T6	BASEEFA
GAS GROUP	II B	II C				
TEMPERATURE CLASS	T4	T4				

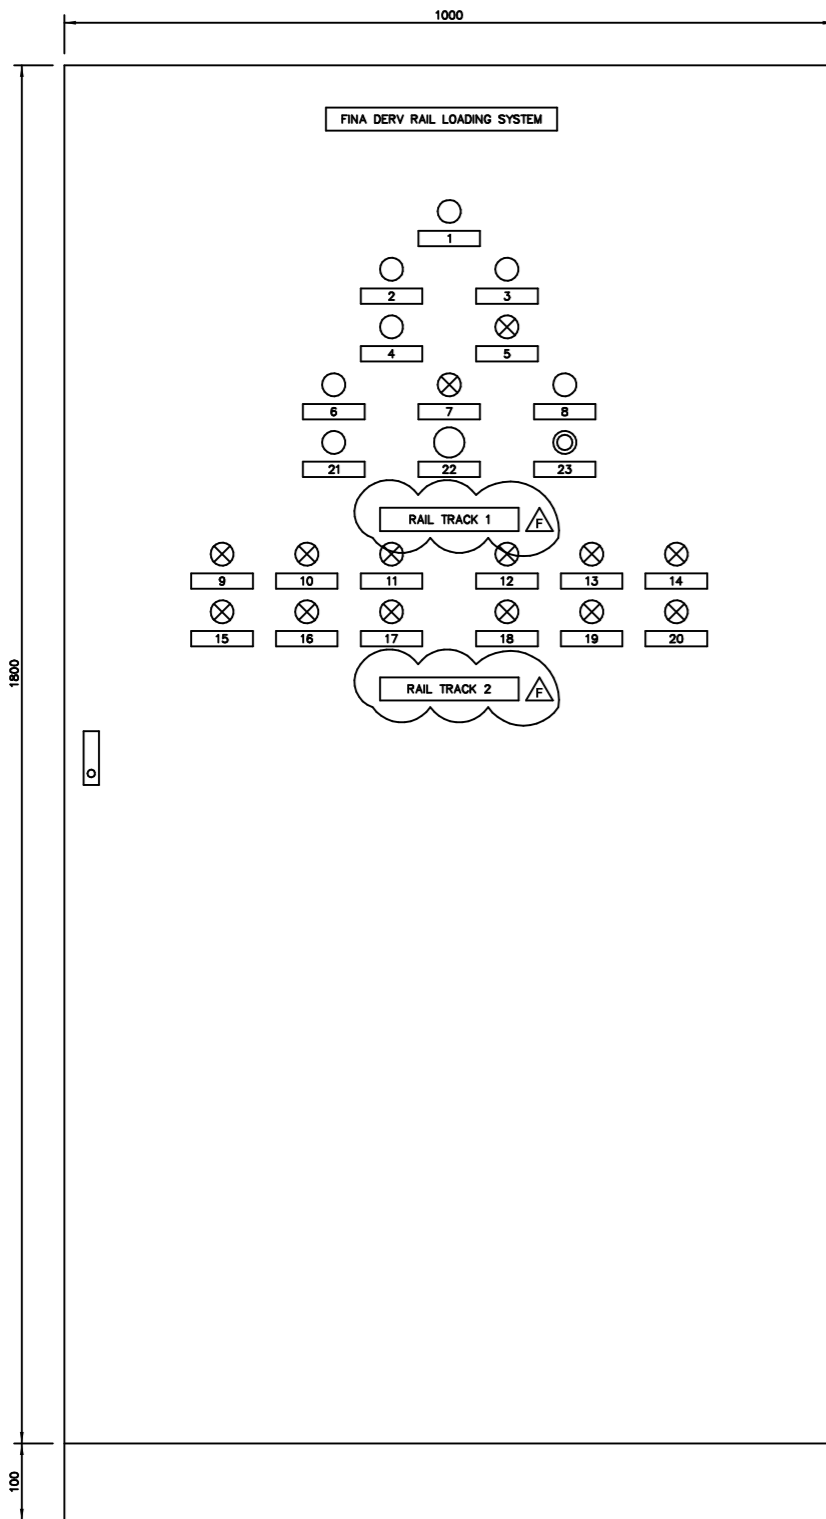


RITTAL ES 5084.600  
FRONT OF PANEL LAYOUT

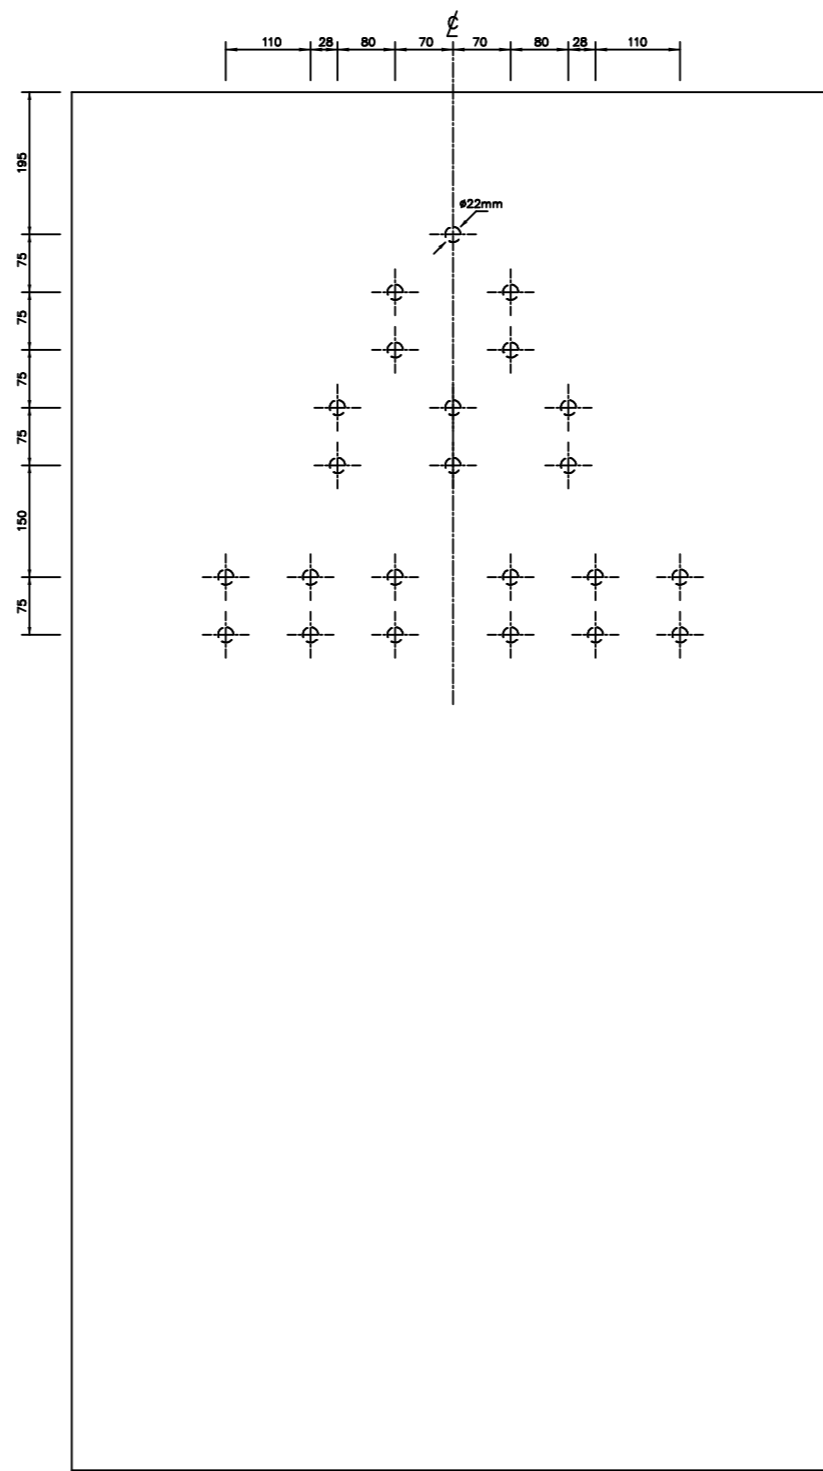

CUT-OUT DETAILS

LOCATION	QUANTITY	ITEMS	STOCK CODE
A	36	RS 4-POLE RELAYS, 24Vdc COIL	RS 213-0793
B	1	RS 4-POLE TIMER RELAYS, 24Vdc COIL (ON DELAY)	RS 328-140
C	1	RS 4-POLE TIMER RELAYS, 24Vdc COIL (OFF DELAY)	RS 328-140
D	15	ASK1	XXXX
E	15	SAK 2.5	XXXX
F	12	ASK1	XXXX
G	12	SAK2.5	XXXX
H	12	EK2.5	XXXX
I	4	MTL 3052	XXXX
J	1	ISOLATOR 25A	XXXX
K	4	RS 4 POLE SAFETY RELAYS, 24Vdc COIL	RS 260-4373
L	6	RS 4-POLE RELAYS, 240VAC COIL	RS 213-0838

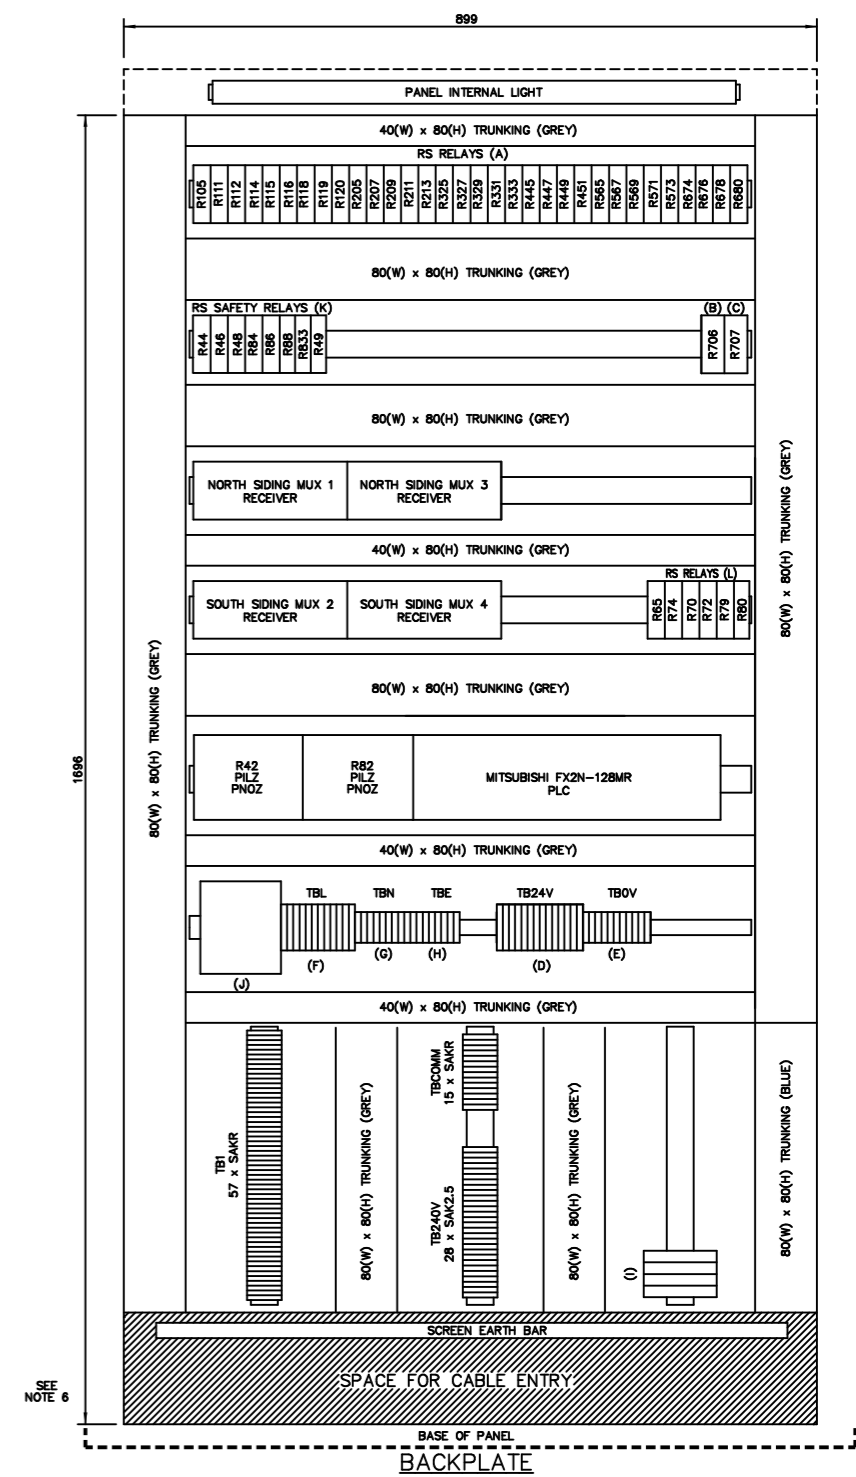

BACKPLATE

LOCATION	LABELS	DETAILS
1		
2		
3		
4		
5		LEVEL SWITCH OPERATED
6		
7		ESD OPERATED
8		
9		
10		LEVEL SWITCH 12 OPERATED
11		LEVEL SWITCH 11 OPERATED
12		LEVEL SWITCH 10 OPERATED
13		LEVEL SWITCH 9 OPERATED
14		LEVEL SWITCH 8 OPERATED
15		LEVEL SWITCH 7 OPERATED
16		LEVEL SWITCH 6 OPERATED
17		LEVEL SWITCH 5 OPERATED
18		LEVEL SWITCH 4 OPERATED
19		LEVEL SWITCH 3 OPERATED
20		LEVEL SWITCH 2 OPERATED
21		LEVEL SWITCH 1 OPERATED
22		ESD
23		LAMP TEST

DO NOT SCALE: CONTRACTOR TO CHECK DIMENSIONS AND REPORT ANY OMISSIONS OR ERRORS

- NOTES
- ALL DIMENSIONS IN mm UNLESS OTHERWISE STATED.
  - INGRESS PROTECTION: IP 56
  - CABLE ENTRY: BOTTOM
  - PANEL DEPTH: 400
  - LABELS TO BE WHITE TRAFFOLYTE WITH BLACK ENGRAVING
  - 2-GANG 240VAC SOCKET & COUTANT LAMBDA DRP240-1 PSU TO BE MOUNTED ON THE PANEL SIDE.

SCALE 1:5  
WHEN PRINTED TO FULL A1  
SIZE ONLY



REV	DATE	BY	DRN	CHK'D	APP'D	DESCRIPTION	
A	08/04/99	A.J.H	A.J.H	D.R.R	D.R.R	D.R.R	GENERAL ISSUE
B	14/03/99	A.J.H	A.J.H	D.R.R	D.R.R	D.R.R	GENERAL UPDATE
C	02/07/99	D.P.	A.J.H	D.R.R	D.R.R	D.R.R	TB COMMS ADDED
D	14/09/10	D.B.F	P.P.	M.M.	M.M.	M.M.	SI760 MODIFICATIONS
E	11/01/11	D.B.F	P.P.	M.M.	M.M.	M.M.	AS BUILT
F	09/06/17	EJENT	D.A.Y	M.M.	M.M.	M.M.	LABEL CHANGE

PLANT	IMMINGHAM STORAGE Co. - EAST TERMINAL
TITLE	4-EAST RAIL LOADING SYSTEM CONTROL PANEL LAYOUT
CLIENT DRG. No.	P&I DESIGN
P&I DESIGN No.	SI039016_DWG


P & I DESIGN  
Tel: 01642 617444  
www.pidesign.co.uk

SHEET 1 OF 1



LABEL:

FINA DERV RAIL LOADING PUMP LOCAL JUNCTION BOX

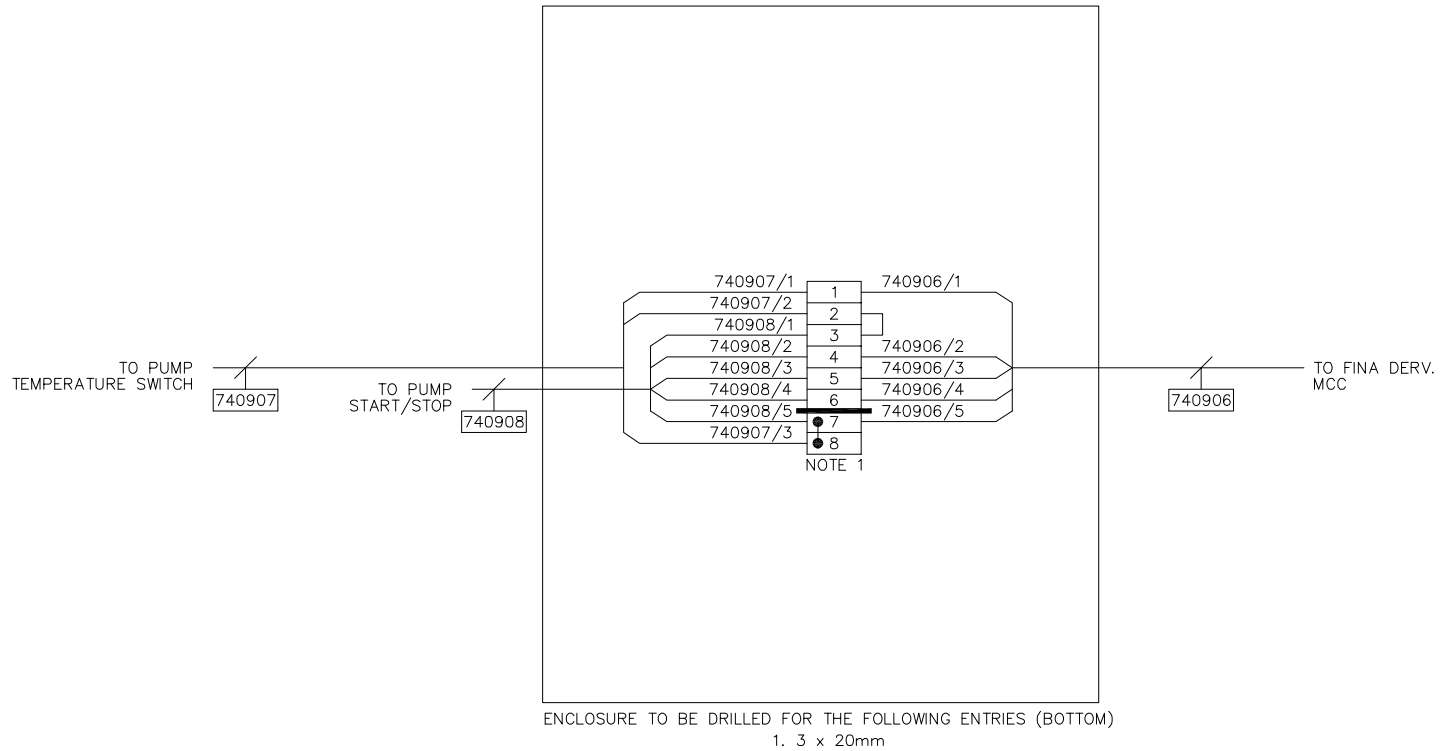

NOTES


1. BOX & TERMINALS TO BE CERTIFIED EEx'e'

REV	DATE	BY	DRN	CHK'D	APP'D	DESCRIPTION	PLANT	FINA DERV RAIL LOADING SYSTEM	
A	06/04/99	A.J.H	A.J.H	D.R.R	D.R.R	ORIGINAL ISSUE	TITLE	PUMP LOCAL JB TERMINAL ARRANGEMENT	
								06/04/99	
							<b>Simon Storage</b>	<b>Terminals</b>	IMMINGHAM STORAGE Co Ltd, IMMINGHAM EAST TERMINAL, IMMINGHAM DOCK, IMMINGHAM, SOUTH HUMBERSIDE
								SHEET	01 OF 01
							CLIENT DRG. No.	P&I DRG No. SI039017	

LABEL:  
FINA DERV RAIL LOADING DC JUNCTION BOX

ENCLOSURE TO BE DRILLED FOR THE FOLLOWING ENTRIES (TOP)

1. 2x40mm
2. 4x25mm
3. 3x20mm (PLUGGED)

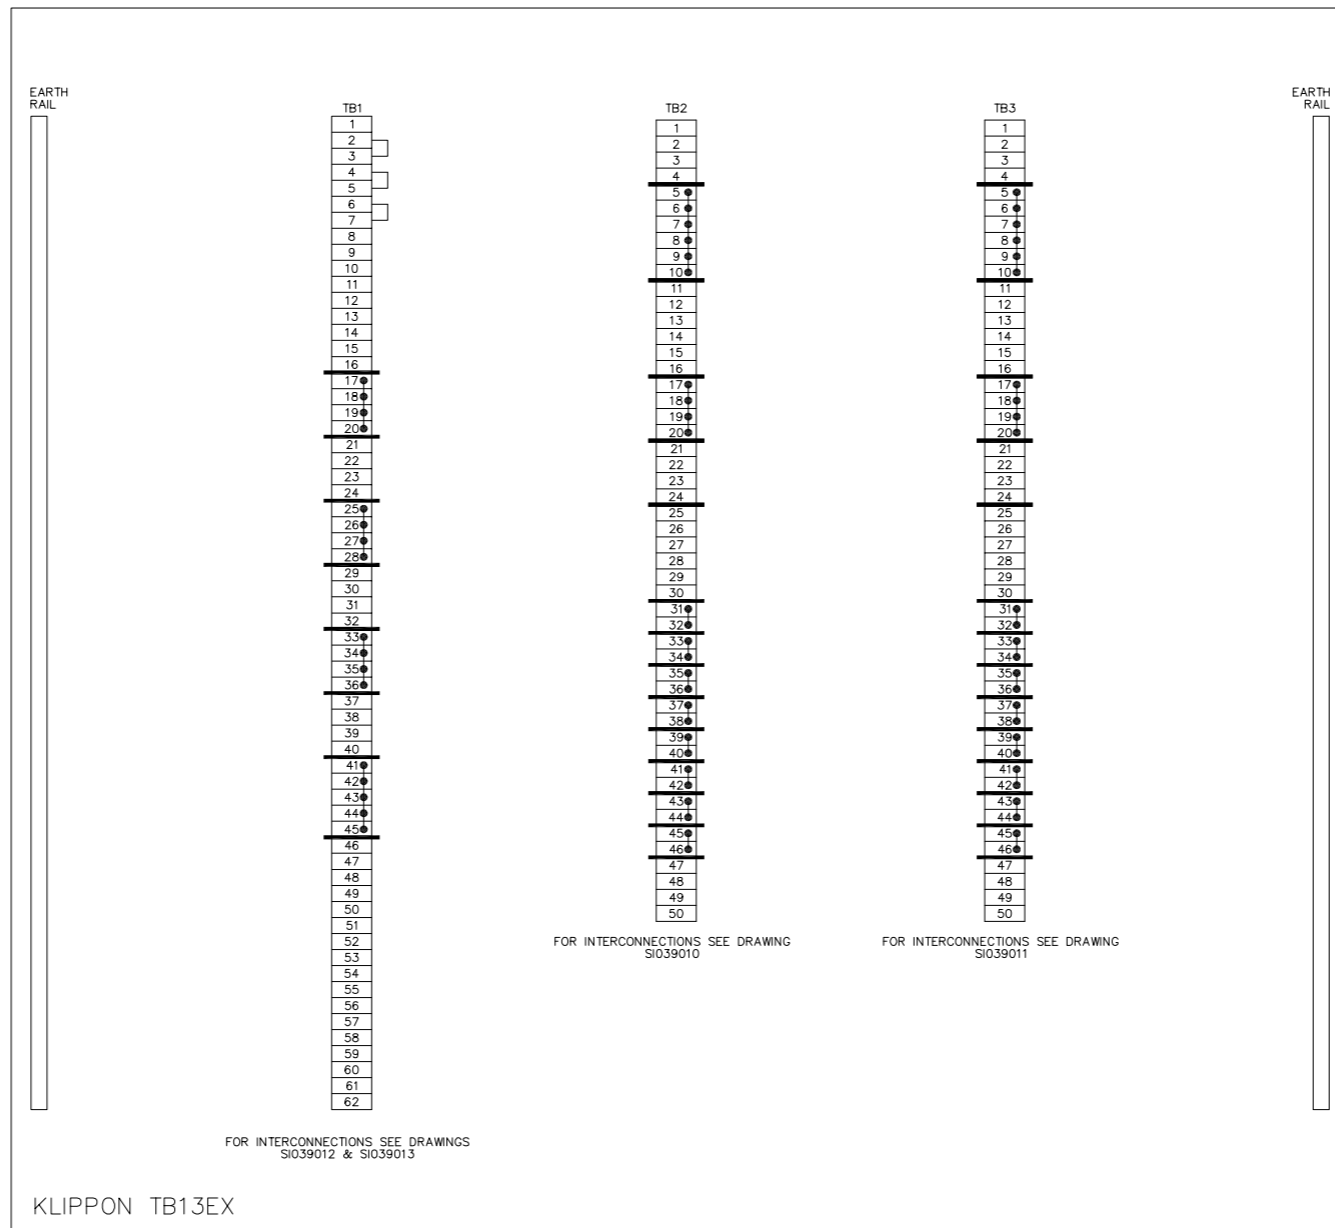

ENCLOSURE TO BE DRILLED FOR THE FOLLOWING ENTRIES (BOTTOM)


1. 26 x 20mm (4 PLUGGED)

NOTES  
1. BOX AND CONTENTS TO BE CERTIFIED EX'9'

REV	DATE	BY	DRN	CHK'D	APP'D	DESCRIPTION	PLANT	FINA DERV RAIL OFFLOADING SYSTEM
A	07/04/99	A.J.H	A.J.H	D.R.R	D.R.R	ORIGINAL ISSUE	TITLE	DC JUNCTION BOX INTERNAL LAYOUT
								07/04/99
							<b>Simon Storage</b>	IMMINGHAM STORAGE Co Ltd, IMMINGHAM EAST TERMINAL, IMMINGHAM DOCK, IMMINGHAM, SOUTH HUMBERSIDE
							<b>Terminals</b>	
								SHEET 01 OF 01
							CLIENT DRG. No.	P&I DRG No. SIO39018

LABEL:

FINA DERV RAIL LOADING AC JUNCTION BOX

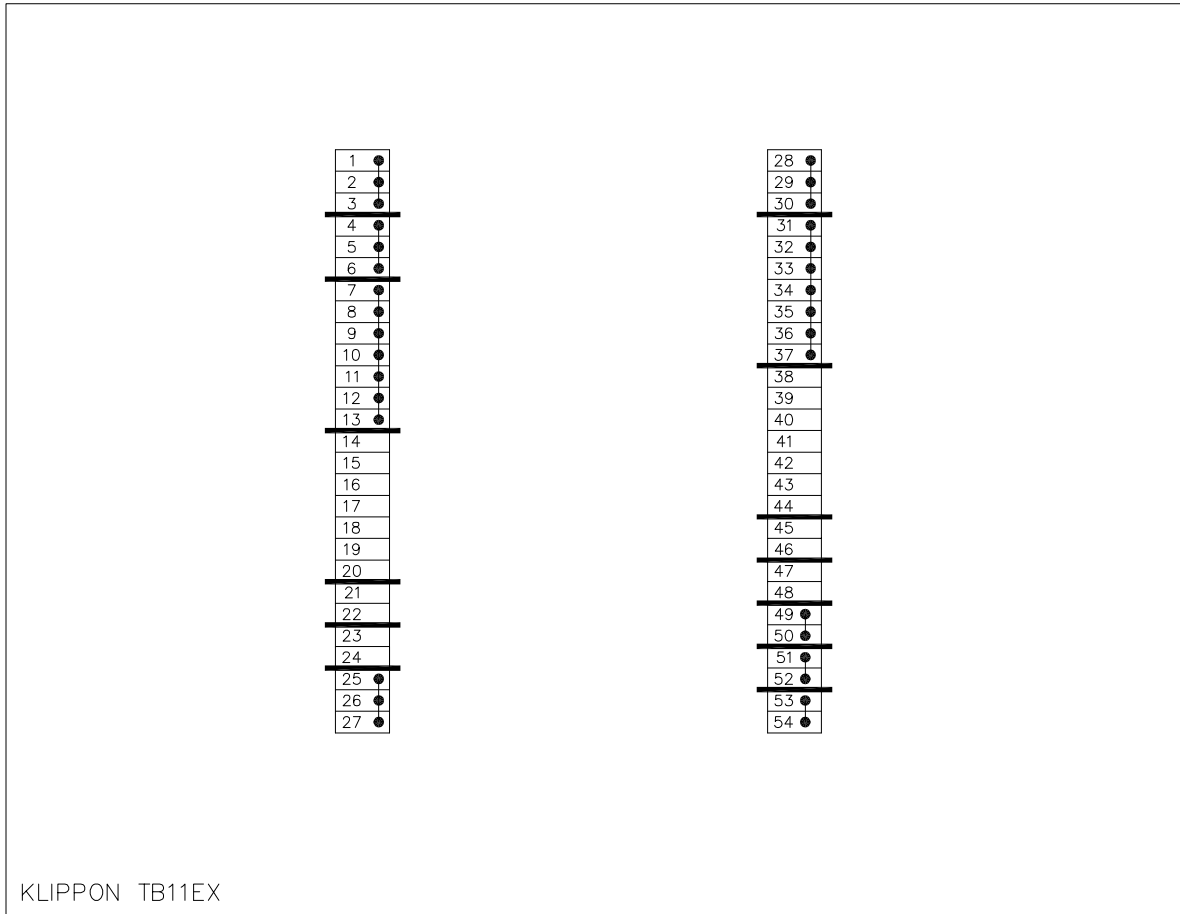


ENCLOSURE TO BE DRILLED FOR THE FOLLOWING ENTRIES (BOTTOM)

- 1. 11 x 20mm (2 PLUGGED)
- 2. 2 x 25mm



NOTES

1. BOX & TERMINALS TO BE CERTIFIED EEx'e'

REV	DATE	BY	DRN	CHK'D	APP'D	DESCRIPTION	PLANT	FINA DERV RAIL OFFLOADING SYSTEM	
A	07/04/99	A.J.H	A.J.H	D.R.R		ORIGINAL ISSUE	TITLE	AC JUNCTION BOX INTERNAL LAYOUT	
								07/04/99	
							<b>SIMON Storage</b>	<b>Terminals</b>	IMMINGHAM STORAGE Co Ltd, IMMINGHAM EAST TERMINAL, IMMINGHAM DOCK, IMMINGHAM, SOUTH HUMBERSIDE
									
								SHEET	01 OF 01
							CLIENT DRG. No.	P&I DRG No. SI039019	


DETAIL A  
 TERMINAL ARRANGMENT  
 SEE DETAIL B FOR WIRING DIAGRAM

DETAIL B  
 WIRING DIAGRAM

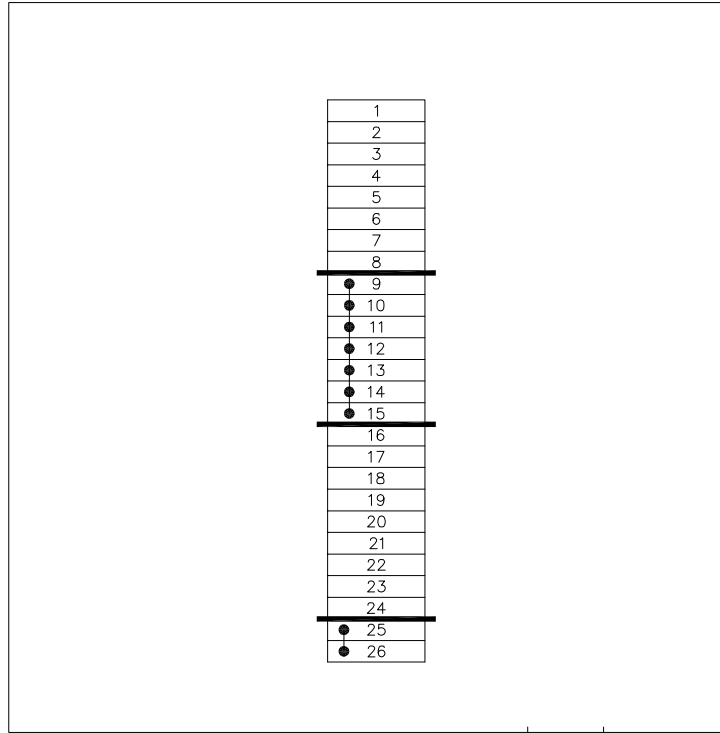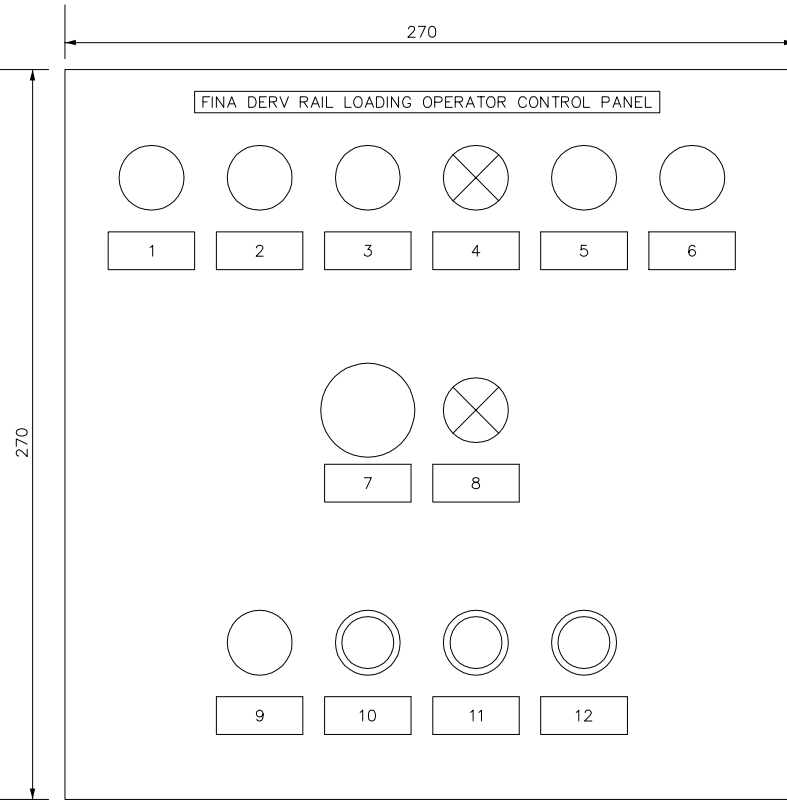

1 x 25mm ENTRY


ESD  
 RESET  
 HORN SILENCE  
 LAMP TEST  
 ESD OPERATED  
 LEVEL SWITCH OPERATED

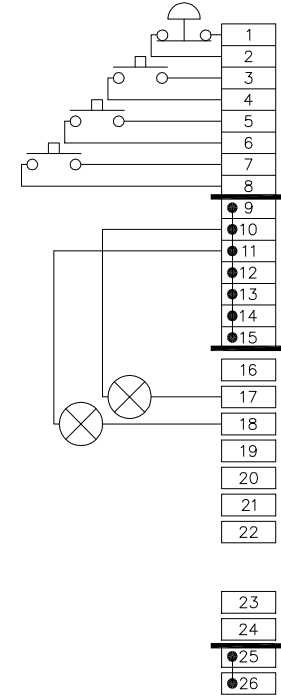


ITEM	TOP LINE	BOTTOM LINE	LAMP COLOUR	NOTES
1				HOLE BLANKED
2				HOLE BLANKED
3				HOLE BLANKED
4	LEVEL SWITCH	OPERATED	RED	
5				HOLE BLANKED
6				HOLE BLANKED
7	ESD		N/A	
8	ESD	OPERATED	RED	
9				HOLE BLANKED
10	RESET		N/A	
11	HORN	SILENCE	N/A	
12	LAMP	TEST	N/A	

REV	DATE	BY	DRN	CHK'D	APP'D	DESCRIPTION	PLANT	FINA DERV RAIL LOADING SYSTEM
A	10/03/99	A.J.H	A.J.H	D.R.R	D.R.R	D.R.R	TITLE	OPERATOR CONTROL PANEL LAYOUT
B	11/03/99	A.J.H	A.J.H	D.R.R	D.R.R	D.R.R		06/04/99
C	06/04/99	A.J.H	A.J.H	D.R.R		D.R.R		
D	12/05/11	D.B.F	P.P.	M.M.		M.M.		
							<b>Simon Storage</b>	IMMINGHAM STORAGE Co Ltd, IMMINGHAM EAST TERMINAL, IMMINGHAM DOCK, IMMINGHAM, SOUTH HUMBERSIDE
							<b>Terminals</b>	
							SHEET	01 OF 01
							CLIENT DRG. No.	P&I DRG No. SI039020

LEGEND OF GRAPHICAL SYMBOLS (ALL CONTACTS SHOWN IN THE DE-ENERGISED STATE)

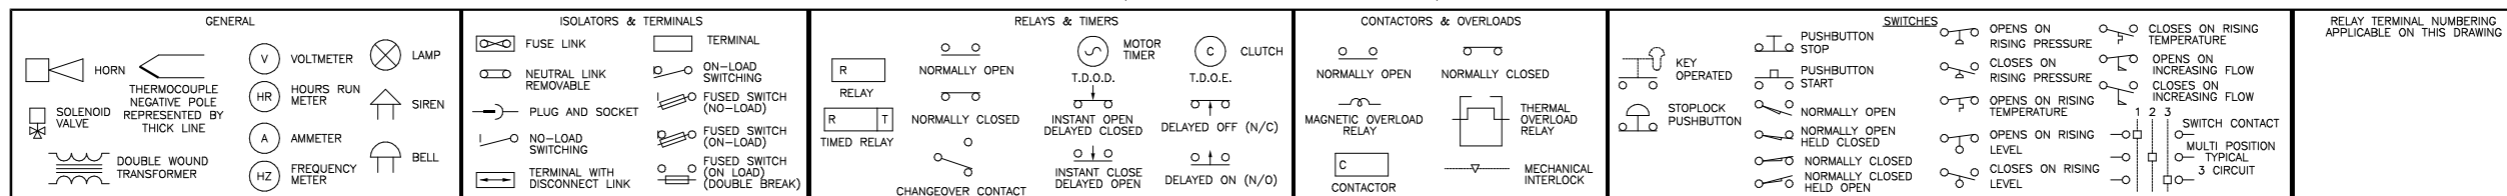

PUMP SELECTOR P4-66/P4-67

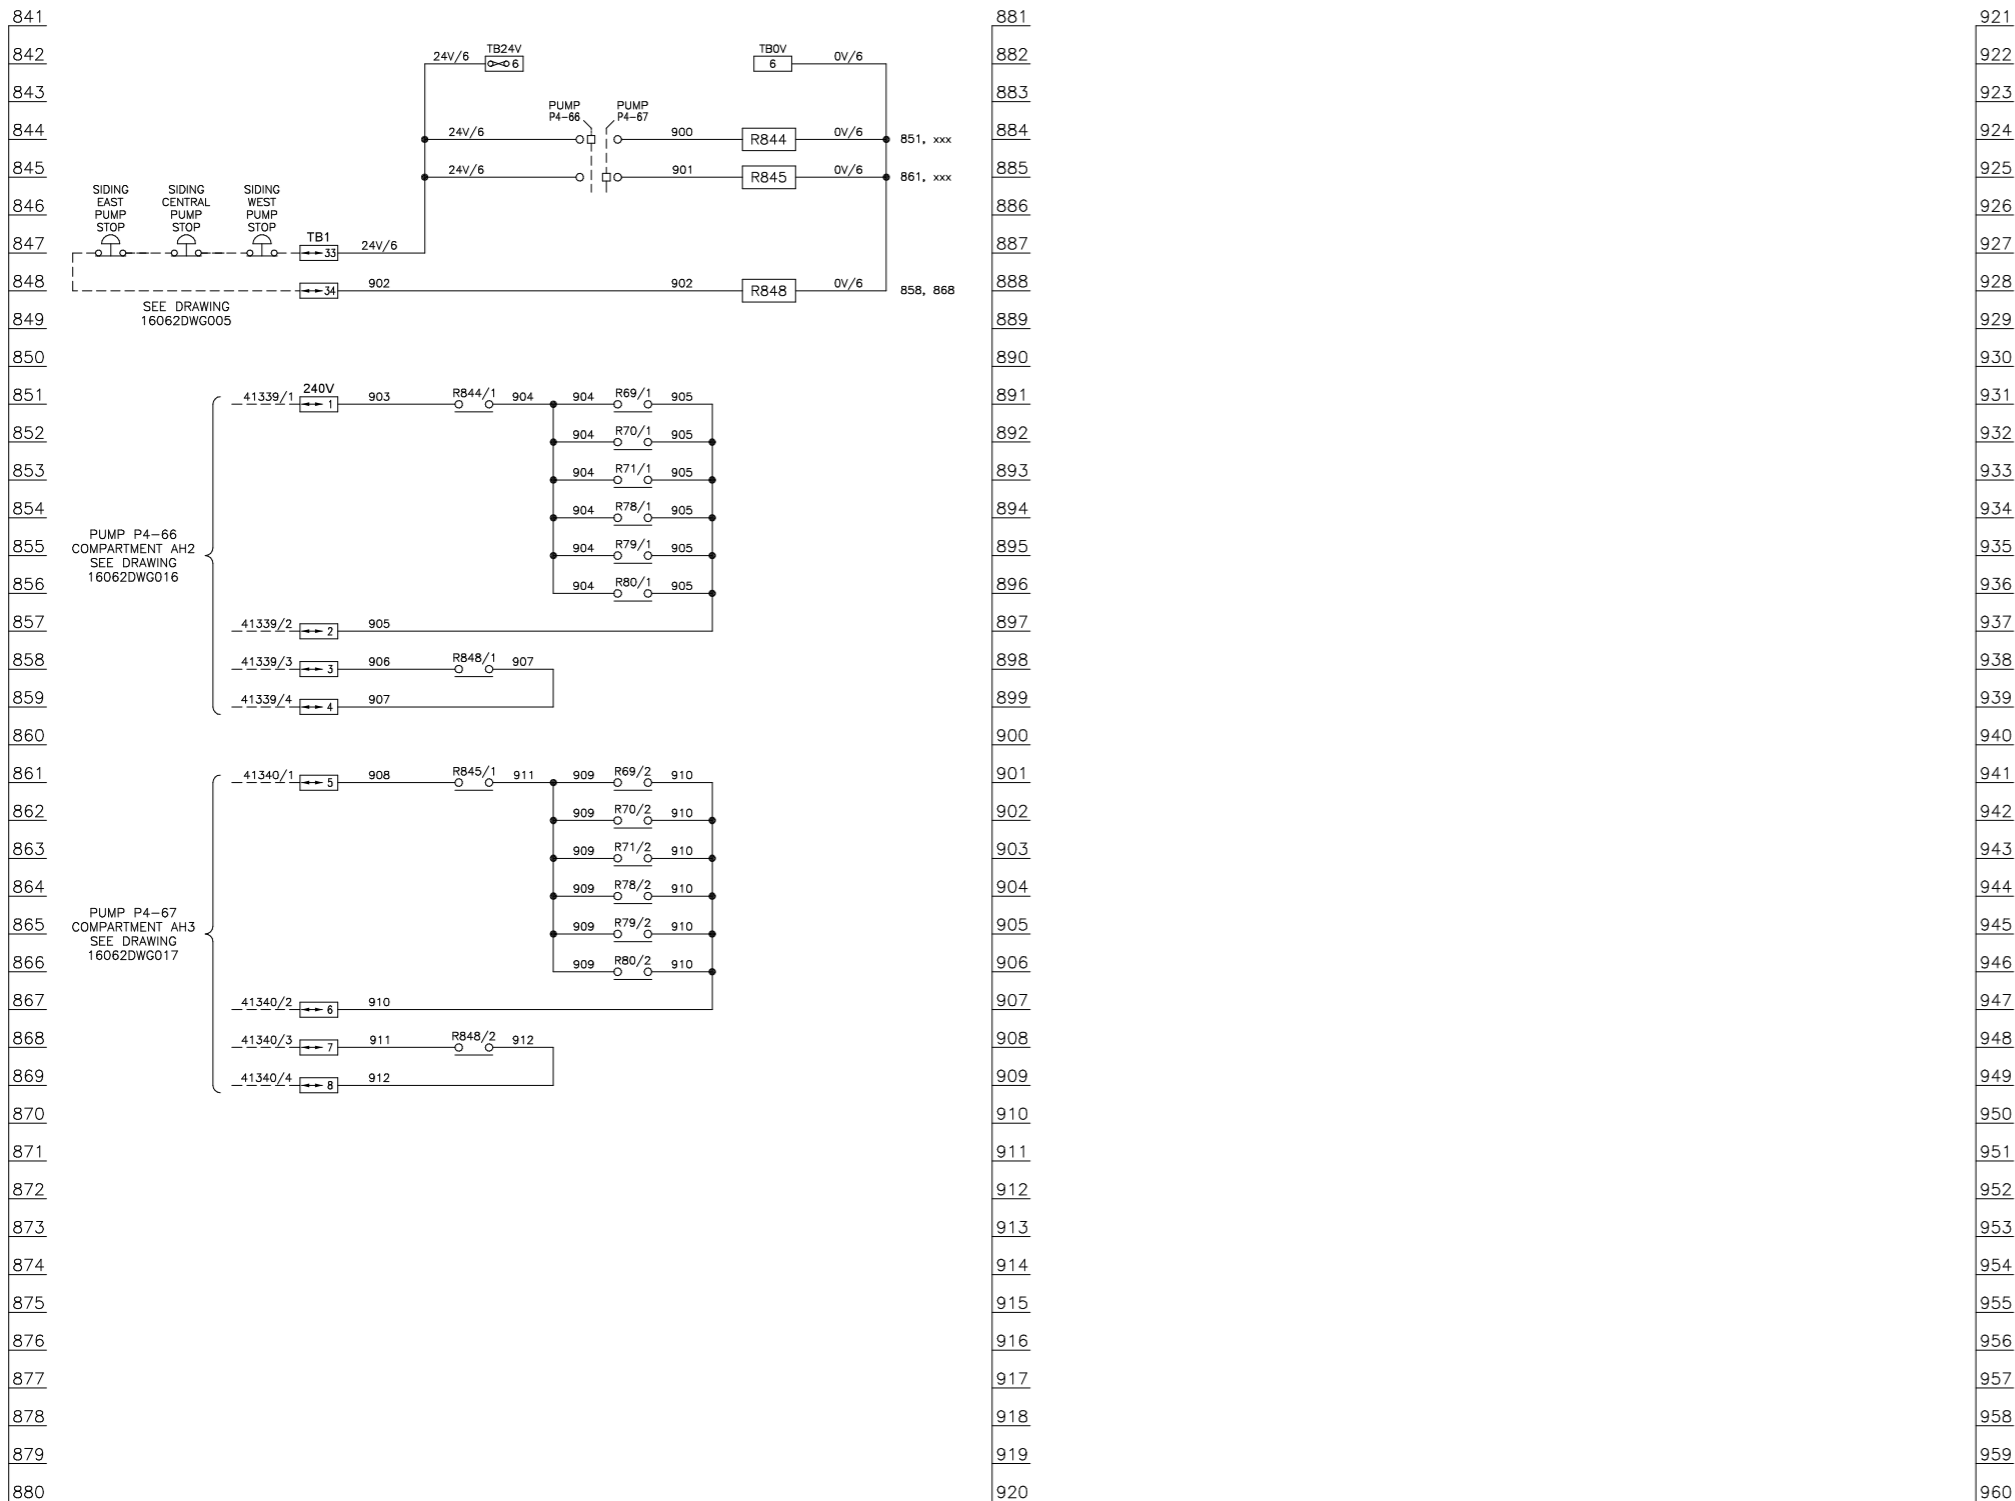


LAST NUMBER USED: 912  
SPARE TO: 920

IF NOT SIGNED THIS DOCUMENT IS UNCONTROLLED						
REV	DATE	BY	DRN	CHK'D	APP'D	DESCRIPTION
A	04/01/17	P.P.	P.P.	D.R.P	D.R.P	M.M. M.M. AS BUILT - 16062 PROJECT
B	24/01/17	P.P.	P.P.	M.M.	M.M.	PUMP STOP DETAILS ADDED

PLANT	INTER TERMINALS IMMINGHAM LTD - EAST TERMINAL
TITLE	4-EAST RAIL LOADING SYSTEM PANEL LOGIC DRAWING 8
inter terminals Inter Terminals Immingham Ltd Immingham East Terminal Immingham Dock Immingham N.E. Lincolnshire DN40 2QW	P & I Design Ltd Tel. 01642 617444 www.pidesign.co.uk
CLIENT DRG. No.	P&I DRG No. SI039022_DWG
SHEET 1 OF 1	

No.2 SWITCHROOM - MCC COMPARTMENT B2E

FIELD

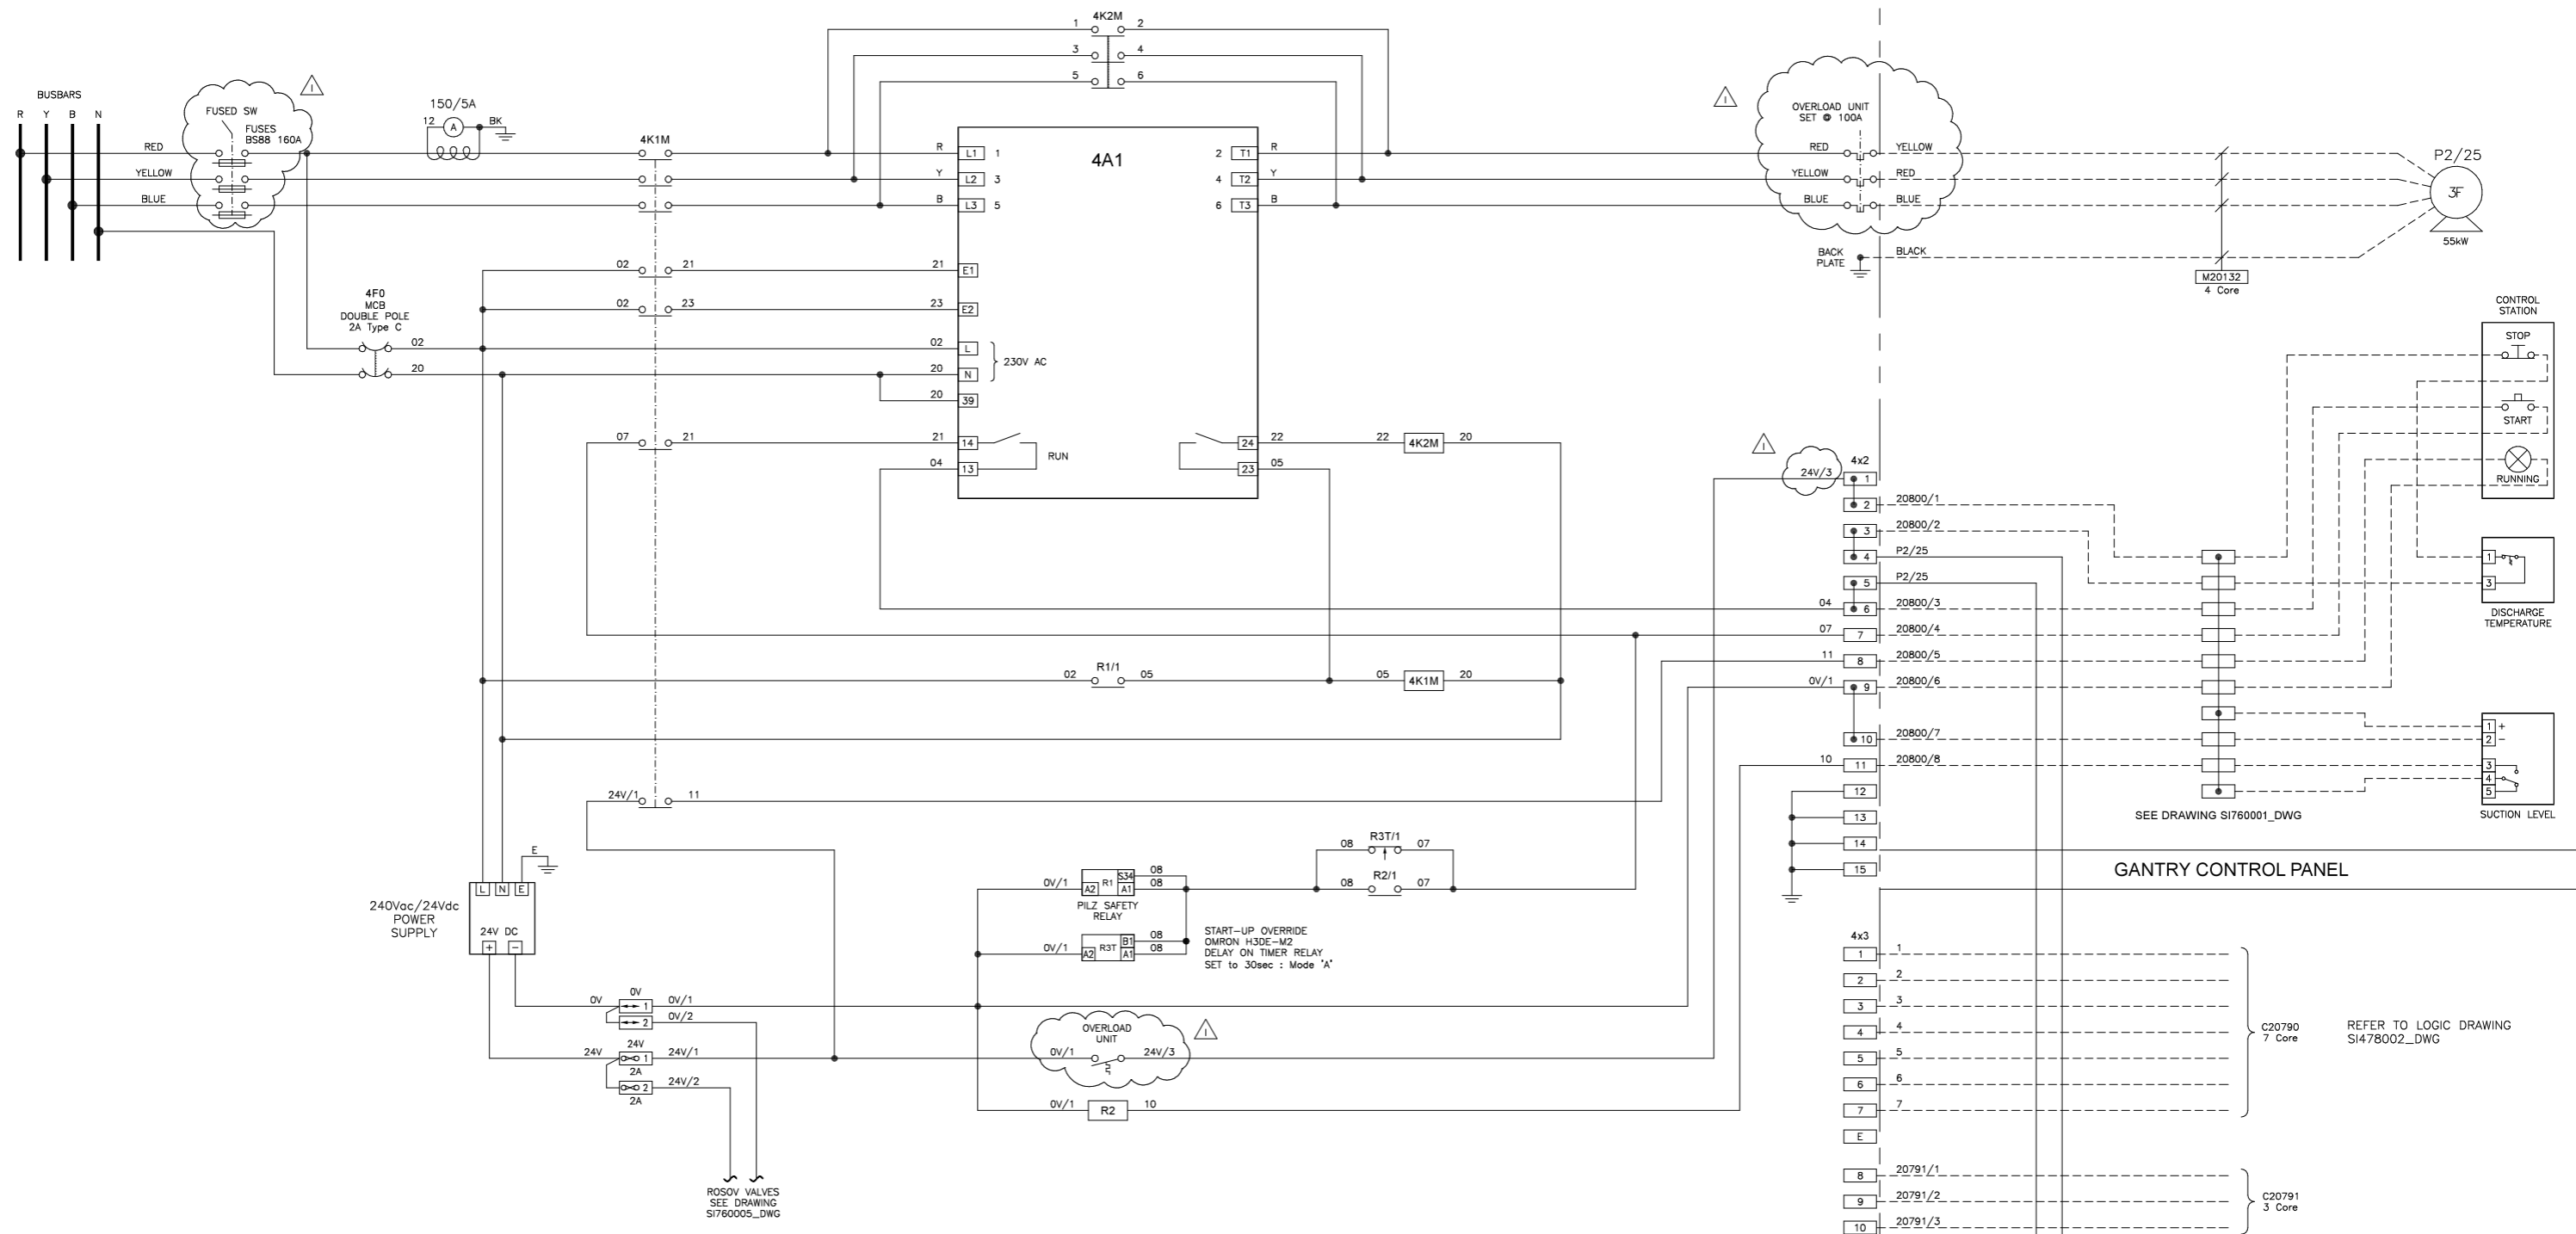

No.2 SWITCHROOM - MCC COMPARTMENT B2F



- NOTES
- JETTY STOP - RELAY ENERGIZED TO STOP DRIVE.
  - THIS DRAWING REPLACES SITE DRAWING SPW-03-688.DWG

IF NOT SIGNED THIS DOCUMENT IS UNCONTROLLED




REV	DATE	BY	DRN	CHK'D	APP'D	DESCRIPTION	REV	DATE	BY	DRN	CHK'D	APP'D	DESCRIPTION				
H	30/11/10	P.P.	P.P.	D.B.F	D.B.F	M.M.	M.M.	ROSOV VALVE POWER ADDED	A	10/12/98	A.J.H	A.J.H	D.R.R	D.R.R	D.R.R	D.R.R	ORIGINAL ISSUE
I	10/07/15	ISCO	P.P.	D.B.F		M.M.		SITE MODIFICATIONS ADDED	B	19/01/99	A.J.H	A.J.H	D.R.R	D.R.R	D.R.R	D.R.R	GENERAL UPDATE
									C	01/02/99	A.J.H	A.J.H	D.R.R	D.R.R	D.R.R	D.R.R	SOFT START CHANGED
									D	17/03/99	A.J.H	A.J.H	D.R.R	D.R.R	D.R.R	D.R.R	PANEL TEST MODS.
									E	23/06/00	M.M.	A.B.	D.R.R	D.R.R	D.R.R	D.R.R	SOFT START MODS.
									F	19/10/10	P.P.	P.P.	D.B.F	D.R.R	M.M.	D.R.R	COMPARTMENT RE-WIRED
									G	28/10/10	P.P.	P.P.	D.B.F	D.R.R	M.M.	M.M.	PUMP CONTROLS REVISED

PLANT: IMMINGHAM STORAGE Co. - EAST TERMINAL  
 TITLE: P2/25 PUMP MCC DIAGRAM

**inter terminals**  
 Immingham Storage Co Ltd  
 Immingham East Terminal  
 N.E. Lincolnshire  
 DN40 2QW

**P & I Design Ltd**  
 Tel. 01642 617444  
 www.pidesign.co.uk

SHEET 1 OF 1  
 P&I DRG No. SI478006\_DWG

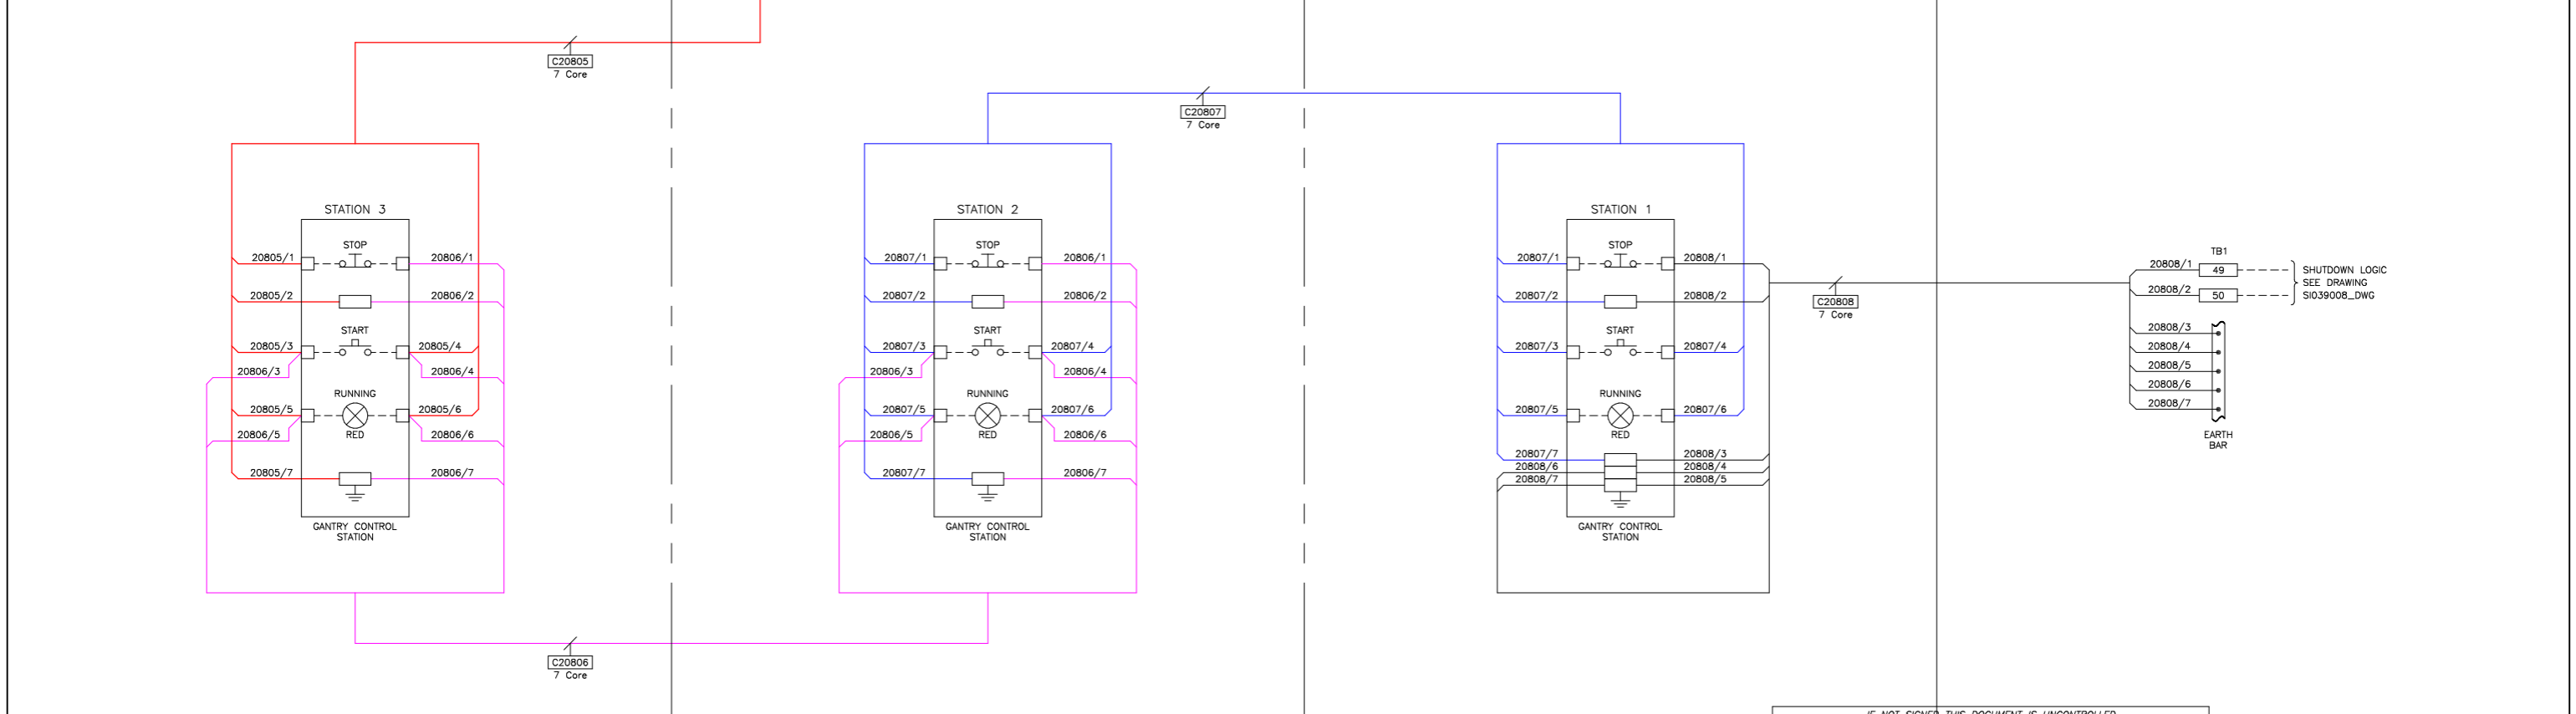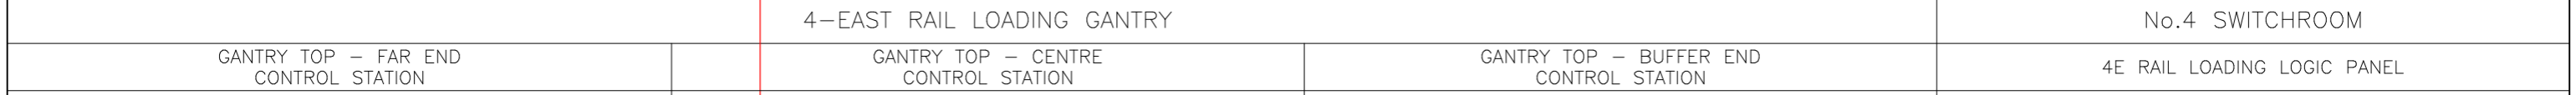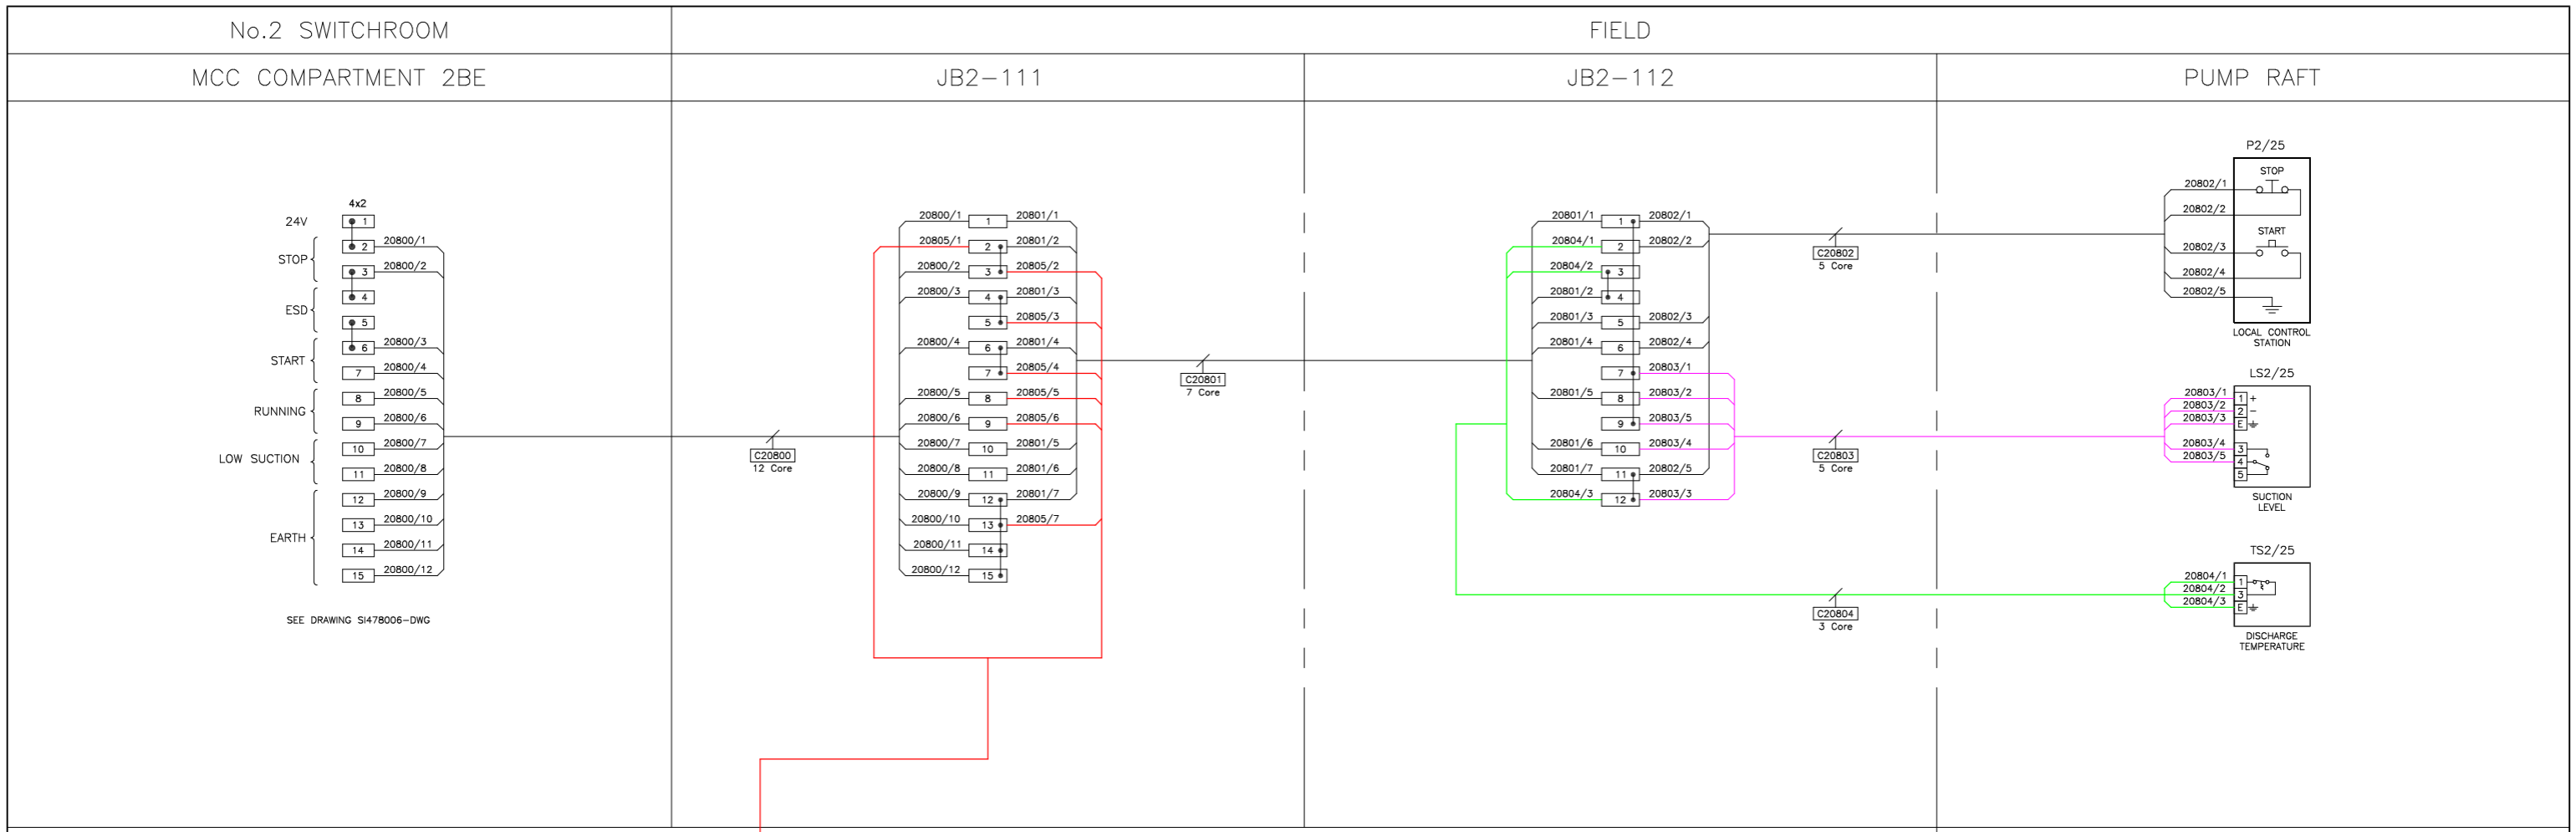

NOTES  
1)

IF NOT SIGNED THIS DOCUMENT IS UNCONTROLLED

REV	DATE	BY	DRN	CHK'D	APP'D	DESCRIPTION
A	01/10/10	P.P.	P.P.	D.B.F	D.B.F	M.M. M.M. ISSUED FOR CONSTRUCTION
B	28/10/10	P.P.	P.P.	D.B.F	D.B.F	M.M. M.M. JB2-112 REVISED
C	11/01/11	D.B.F	P.P.	M.M.	D.B.F	M.M. M.M. AS BUILT
D	10/07/15	ISC	P.P.	M.M.	M.M.	M.M. M.M. SITE MODIFICATION ADDED
E	24/01/17	P.P.	P.P.	M.M.	M.M.	M.M. M.M. AS BUILT - 16062 PROJECT

PLANT	IMMINGHAM STORAGE Co. - EAST TERMINAL
TITLE	4-EAST RAIL LOADING SYSTEM - PUMP P2/25 CONTROL JUNCTION BOX INTERCONNECTION DETAILS
	Immingham Storage Co Ltd Immingham East Terminal Immingham Dock Immingham N.E. Lincolnshire DN40 2QW
CLIENT DRG. No.	P&I DRG No. SI760001_DWG

SHEET 1 OF 1






No.5 SWITCHROOM

FIELD

MCC 5/2 COMPARTMENT A1

JB5/61

PUMP RAFT

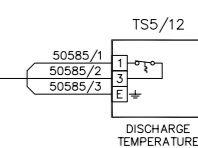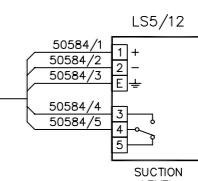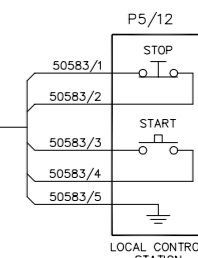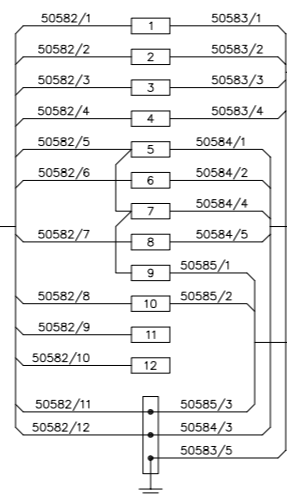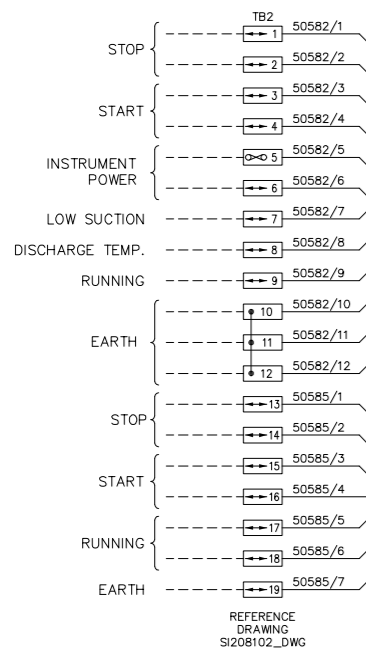

4-EAST RAIL LOADING GANTRY





No.4 SWITCHROOM

GANTRY TOP - BUFFER END CONTROL STATION

GANTRY TOP - CENTRE CONTROL STATION

GANTRY TOP - FAR END CONTROL STATION

4E RAIL LOADING LOGIC PANEL

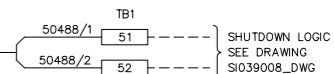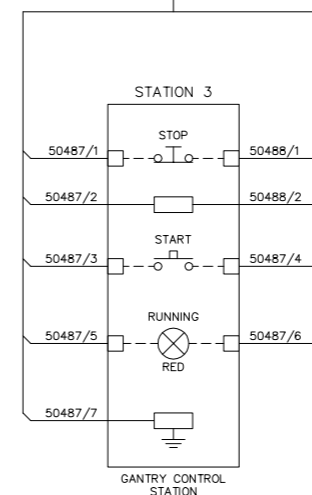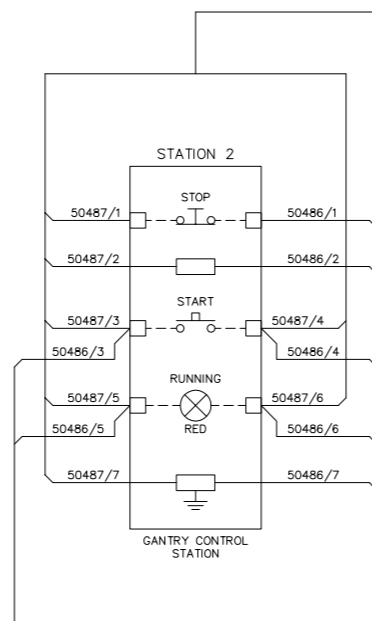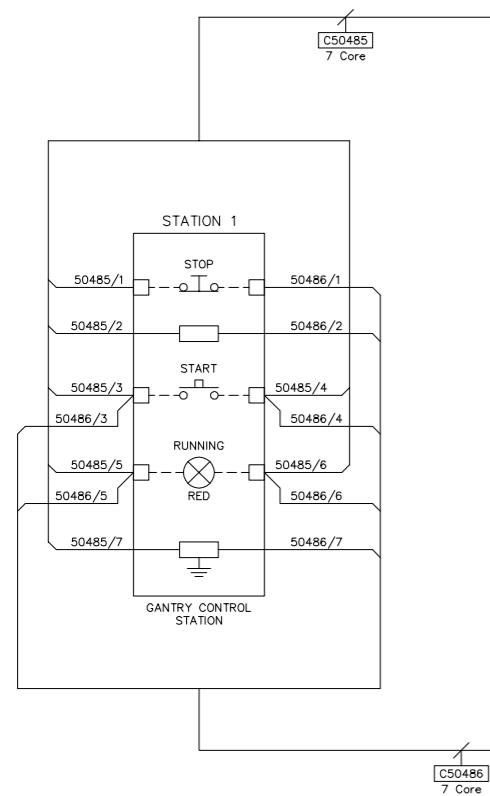

NOTES

1)



IF NOT SIGNED THIS DOCUMENT IS UNCONTROLLED

REV	DATE	BY	DRN	CHK'D	APP'D	DESCRIPTION
A	01/10/10	P.P.	P.P.	D.B.F	D.B.F	M.M. M.M. ISSUED FOR CONSTRUCTION
B	11/01/11	D.B.F	P.P.	M.M.	M.M.	AS BUILT

PLANT	IMMINGHAM STORAGE Co. - EAST TERMINAL
TITLE	4-EAST RAIL LOADING SYSTEM - PUMP P5/12 CONTROL JUNCTION BOX INTERCONNECTION DETAILS
CLIENT DRG. No.	P&I DRG No. SI760002_DWG



P & I Design Ltd  
Tel. 01642 617444  
www.pidesign.co.uk

SHEET 1 OF 1




600 SERIES TANK FARM

SAFE AREA


TANK 601 RAIL LOADING VALVE XV60103

JB4/89  
TANK ISOLATION PUSHBUTTON JUNCTION BOX


No.2 SWITCHROOM - MCC COMPARTMENT B2F

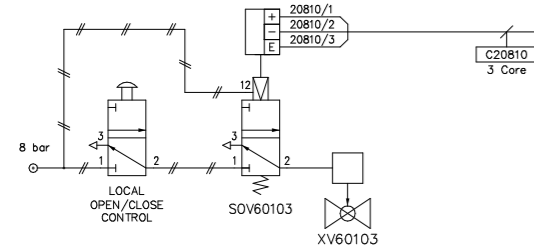


TANK 602 RAIL LOADING VALVE XV60203

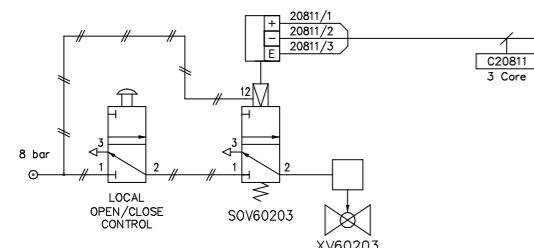

TANK 603 RAIL LOADING VALVE XV60303

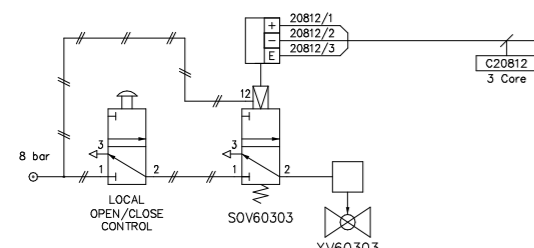

**NOTE**  
PUSHBUTTON CONTACT SET 1 IS FED FROM No.4 SWITCHROOM AND IS PART OF THE SIS SYSTEM

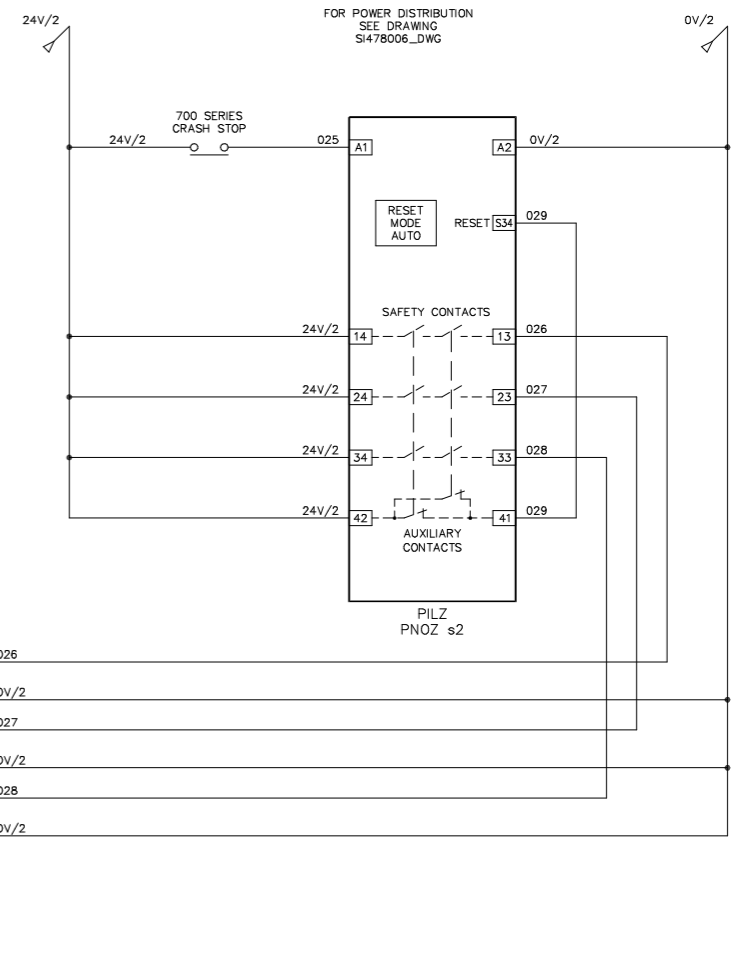

NOTES  
1)



IF NOT SIGNED THIS DOCUMENT IS UNCONTROLLED

REV	DATE	BY	DRN	CHK'D	APP'D	DESCRIPTION
A	30/11/10	P.P.	P.P.	D.B.F	D.B.F	M.M. M.M. ISSUED FOR CONSTRUCTION
B	31/08/11	P.P.	P.P.	D.B.F	M.M.	AS BUILT

PLANT	IMMINGHAM STORAGE Co. - EAST TERMINAL
TITLE	4-EAST RAIL LOADING SYSTEM TANK 601, 602 & 603 RAIL LOADING VALVE LOOP SHEET
CLIENT DRG. No.	P&I DRG No. SI760005_DWG



P & I Design Ltd  
 Tel: 01642 617444  
 www.pidesign.co.uk

SHEET 1 OF 1

## INSTRUMENT/ELECTRICAL CABLE SCHEDULE

CABLE		CONDUCTORS		CABLE ROUTE				APPROX. LENGTH METRES	REMARKS
REFERENCE	TYPE	AREA mm <sup>2</sup>	No.	FROM	GLAND TYPE	TO	GLAND TYPE		
740900	TBA	TBA	5	EXISTING SUPPLY	EExe	BUSBAR CHAMBER	EExe		
740901	J03	2.5	3	240V DISTRIBUTION BOARD	EExe	CONTROL PANEL	EExe		
740902	J07	1.5	7	CONTROL PANEL	EExe	MCC FINA DERV PUMP SOFT START	EExe		
740903	J04	1.5	4	CONTROL PANEL	EExe	MCC FINA DERV PUMP SOFT START	EExe		
740904	E02I	0.75	2 pair	COMMUNICATIONS INTERFACE PANEL	EExe	JUNCTION BOX	EExe		
740905	J04	70	4	MCC FINA DERV PUMP SOFT START	EExe	55 KW PUMP	EExe		
740906	J05	1.5	5	MCC FINA DERV PUMP SOFT START	EExe	PUMP LOCAL JUNCTION BOX	EExe		
740907	J03	1.5	3	PUMP LOCAL JUNCTION BOX	EExe	TEMPERATURE SWITCH HIGH	EExe		
740908	J05	1.5	5	PUMP LOCAL JUNCTION BOX	EExe	STOP/START	EExe		
740909	E02I	0.75	2 pair	CONTROL PANEL	EExe	MUX 1 & 2 PANEL	EExe		
740910	J19	1.5	19	CONTROL PANEL	EExe	DC JUNCTION BOX	EExe		
740911	J07	2.5	7	CONTROL PANEL	EExe	NORTH SIDING DANLOAD 240V AC ISOL.	EExe		
740912	J03	2.5	3	CONTROL PANEL	EExe	MUX ANTI-COND. HEATER ISOLATOR	EExe		
740913	J07	2.5	7	CONTROL PANEL	EExe	SOUTH SIDING DANLOAD 240V AC ISOL.	EExe		
740914	J19	1.5	19	CONTROL PANEL	EExe	DC JUNCTION BOX	EExe		
740915	E02I	0.75	2 pair	CONTROL PANEL	EExe	MUX 3 & 4 PANEL	EExe		
740916	E02I	0.75	2 pair	COMMUNICATIONS INTERFACE PANEL	EExe	JUNCTION BOX	EExe		
740917	J19	1.5	19	OPERATORS CONTROL PANEL	EExe	DC JUNCTION BOX	EExe		
740918	J02	1.5	2	ESD @ CONTROL STATION END	EExe	DC JUNCTION BOX	EExe		
740919	J02	1.5	2	ESD @ FAR END	EExe	DC JUNCTION BOX	EExe		
740920	J02	1.5	2	HORN	EExe	DC JUNCTION BOX	EExe		
740921	J02	1.5	2	DC JUNCTION BOX	EExe	XSV1	EExe		
740922	J02	1.5	2	DC JUNCTION BOX	EExe	XSV2	EExe		
740923	J02	1.5	2	DC JUNCTION BOX	EExe	XSV3	EExe		
740924	J02	1.5	2	DC JUNCTION BOX	EExe	XSV7	EExe		
740925	J02	1.5	2	DC JUNCTION BOX	EExe	XSV8	EExe		
740926	J02	1.5	2	DC JUNCTION BOX	EExe	XSV9	EExe		
740927									
740928									
740929									
740930									
							TOTAL		



**Note : Refer to P&I Design Cable Specifications for details on Cable Type.**

REFERENCE DRAWINGS	REV	DATE	BY	DRN	CHK'D	APP'D	DESCRIPTION	PLANT	4 East Rail Loading	
	A	12.03.99	A.J.H	A.J.H	P.J.P	P.J.P	ORIGINAL ISSUE	TITLE	Cable Schedule	
	B	09.04.99	A.J.H	A.J.H	D.R.R	D.R.R	GENERAL UPDATE			
	C	02.07.99	A.J.H	A.J.H	D.R.R	D.R.R	740994 ADDED			
	D	24.12.10	D.B.F	D.B.F	MM	MM	SI760 Update			
	E	22.04.11	D.B.F	D.B.F	MM	MM	As Built			
									SHEET 1 OF 4	
								CLIENT DRG No	REF NO. SI039100_SCH	

## INSTRUMENT/ELECTRICAL CABLE SCHEDULE

CABLE		CONDUCTORS		CABLE ROUTE				APPROX. LENGTH METRES	REMARKS
REFERENCE	TYPE	AREA mm <sup>2</sup>	No.	FROM	GLAND TYPE	TO	GLAND TYPE		
740931	J07	2.5	7	DANLOAD 240V ISOLATOR (NORTH SIDING)	EExe	AC JUNCTION BOX	EExe		
740932	J03	2.5	3	MUX ANTI COND HEATER ISOLATOR	EExe	AC JUNCTION BOX	EExe		
740933	J07	2.5	7	DANLOAD 240V ISOLATOR (SOUTH SIDING)	EExe	AC JUNCTION BOX	EExe		
740934									
740935									
740936									
740937									
740938	J02	1.5	2	DC JUNCTION BOX	EExe	XSV4	EExe		
740939	J02	1.5	2	DC JUNCTION BOX	EExe	XSV5	EExe		
740940	J02	1.5	2	DC JUNCTION BOX	EExe	XSV6	EExe		
740941	J02	1.5	2	DC JUNCTION BOX	EExe	XSV10	EExe		
740942	J02	1.5	2	DC JUNCTION BOX	EExe	XSV11	EExe		
740943	J02	1.5	2	DC JUNCTION BOX	EExe	XSV12	EExe		
740944									
740945									
740946									
740947									
740948	J03	1.5	3	AC JUNCTION BOX	EExe	MUX 1 & 2 HEATER EXE TERMINALS	EExe		
740949	J03	1.5	3	AC JUNCTION BOX	EExe	MUX 3 & 4 HEATER EXE TERMINALS	EExe		
740950									
740951									
740952	E02I	0.75	2 pair	MUX 1 & 2 PANEL	EExe	XV1 OPEN/CLOSED LIMITS	EExe		
740953	E02I	0.75	2 pair	MUX 1 & 2 PANEL	EExe	XCV1 OPEN/CLOSED LIMIT	EExe		
740954	E01I	0.75	1 pair	MUX 1 & 2 PANEL	EExe	LS1 HIGH LIMITS	EExe		
740955	E02I	0.75	2 pair	MUX 1 & 2 PANEL	EExe	XV2 OPEN/CLOSED LIMITS	EExe		
740956	E02I	0.75	2 pair	MUX 1 & 2 PANEL	EExe	XCV2 OPEN/CLOSED LIMITS	EExe		
740957	E01I	0.75	1 pair	MUX 1 & 2 PANEL	EExe	LS2 HIGH LEVEL	EExe		
740958	E02I	0.75	2 pair	MUX 1 & 2 PANEL	EExe	XV3 OPEN/CLOSED LIMITS	EExe		
740959	E02I	0.75	2 pair	MUX 1 & 2 PANEL	EExe	XCV3 OPEN/CLOSED LIMITS	EExe		
740960	E01I	0.75	1 pair	MUX 1 & 2 PANEL	EExe	LS3 HIGH LEVEL	EExe		
740961	E02I	0.75	2 pair	MUX 1 & 2 PANEL	EExe	XV7 OPEN/CLOSED LIMITS	EExe		
							TOTAL		

**Note : Refer to P&I Design Cable Specifications for details on Cable Type.**

REFERENCE DRAWINGS	REV	DATE	BY	DRN	CHK'D	APP'D	DESCRIPTION	PLANT	4 East Rail Loading	
	A	12.03.99	A.J.H	A.J.H	P.J.P	P.J.P	ORIGINAL ISSUE	TITLE	Cable Schedule	
	B	09.04.99	A.J.H	A.J.H	D.R.R	D.R.R	GENERAL UPDATE			
	C	02.07.99	A.J.H	A.J.H	D.R.R	D.R.R	740994 ADDED			
	D	24.12.10	D.B.F	D.B.F	MM	MM	SI760 Update			
	E	22.04.11	D.B.F	D.B.F	MM	MM	As Built			
									SHEET 2 OF 4	
								CLIENT DRG No	REF NO. SI039100_SCH	





# INSTRUMENT/ELECTRICAL CABLE SCHEDULE

CABLE		CONDUCTORS		CABLE ROUTE				APPROX. LENGTH METRES	REMARKS
REFERENCE	TYPE	AREA mm <sup>2</sup>	No.	FROM	GLAND TYPE	TO	GLAND TYPE		
<b>P2-25</b>									
M20132	J04	70	4 Core	No.2 Switchroom MCC Compartment 2BE	ATEX II 2 G EExed	P2-25 - Bund R Rail Loading Pump	ATEX II 2 G EExed	100	Cable Extended
M20132/1	J04	70	4 Core	No.2 Switchroom MCC Compartment 2BE	ATEX II 2 G EExed	P2-25 - Bund R Rail Loading Pump	ATEX II 2 G EExed	160	Extension
C20133	J04	N/A	4 Core	No.2 Switchroom MCC Compartment 2BE	ATEX II 2 G EExed	P2-25 Local Controls	ATEX II 2 G EExed	100	Remove
C20134	J02	N/A	2 Core	P2-25 Local Controls	ATEX II 2 G EExed	TS2-25 Discharge Temperature Switch	ATEX II 2 G EExed	5	Remove
C20800	J12	1.5	12 Core	No.2 Switchroom MCC Compartment 2BE	ATEX II 2 G EExed	JB2/111 - P2-25 Junction Box	ATEX II 2 G EExed	100	
C20801	J07	1.5	7 Core	JB2/111 - P2-25 Junction Box	ATEX II 2 G EExed	JB2/112 - P2-25 Local Junction Box	ATEX II 2 G EExed	5	
C20802	J05	1.5	5 Core	JB2/112 - P2-25 Local Junction Box	ATEX II 2 G EExed	P2-25 Stop/Start Station	ATEX II 2 G EExed	5	
C20803	J05	1.5	5 Core	JB2/112 - P2-25 Local Junction Box	ATEX II 2 G EExed	LS2-25 Dry Run Protection Switch	ATEX II 2 G EExed	5	
C20804	J03	1.5	3 Core	JB2/112 - P2-25 Local Junction Box	ATEX II 2 G EExed	TS2-25 Discharge Temperature Switch	ATEX II 2 G EExed	5	
C20805	J07	1.5	7 Core	JB2/111 - P2-25 Junction Box	ATEX II 2 G EExed	P2-25 Stop/Start/Run Station 3 at 4 East Rail Gantry	ATEX II 2 G EExed	Reuse C40279	Station 3 @ Far End
C20806	J07	1.5	7 Core	P2-25 Stop/Start/Run Station 3 at 4 East Rail Gantry	ATEX II 2 G EExed	P2-25 Stop/Start/Run Station 2 at 4 East Rail Gantry	ATEX II 2 G EExed	40	Station 2 @ Centre
C20807	J07	1.5	7 Core	P2-25 Stop/Start/Run Station 2 at 4 East Rail Gantry	ATEX II 2 G EExed	P2-25 Stop/Start/Run Station 1 at 4 East Rail Gantry	ATEX II 2 G EExed	40	Station 1 @ Control End
C20808	J02	1.5	2 Core	P2-25 Stop/Start/Run Station 1 at 4 East rail Gantry	ATEX II 2 G EExed	4 East Switch Room Rail Loading Logic Panel	ATEX II 2 G EExed	TBC	Re-use C40279 7c Option
<b>P5-12</b>									
C50485	J07	1.5	7 Core	No.5 Switchroom MCC 5/2 Compartment A1	ATEX II 2 G EExed	P5-12 Stop/Start/Run Station 1 at 4 East Rail Gantry	ATEX II 2 G EExed	TBC	Station 1 @ Control End
C50486	J07	1.5	7 Core	P5-12 Stop/Start/Run Station 1 at 4 East Rail Gantry	ATEX II 2 G EExed	P5-12 Stop/Start/Run Station 2 at 4 East Rail Gantry	ATEX II 2 G EExed	40	Station 2 @ Centre
C50487	J07	1.5	7 Core	P5-12 Stop/Start/Run Station 2 at 4 East Rail Gantry	ATEX II 2 G EExed	P5-12 Stop/Start/Run Station 3 at 4 East Rail Gantry	ATEX II 2 G EExed	40	Station 3 @ Far End
C50488	J02	1.5	2 Core	P5-12 Stop/Start/Run Station 3 at 4 East Rail Gantry	ATEX II 2 G EExed	4 East Switch Room Rail Loading Logic Panel	ATEX II 2 G EExed	TBC	Re-use X40356 1 Pr Option
<b>4 EAST RAIL GANTRY</b>									
C40820	J03	1.5	3 Core	JB 4-86 DC Junction Box	ATEX II 2 G EExed	ESD @ Gantry Top Control End	ATEX II 2 G EExed	TBC	
C40821	J03	1.5	3 Core	JB 4-86 DC Junction Box	ATEX II 2 G EExed	ESD @ Gantry Top Centre	ATEX II 2 G EExed	TBC	
C40822	J03	1.5	3 Core	JB 4-86 DC Junction Box	ATEX II 2 G EExed	ESD @ Gantry Top Far End	ATEX II 2 G EExed	TBC	
C40823	J03	1.5	3 Core	No.4 Switchroom Rail Loading Control Panel	ATEX II 2 G EExed	ESD Valve Solenoid	ATEX II 2 G EExed	TBC	
<b>4 EAST SWITCHROOM</b>									
C40824	J02	1.5	2 Core	No.4 Switchroom Rail Loading Control Panel	ATEX II 2 G EExed	No.4 Switchroom Extension Annunciator Node Panel	ATEX II 2 G EExed	30	
C40825	J02	1.5	2 Core	No.4 Switchroom Rail Loading Control Panel	ATEX II 2 G EExed	No.4 Switchroom Dupline Panel	ATEX II 2 G EExed	20	
TOTAL								695	

**NOTES:**  
1) Refer to P&I Design Cable Specifications for details on Cable Type.

IF NOT SIGNED THIS DOCUMENT IS UNCONTROLLED

REV	DATE	BY	DRN	CHK'D	APP'D	DESCRIPTION	PLANT	TITLE
A	30/09/10	DBF	DBF	MM	MM	Issued for Tender	Immingham East - 4 East	4 East Rail Loading Cable Schedule

- Denotes Cable Modified
- Denotes Cable Deleted
- Denotes Cable Added
- Future Cables





# INSTRUMENT/ELECTRICAL CABLE SCHEDULE

CABLE		CONDUCTORS		CABLE ROUTE				APPROX. LENGTH METRES	REMARKS
REFERENCE	TYPE	AREA mm <sup>2</sup>	No.	FROM	GLAND TYPE	TO	GLAND TYPE		
C20809	J07	1.5	7 Core	No.2 Switchroom MCC Compartment B2F	ATEX II 2 G EExed	JB4_89 Tank Isolation Pushbutton Junction Box	ATEX II 2 G EExed	100	Note 2
C20810	J03	1.5	3 Core	JB4_89 Tank Isolation Pushbutton Junction Box	ATEX II 2 G EExed	Tank 601 Rail Loading Valve - XSV60103 Soleniod	ATEX II 2 G EExed	220	
C20811	J03	1.5	3 Core	JB4_89 Tank Isolation Pushbutton Junction Box	ATEX II 2 G EExed	Tank 602 Rail Loading Valve - XSV60203 Soleniod	ATEX II 2 G EExed	190	
C20812	J03	1.5	3 Core	JB4_89 Tank Isolation Pushbutton Junction Box	ATEX II 2 G EExed	Tank 603 Rail Loading Valve - XSV60303 Soleniod	ATEX II 2 G EExed	160	
<b>TOTAL</b>								670	

**NOTES:**  
 1) Refer to P&I Design Cable Specifications for details on Cable Type. 2) Cables to be relocated to ROSOV Control Panel in future, allow spare length.

- Denotes Cable Modified
- Denotes Cable Deleted
- Denotes Cable Added
- Future Cables

IF NOT SIGNED THIS DOCUMENT IS UNCONTROLLED								PLANT	Immingham East - 2 East
REV	DATE	BY	DRN	CHK'D	APP'D	DESCRIPTION	TITLE	600 Series ROSOVs Cable Schedule	
A	30/11/10	DBF	DBF	MM	MM	Issued for Construction			
									
							CLIENT DRG No	SHEET 1 OF 1	
								REF No. SI760002_SCH	

ALARM/TRIP INITIATOR	TAG	TYPE	CALIBRATION	UNITS	SET	ORIGIN	ACTION	VALVES	RAIL LOADING PUMPS	SUMP PUMPS	OPERATIONS OFFICE ANNUNCIATOR	RADIO BROADCAST	NOTES	
<b>ESD RELAY R82</b>														Gantry Control Panel Reset Required
Site Fire Alarm System	FIRE							H H H H H H H H H H H H H H					* Not Part of R82, Via No.5 Switchroom	
4 East ESD	4E ESD							H H H H H H H H H H H H H H						
4 East Rail Gantry ESD	4ER ESD							H H H H H H H H H H H H H H						
High Level Multiplexer Fault	Mux 1,2,3 & 4							H H H H H H H H H H H H H H						
<b>ESD</b>														
2 East ESD	2E ESD													
<b>HIGH LEVEL RELAY R44</b>														Gantry Control Panel Reset Required
Rail Car 1 - North Siding	LS1	Float	Switch					H H H H H H H H H H H H H H						
Rail Car 2 - North Siding	LS2	Float	Switch					H H H H H H H H H H H H H H						
Rail Car 3 - North Siding	LS3	Float	Switch					H H H H H H H H H H H H H H						
Rail Car 4 - North Siding	LS4	Float	Switch					H H H H H H H H H H H H H H						
Rail Car 5 - North Siding	LS5	Float	Switch					H H H H H H H H H H H H H H						
Rail Car 6 - North Siding	LS6	Float	Switch					H H H H H H H H H H H H H H						
Rail Car 7 - SouthSiding	LS7	Float	Switch					H H H H H H H H H H H H H H						
Rail Car 8 - SouthSiding	LS8	Float	Switch					H H H H H H H H H H H H H H						
Rail Car 9 - SouthSiding	LS9	Float	Switch					H H H H H H H H H H H H H H						
Rail Car 10 - SouthSiding	LS10	Float	Switch					H H H H H H H H H H H H H H						
Rail Car 11 - SouthSiding	LS11	Float	Switch					H H H H H H H H H H H H H H						
Rail Car 12 - SouthSiding	LS12	Float	Switch					H H H H H H H H H H H H H H						
<b>P2-25 PUMP CONTROLS</b>														
Low Suction Level	LS2-25	Vib'	Switch											
High Discharge Temperature	TS2-25	Filled	Switch	DegC	40									
Local Stop			Pushbutton											
4 East Rail Gantry Stop			Pushbutton											
<b>P5-12 PUMP CONTROLS</b>														
Low Suction Level	LS5-12	Vib'	Switch											
High Discharge Temperature	TS5-12	Filled	Switch	DegC	40									
Local Stop			Pushbutton											
4 East Rail Gantry Stop			Pushbutton											
MCC Stop			Pushbutton											
<b>P5-13 PUMP CONTROLS</b>														
Low Sump Level	LS5-13	Float	Switch											
High Discharge Temperature	TS5-13	Filled	Switch	DegC	40									
Local Stop			Pushbutton											
MCC Stop			Pushbutton											
Pump Thermister	TH5-13	TH		DegC	TBC									
<b>SERVICES</b>														
Air Failure								H H H H H H H H H H H H H H						
Power Failure								H H H H H H H H H H H H H H						

ABBREVIATIONS	NOTES	REFERENCE DRAWINGS	REV	DATE	BY	DRN	CHK'D	APPD	DESCRIPTION	PLANT	TITLE
ESD - Emergency Shutdown			A	08.09.10	DBF	DBF	MM MM	MM MM	Original Issue For Comments	Simon Immingham Storage Co East Terminal	4 East Rail Loading Trip Matrix
			B	24.12.10	DBF	DBF	MM	MM	As Built -Temperatures Changed to 40 DegC		
H - Hardwired											
S - Software											





# *P & I Design Ltd*

Process Instrumentation Consultancy & Design

2 Reed Street, Gladstone Industrial Estate,  
Thornaby, TS17 7AF, United Kingdom.  
Tel. +44 (0)1642 617444 Fax. +44 (0)1642 616447  
Web Site: www.pidesign.co.uk

## **SIMON STORAGE**

### **ISCo EAST TERMINAL**

#### **4 EAST RAIL LOADING MODIFICATIONS**

#### **INSTALLATION SPECIFICATION**

<b>Rev</b>	<b>Date</b>	<b>By</b>	<b>Checked</b>	<b>Approved</b>	<b>Description</b>	<b>Client Ref.</b>
A	30.09.10	D.B.Faulkner	MM	MM	Issued for Tender	
						Document No. SI760001_INS
						<b>Page 1 of 14</b>

*IF NOT SIGNED THIS DOCUMENT IS UNCONTROLLED*

## CONTENTS

- 1 INTRODUCTION
- 2 GENERAL REQUIREMENTS
- 3 METHODS OF WORK AND MATERIALS
- 4 SCOPE OF WORK
  - 4.1 Contractor supplied equipment
  - 4.2 Free issue equipment
- 5 CONTRACT PRICING CONTENTS
  - 5.1 Introduction Contractor Supplied Equipment
  - 5.2 Pricing Preambles/Notes on Pricing
  - 5.3 Schedule of Rates
  - 5.4 Programme
- 6 TENDER PRICING SUMMARY

## APPENDIX

- I Drawings
- II Schedules
- III Cable Specifications
- IV Standard Specification for Instrument & Electrical Installations

### Revision History

Revision A – Issue for tender.



## **1 INSTRUCTIONS TO TENDERERS**

### **1.1 Introduction**

This document details the scope of work to provide the cabling and containment installation for 4 east Rail Loading modifications at ISCo East Terminal. It is to be read in conjunction with specification SI003001\_INS - Standard Specification for Instrument & Electrical Installations.

The Tender shall be in respect of the proposed works and shall be completed and submitted strictly in accordance with these instructions to tenderers.

### **1.2 Date, Time and Mode of Delivery**

The completed tender packages together with any covering letter and with the remainder of the containing document all in originally bound form (taking account of additions/omissions, etc., notified in writing during the tender period) together with other requirements, shall be submitted by the time stated in the purchaser's letter of invitation to tender.

The envelope must not be marked nor delivered in any way which might disclose the identity of the tenderer.

### **1.3 Alterations of Tender Documents**

No authorised alteration shall be made in the Tender or the accompanying documents.

### **1.4 Enquiries to be Made Concerning the Tender**

Any query in connection with the tender shall be submitted to:-

Mr D.B.Faulkner  
P & I Design Limited  
2 Reed Street  
Gladstone Industrial Estate  
Thornaby.  
Tel: (01642) 617444  
Fax: (01642) 616447  
[df@pidesign.co.uk](mailto:df@pidesign.co.uk)

A site visit is required to ensure that the work associated with this project is fully understood. The site visit is to be organised by contacting D.B.Faulkner at P & I Design Ltd.



## **1.5 Sufficiency of Tender**

Before submitting a tender the tenderer should obtain all information, familiarise himself with means of access, location, extent and nature of the site, extent and nature of the services to be provided, conditions under which the services and works will be carried out, conditions affecting supply of staff and labour and any other matters which may affect his tender. applications for costs etc. on the ground of lack of knowledge in any respect of the aforementioned will be refused.

## **1.6 Confidentiality**

The particulars of this document and any tender submitted in respect hereof are private and confidential and shall not be used for any purpose other than the proposed contract. In the event of a tender not being submitted or accepted all documents and drawings shall be returned to the person named in Clause 4 of these instructions to tenderers.

## **1.7 Contravention of Tender Requirements**

Contravention of any of the requirements of these instructions to tenderers with regard to tendering shall render any tender concerned liable to disqualification at the sole discretion of Simon Storage Ltd.

## **1.8 Contract Agreement**

The contractor shall, when called upon, enter into and execute a contract agreement.

## **1.9 Information to be Supplied by the Purchaser**

In addition to the information to be provided by the purchaser prior to the contract award the tenderer shall attach a schedule of any further information which may be required from the purchaser, together with a programme indicating when it will be required.

## **1.10 Tender Price**

The contractor shall make his tender open for acceptance for a period of one month from date of receipt by the Purchaser.



## 2 GENERAL REQUIREMENTS

Detailed in document SI003001\_INS - Standard Specification for Instrument & Electrical Installation Section 2 with the following additional information -

### Section 2.2 – Requirement

A “For Construction” drawing package will be issued prior to contract. Modifications from the “For Tender” package will be highlighted.

The contractor is to supply details of labour usage to complete the installation within the programme. The contractor shall also supply day rate costs.

Normal site working hours 8.00am to 6.00pm Monday to Friday.

### Section 2.4 - Installation

All scaffolding requirements will be included within the contractor’s Scope of Work.



### 3 METHODS OF WORK AND MATERIALS

Detailed in document SI003001.INS - Standard Specification for Instrument & Electrical Installation Section 3 with the following additional information -

#### Section 3.5 – Segregation of Service

The schedules will indicate cables exceeding 110V AC.

#### Section 3.6 – Fixings

No fixings shall be made to the bund walls.

#### Section 3.8.3 – Equipment Earthing

Main earth bars within switchrooms.

#### Section 3.11.1 – Testing

No commissioning will commence until handover of cable test certificates and CompEx inspections by the contractor. The contractor will be responsible for providing installation handover to the engineer in good time to progress the commissioning programme.

#### Section 3.11.2 – Commissioning

The contractor will not be required to carry out commissioning. The contractor will not power any equipment without the consent of the engineer.

#### Pneumatics

The contractor shall supply all labour and materials to install or modify the pneumatic supplies to all actuated valves utilising 6mm OD black PVC tubing and push in fittings. Each tube shall be identified with durable, non-corrodible tags, of the Critchley K type or equivalent, inscribed with the valve tag number and fixed securely to the tube.

A distribution Manifold will be installed by the mechanical contractor within 10 metres of the valve. The contractor shall use this length for his costing for every valve.



## 4 SCOPE OF WORK

As part of the 4 East Rail Loading project P2-25 will be re-located from No.2 East loading yard to Bund R pump raft, P2-25 and P5-12 pump control systems will be modified. All inline batching equipment and associated electrical equipment will be removed to allow for line pigging.

The scope of work is as detailed in the following sections and as shown on the documentation listed below.

	Existing	Modified/New
Cable Schedules		SI760001_SCH_A
Cable Overview Drawing	SI039001_DWG_C	SI039001_DWG_D
Logic Drawings	SI039002_DWG_C	SI039002_DWG_D
	SI039003_DWG_B	SI039003_DWG_C
	SI039004_DWG_B	SI039004_DWG_C
	SI039005_DWG_B	SI039005_DWG_C
	SI039006_DWG_B	SI039006_DWG_C
	SI039007_DWG_B	SI039007_DWG_C
	SI039008_DWG_B	SI039008_DWG_C
Loop Sheets	SI039010_DWG_C	SI039010_DWG_D
	SI039011_DWG_C	SI039011_DWG_D
	SI039012_DWG_C	SI039012_DWG_D
	SI039013_DWG_C	SI039013_DWG_D
	SI039014_DWG_B	SI039014_DWG_C
		SI760001_DWG_A
		SI760002_DWG_A
Panel Layout Drawing	SI039016_DWG_C	SI039016_DWG_D

The contractor shall make provision for the following works –

### General

Relabeling of all equipment as required, removal of all FINA references.

Detailed CompEx inspections to be carried out to all existing equipment modified under this scope.

### P2-25

Isolate and de-gland motor cable M20132 to allow relocation of pump by others. M20132 to be extended to new location via M20132/1.

Isolate, de-gland and remove control cables C20133 & C20134.

Modifications to P2-25 controls to include supply/installation of 240 Vac to 24Vdc/5A PSU. Remove of P2-25 jetty controls from the dupline system. Relabeling as required.



## No.4 Switchroom

Re-programming of dupline system to provide a Site Fire Alarm output and wire to 4 pole relay within No.4 Switchroom dupline panel.

Modifications to 4 East Rail Loading panel as detailed on logic drawings.

## Gantry

Replacement of 12 off free issue Exd Solenoids – 12 off original units to be removed, contractor to allow for re-glanding and testing.

Supply and install local pneumatic Open/Close control stations on rail loading valves and ESD valve.

Relocation of telephone extension No.310 from loading yard adjacent to tanks 560/599 to control end of gantry.

Removal of cables –

740927, 740928, 740929, 740930, 740934, 740935, 740936, 740937, 740944, 740945, 740946, 740947, 740950, 740951, 740990, 740991, 740992 & 740993

Removal of associated north & south siding field equipment –

2 off Danloads

4 off preamps

2 off Mercury units (cable to be installed into a contractor supplied JB)

Isolate and de-gland associated north & south siding field equipment for removal by others

4 off pickup coils,

2 off RTD's

2 off downstream DCV's

2 off upstream DCV's

All removed equipment to be retained.

Modifications to remove/blank or re-label Operator Control Panel Lamps

Three contractor supplied boards are to be mounted on the gantry top, each board will have a P2-25 stop/start/run a P5-12 stop/start/run and an 4 East Rail ESD pushbutton, the boards will be located at the control panel end, the centre and the far end of the gantry. The boards need to be of sufficient size to allow for A3 sized operating instructions to be attached.





## 4.1 Contractor Supplied Equipment

The contractor shall supply and install the following equipment. All equipment shall be suitably rated for the environment in which it is to be installed (site hazardous area drawing available on request). Where not fully specified, equipment shall conform with normal site standards for similar installations.

### 4 East Rail Loading Valves

- 12 off Pneumatic Open/Close Stations

### 4 East Rail Loading ESD Valve

- 1 off Pneumatic Open/Close Stations

### P2-25 Delivery Pump Exde Installation

- 1 off Pump local momentary start/momentary stop station.
- 1 off JB2-111
- 1 off JB2-112
- 3 off Pump momentary start/momentary stop/run stations - Red 24Vdc Lamp

### P5-12 Delivery Pump Exde Installation

- 3 off Pump momentary start/momentary stop/run stations - Red 24Vdc Lamp

### 4 East Rail ESD

- 3 off Stay Put Stop ESD Pushbuttons

### General

- 3 off Boards for control stations on gantry top
- 2 off JB's to replace Mercury terminals

## 4.2 Free Issue Equipment

The contractor shall supply labour and materials to take delivery, offload and position the following free issue equipment. Equipment requiring a direct connection into the process lines will be mechanically completed by others.

### P2-25 Delivery Pump Exd Local Controls

- 1 off Exd discharge temperature switch - Original unit to be reused, contractor to allow for de-glanding removal of cable.
- 1 off Exd dry run protection switch.

### Gantry Instrumentation

- 13 off Exd solenoids (12 off replacements, 1 new)



## **5 CONTRACT PRICING CONTENTS**

### **5.1 Introduction**

The Tenderer must complete the Schedules attached in Sections 5.3.4 & 6 completing the lists of categories of unit rates for variations. The Tenderer must not re-type or make any other alterations to the wording.

Engineer authorised variations in respect of the provision of the aforementioned services to be paid in accordance with Section 5.3.4.

Payment under hourly/day rates for variations to Contract will only be made to the Contractor for Personnel approved by the Purchaser and will only be made in respect of all approved hours worked, or pro-rata to the nearest half hour, half day or whole day respectively.

### **5.2 Pricing Preambles/Notes on Pricing**

#### **5.2.1 General**

These Pricing Preambles relate to Rates, Sums and Amounts entered in Schedules which form part of the Contract.

In arriving at said Rates, Sums and Amounts, the Contractor will be deemed to have taken account of the Conditions of Contract, the Specification/Scope of Work, the Particular Specification, these Pricing Preambles and any other matters which affects said Rates, Sums and Amounts.

Rates, Sums and Amounts, except where otherwise provided in the Contract shall be fixed for the duration of the Contract.

Completion of Lump Sums, Normal Time Rates.

- 5.2.1.1** A Rate, Sum or Amount shall be entered by the Contractor against each reference or item and reference or items against which no Rate, Sum or Amount is entered shall be deemed to be covered by other Rates, Sums or Amounts entered elsewhere in the Schedules.
- 5.2.1.2** The Contractor shall omit from his Tender any Value Added Tax chargeable or any taxable supplies made under Contract to the Purchaser and payable by him as a taxable person to the Commissioners of Customs and Excise.
- 5.2.1.3** The Contractor shall allow for compliance in all respects with the applicable British Standard, Codes of Practice and any other Standards or Codes specified. The Contractor shall be fully responsible for obtaining such documents and familiarising himself with same.
- 5.2.1.4** The Contractor shall allow for compliance with all statutory safety regulations, including those of the Purchaser, and executing the Services in such an order or sequence as may be required to accord with the overall Project programme requirements.



## **5.3 Schedule of Rates**

### **5.3.1 General**

#### **5.3.1.1 Schedule of Rates**

A schedule of rates is to accompany the tender.

#### **5.3.1.2 Man-hours**

The Man-hour Rates which the Contractor inserts in the Schedule shall be deemed to include, but not necessarily be restricted to all allowances required for the following:

All cost associated with the employment of labour including the requirements of Government enactment's (V.A.T. excepted) and/or other suitable National Working Rule Agreement.

Supervision by non-working trade supervisors, other than those allowed separately by the Contractor in the General Preliminaries section of the Tender.

All man-hours and costs associated with collecting "Free Issue" materials from the Purchaser's stores or compounds and transporting to the Contractor's store or workshop, including all loading, unloading, stacking and storage. Also any costs associated with off-loading, stacking and storage of materials supplied by the Contractor. Compilation of stores record system and final reconciliation for all "Free Issue" materials. Generally this store will be located on the site.

Loading and transporting from the Contractor's store or compound and assembling and installing in the final position.

The installation of all work and operations required by the Specifications and Works Rules and Regulations.

The carrying out of any tests including submission of samples where required. Any necessary site measurement and sketching for fabrication and erection purposes.

Marking up construction drawings to record the "As Built" installation.

All necessary allowances for small hand tools and consumables which are not included as Constructional Plant in the General Preliminaries section of the Tender.

Protecting the works during construction period from damage and for making good /reinstating damage caused.

All required allowances for overhead and profit.



### 5.3.2 Materials

The material prices which the Contractor inserts in the Schedule of Rates shall be deemed to include the following:-

All costs associated with delivery to the Contractor's site stores or compound.

Any demurrage charges or costs associated with returning packing cases, drums and the like for materials supplied by the Contractor.

All necessary allowances for waste.

All necessary allowances for consumables.

All necessary fixing devices.

### 5.3.3 Testing

The man-hour rates shall include for all testing.

### 5.3.4 Schedule of Day work Rates

Variations shall be valued on a lump sum basis. Such lump sums shall be derived from the Schedule of Rates below and the man-hour estimates for the variations which the Engineer has agreed in writing and all of which shall be subject to the issue of a Variation Order.

Position	40 Hour Rate	Time & 1/2 Rate	Double Time
Site Supervision			
Working Foreman			
CompEx Approved Technician			
Approved Electrician			
Electrician			
Labourer			

Percentage to be added to net cost of materials %

### Site Establishment

Cost inclusive of site management, office facilities, £  
messing, toilets and constructional equipment at a weekly rate.



## 5.4 Programme

### 5.4.1 Provisional Programme

The following information is supplied for the guidance of the Tenderer and is provisional only, based upon the information available at the time of issue of the Tender:

1. Site visit – TBA (if required)
2. Tender required by – ASAP
3. Earliest date on which work can commence – Immediate
4. No.5 Switchroom 415V MCC delivery to site – w/c 25/10/10
5. Latest date for completion, including all testing – 29/10/10

The tenderer shall include a provisional programme with the tender to include key milestones for delivery of equipment within their supply.



## 6. Tender Pricing Summary

This tender summary to be completed by the tenderer, applies to the Scope of Work for the Arcton area stripping pump and sump pump project for ISCo East terminal.

- |    |  |   |
|----|--|---|
| 1. | Supply and installation of containment | £ |
| 2. | Supply and Installation of cabling     | £ |
| 3. | Supply and installation of earthing    | £ |
| 4. | Testing and Documentation              | £ |
| 5. | Miscellaneous (Please State)           |   |

**Sub Total** £

**Site Establishment Total** (based on ..... weeks) £  
(See Section 5.3.4)

**Total Tender Price** £



## Appendix I

### Drawings

Cable Overview Drawing

SI039001\_DWG\_C & D

Logic Drawings

SI039002\_DWG\_C & D

SI039003\_DWG\_B & C

SI039004\_DWG\_B & C

SI039005\_DWG\_B & C

SI039006\_DWG\_B & C

SI039007\_DWG\_B & C

SI039008\_DWG\_B & C

Loop Sheets

SI039010\_DWG\_C & D

SI039011\_DWG\_C & D

SI039012\_DWG\_C & D

SI039013\_DWG\_C & D

SI039014\_DWG\_B & C


SI760001\_DWG\_A

SI760002\_DWG\_A

Panel Layout Drawing

SI039016\_DWG\_C & D



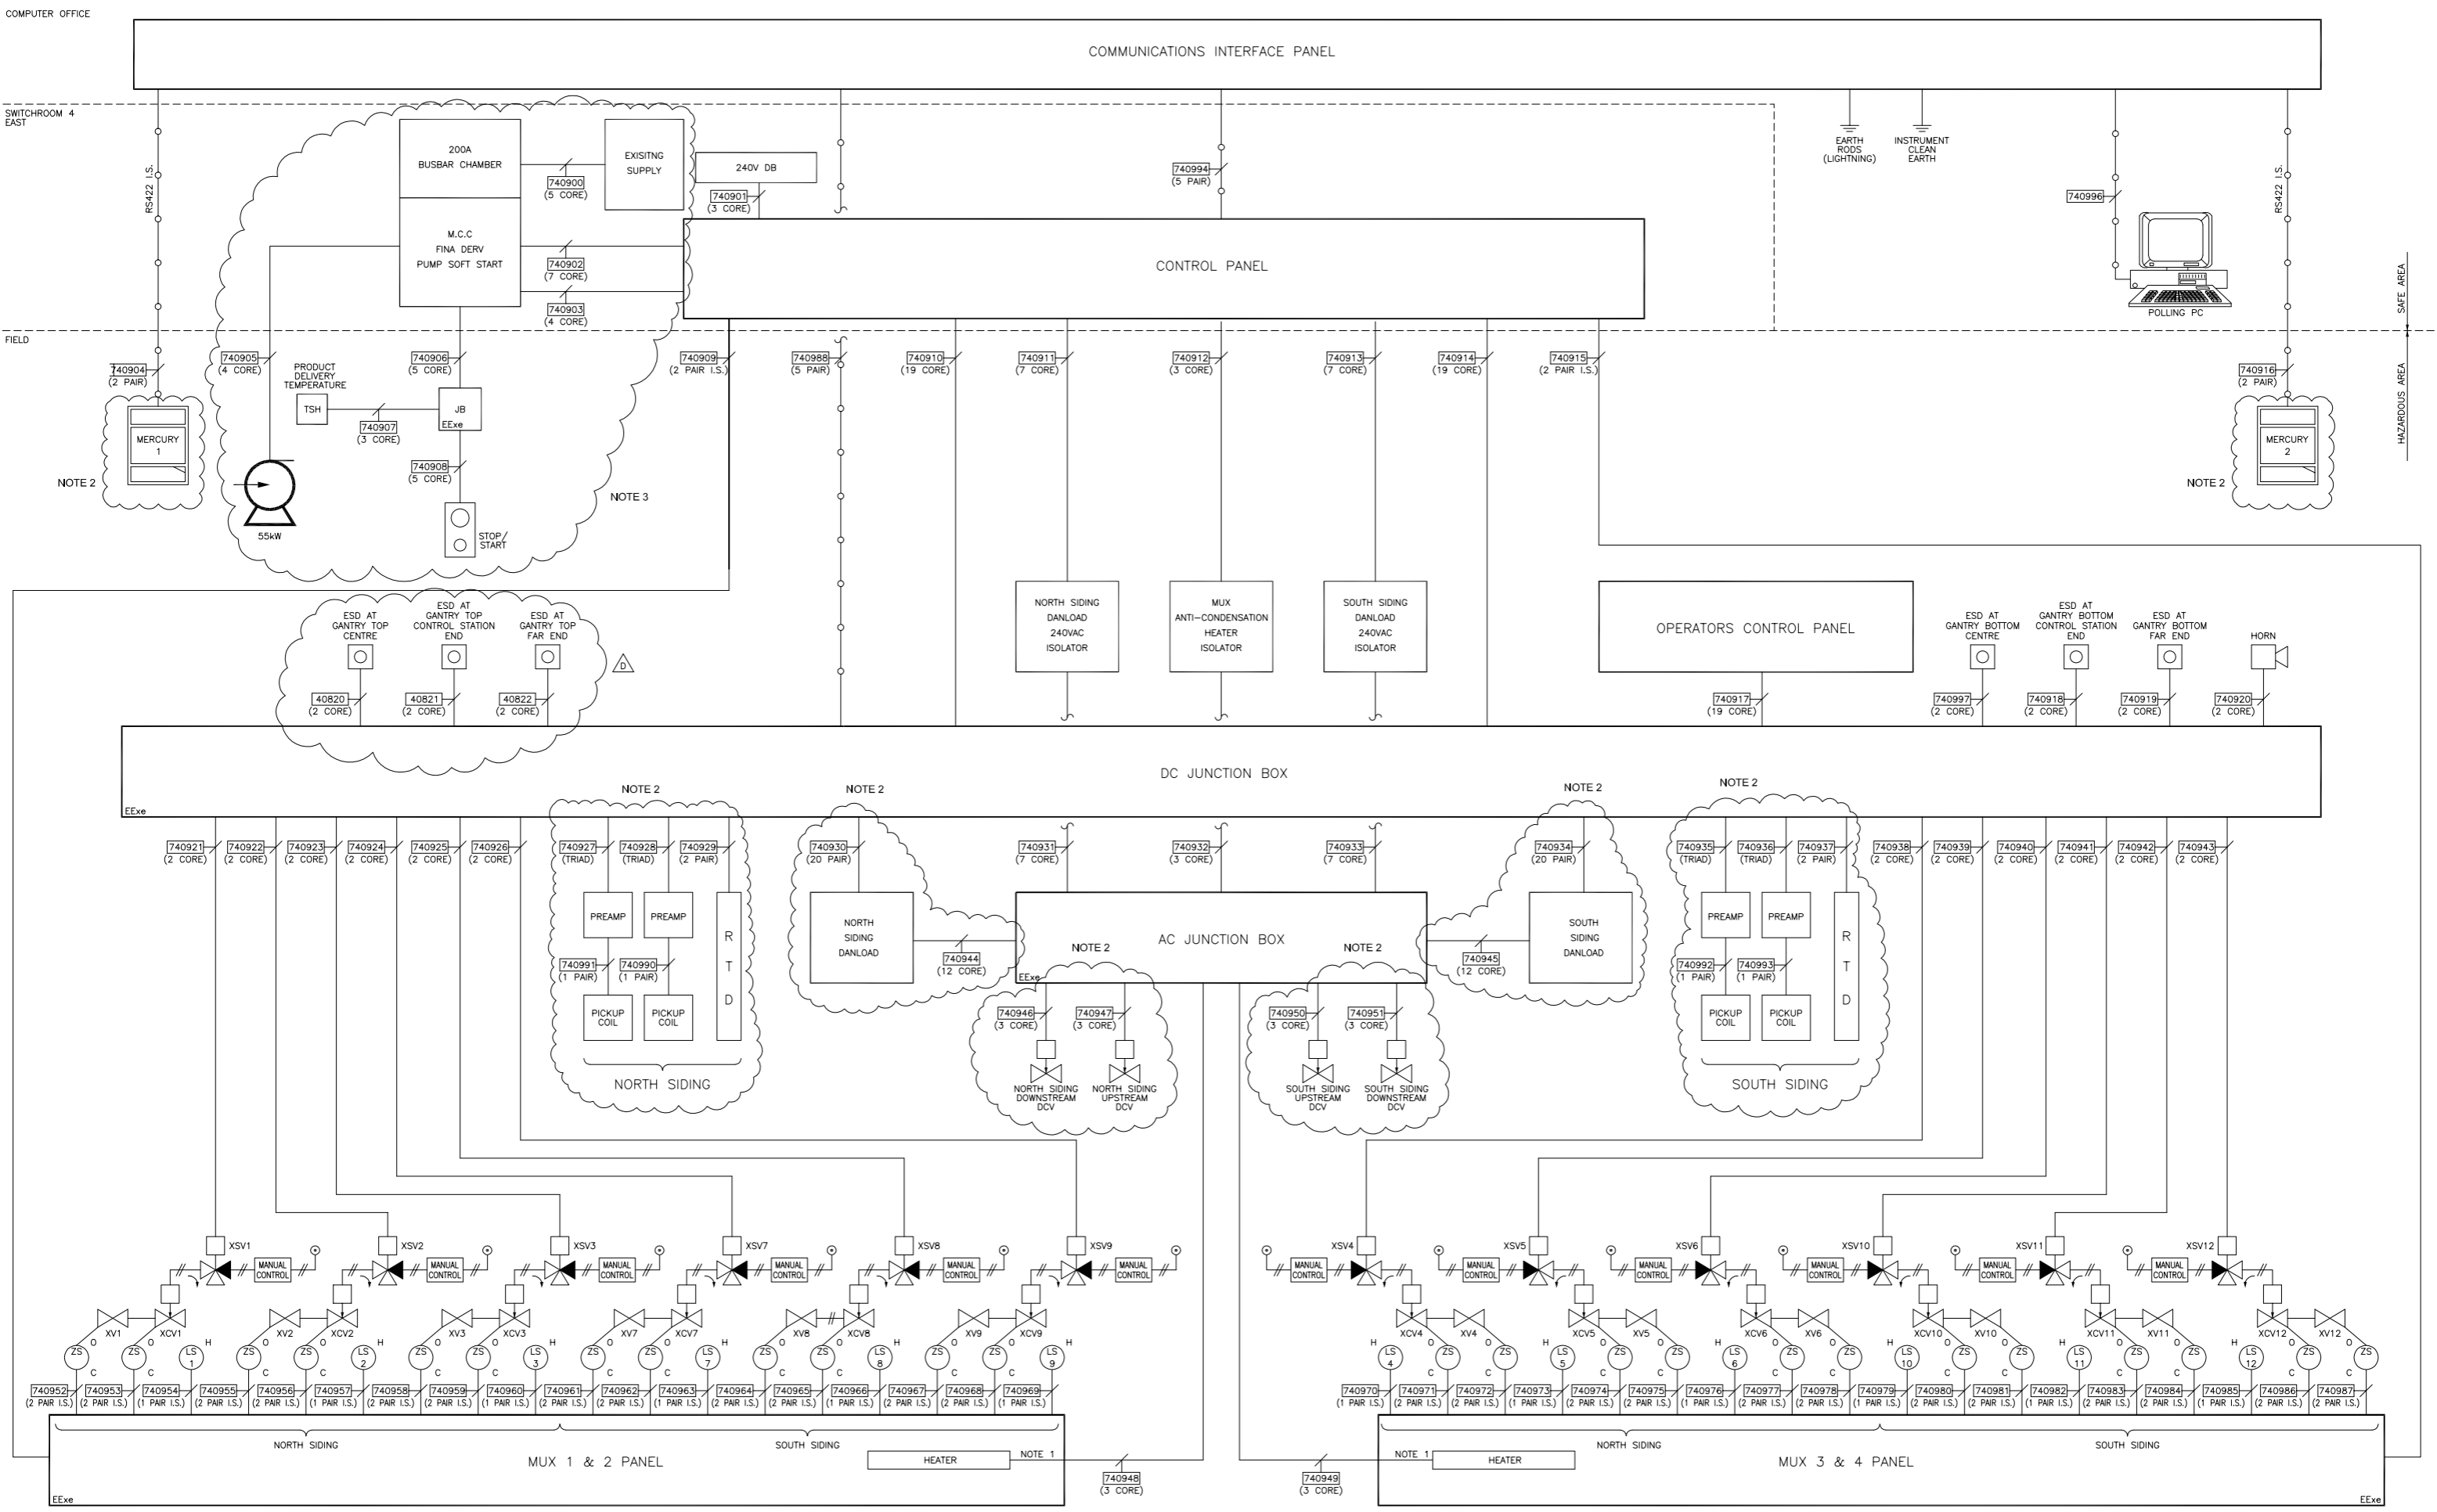

- NOTES**
- VIA SAK2.5 EEx'e' TERMINALS
  - EQUIPMENT HIGHLIGHTED TO BE REMOVED.
  - DECOMMISSIONED BATCHING SYSTEM.



IF NOT SIGNED THIS DOCUMENT IS UNCONTROLLED							PLANT	IMMINGHAM STORAGE Co. - EAST TERMINAL
REV	DATE	BY	DRN	CHK'D	APP'D	DESCRIPTION	TITLE	4-EAST RAIL LOADING SYSTEM OVERVIEW
A	18/02/99	D.R.R.	A.J.H.	P.J.P.	P.J.P.	D.R.R. D.R.R.	ORIGINAL ISSUE	
B	07/04/99	A.J.H.	A.J.H.	D.R.R.	D.R.R.	D.R.R. D.R.R.	GENERAL UPDATE	
C	02/07/99	D.P.	A.J.H.	D.R.R.	D.R.R.	D.R.R. D.R.R.	EARTH RODS UPDATED	
D	17/09/10	D.B.F.	P.P.	M.M.	M.M.		SI760 MODIFICATIONS	

CLIENT DRG. No.	P&I DRG No. SI039001_DWG
-----------------	--------------------------


IMMINGHAM STORAGE Co. Ltd.  
 IMMINGHAM EAST TERMINAL  
 IMMINGHAM DOCK,  
 IMMINGHAM,  
 SOUTH HUMBERSIDE

**simon**

**P & I DESIGN**  
 P & I Design Ltd  
 Tel. 01642 617444  
 www.pidesign.co.uk

SHEET 1 OF 1



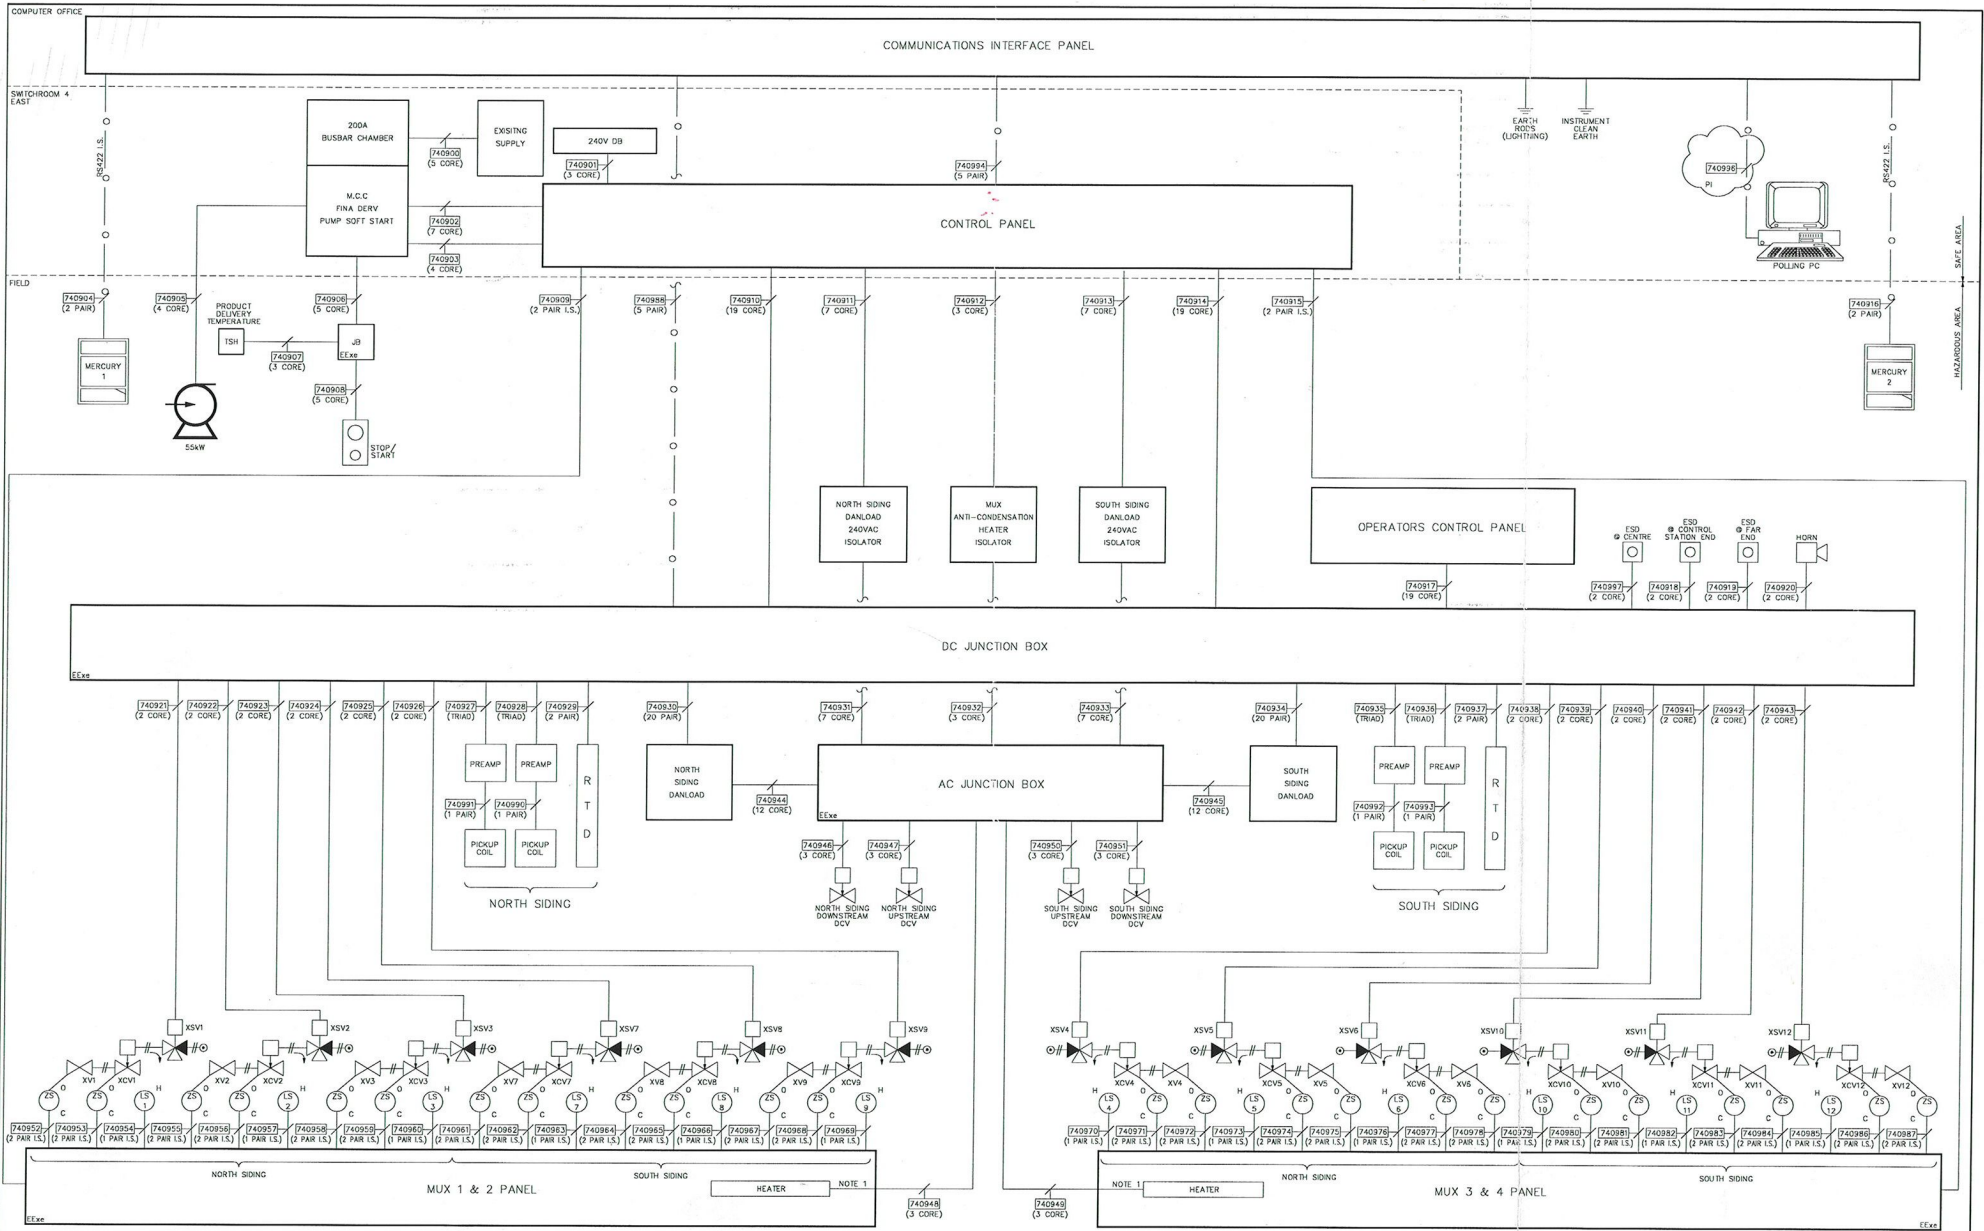


NOTES  
 1. VIA SAK2.5 EEx'a TERMINALS

REV	DATE	BY	DRN	CHK'D	APP'D	DESCRIPTION	PLANT	FNA DERV RAIL LOADING SYSTEM
A	18/02/99	D.R.R.	A.J.H.	P.J.P.	P.J.P.	D.R.R.	ORIGINAL ISSUE	
B	07/24/99	A.J.H.	A.J.H.	D.R.R.	D.R.R.	D.R.R.	GENERAL UPDATE	
C	02/07/99	D.P.	A.J.H.	D.R.R.	D.R.R.	D.R.R.	CARTING RODS UPDATED	02/07/99


  

	INWINDHAM STORAGE Co. Ltd. INWINDHAM EAST TERMINAL INWINDHAM DOCK, INWINDHAM, SOUTH HUMBERSIDE	
	SHEET 01 OF 01 P&I DRG No. SID59001	


LEGEND OF GRAPHICAL SYMBOLS (ALL CONTACTS SHOWN IN THE DE-ENERGISED STATE)

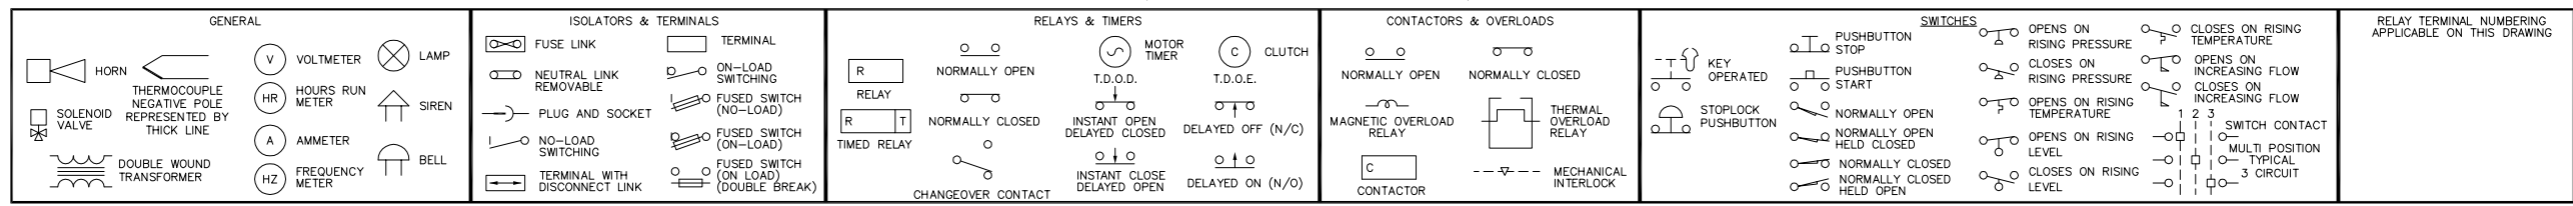




**POWER DISTRIBUTION**

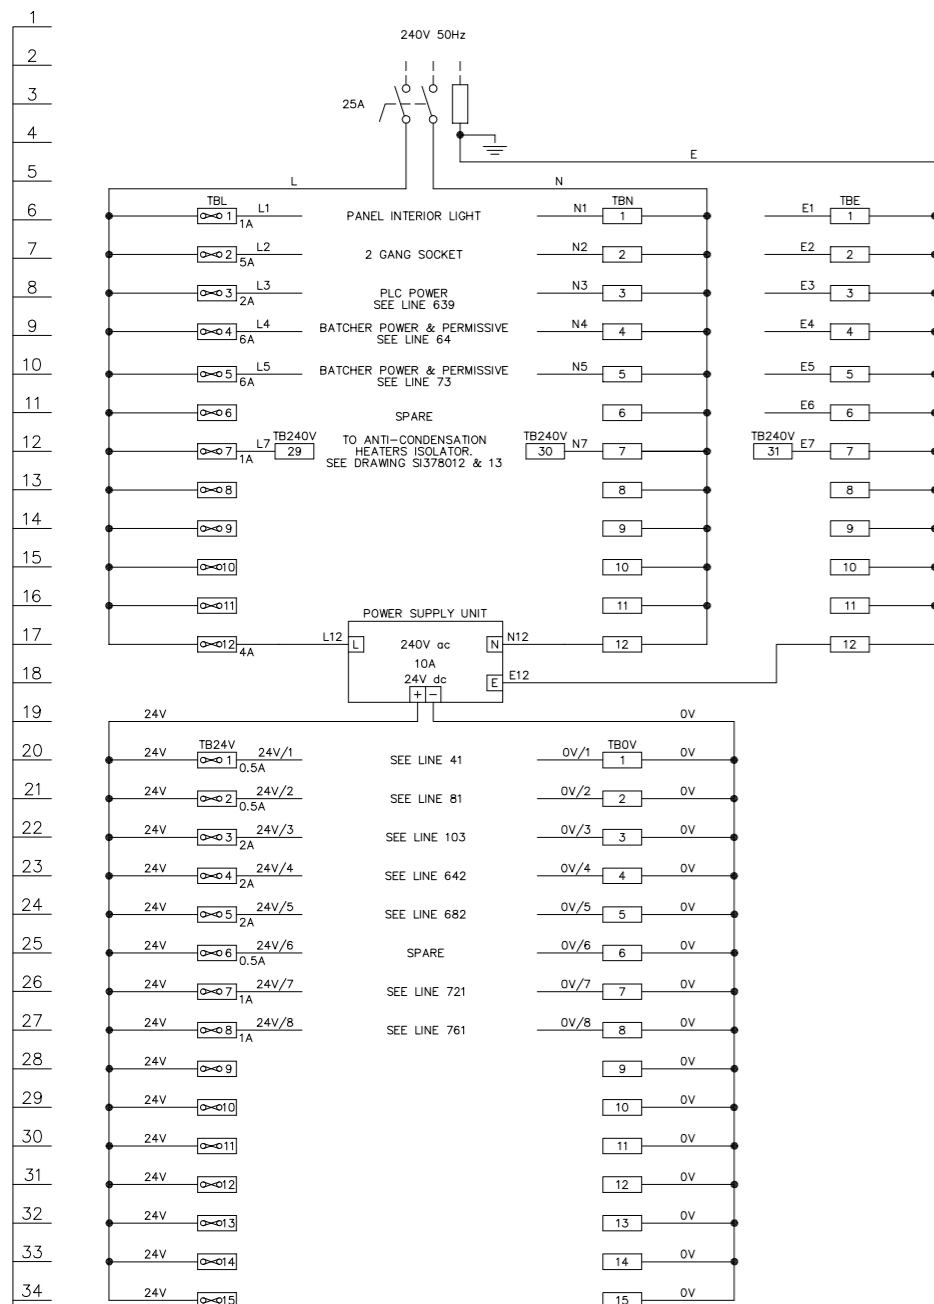

**LEVEL**

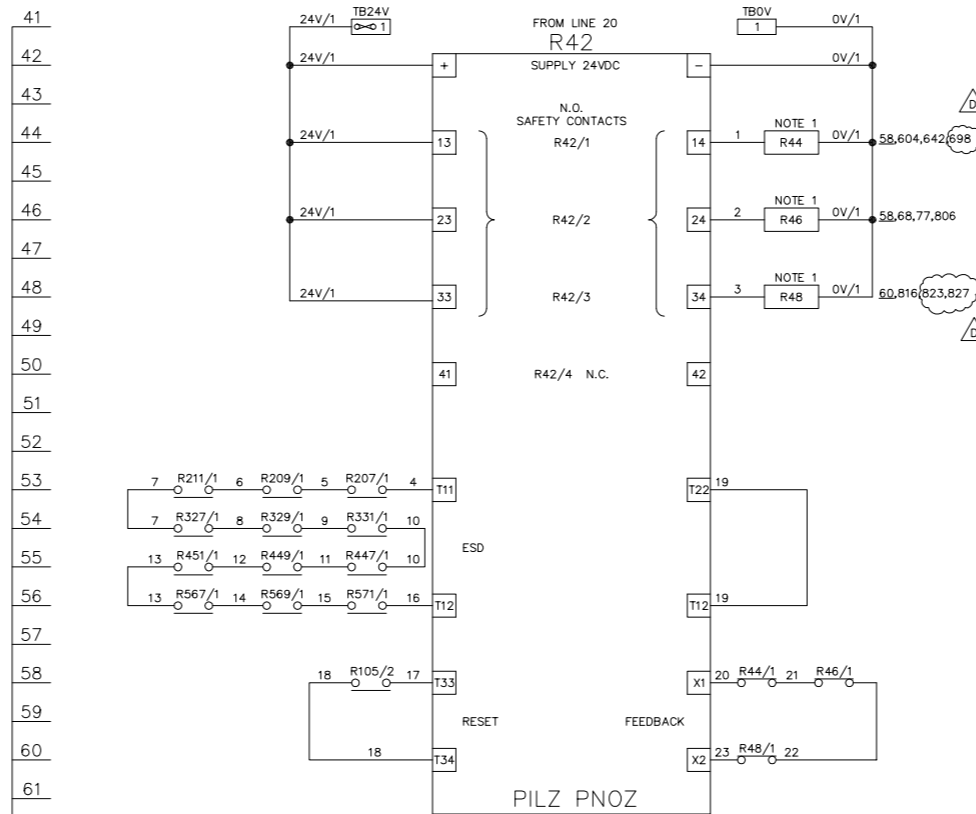

**ESD**

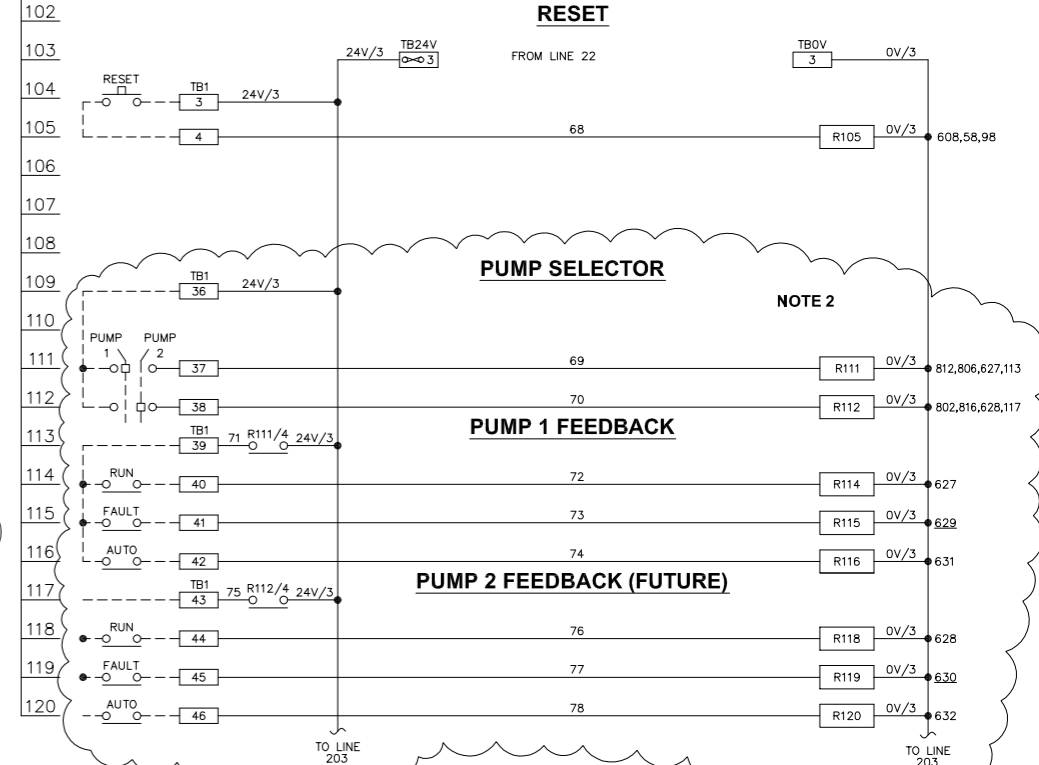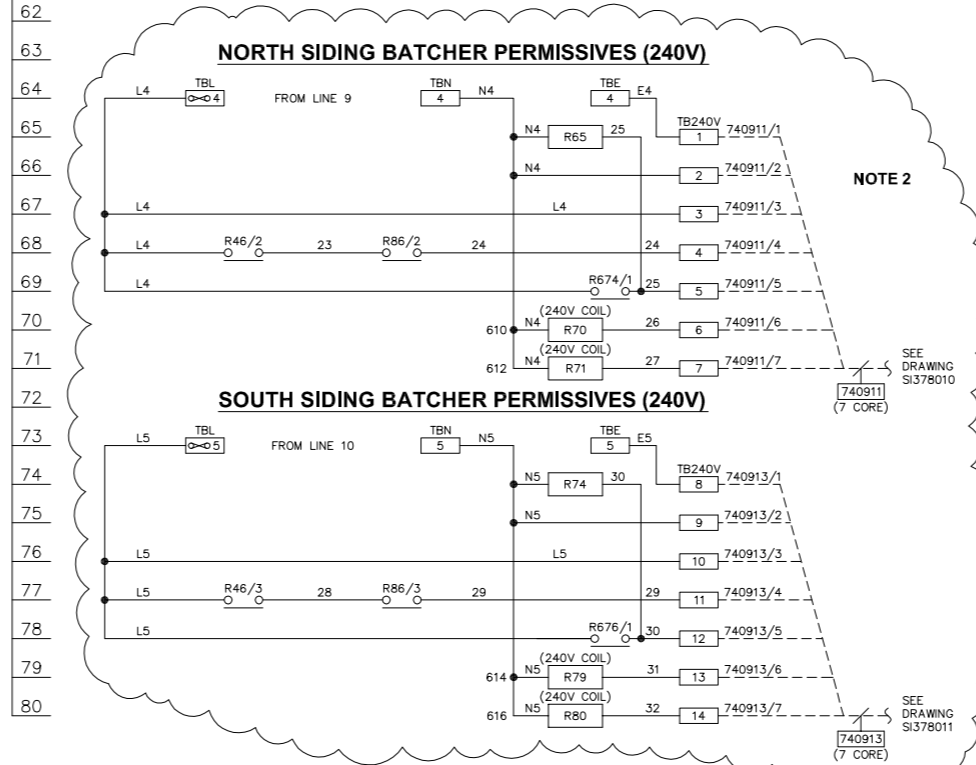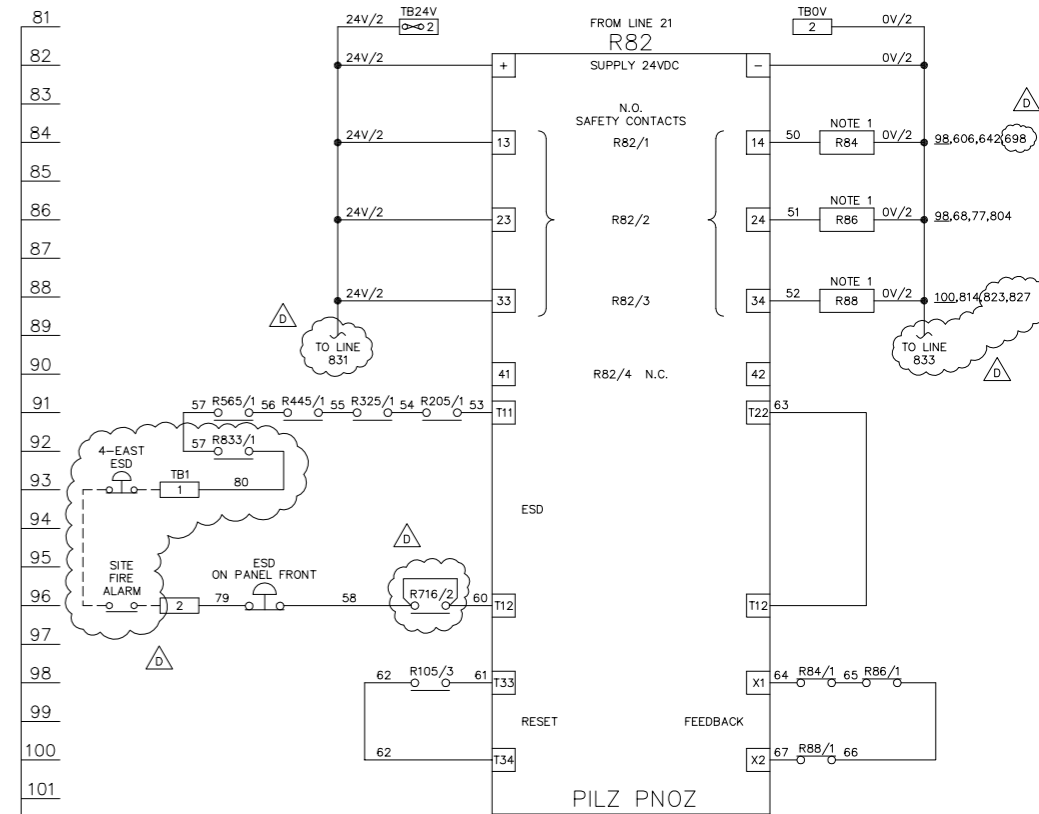

- NOTES**
- OMRON G7S-4A2B GUIDED CONTACT RELAY (RS260-4373)
  - DECOMMISSIONED BATCHING SYSTEM. INPUTS NOT USED IN PLC




REV	DATE	BY	DRN	CHK'D	APP'D	DESCRIPTION
A	07/04/99	A.J.H.	A.J.H.	D.R.R.	D.R.R.	ORIGINAL ISSUE
B	14/03/99	A.J.H.	A.J.H.	D.R.R.	D.R.R.	GENERAL UPDATE
C	01/07/99	D.P.	A.J.H.	D.R.R.	D.R.R.	PANEL TEST MODS
D	14/09/10	D.B.F.	P.P.	M.M.	M.M.	SI760 MODIFICATIONS

PLANT	IMMINGHAM STORAGE Co. - EAST TERMINAL
TITLE	4-EAST RAIL LOADING SYSTEM PANEL LOGIC DRAWING 1
CLIENT DRG. No.	IMMINGHAM STORAGE Co. Ltd. IMMINGHAM EAST TERMINAL, IMMINGHAM DOCK, IMMINGHAM, SOUTH HUMBERSIDE
P&I DRG No.	SI039002_DWG




SHEET 1 OF 1  
 P&I Design Ltd  
 Tel: 01642 617444  
 www.ptdesign.co.uk


LEGEND OF GRAPHICAL SYMBOLS (ALL CONTACTS SHOWN IN THE DE-ENERGISED STATE)

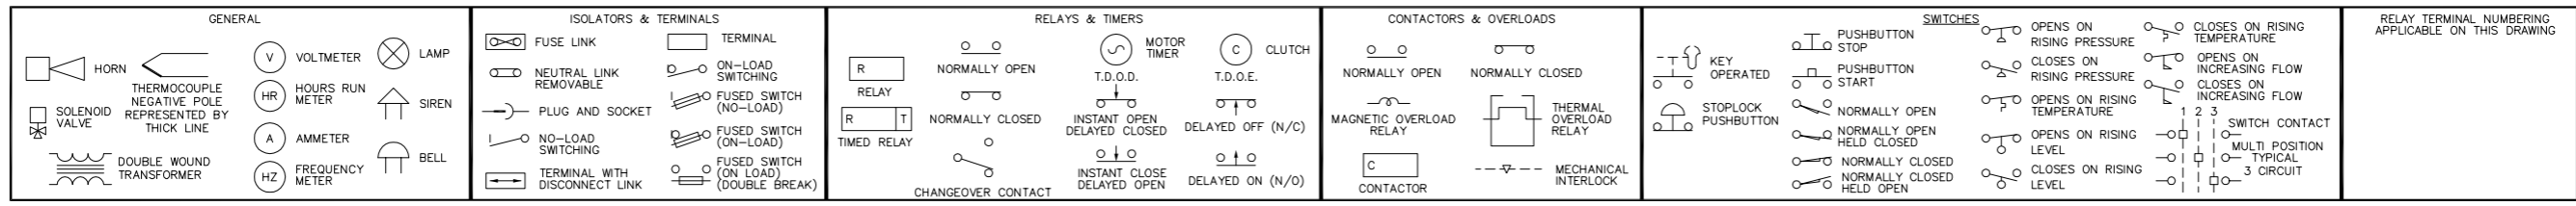


**POWER DISTRIBUTION**

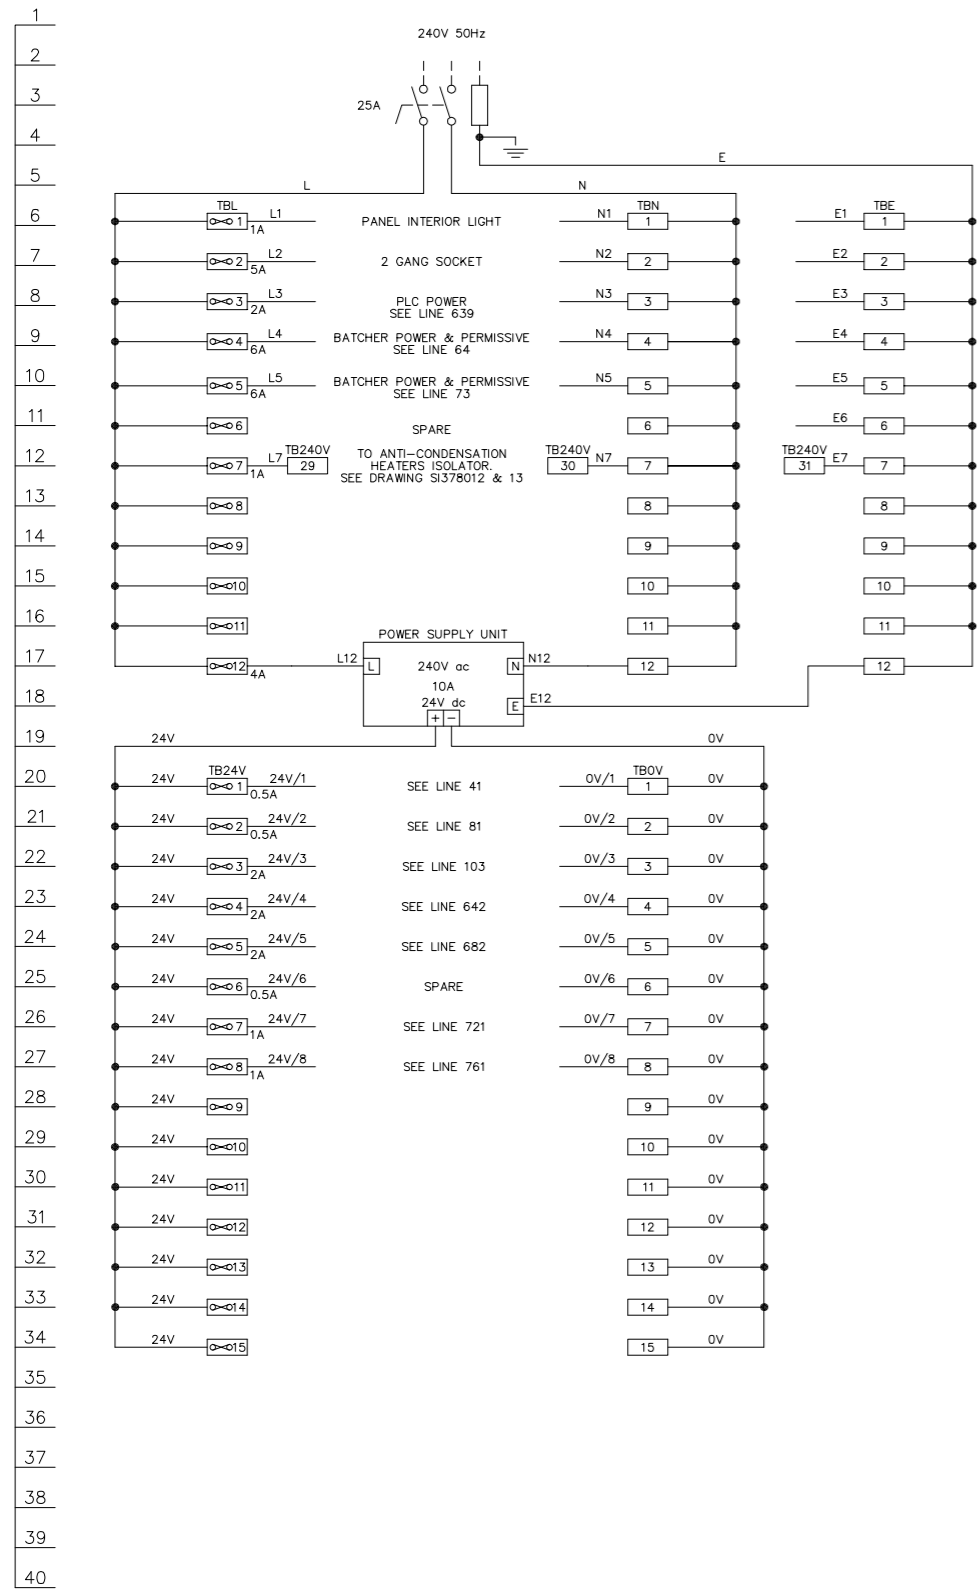


**LEVEL**

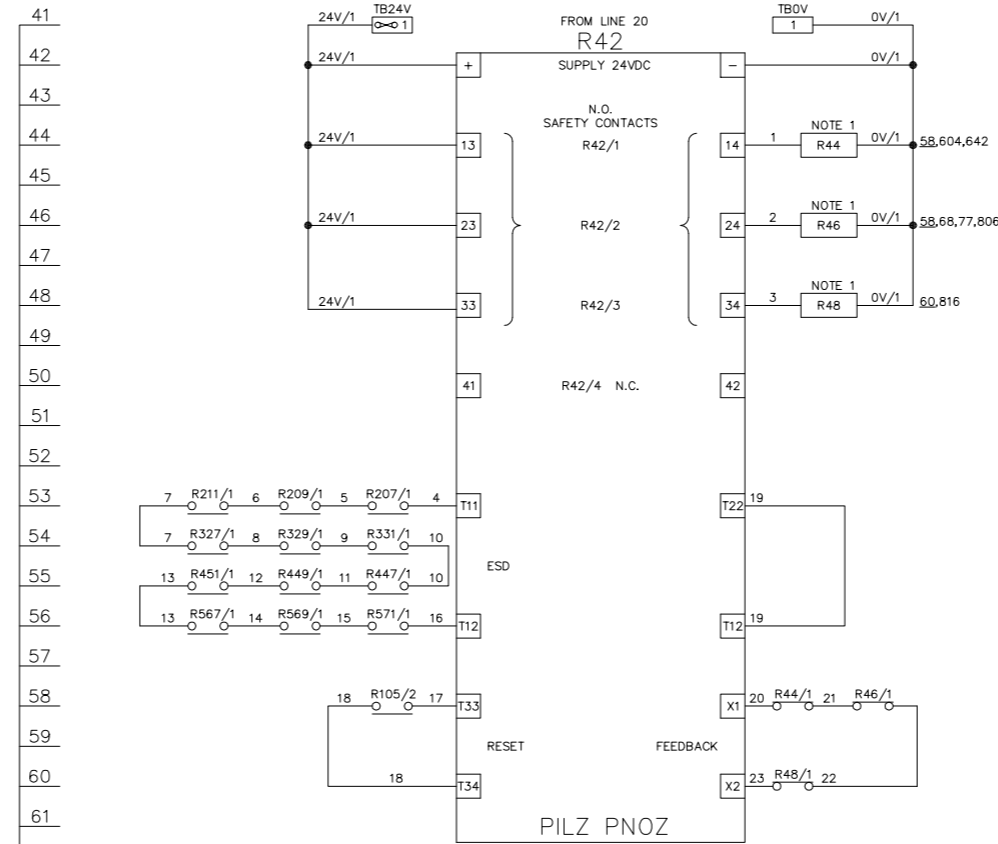


**ESD**

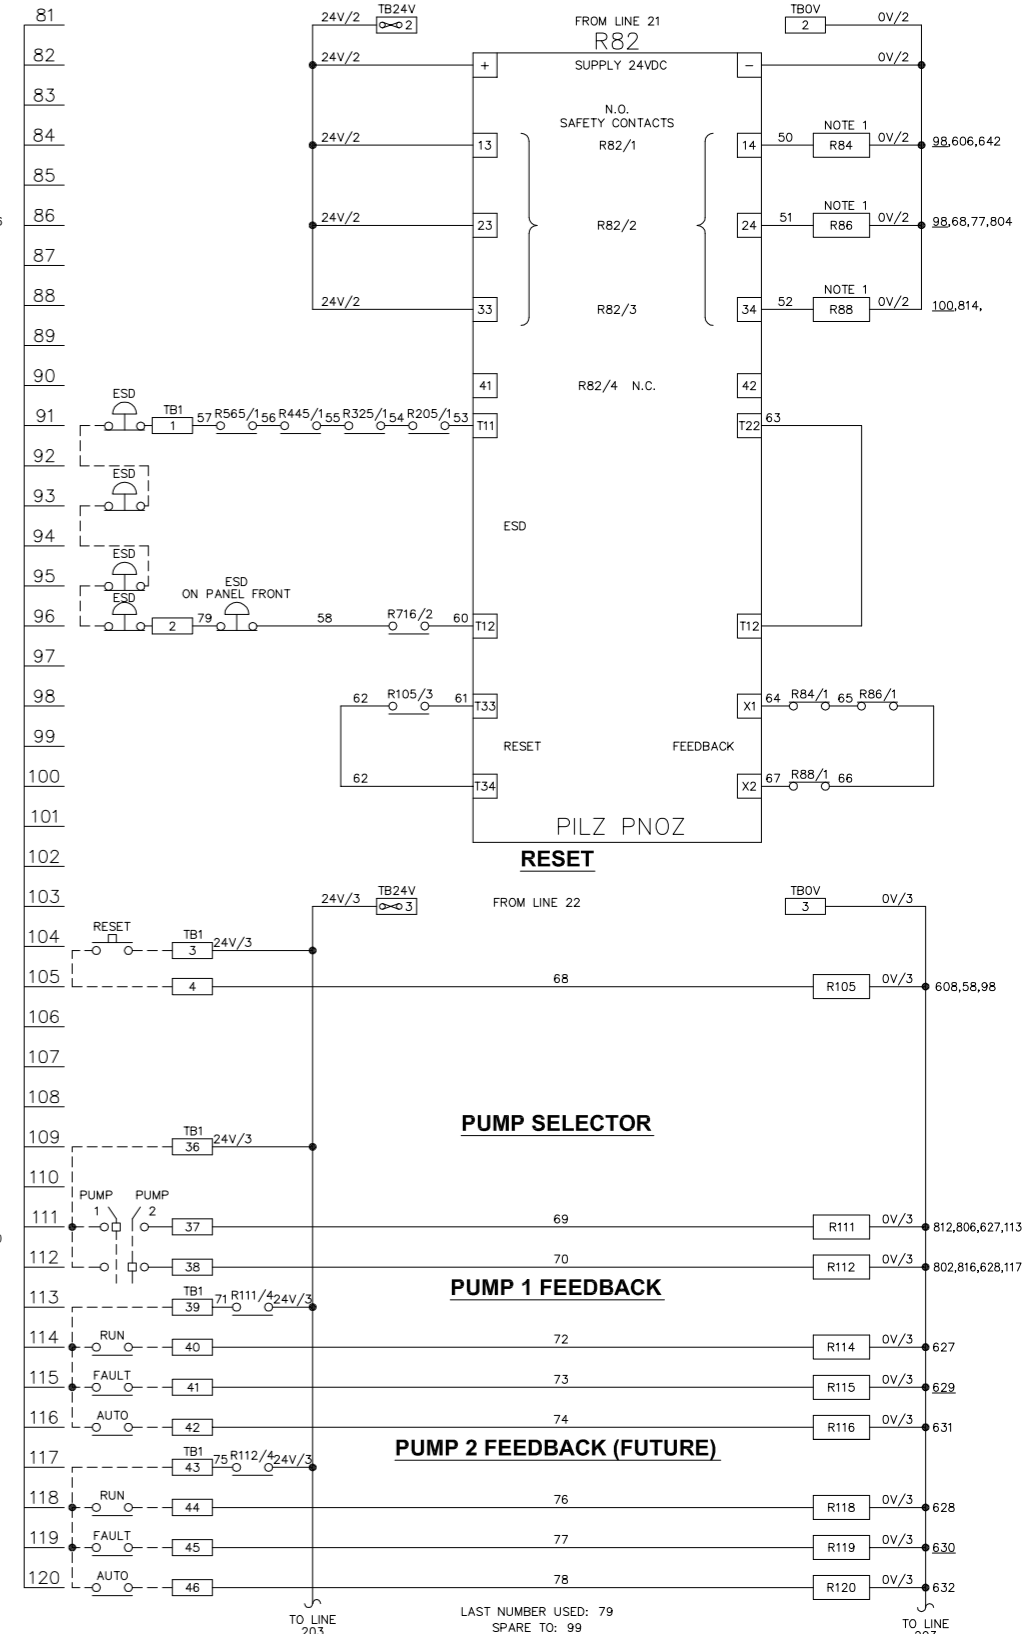

**NORTH SIDING BATCHER PERMISSIVES (240V)**

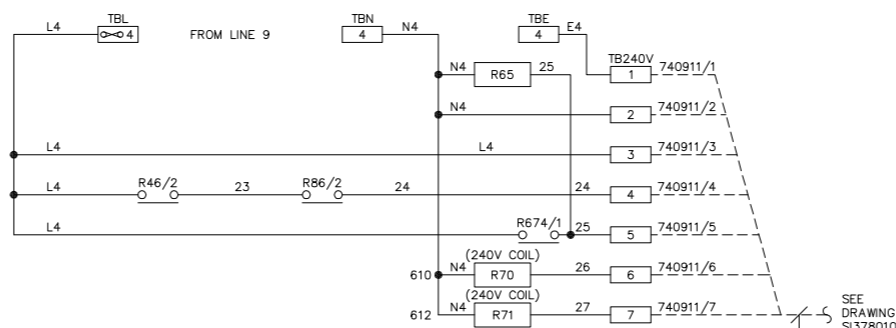

**SOUTH SIDING BATCHER PERMISSIVES (240V)**

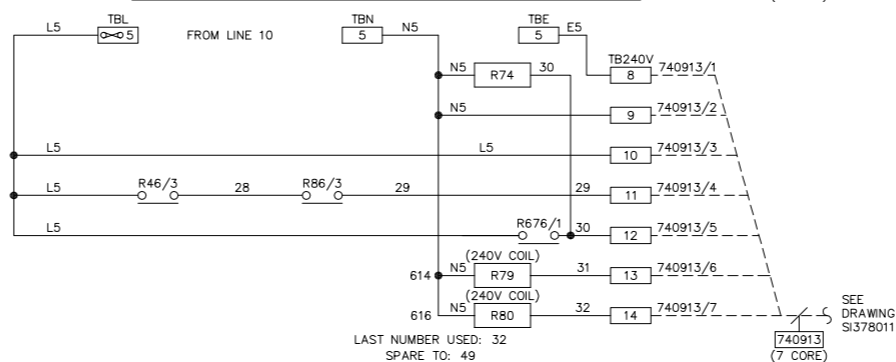

LAST NUMBER USED: 32 SPARE TO: 49

**NOTES**  
 1. RELAY WITH POSITIVELY GUIDED CONTACTS RS STOCK CODE (RS260-4373)

REV	DATE	BY	DRN	CHK'D	APP'D	DESCRIPTION	PLANT	FINA DERV RAIL LOADING SYSTEM
A	07/04/99	A.J.H	A.J.H	P.J.P	P.J.P	D.R.R	D.R.R	ORIGINAL ISSUE
B	14/03/99	A.J.H	A.J.H	D.R.R	D.R.R	D.R.R	D.R.R	GENERAL UPDATE
C	01/07/99	D.P.	A.J.H	D.R.R	D.R.R	D.R.R	D.R.R	PANEL TEST MODS


IMMINGHAM STORAGE Co Ltd, IMMINGHAM EAST TERMINAL, SOUTH HUMBERSIDE

**Simon Storage** **Terminals**


ELECTRICAL SCHEMATIC TEMPLATE SHEET 01 OF 01

CLIENT DRG. No. P&I DRG No. SIO39002

LEGEND OF GRAPHICAL SYMBOLS (ALL CONTACTS SHOWN IN THE DE-ENERGISED STATE)

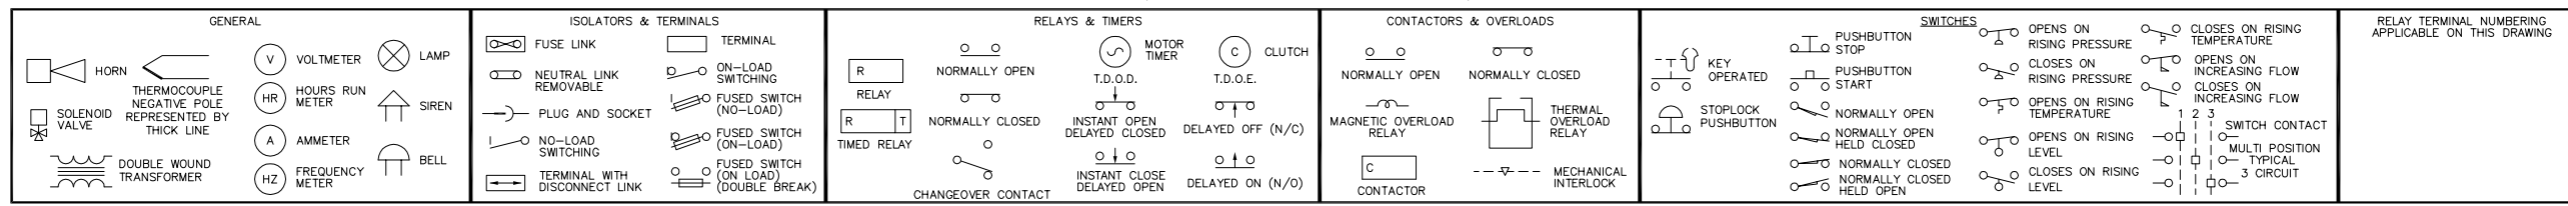

**MUX 1 (NORTH SIDING)**

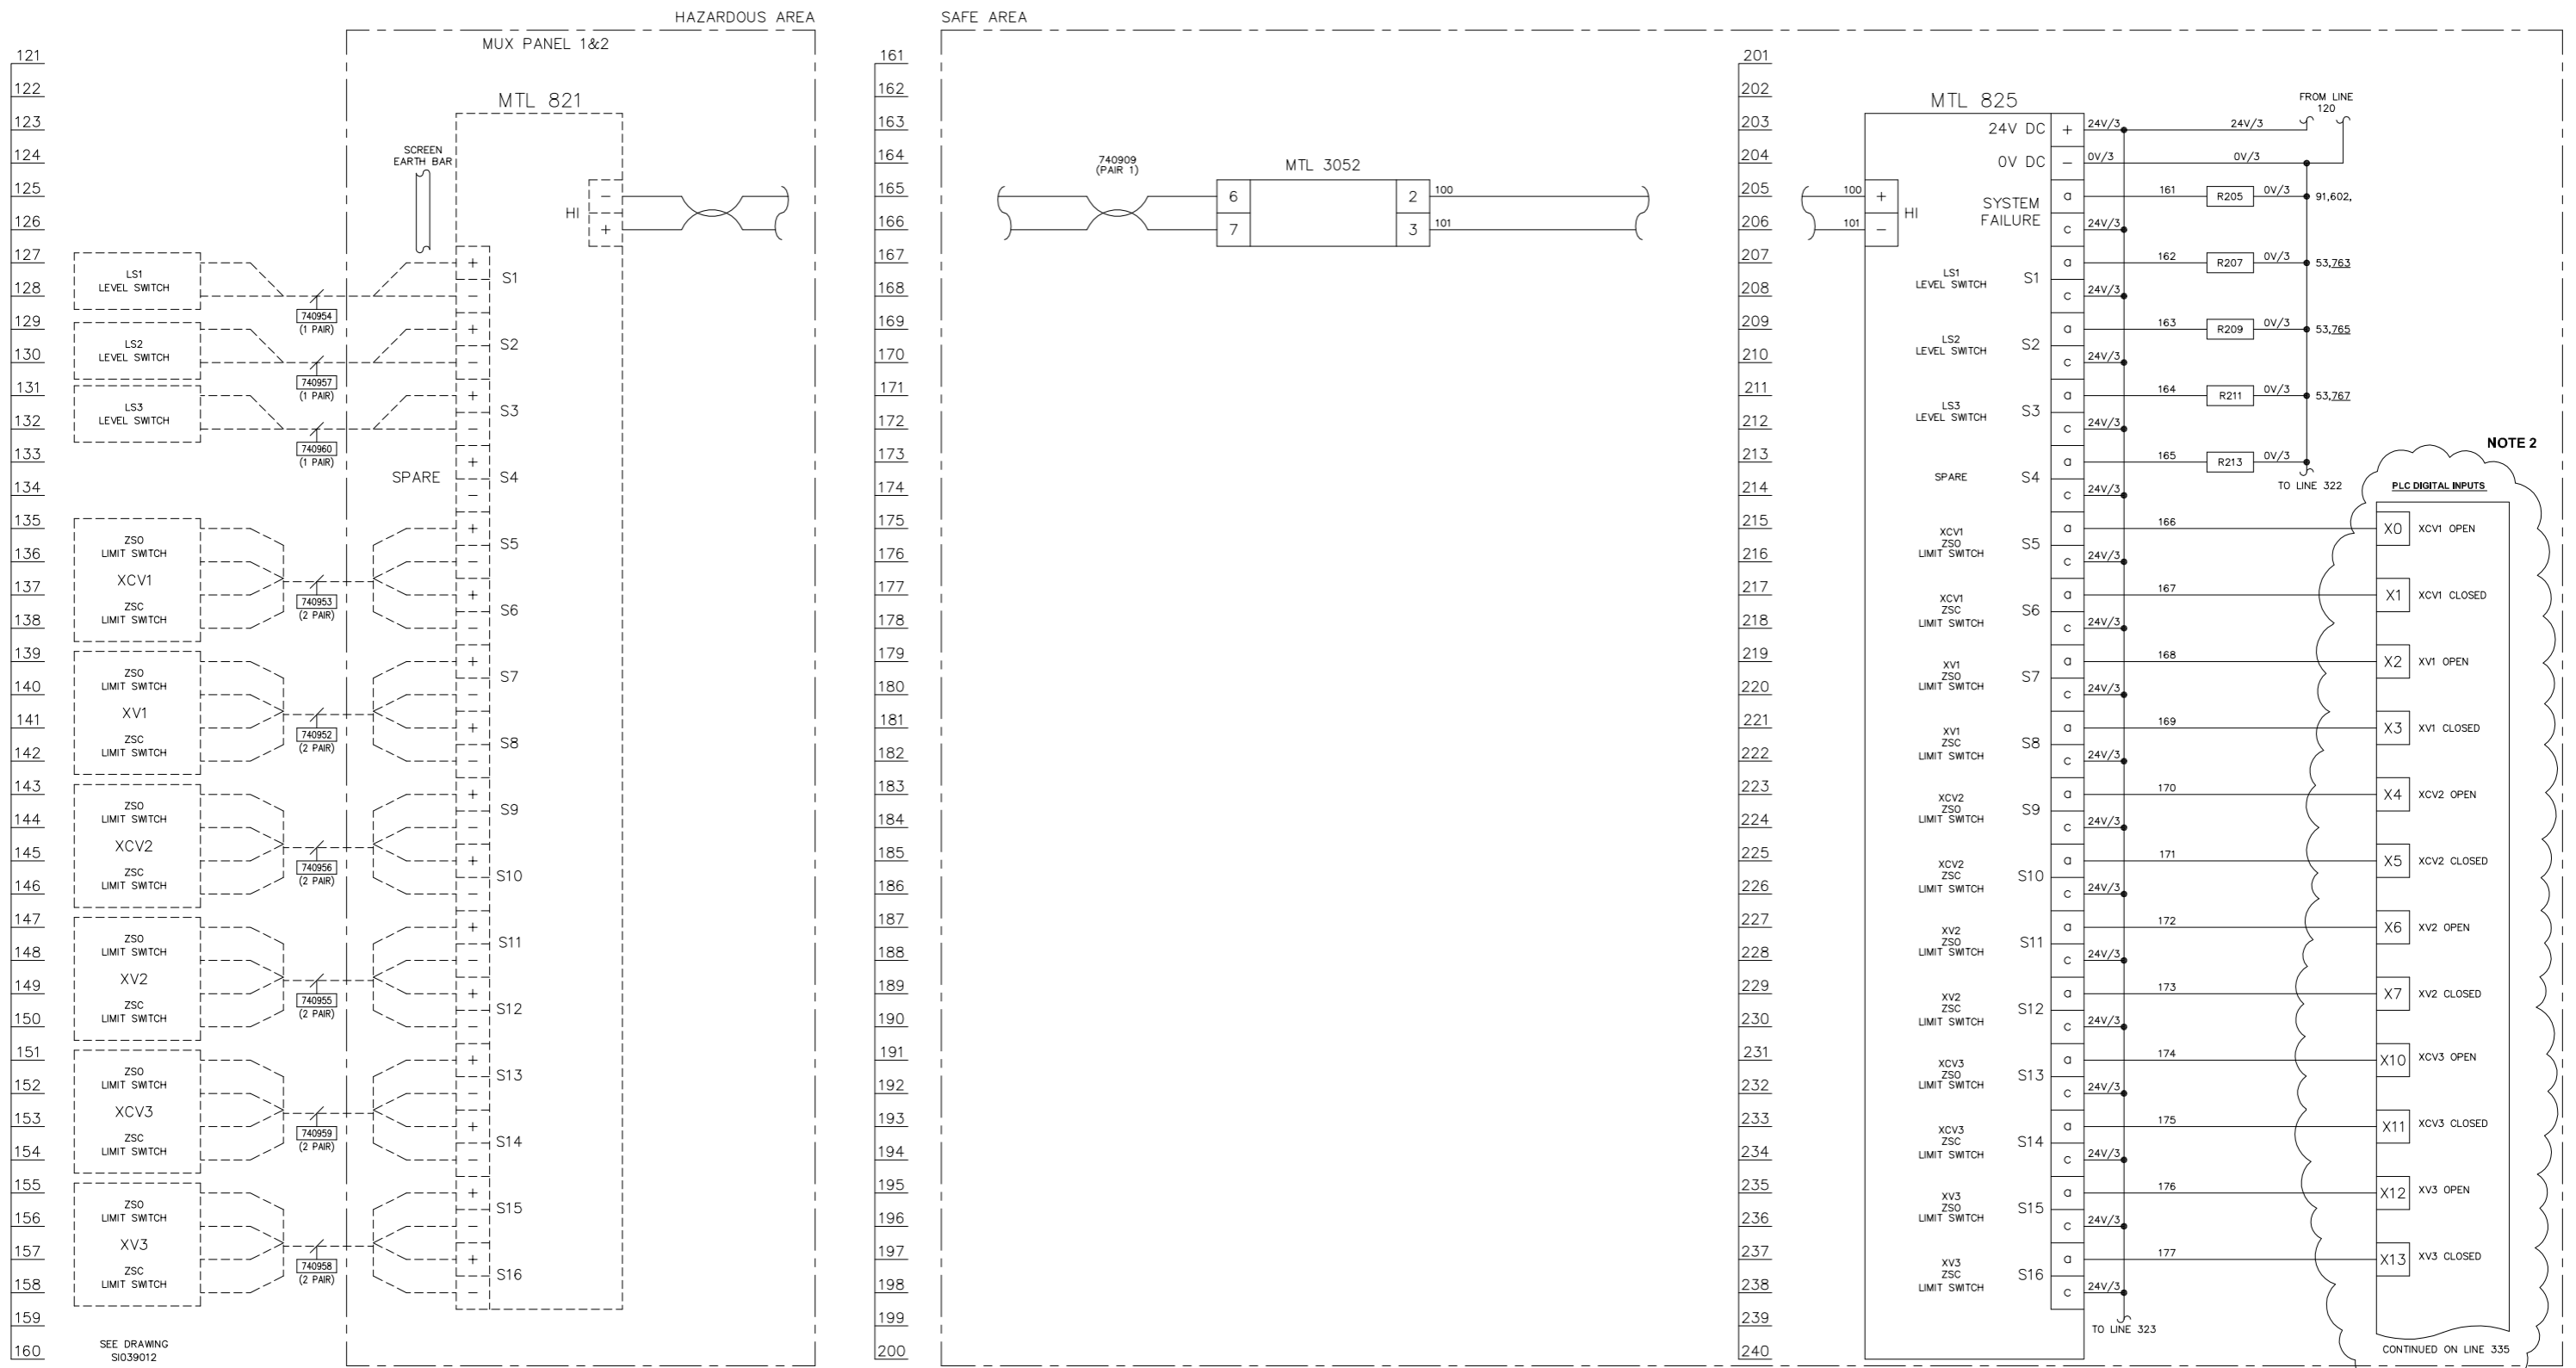

LAST NUMBER USED: 101  
SPARE TO: 160

LAST NUMBER USED: 177  
SPARE TO: 199


- NOTES**
- SCREEN EARTHS NOT SHOWN FOR CLARITY.
  - DECOMMISSIONED BATCHING SYSTEM. INPUTS NOT USED IN PLC




IF NOT SIGNED THIS DOCUMENT IS UNCONTROLLED

REV	DATE	BY	DRN	CHK'D	APP'D	DESCRIPTION
A	07/04/99	A.J.H	A.J.H	D.R.R	D.R.R	ORIGINAL ISSUE
B	07/07/99	A.J.H	A.J.H	D.R.R	D.R.R	COMMS POLARITY REVERSED
C	14/09/10	D.B.F	P.P.	M.M.	M.M.	SI760 MODIFICATIONS

PLANT	IMMINGHAM STORAGE Co. - EAST TERMINAL
TITLE	4-EAST RAIL LOADING SYSTEM PANEL LOGIC DRAWING 2
CLIENT DRG. No.	IMMINGHAM STORAGE Co. Ltd. IMMINGHAM EAST TERMINAL, IMMINGHAM DOCK, IMMINGHAM, SOUTH HUMBERSIDE
P&I DESIGN	P & I Design Ltd Tel. 01642 617444 www.pidesign.co.uk
SHEET 1 OF 1	
P&I DRG No.	SI039003_DWG

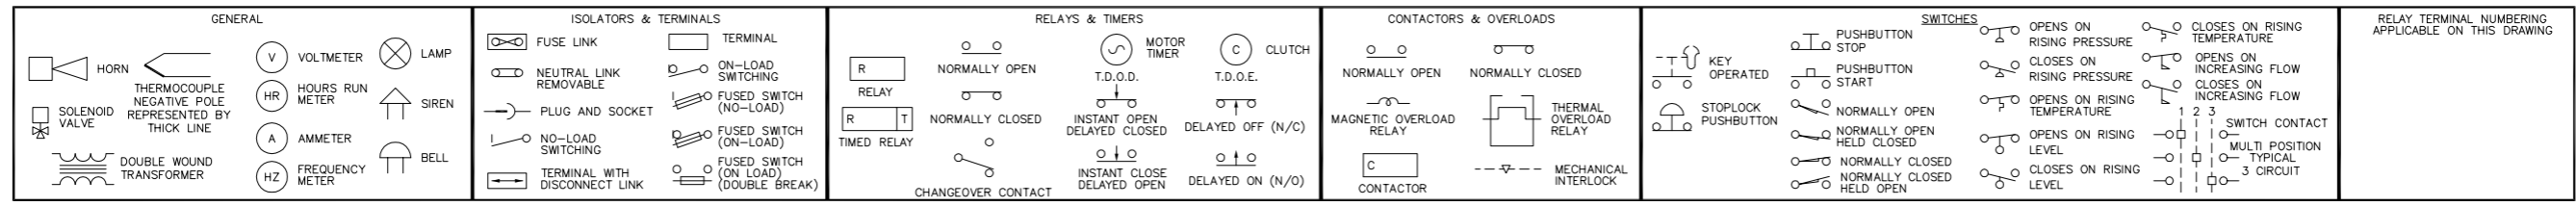

**MUX 1 (NORTH SIDING)**

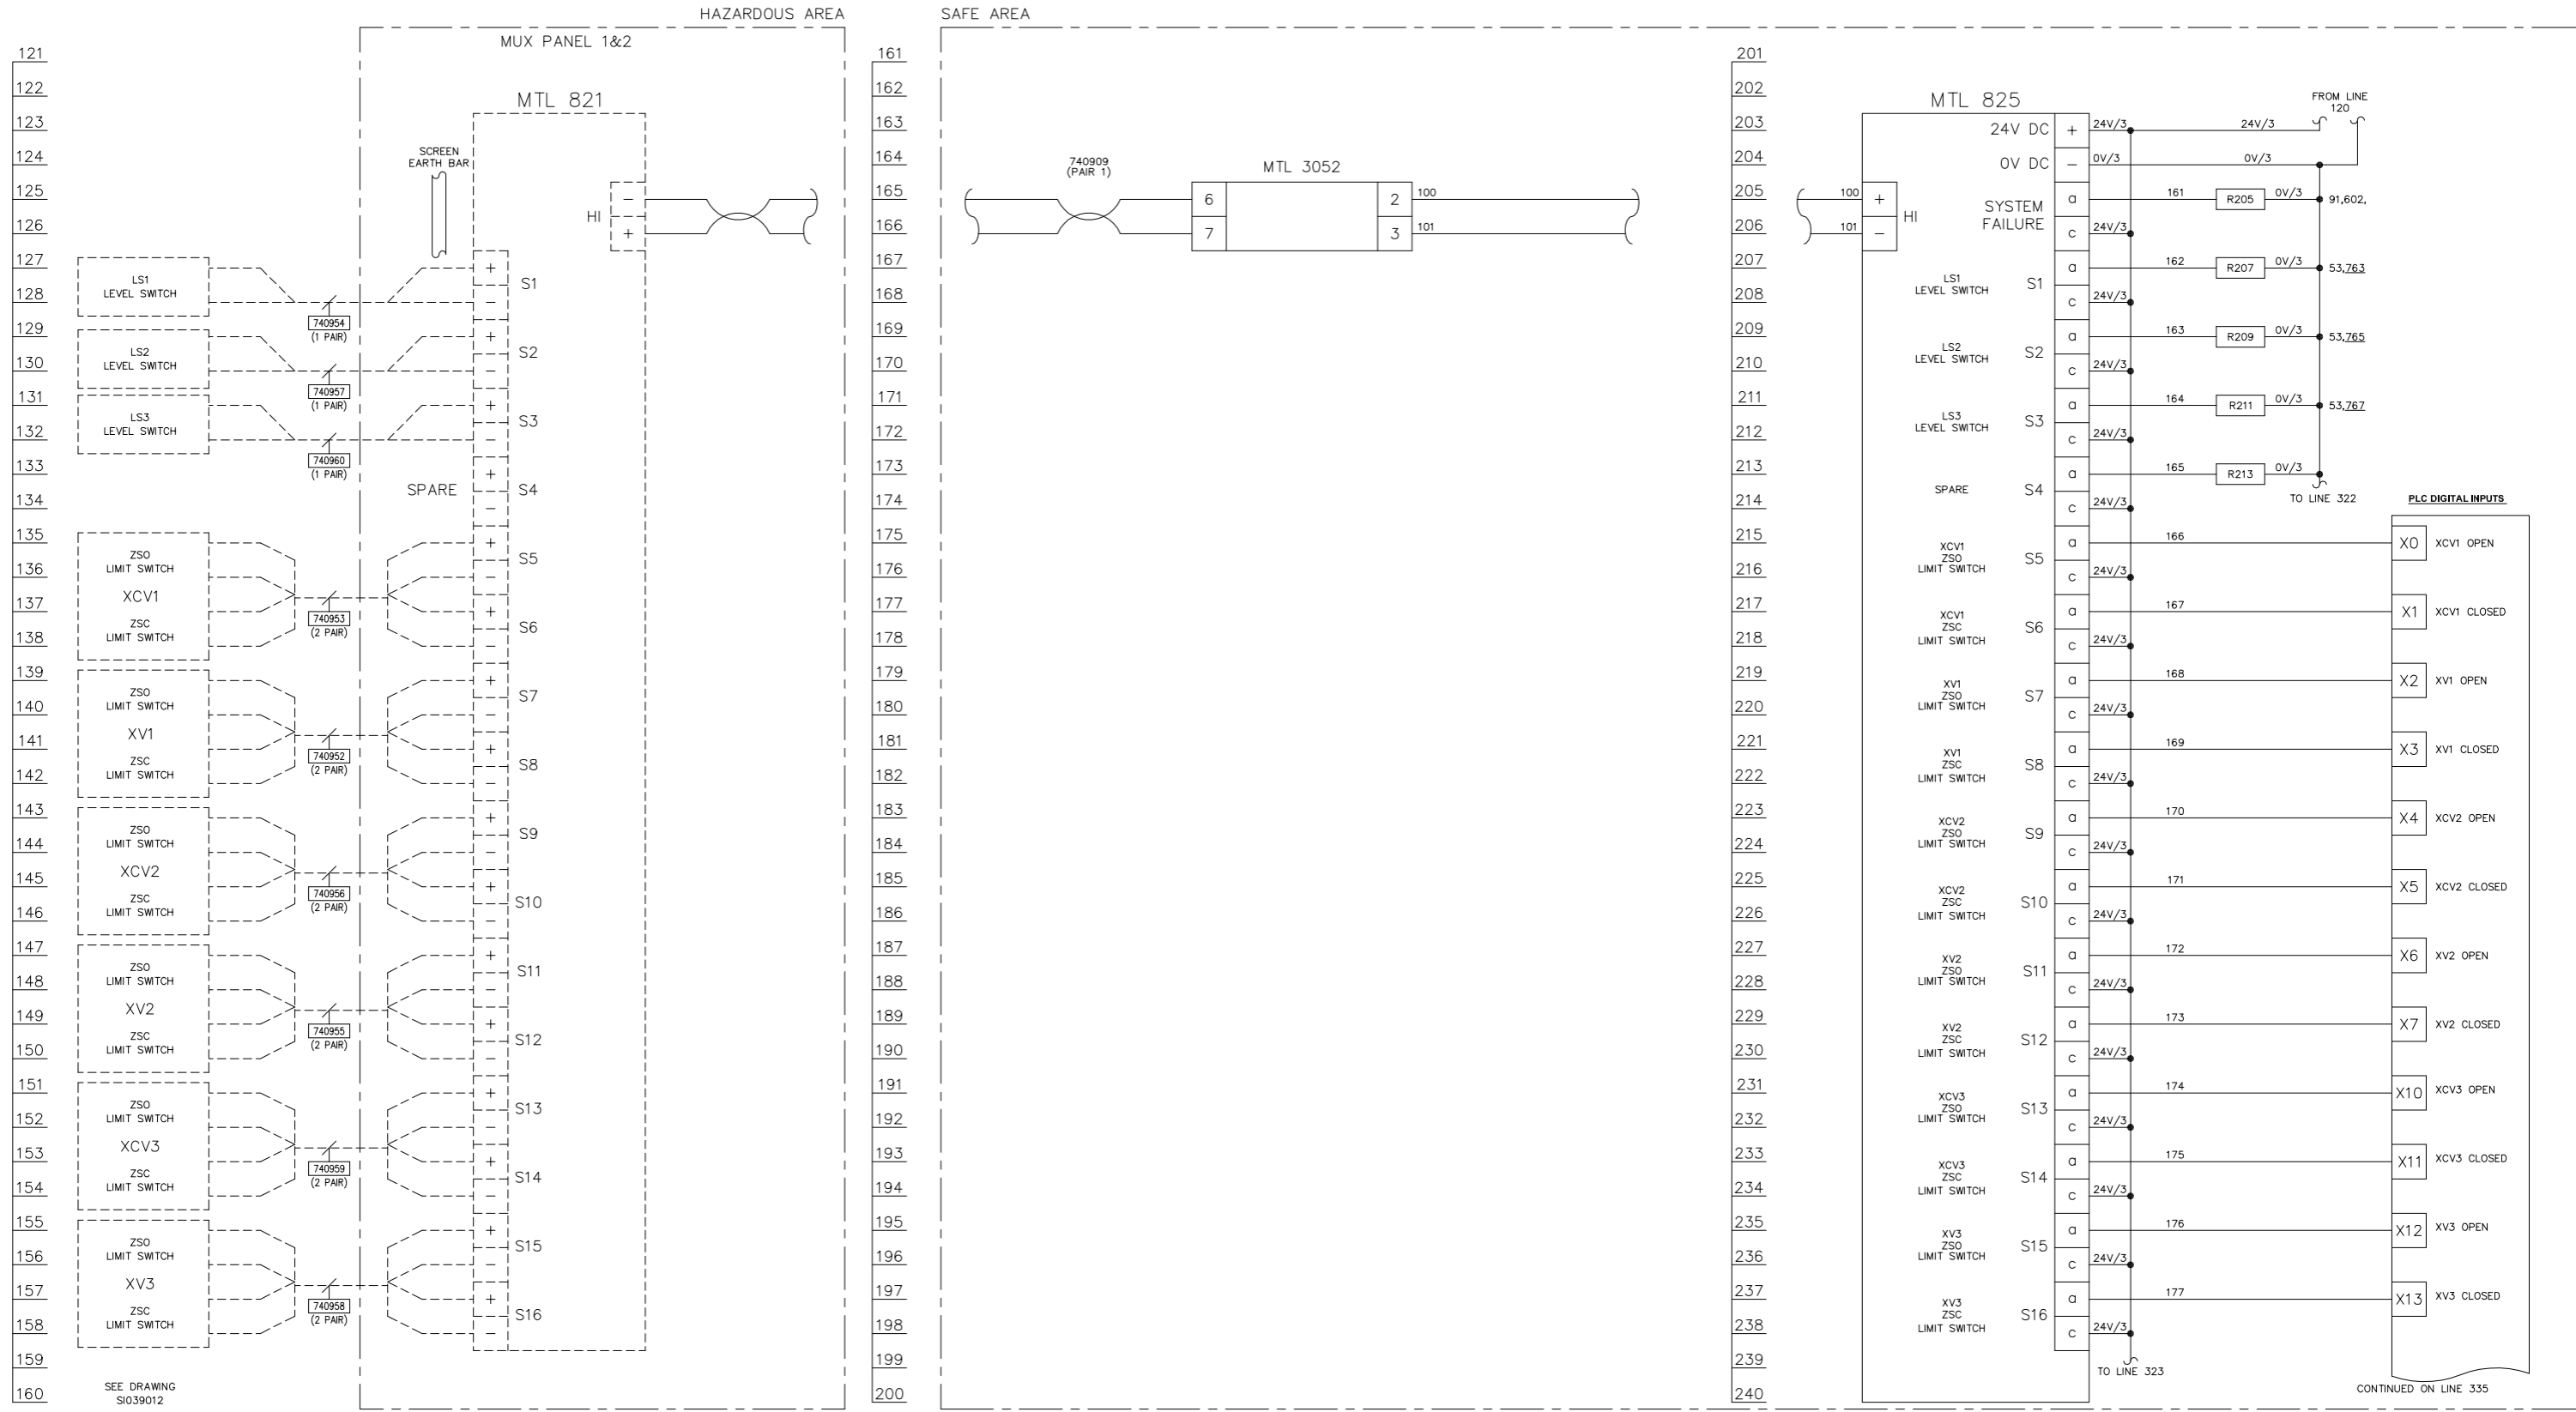

LAST NUMBER USED: 101  
 SPARE TO: 160

LAST NUMBER USED: 177  
 SPARE TO: 199

**NOTES**  
 1. SCREEN EARTHS NOT SHOWN FOR CLARITY.

REV	DATE	BY	DRN	CHK'D	APP'D	DESCRIPTION	PLANT	FINA DERV RAIL LOADING SYSTEM
A	04/03/99	A.J.H	A.J.H	P.J.P	P.J.P	D.R.R	D.R.R	ORIGINAL ISSUE
B	02/07/99	A.J.H	A.J.H	D.R.R	D.R.R	D.R.R	D.R.R	COMMS POLARITY REVERSED

02/07/99


**Simon Storage** IMMINGHAM STORAGE Co Ltd, IMMINGHAM EAST TERMINAL, IMMINGHAM DOCK, IMMINGHAM, SOUTH HUMBERSIDE

**P & I DESIGN**


ELECTRICAL SCHEMATIC TEMPLATE SHEET 01 OF 01

CLIENT DRG. No. P&I DRG No. SIO39003

LEGEND OF GRAPHICAL SYMBOLS (ALL CONTACTS SHOWN IN THE DE-ENERGISED STATE)

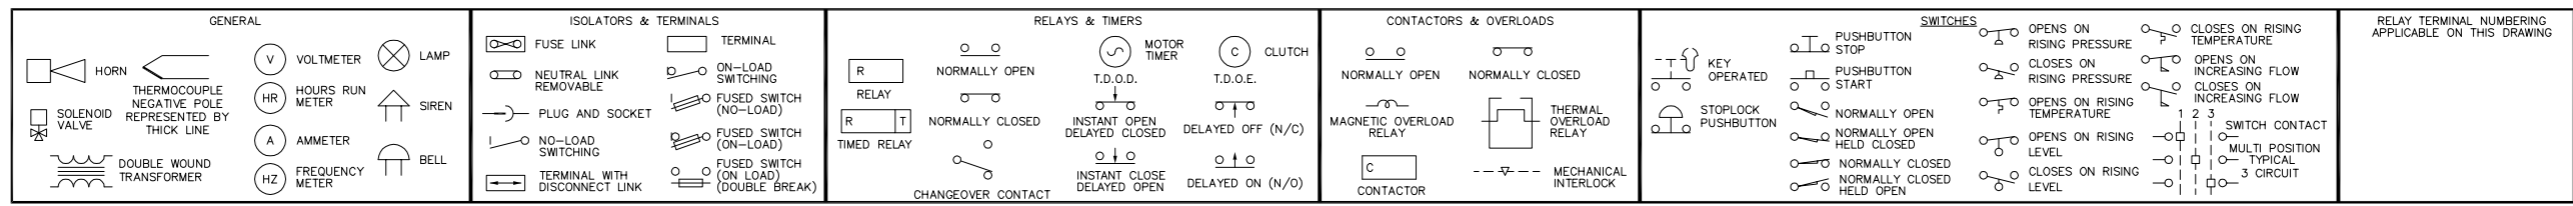

**MUX 2 (SOUTH SIDING)**

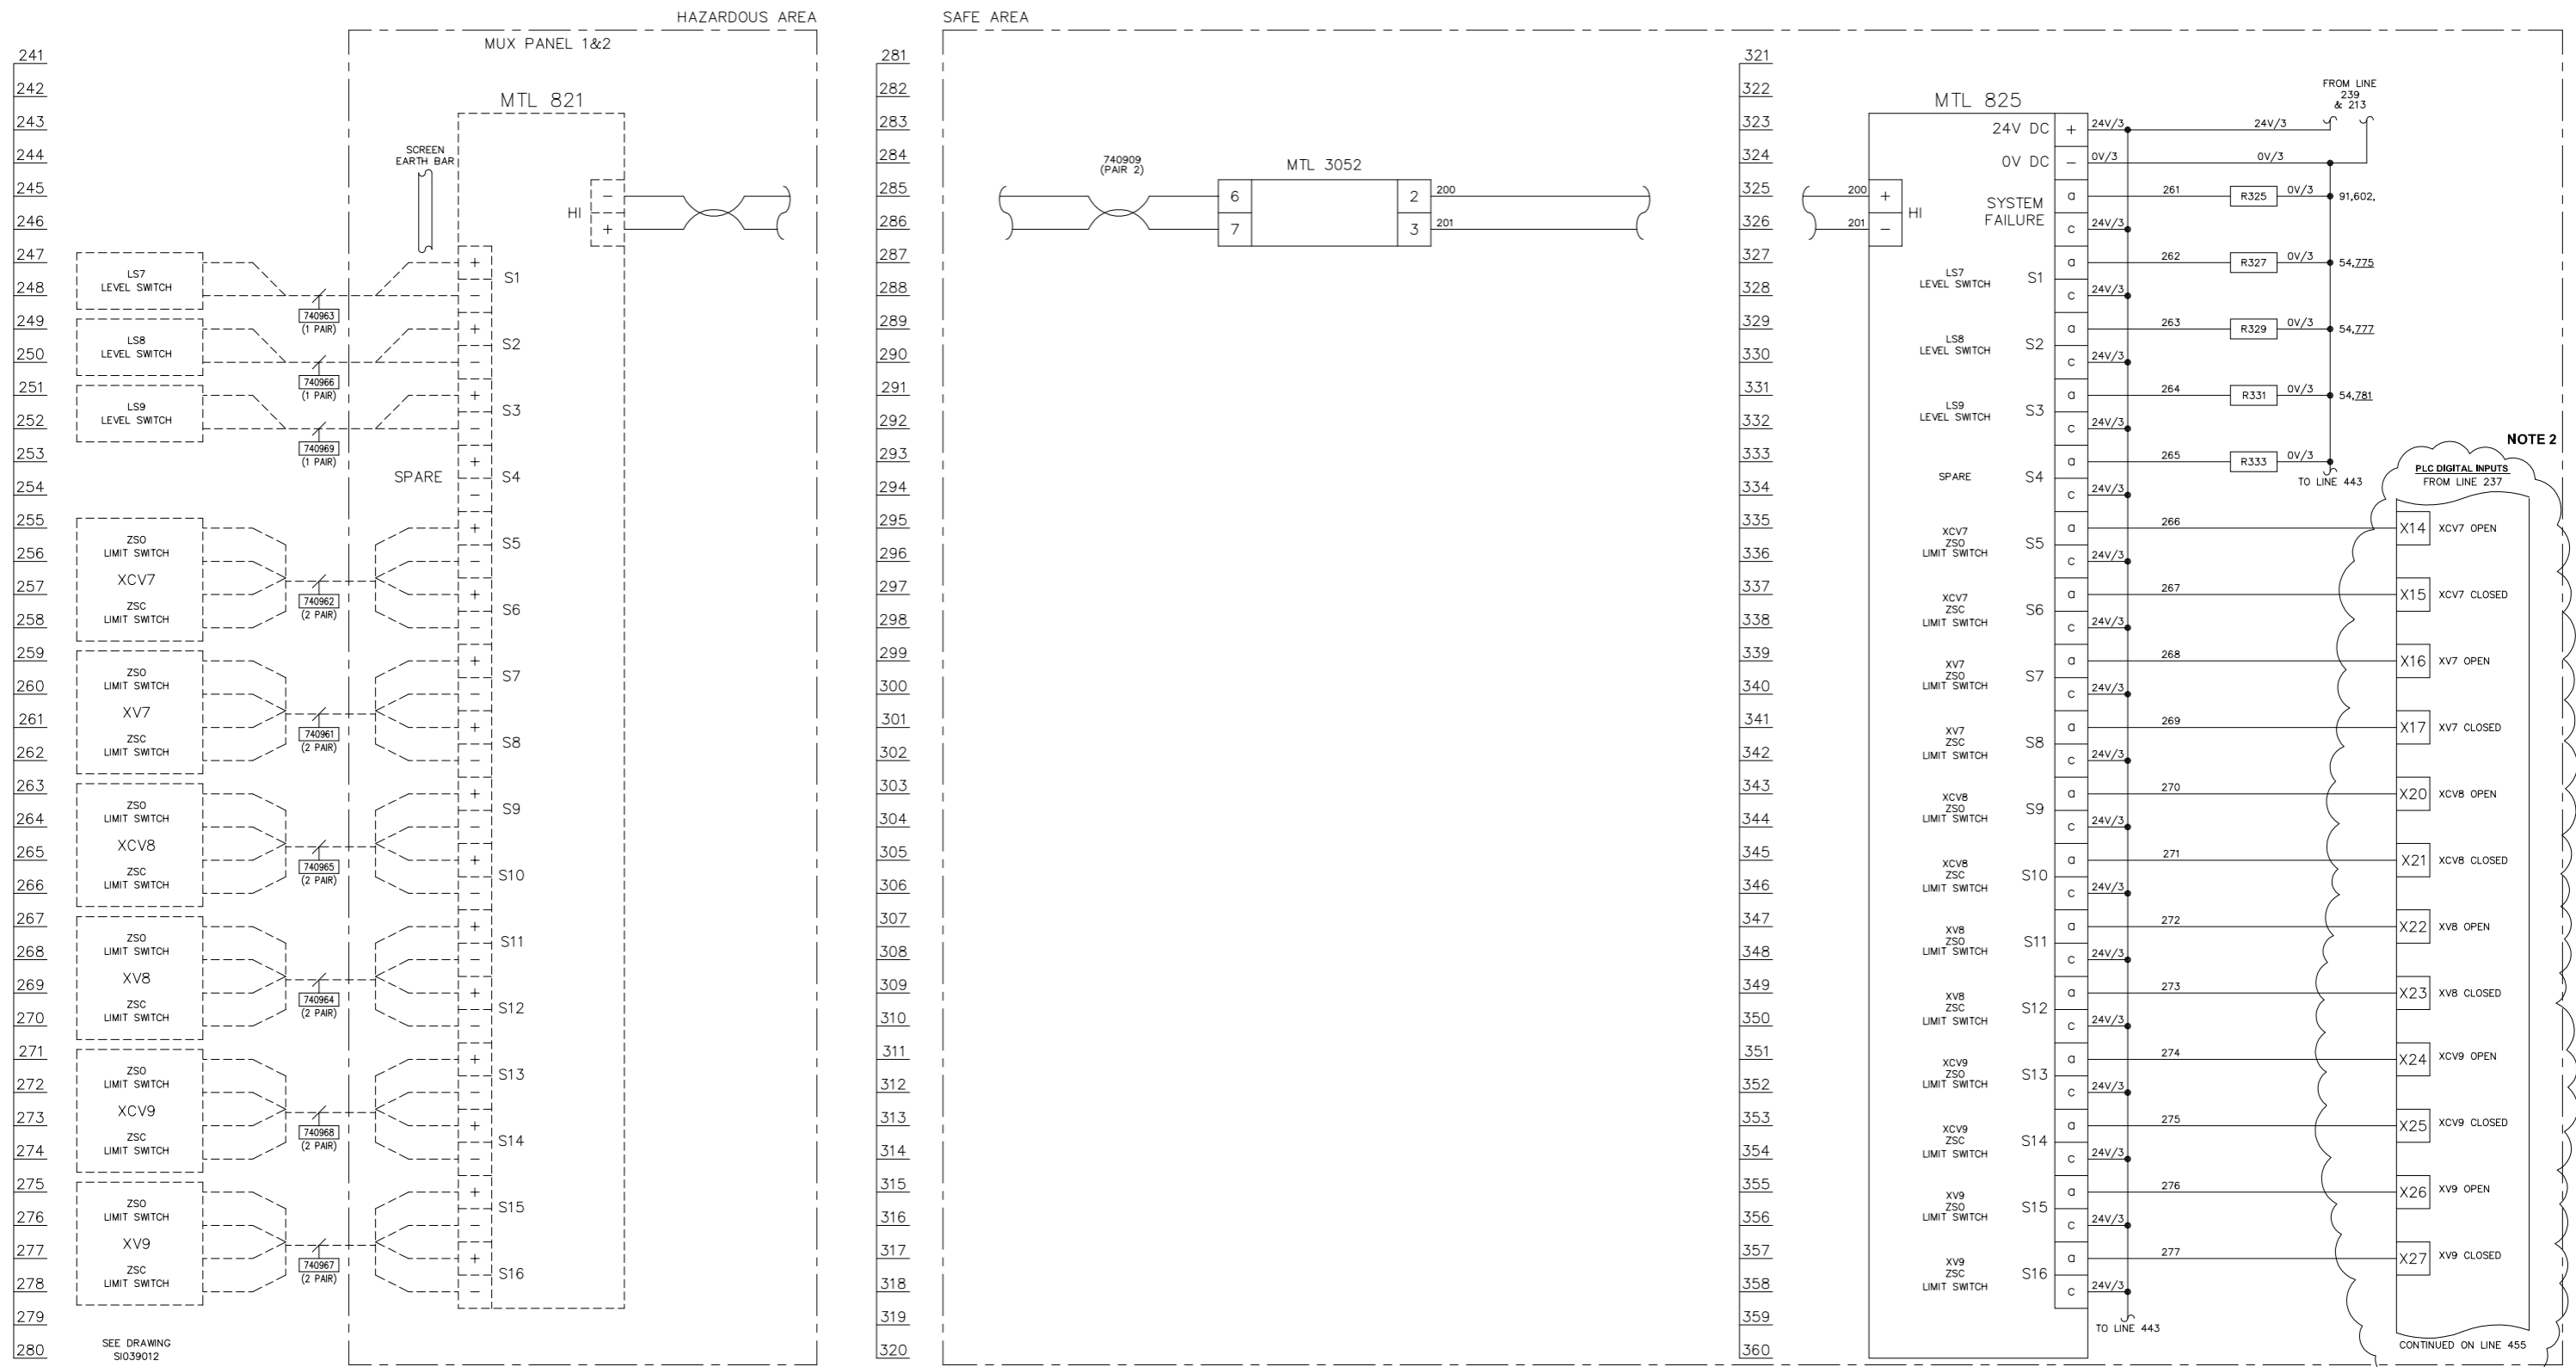

LAST NUMBER USED: 201  
SPARE TO: 260

LAST NUMBER USED: 277  
SPARE TO: 299

- NOTES**
- SCREEN EARTHS NOT SHOWN FOR CLARITY.
  - DECOMMISSIONED BATCHING SYSTEM. INPUTS NOT USED IN PLC




IF NOT SIGNED THIS DOCUMENT IS UNCONTROLLED							PLANT	IMMINGHAM STORAGE Co. - EAST TERMINAL
REV	DATE	BY	DRN	CHK'D	APP'D	DESCRIPTION	TITLE	4-EAST RAIL LOADING SYSTEM PANEL LOGIC DRAWING 3
A	04/03/99	A.J.H	A.J.H	P.J.P	P.J.P	D.R.R	D.R.R	ORIGINAL ISSUE
B	02/07/99	A.J.H	A.J.H	D.R.R	D.R.R	D.R.R	D.R.R	COMMS POLARITY REVERSED
C	14/09/10	D.B.F	P.P.	M.M.	M.M.			SI760 MODIFICATIONS


  

	IMMINGHAM STORAGE Co. Ltd. IMMINGHAM EAST TERMINAL, IMMINGHAM DOCK, IMMINGHAM, SOUTH HUMBERSIDE		P & I Design Ltd Tel. 01642 617444 www.ptdesign.co.uk
CLIENT DRG. No.		SHEET 1 OF 1 P&I DRG No. SI039004_DWG	

LEGEND OF GRAPHICAL SYMBOLS (ALL CONTACTS SHOWN IN THE DE-ENERGISED STATE)

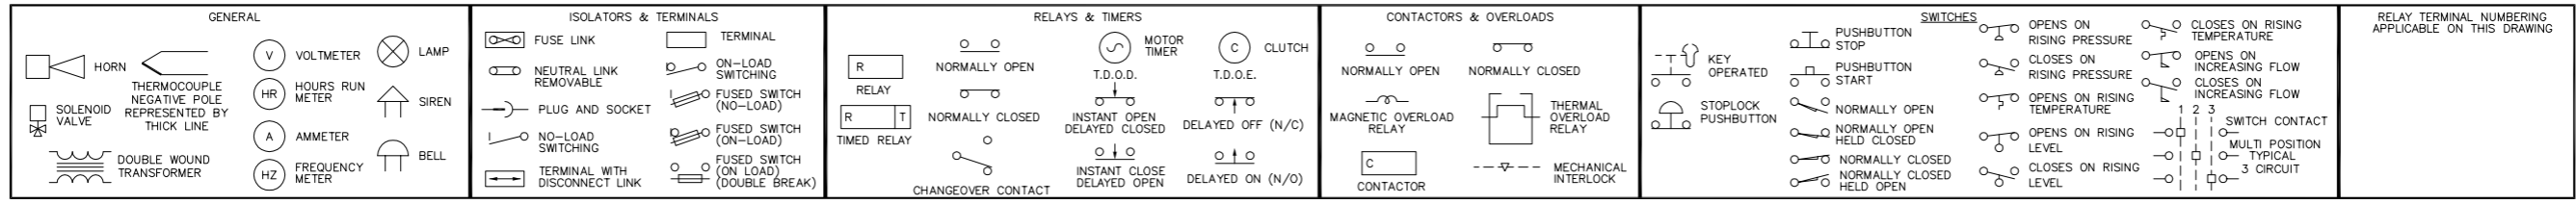

**MUX 2 (SOUTH SIDING)**

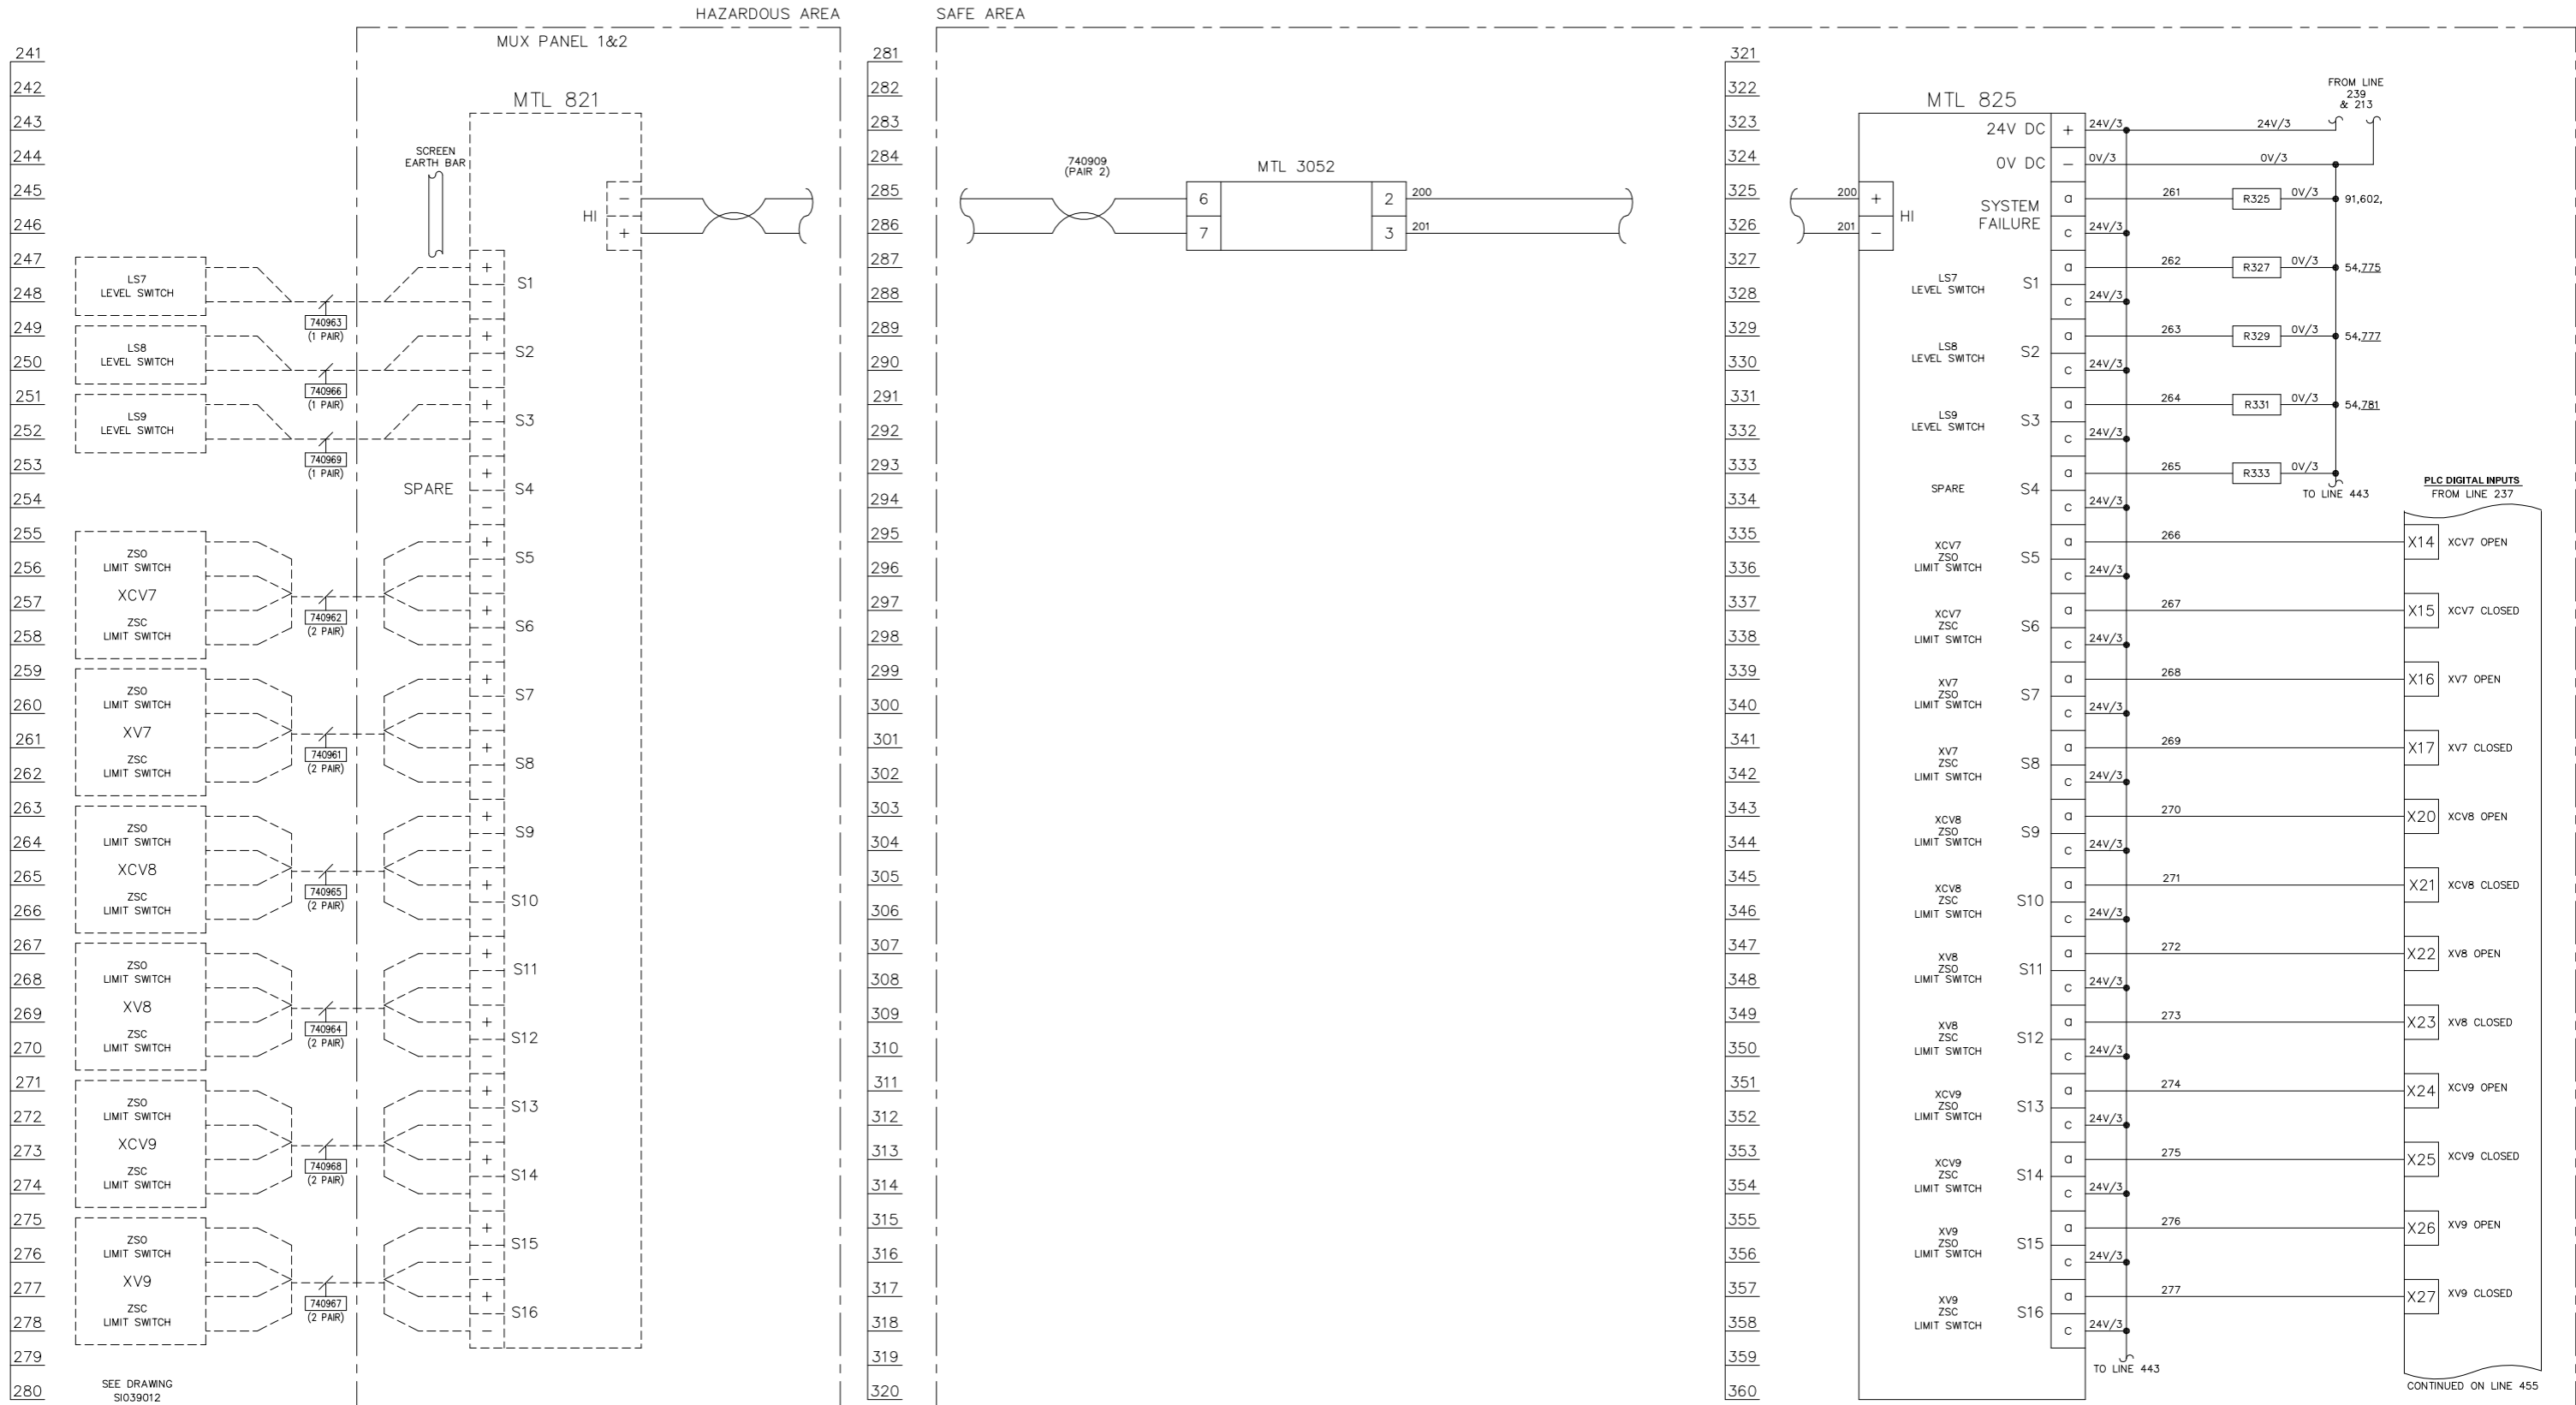

LAST NUMBER USED: 201  
 SPARE TO: 260

LAST NUMBER USED: 277  
 SPARE TO: 299

**NOTES**  
 1. SCREEN EARTHS NOT SHOWN FOR CLARITY.

REV	DATE	BY	DRN	CHK'D	APP'D	DESCRIPTION	PLANT	FINA DERV RAIL LOADING SYSTEM
A	04/03/99	A.J.H	A.J.H	P.J.P	P.J.P	ORIGINAL ISSUE	LOGIC 3	
B	02/07/99	A.J.H	A.J.H	D.R.R	D.R.R	COMMS POLARITY REVERSED		

02/07/99


**Simon Storage** TERMINALS IMMINGHAM STORAGE Co Ltd, IMMINGHAM EAST TERMINAL, IMMINGHAM DOCK, IMMINGHAM, SOUTH HUMBERSIDE

**P & I DESIGN**


ELECTRICAL SCHEMATIC TEMPLATE SHEET 01 OF 01

CLIENT DRG. No. P&I DRG No. SI039004

LEGEND OF GRAPHICAL SYMBOLS (ALL CONTACTS SHOWN IN THE DE-ENERGISED STATE)

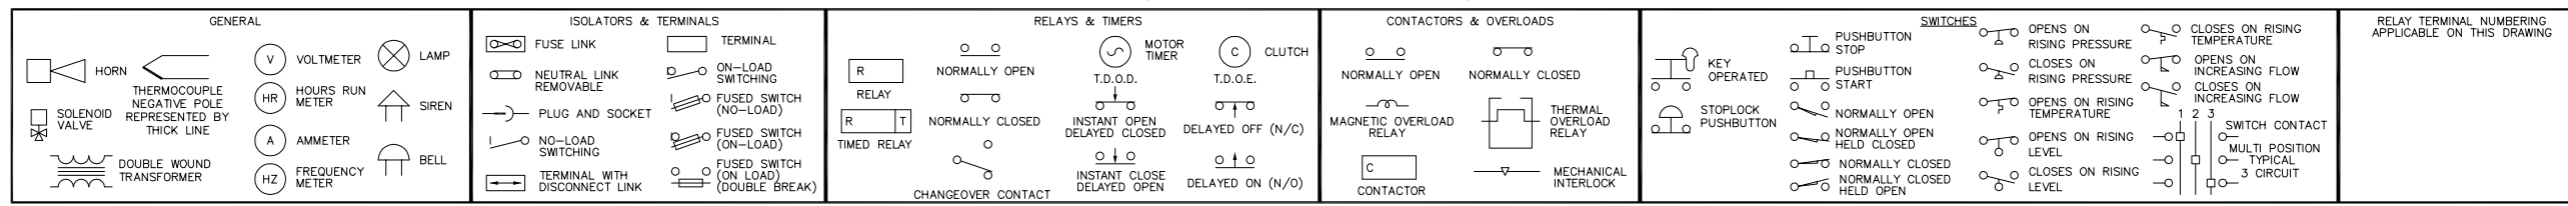

**MUX 3 (NORTH SIDING)**

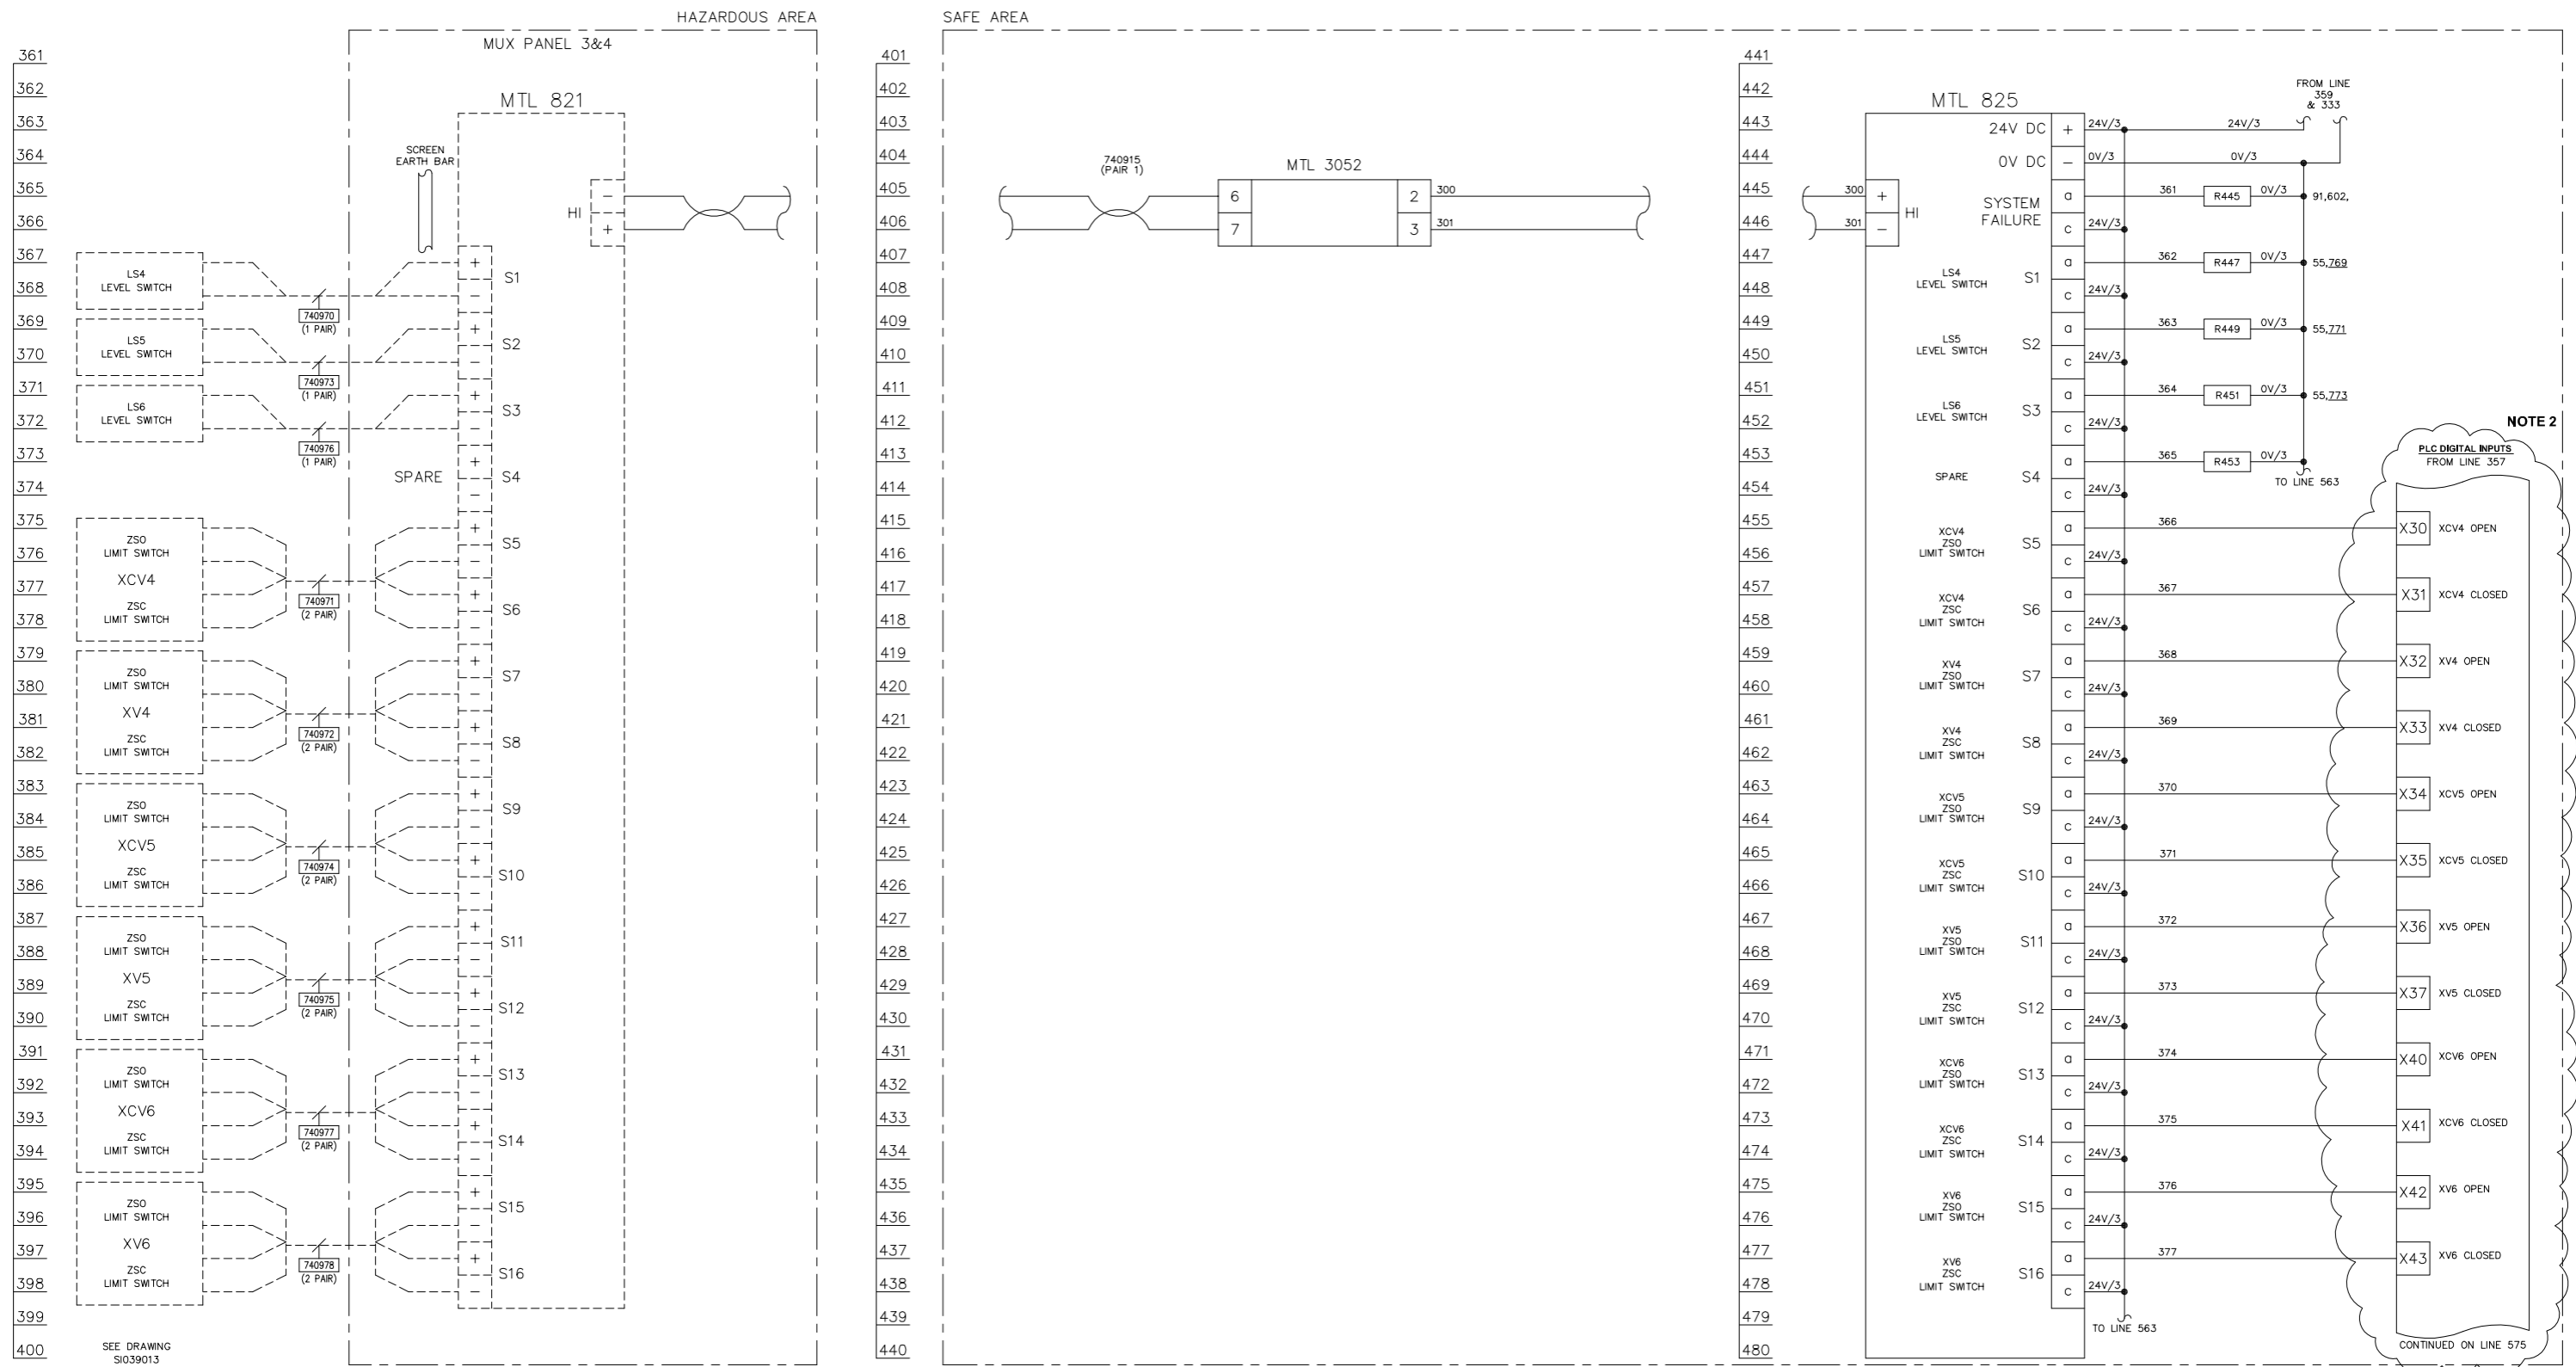

LAST NUMBER USED: 301  
 SPARE TO: 360

LAST NUMBER USED: 377  
 SPARE TO: 399


- NOTES**  
 1. SCREEN EARTHS NOT SHOWN FOR CLARITY.  
 2. DECOMMISSIONED BATCHING SYSTEM. INPUTS NOT USED IN PLC




IF NOT SIGNED THIS DOCUMENT IS UNCONTROLLED						
REV	DATE	BY	DRN	CHK'D	APP'D	DESCRIPTION
A	04/03/99	A.J.H.	A.J.H.	P.J.P.	P.J.P.	D.R.R. D.R.R. ORIGINAL ISSUE
B	07/07/99	D.P.	A.J.H.	D.R.R.	D.R.R.	COMMS POLARITY REVERSED
C	14/09/10	D.B.F.	P.P.	M.M.	M.M.	SI760 MODIFICATIONS

PLANT	IMMINGHAM STORAGE Co. - EAST TERMINAL
TITLE	4-EAST RAIL LOADING SYSTEM PANEL LOGIC DRAWING 4
CLIENT DRG. No.	P&I DESIGN P&I Design Ltd Tel. 01642 617444 www.ptdesign.co.uk
	SHEET 1 OF 1
	P&I DRG No. SI039005_DWG



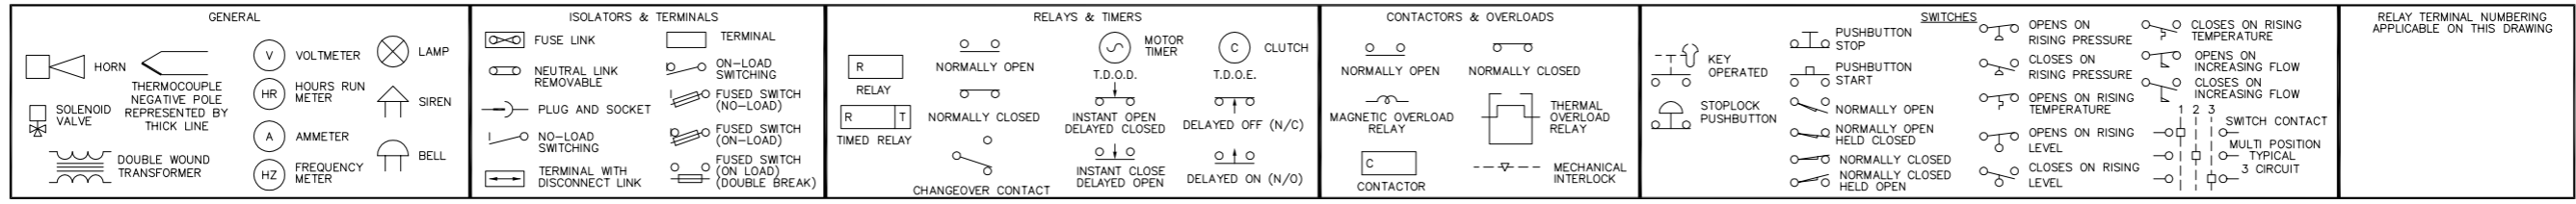

**MUX 3 (NORTH SIDING)**

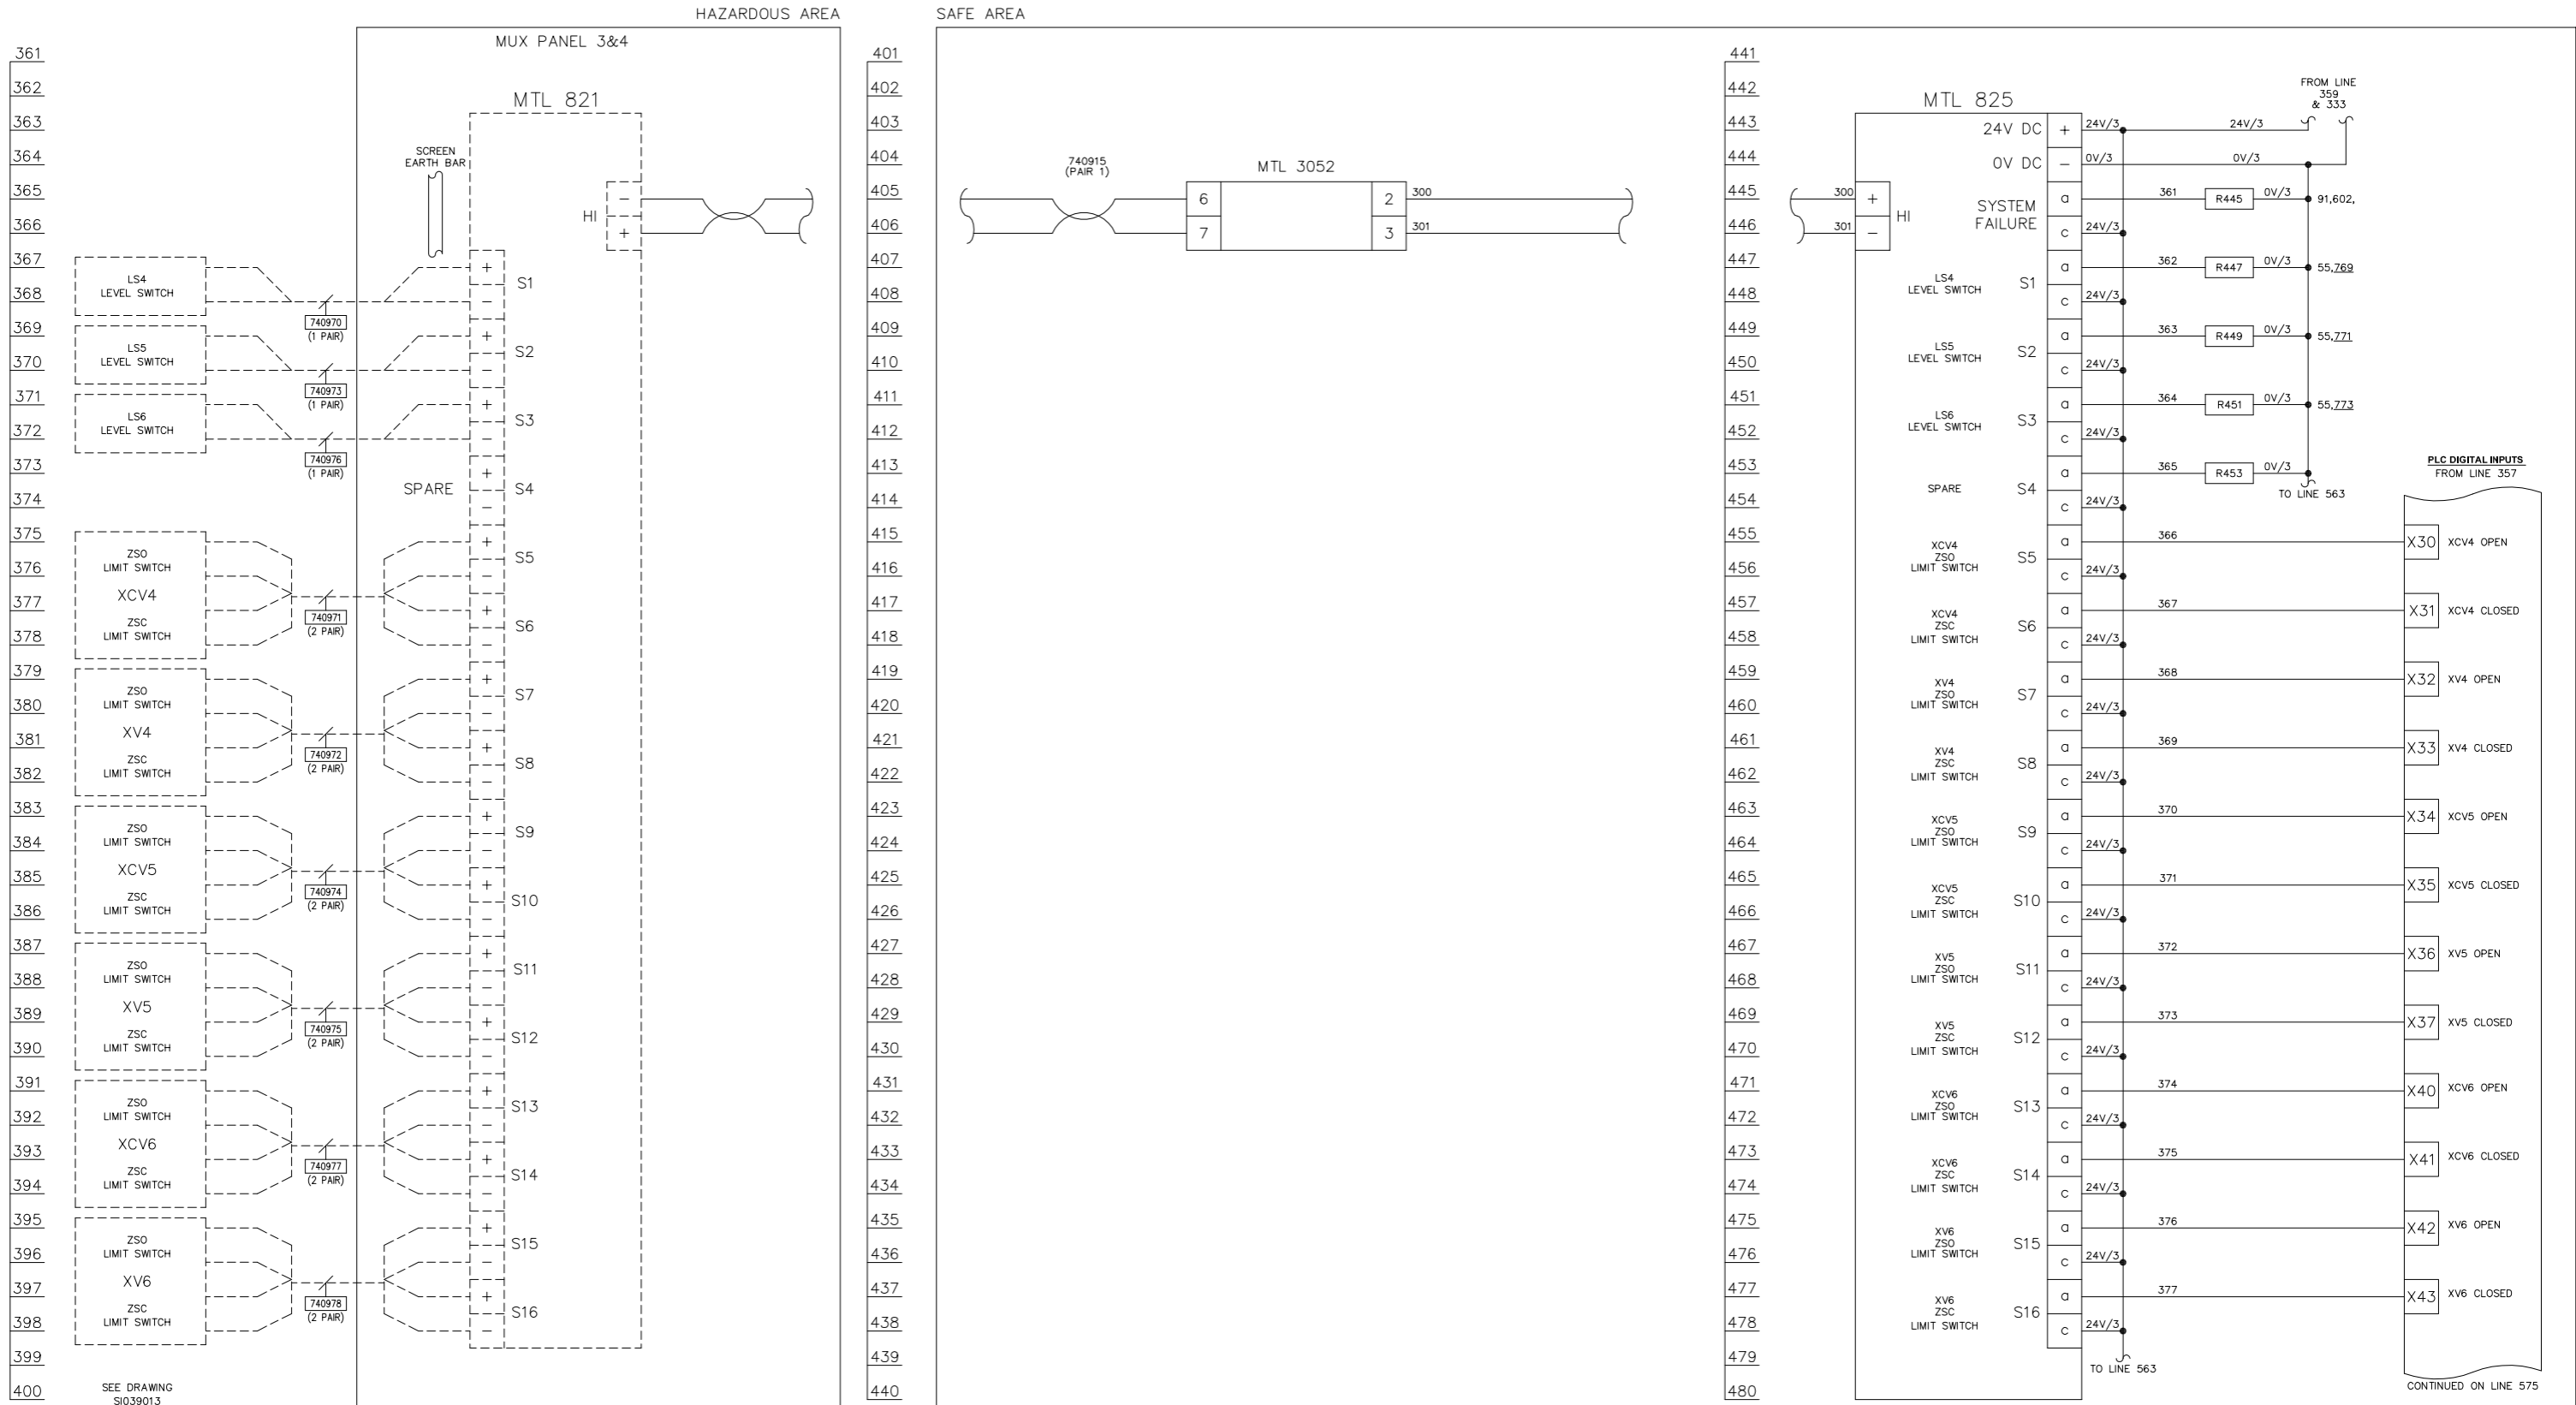

LAST NUMBER USED: 301  
 SPARE TO: 360

LAST NUMBER USED: 377  
 SPARE TO: 399

REV	DATE	BY	DRN	CHK'D	APP'D	DESCRIPTION	PLANT	FINA DERV RAIL LOADING SYSTEM
A	04/03/99	A.J.H.	A.J.H.	P.J.P.	P.J.P.	ORIGINAL ISSUE	LOGIC 4	
B	02/07/99	D.P.	A.J.H.	D.R.R.	D.R.R.	COMMS POLARITY REVERSED		02/07/99

NOTES


IMMINGHAM STORAGE Co Ltd, IMMINGHAM EAST TERMINAL, IMMINGHAM DOCK, IMMINGHAM, SOUTH HUMBERSIDE

**Simon Storage Terminals**


ELECTRICAL SCHEMATIC TEMPLATE SHEET 01 OF 01

CLIENT DRG. No. P&I DRG No. SI039005

LEGEND OF GRAPHICAL SYMBOLS (ALL CONTACTS SHOWN IN THE DE-ENERGISED STATE)

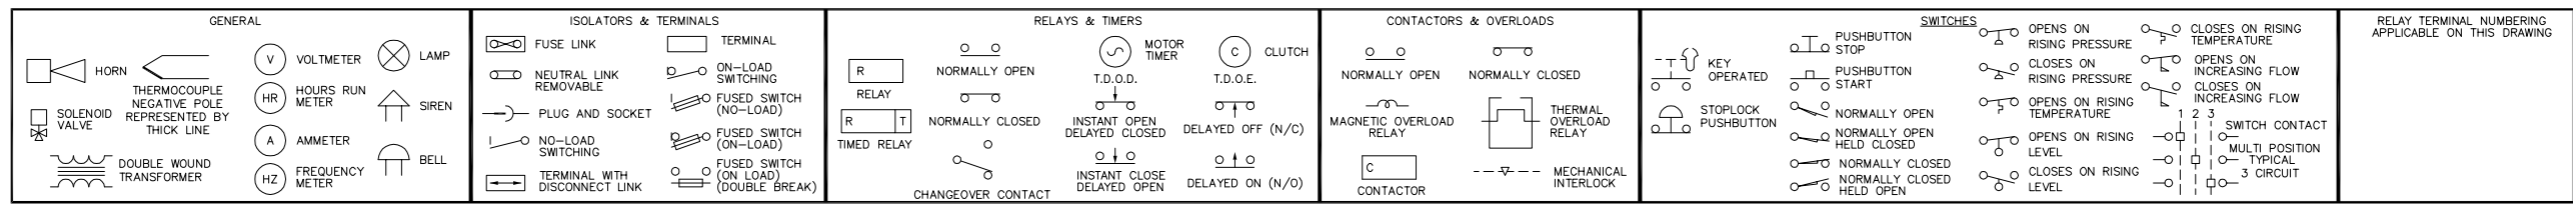

**MUX 4 (SOUTH SIDING)**

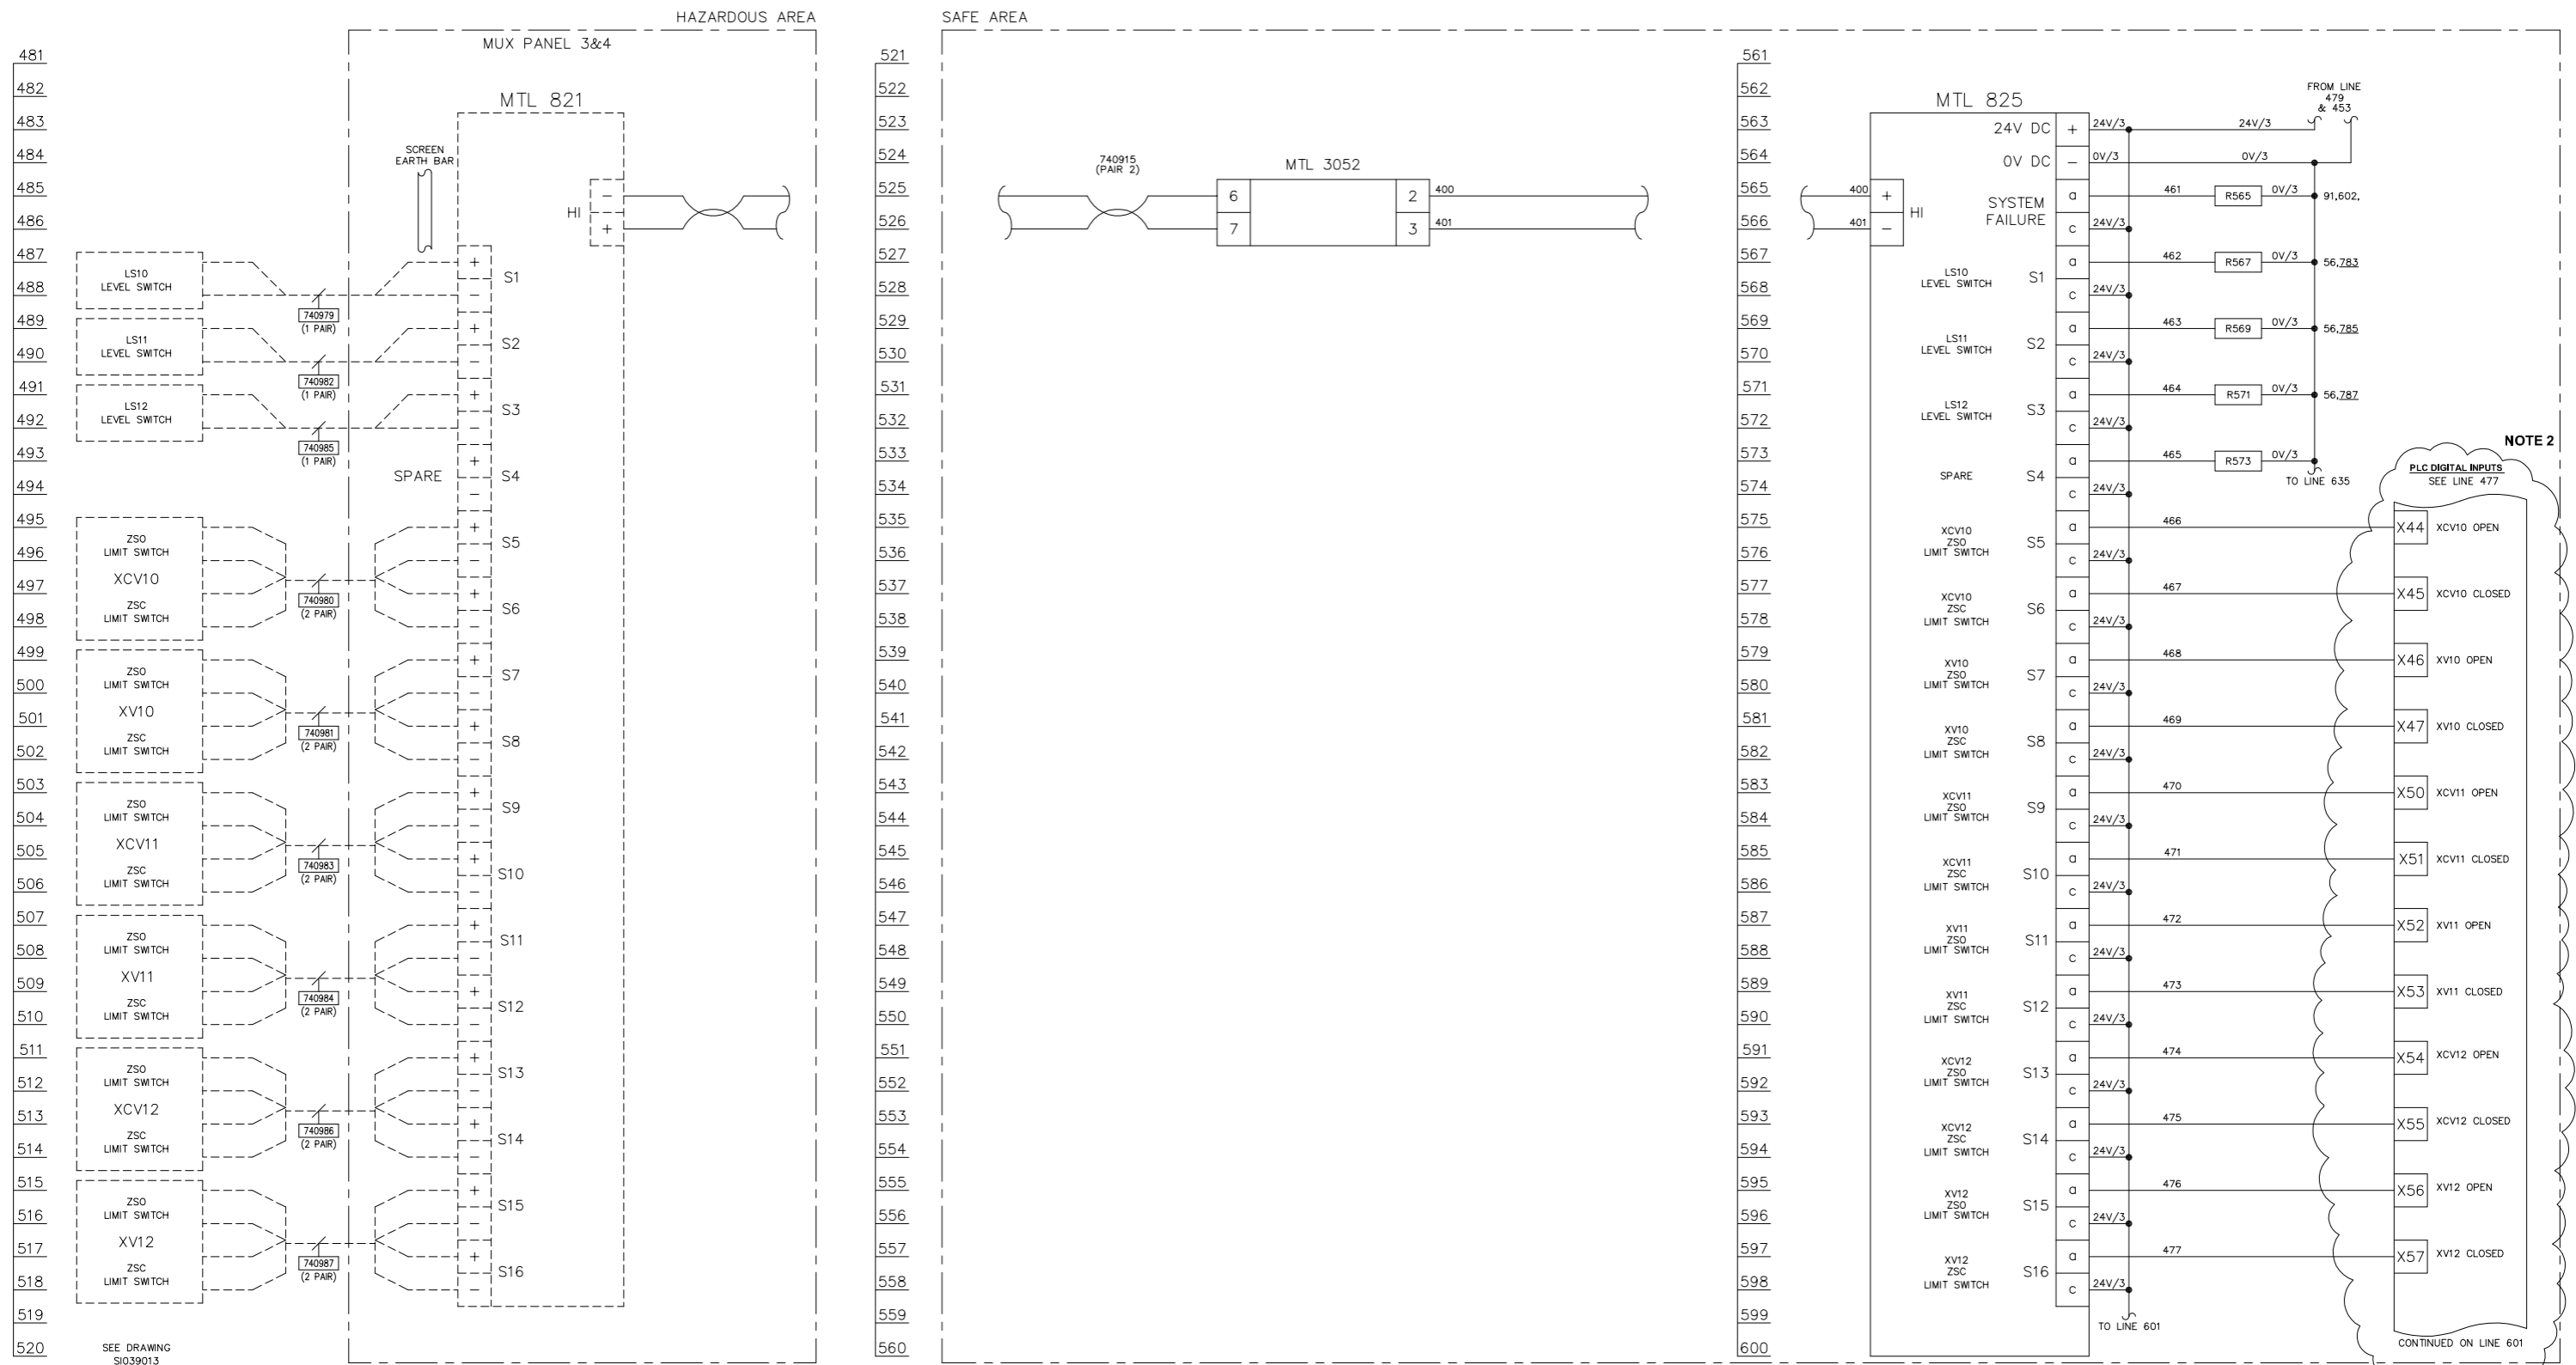

LAST NUMBER USED: 401  
SPARE TO: 460

LAST NUMBER USED: 477  
SPARE TO: 499

- NOTES**  
 1. SCREEN EARTHS NOT SHOWN FOR CLARITY.  
 2. DECOMMISSIONED BATCHING SYSTEM. INPUTS NOT USED IN PLC




IF NOT SIGNED THIS DOCUMENT IS UNCONTROLLED


REV	DATE	BY	DRN	CHK'D	APP'D	DESCRIPTION
A	11/03/99	A.J.H.	A.J.H.	P.J.P.	P.J.P.	D.R.R. ORIGINAL ISSUE
B	07/07/99	D.P.	A.J.H.	D.R.R.	D.R.R.	COMMS POLARITY REVERSED
C	14/09/10	D.B.F.	P.P.	M.M.	M.M.	SI760 MODIFICATIONS

PLANT	IMMINGHAM STORAGE Co. - EAST TERMINAL
TITLE	4-EAST RAIL LOADING SYSTEM PANEL LOGIC DRAWING 5
CLIENT DRG. No.	IMMINGHAM STORAGE Co. Ltd. IMMINGHAM EAST TERMINAL, IMMINGHAM DOCK, IMMINGHAM, SOUTH HUMBERSIDE
	<b>P &amp; I DESIGN</b> P & I Design Ltd Tel. 01642 617444 www.ptdesign.co.uk
	SHEET 1 OF 1
	P&I DRG No. SI039006_DWG

LEGEND OF GRAPHICAL SYMBOLS (ALL CONTACTS SHOWN IN THE DE-ENERGISED STATE)

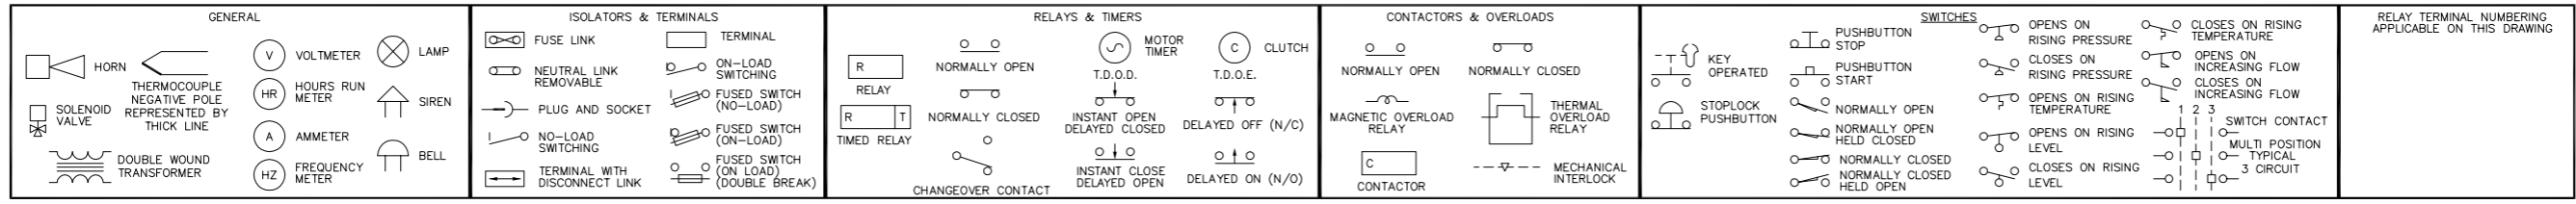

**MUX 4 (SOUTH SIDING)**

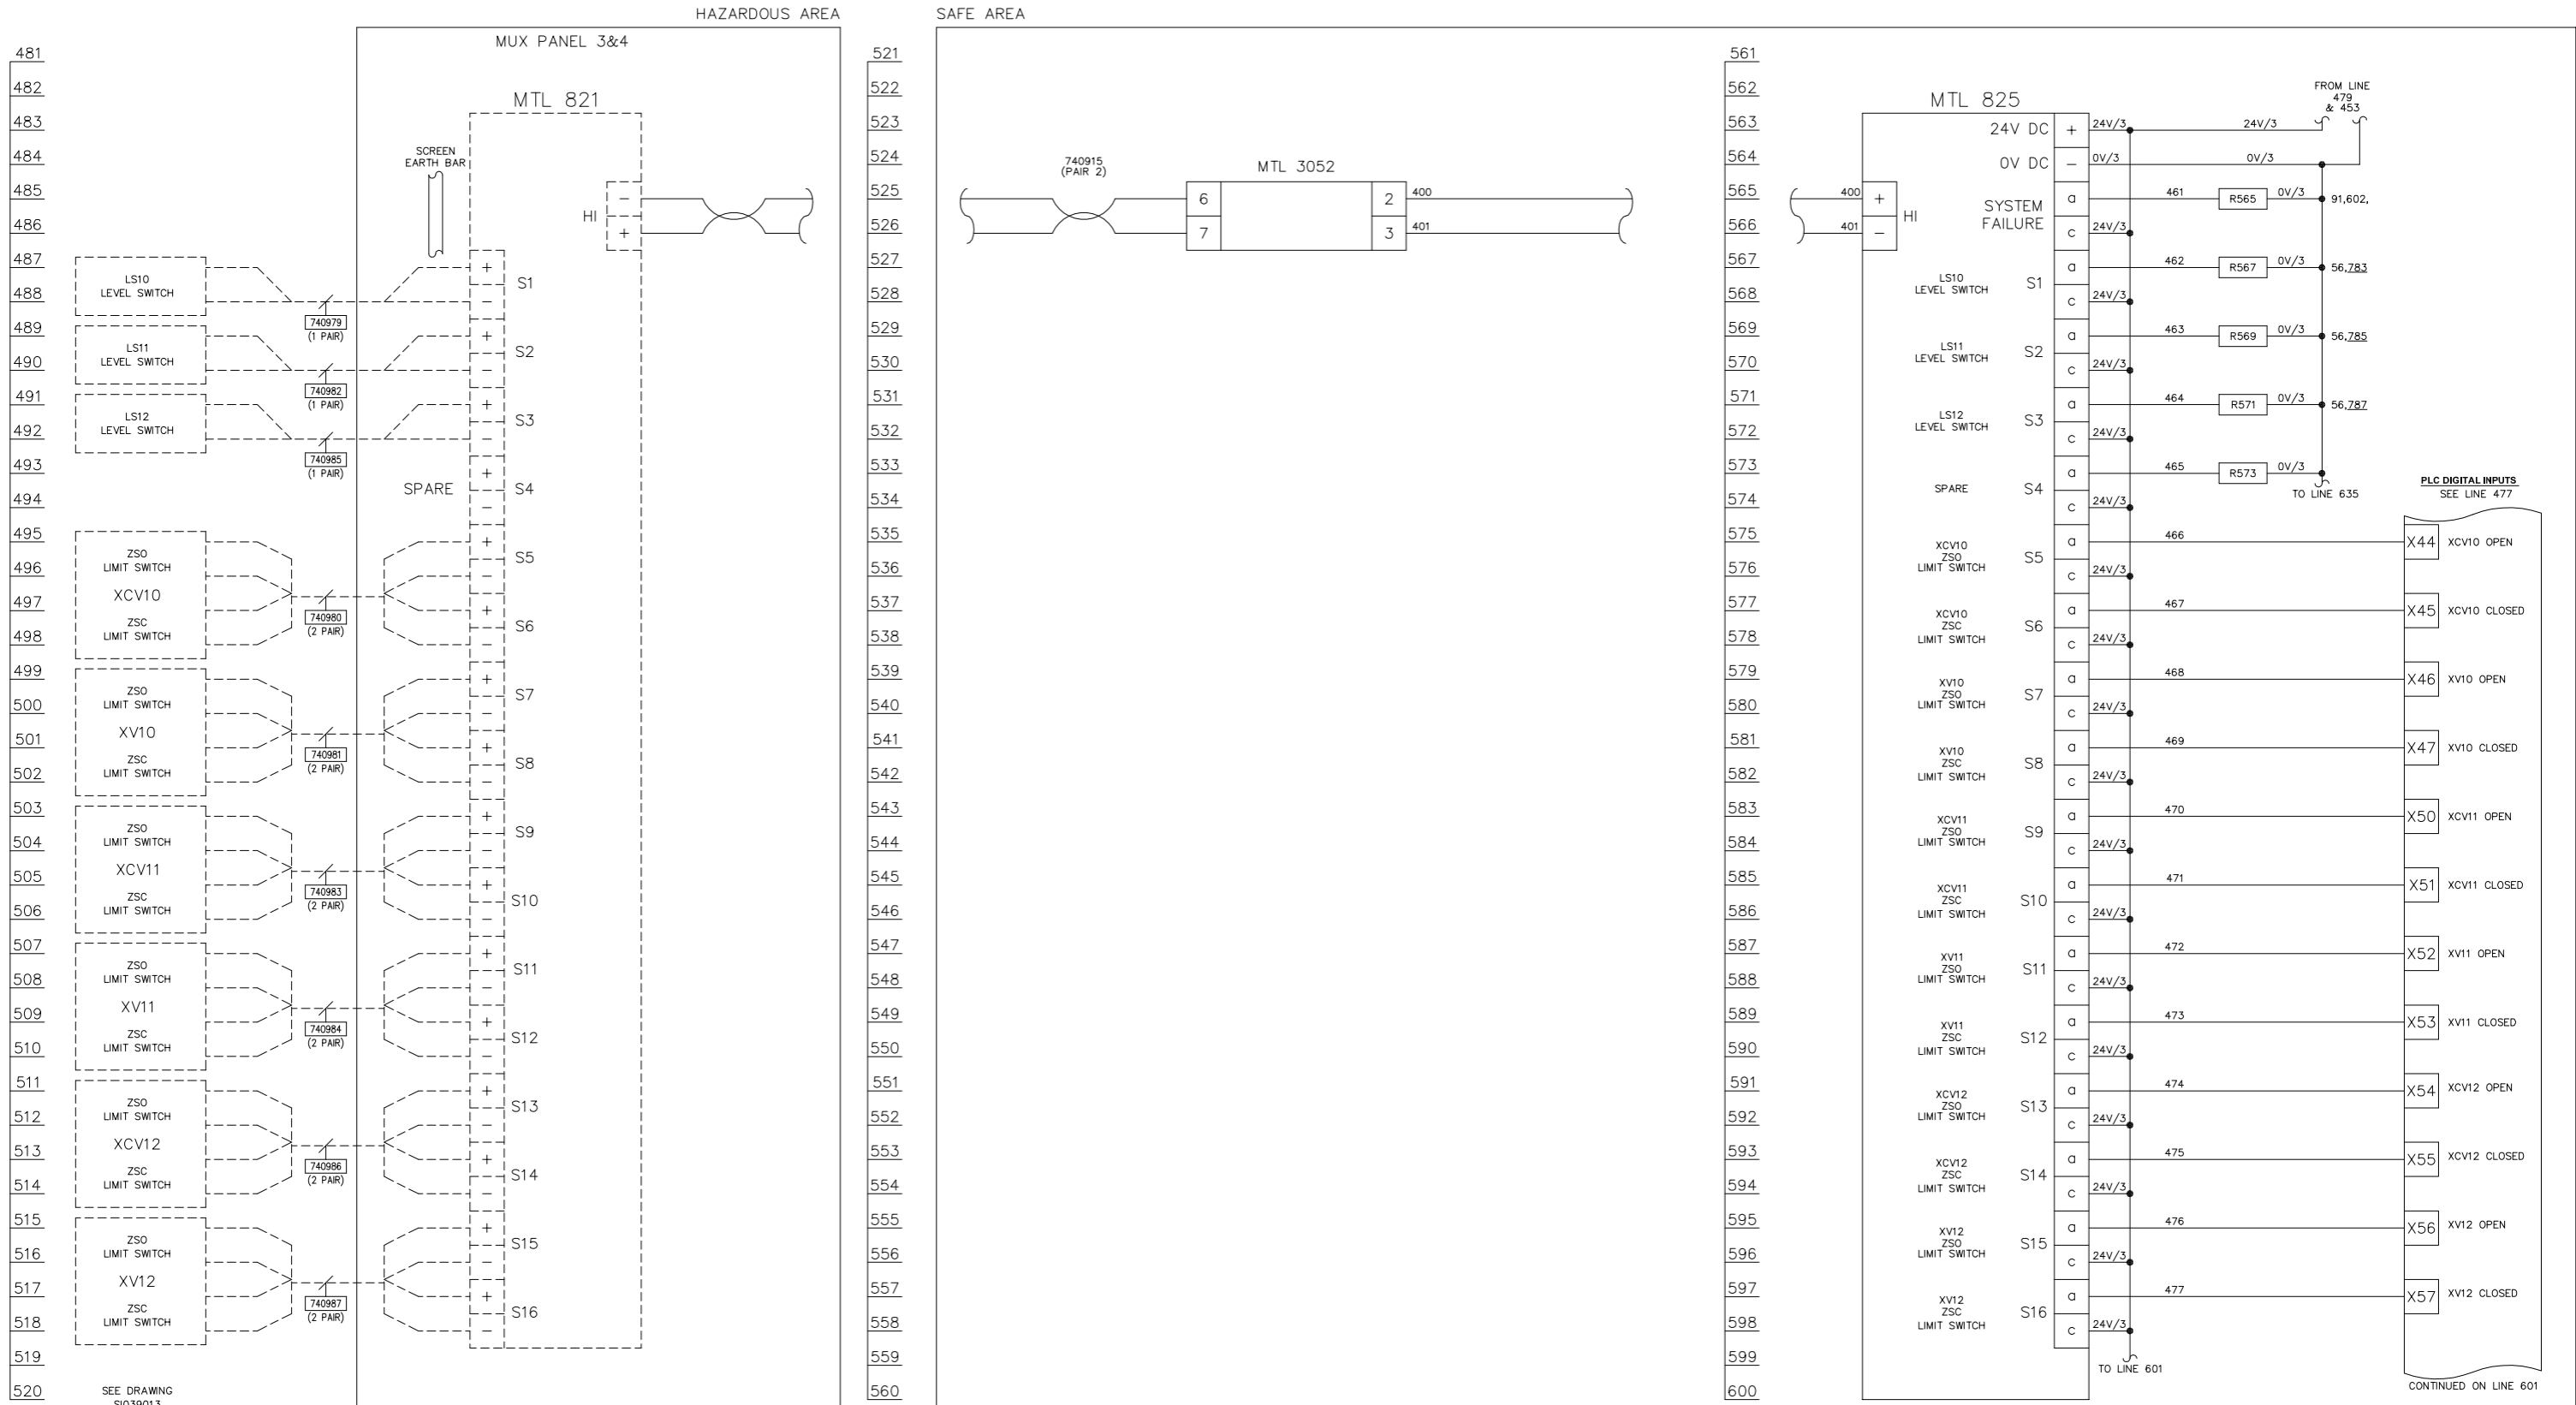


LAST NUMBER USED: 401  
 SPARE TO: 460

LAST NUMBER USED: 477  
 SPARE TO: 499


REV	DATE	BY	DRN	CHK'D	APP'D	DESCRIPTION	PLANT	FINA DERV RAIL LOADING SYSTEM
A	11/03/99	A.J.H	A.J.H	P.J.P	P.J.P	ORIGINAL ISSUE	Storage	LOGIC 5
B	02/07/99	D.P.	A.J.H	D.R.R	D.R.R	COMMS POLARITY REVERSED		

CLIENT DRG. No. P&I DRG No. SI039006


LEGEND OF GRAPHICAL SYMBOLS (ALL CONTACTS SHOWN IN THE DE-ENERGISED STATE)

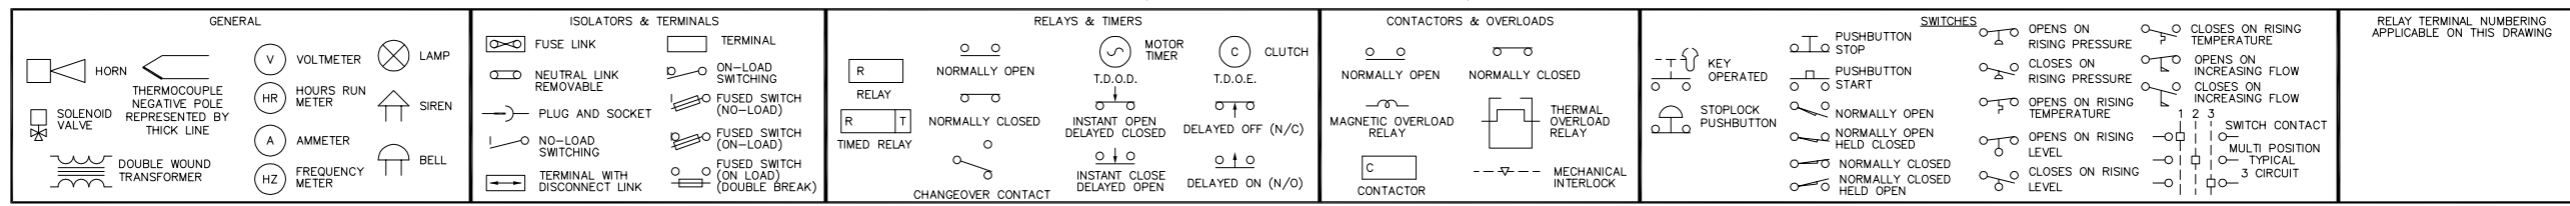


PLC DIGITAL INPUTS

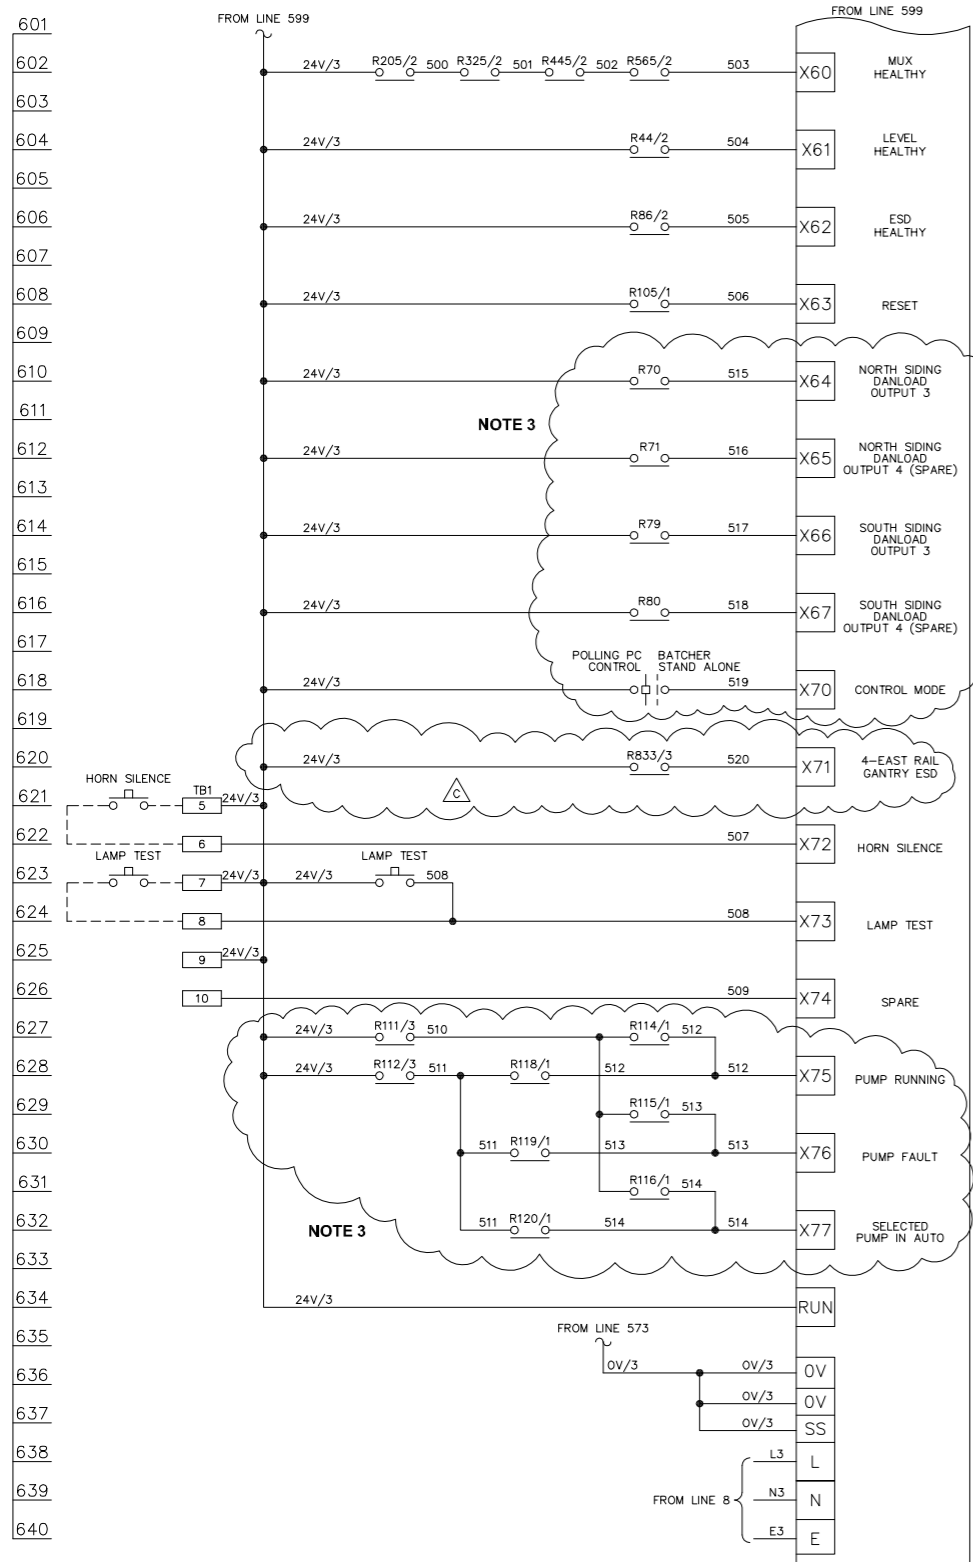

PLC DIGITAL OUTPUTS

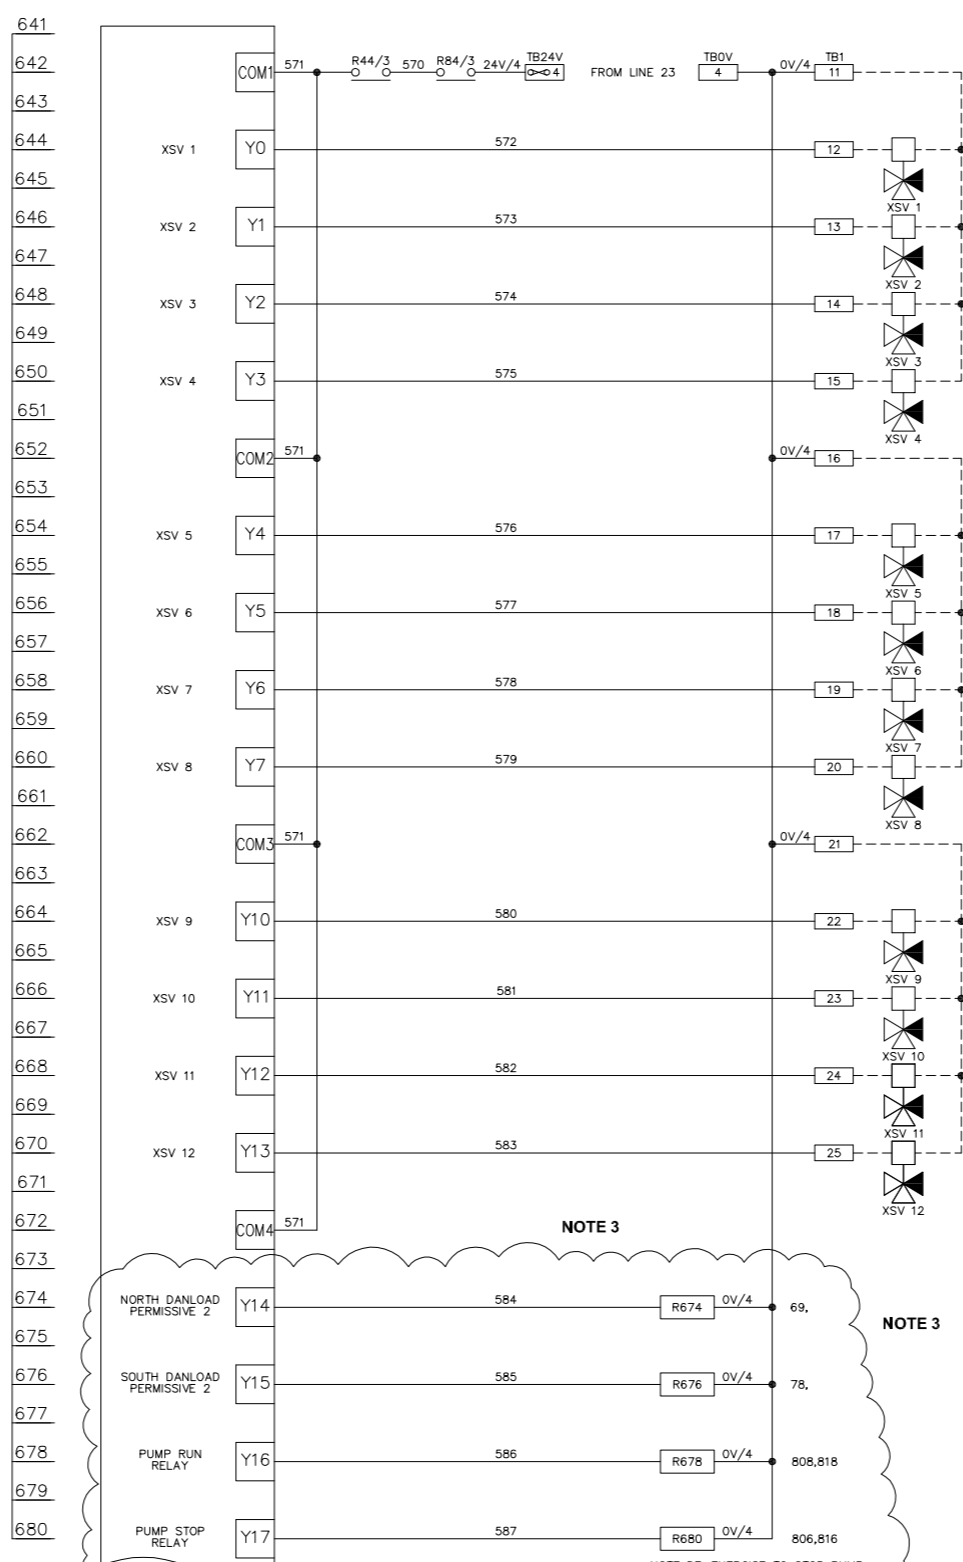


PLC DIGITAL OUTPUTS

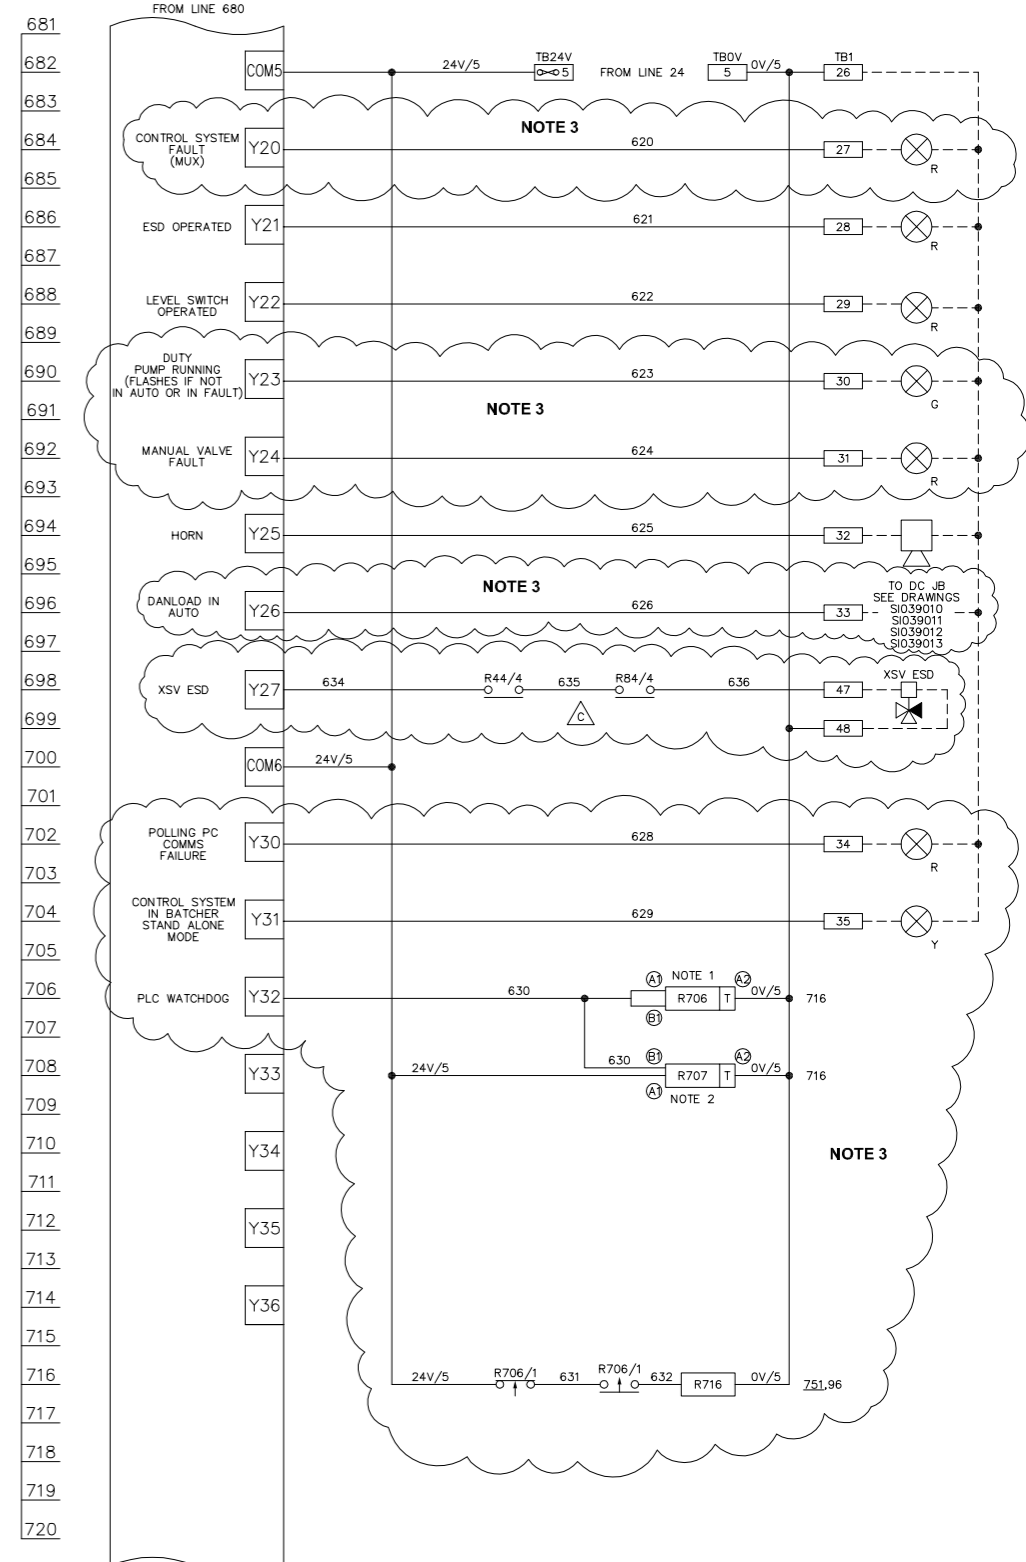


- NOTES
1. TIMER RELAY OMRON M3DE-M1 MODE A SET @ 1 SEC.
  2. TIMER RELAY OMRON M3DE-M1 MODE D SET @ 1 SEC
  3. DECOMMISSIONED BATCHING SYSTEM. INPUTS NOT USED IN PLC



IF NOT SIGNED THIS DOCUMENT IS UNCONTROLLED							PLANT	
REV	DATE	BY	DRN	CHK'D	APP'D	DESCRIPTION	IMMINGHAM STORAGE Co. - EAST TERMINAL	
A	07/04/99	A.J.H.	A.J.H.	D.R.R.	D.R.R.	D.R.R.	4-EAST RAIL LOADING SYSTEM	
B	02/07/99	D.P.	A.J.H.	D.R.R.	D.R.R.	D.R.R.	PANEL LOGIC DRAWING 6	
C	14/09/10	D.B.F.	P.P.	M.M.	M.M.	M.M.	PANEL TEST MODS	
							SI760 MODIFICATIONS	
							CLIENT DRG. No.	

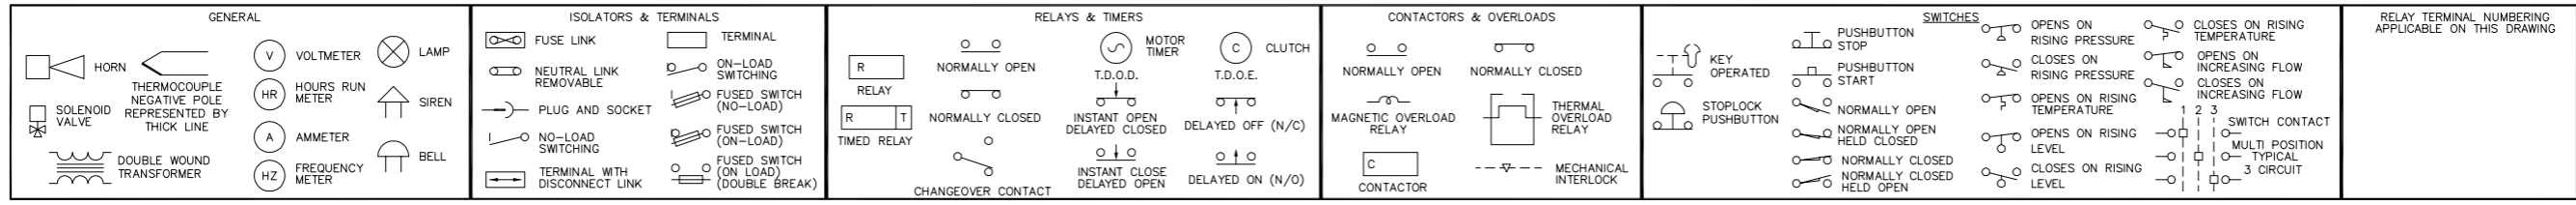


**PLC DIGITAL INPUTS**

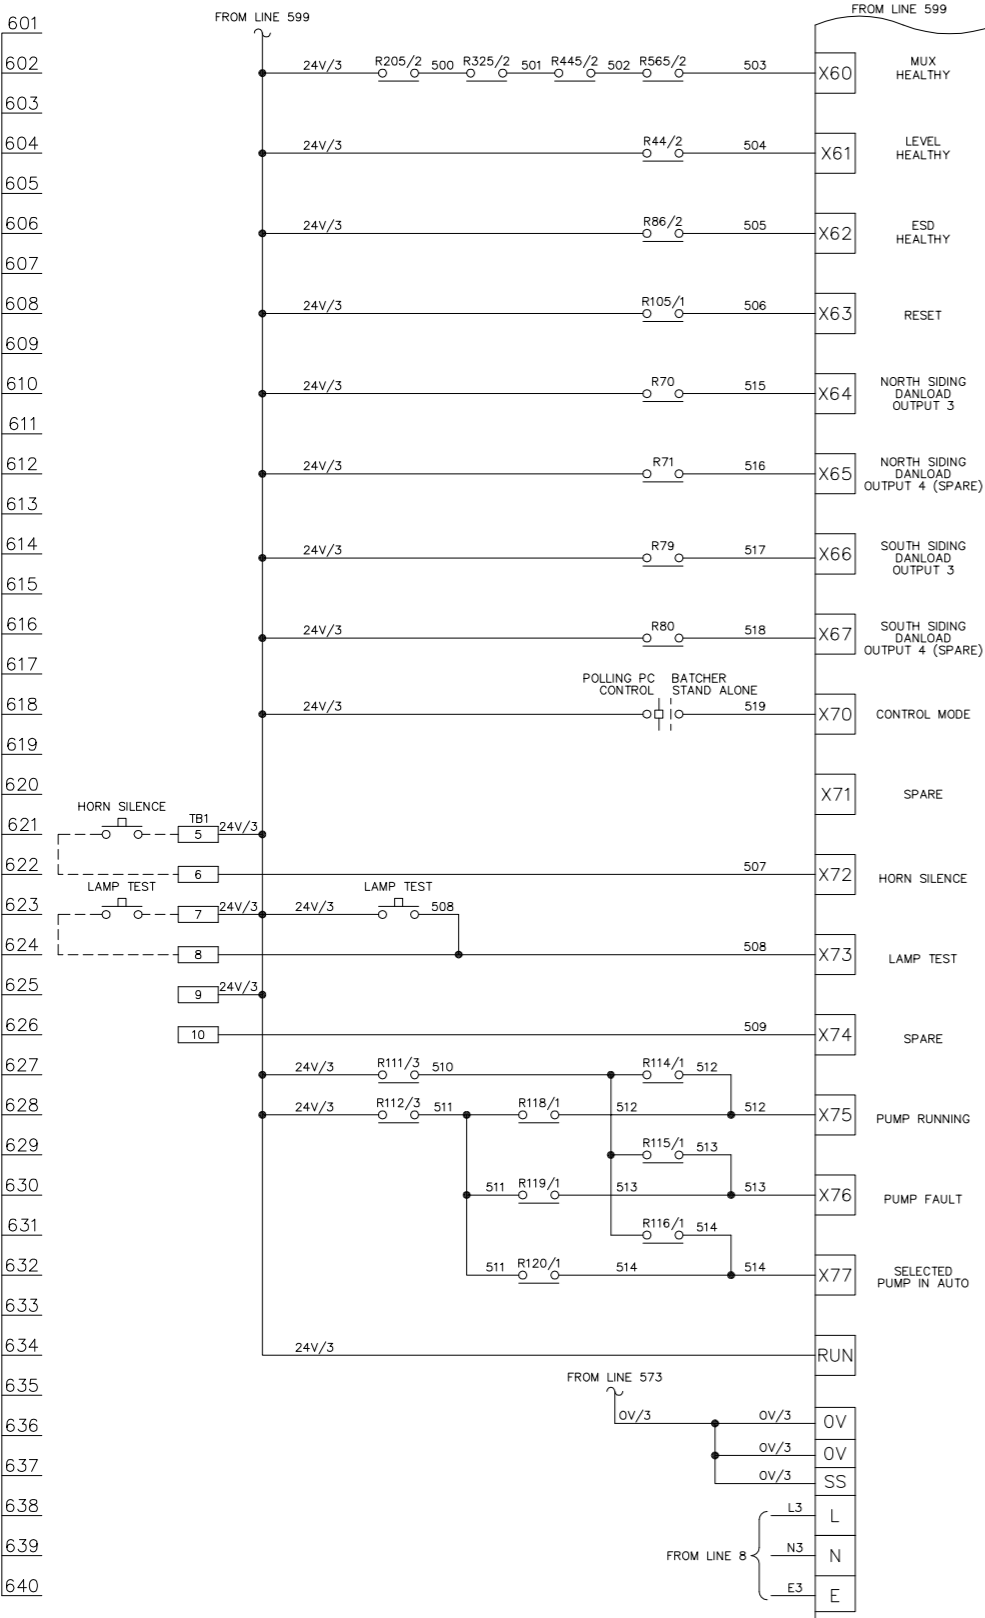

LAST NUMBER USED: 514  
 SPARE TO: 569


**PLC DIGITAL OUTPUTS**

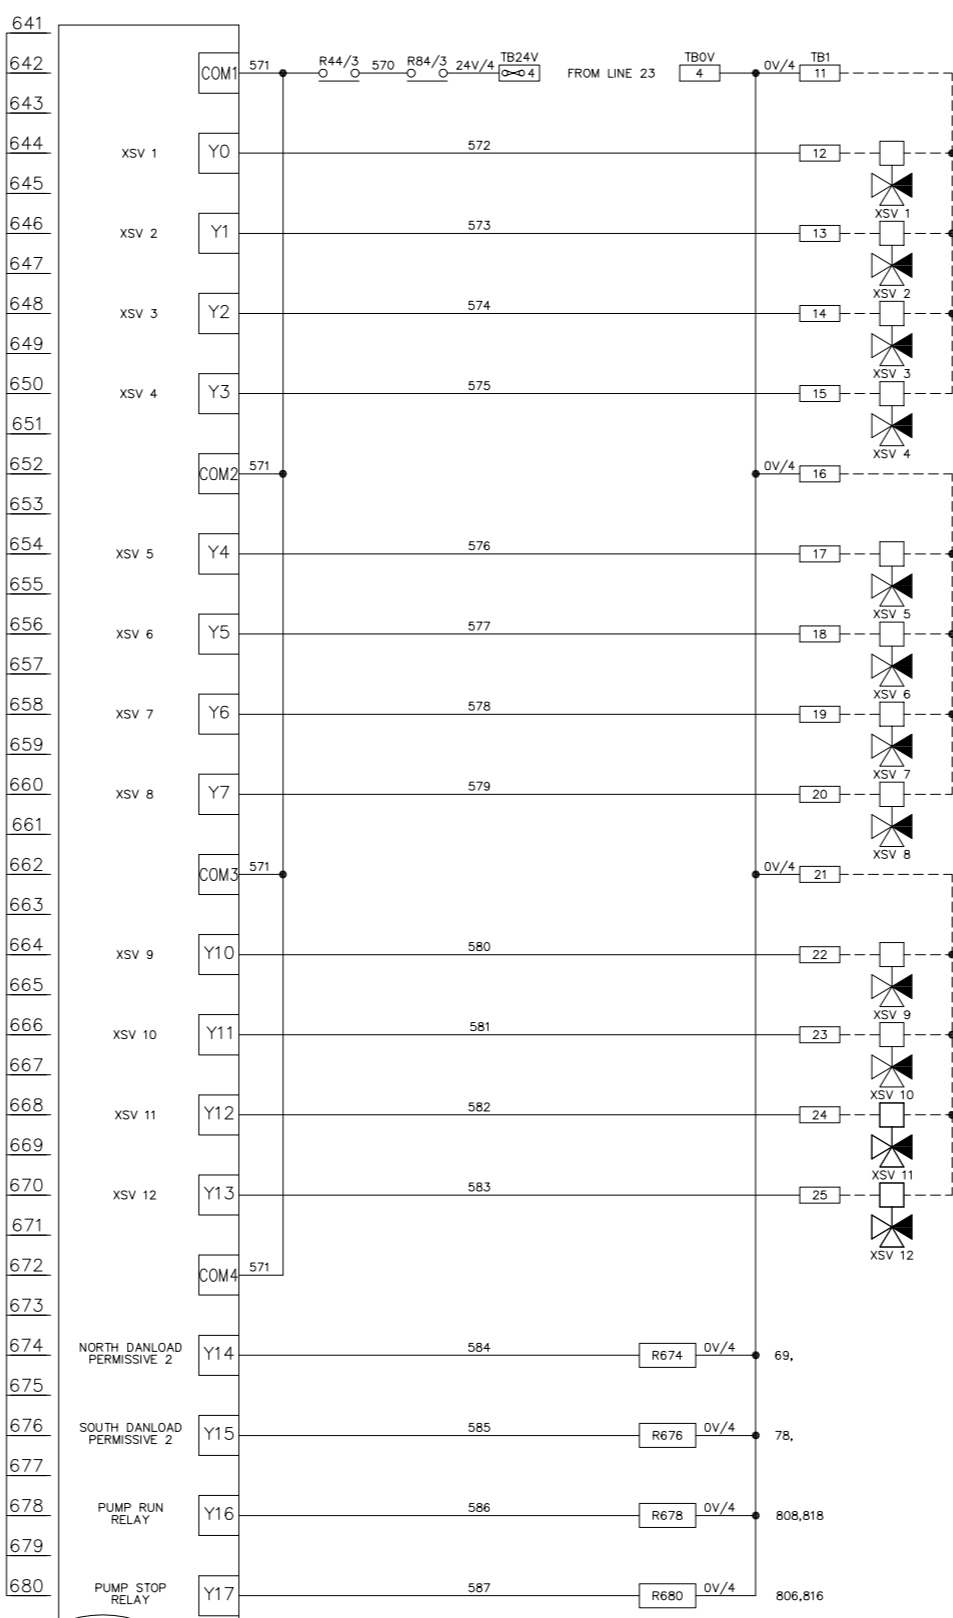

LAST NUMBER USED: 587  
 SPARE TO: 619

NOTE DE-ENERGISE TO STOP PUMP

**PLC DIGITAL OUTPUTS**

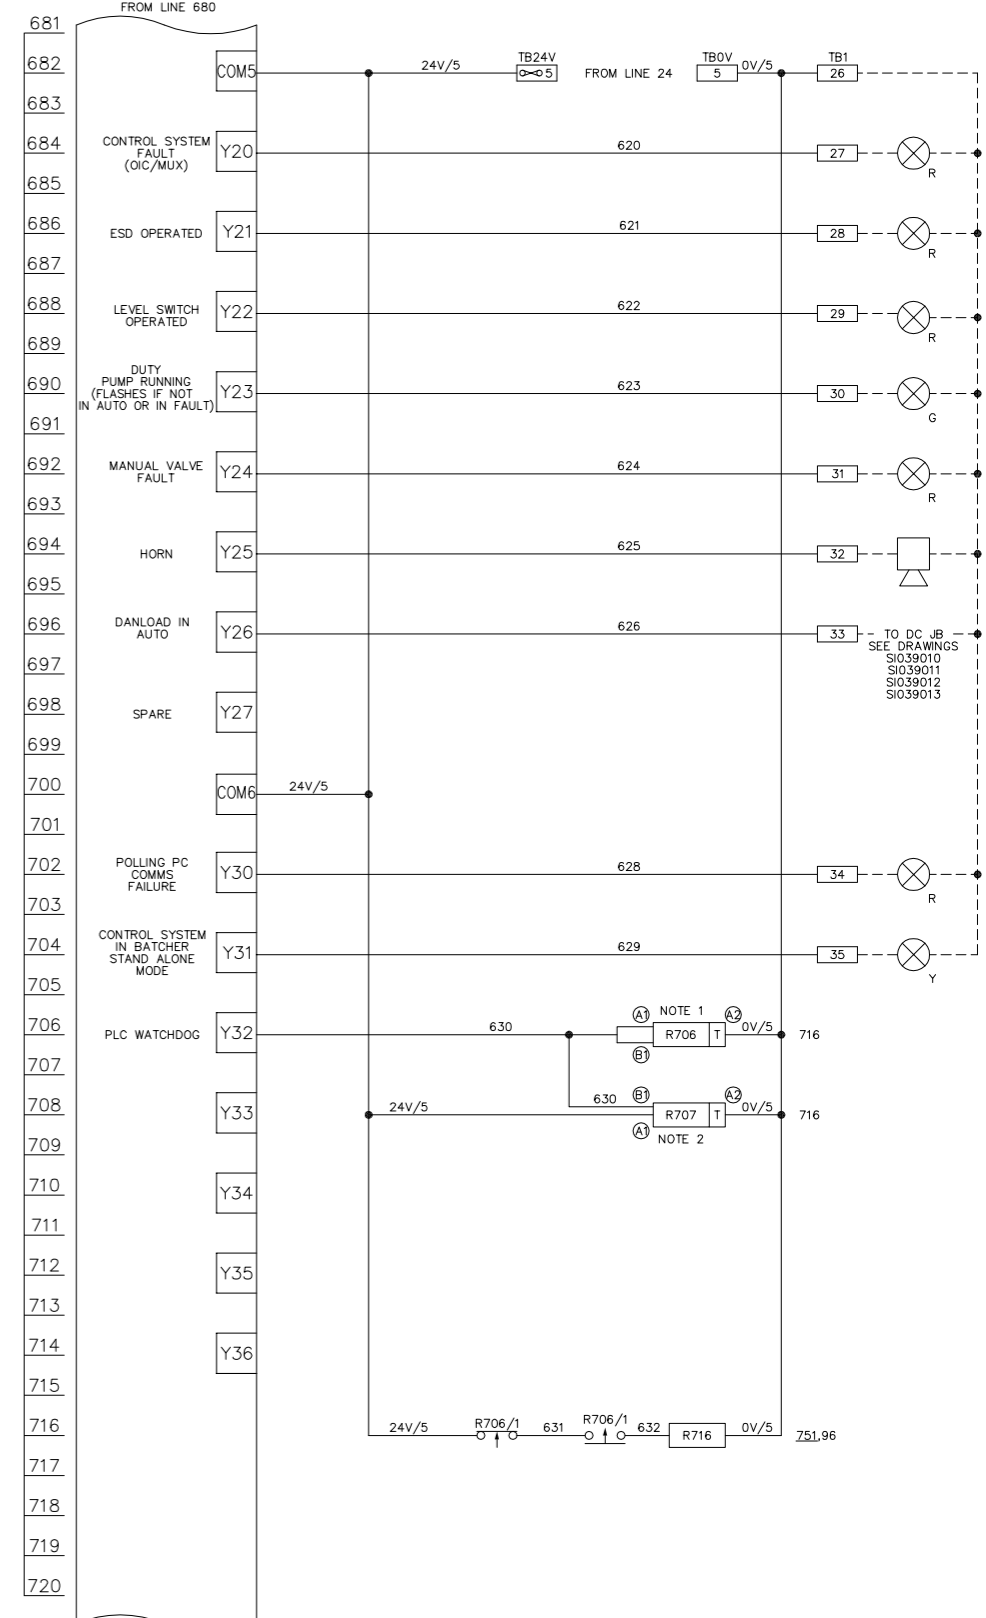

LAST NUMBER USED: 633  
 SPARE TO: 679

- NOTES**  
 1. TIMER RELAY OMRON M3DE-M1 MODE A SET @ 1 SEC  
 2. TIMER RELAY OMRON M3DE-M1 MODE D SET @ 1 SEC

REV	DATE	BY	DRN	CHK'D	APP'D	DESCRIPTION	PLANT	FINA DERV RAIL LOADING SYSTEM
A	07/04/99	A.J.H	A.J.H	D.R.R	D.R.R	ORIGINAL ISSUE	TITLE	LOGIC 6
B	02/07/99	D.P.	A.J.H	D.R.R	D.R.R	PANEL TEST MODS		


02/07/99

**Simon** **Terminal** IMMINGHAM STORAGE Co Ltd, IMMINGHAM EAST TERMINAL, IMMINGHAM DOCK, IMMINGHAM, SOUTH HUMBERSIDE


ELECTRICAL SCHEMATIC TEMPLATE SHEET 1 OF 01

CLIENT DRG. No. P&I DRG No. SI039007

LEGEND OF GRAPHICAL SYMBOLS (ALL CONTACTS SHOWN IN THE DE-ENERGISED STATE)

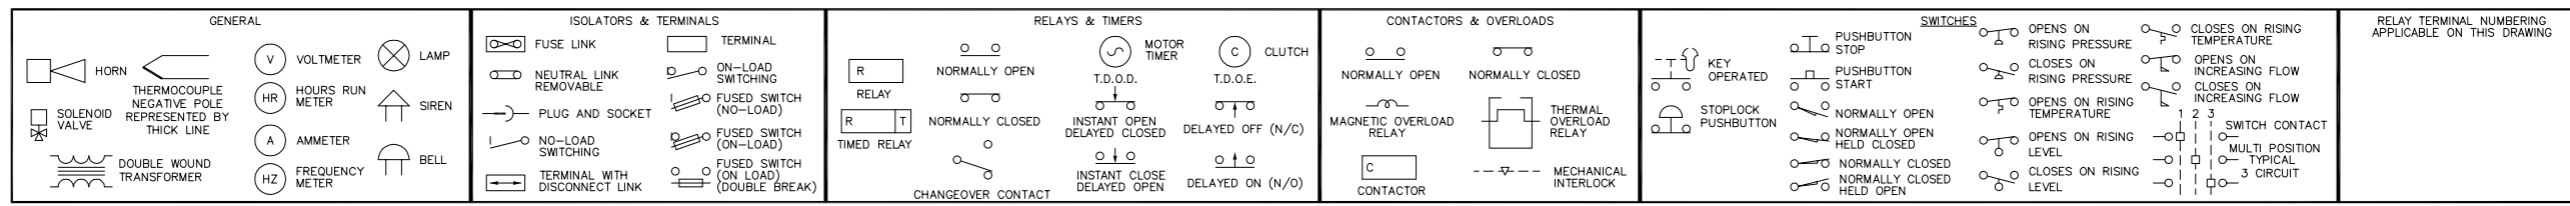

PLC DIGITAL OUTPUTS

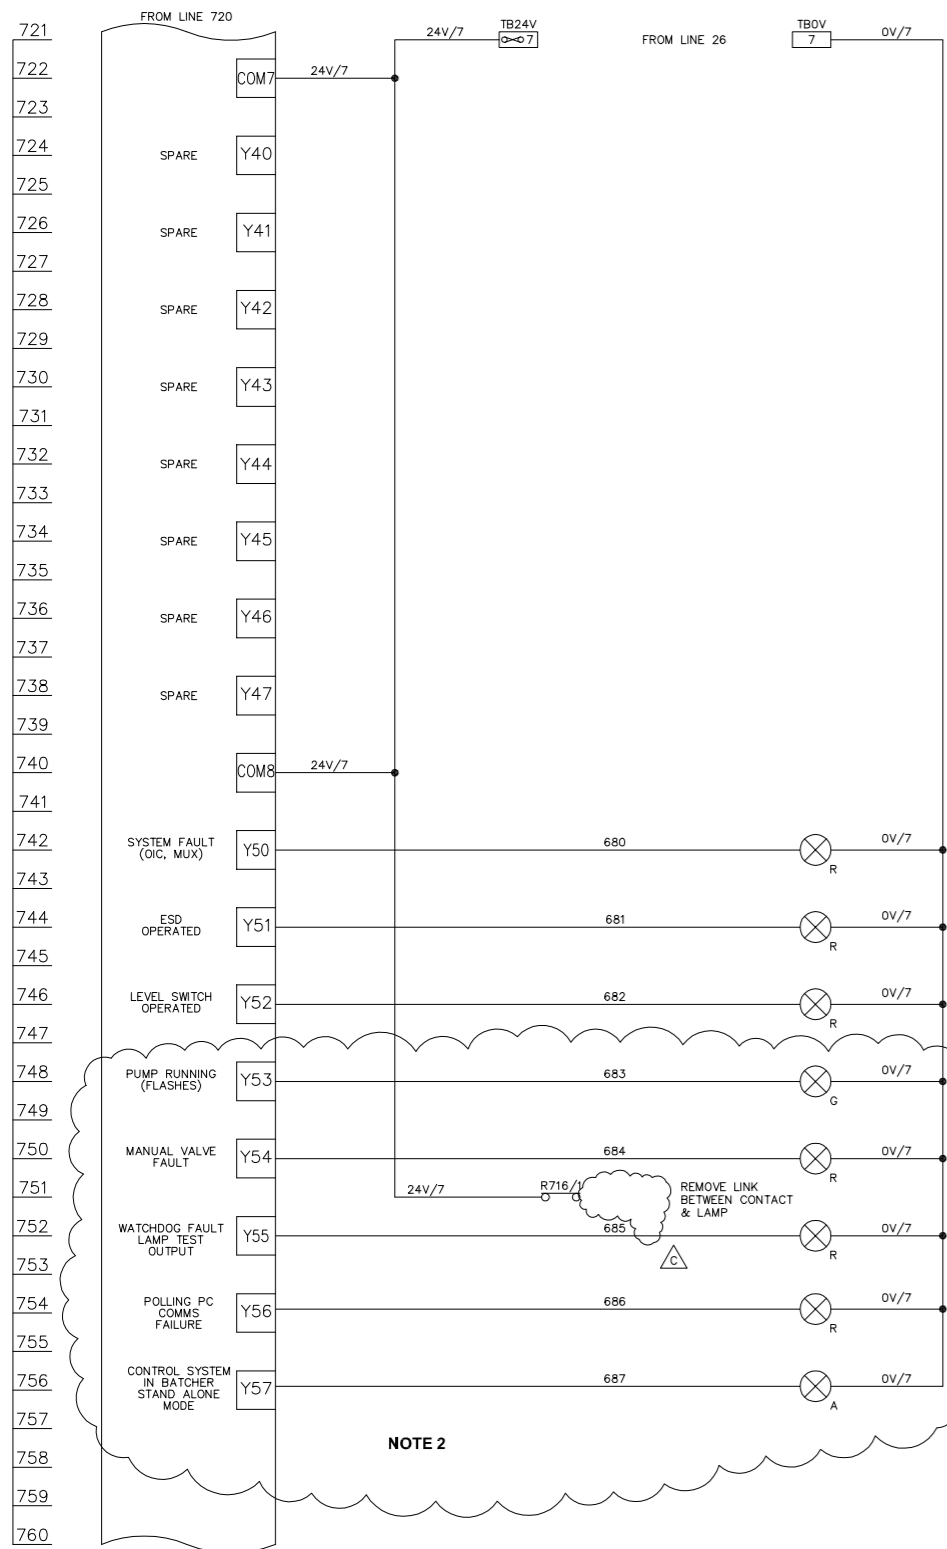


NOTE 2

LAST NUMBER USED: 687  
 SPARE TO: 749


CONTINUED ON LINE 761

PLC DIGITAL OUTPUTS

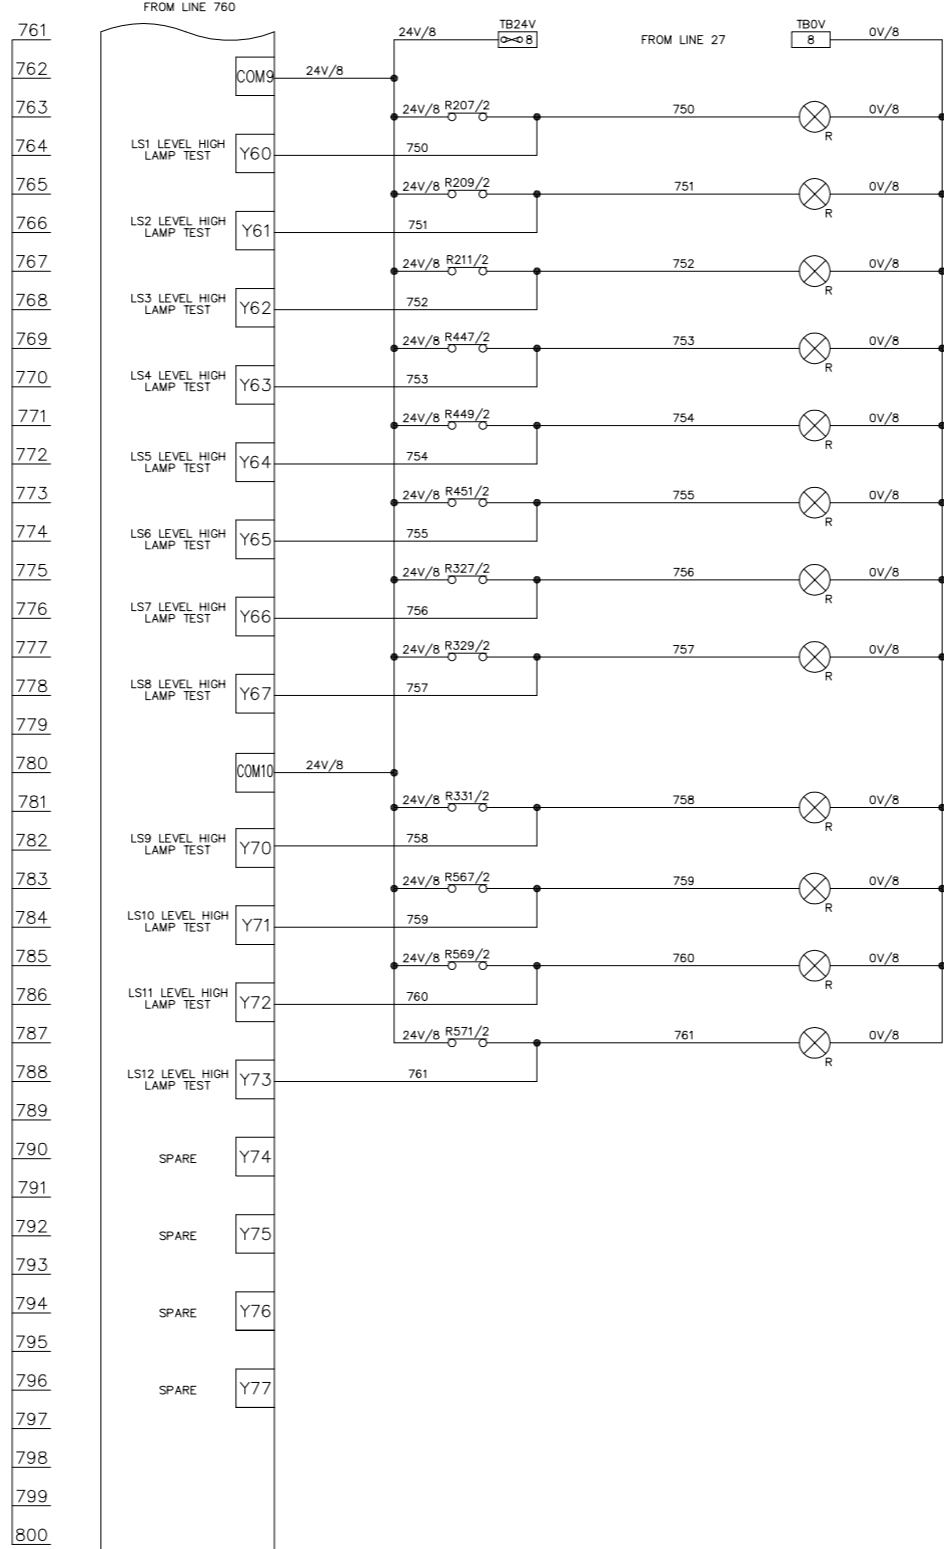

LAST NUMBER USED: 761  
 SPARE TO: 849

PUMP CONTROLS (240V)

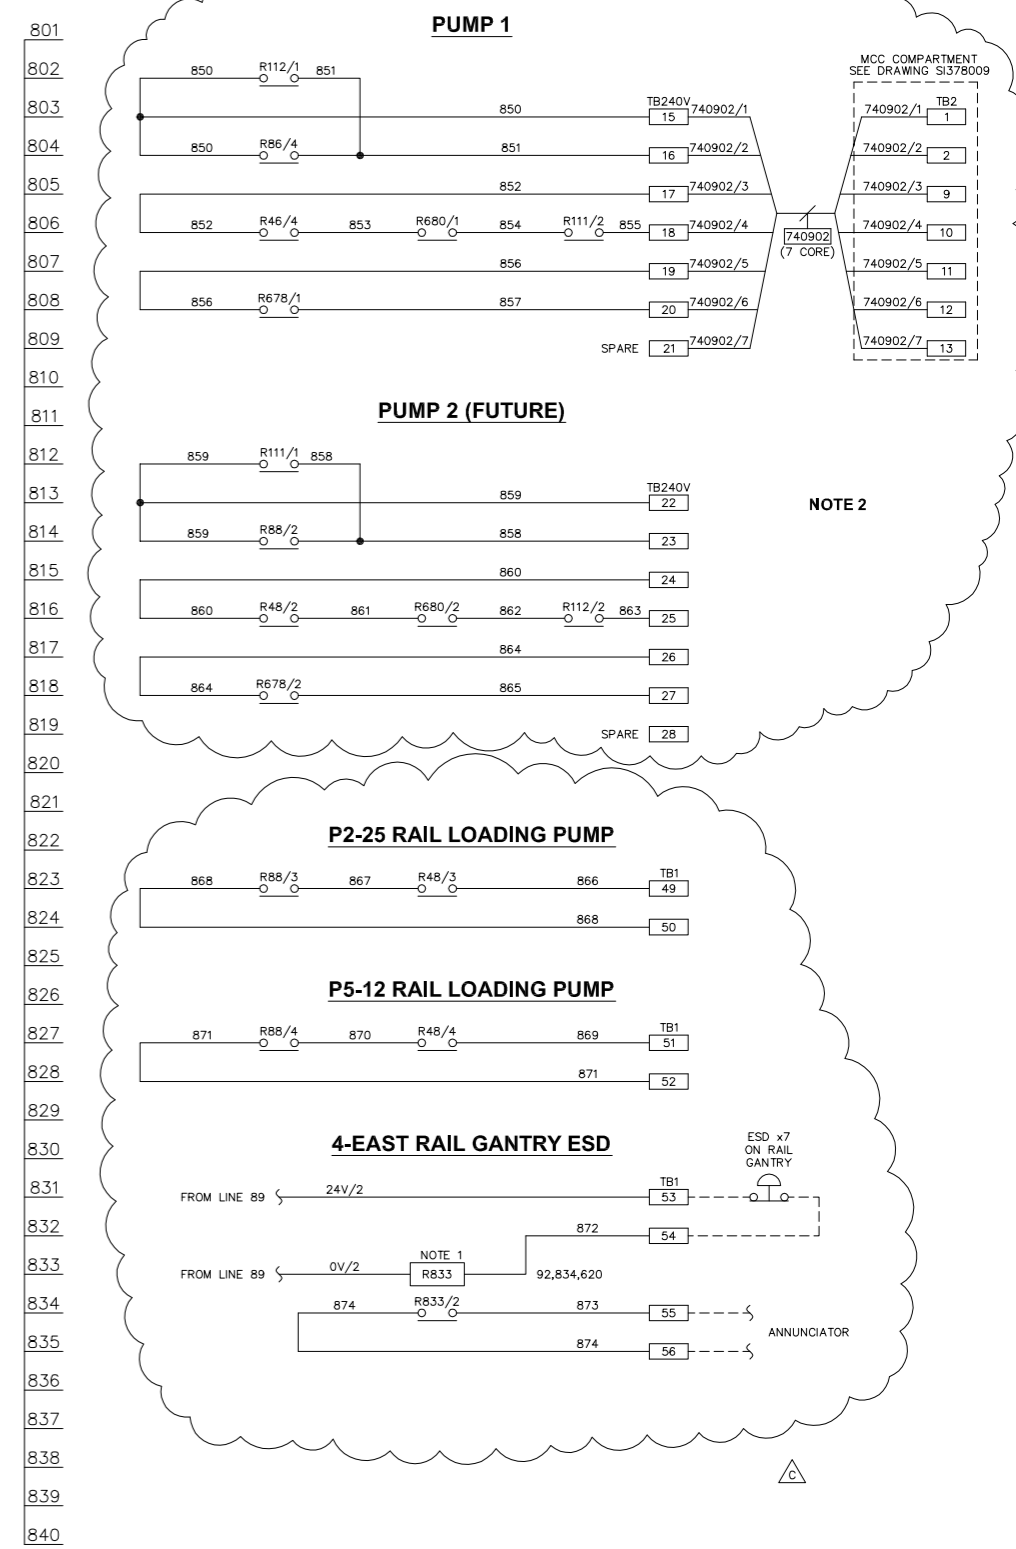

NOTE 2

LAST NUMBER USED: 874  
 SPARE TO: 899


NOTES  
 1. OMRON G7S-4A2B GUIDED CONTACT RELAY (RS260-4373).  
 2. DECOMMISSIONED BATCHING SYSTEM. INPUTS NOT USED IN PLC




IF NOT SIGNED THIS DOCUMENT IS UNCONTROLLED							PLANT	IMMINGHAM STORAGE Co. - EAST TERMINAL
REV	DATE	BY	DRN	CHK'D	APP'D	DESCRIPTION	TITLE	4-EAST RAIL LOADING SYSTEM PANEL LOGIC DRAWING 7
A	07/04/99	A.J.H	A.J.H	D.R.R	D.R.R	D.R.R	ORIGINAL ISSUE	
B	02/07/99	D.P.	A.J.H	D.R.R	D.R.R	D.R.R	PANEL TEST MODS	
C	14/09/10	D.B.F	P.P.	M.M.	M.M.		SI760 MODIFICATIONS	
							CLIENT DRG. No.	P&I DRG No. SI039008_DWG

P & I DESIGN Ltd  
 Tel. 01642 617444  
 www.pidesign.co.uk


LEGEND OF GRAPHICAL SYMBOLS (ALL CONTACTS SHOWN IN THE DE-ENERGISED STATE)

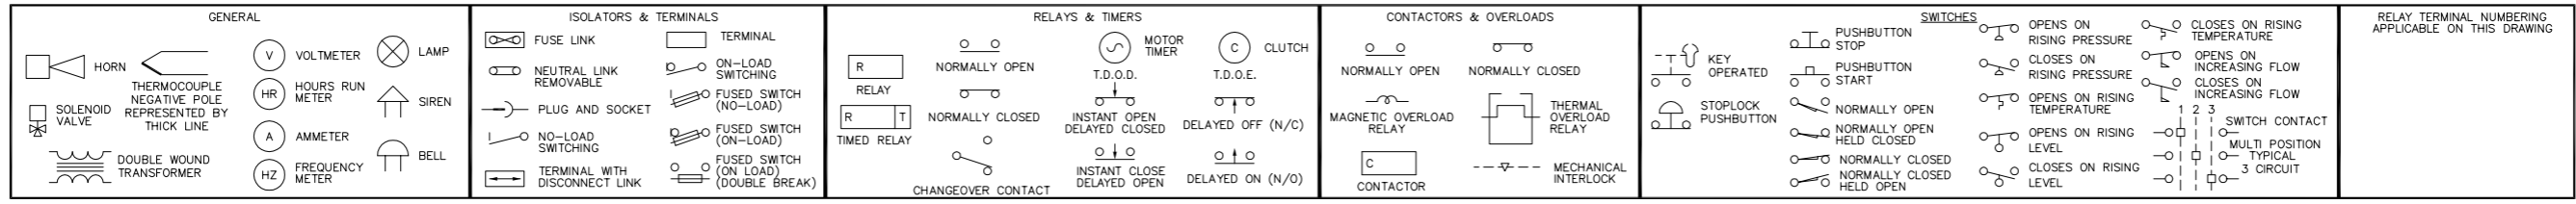


PLC DIGITAL OUTPUTS

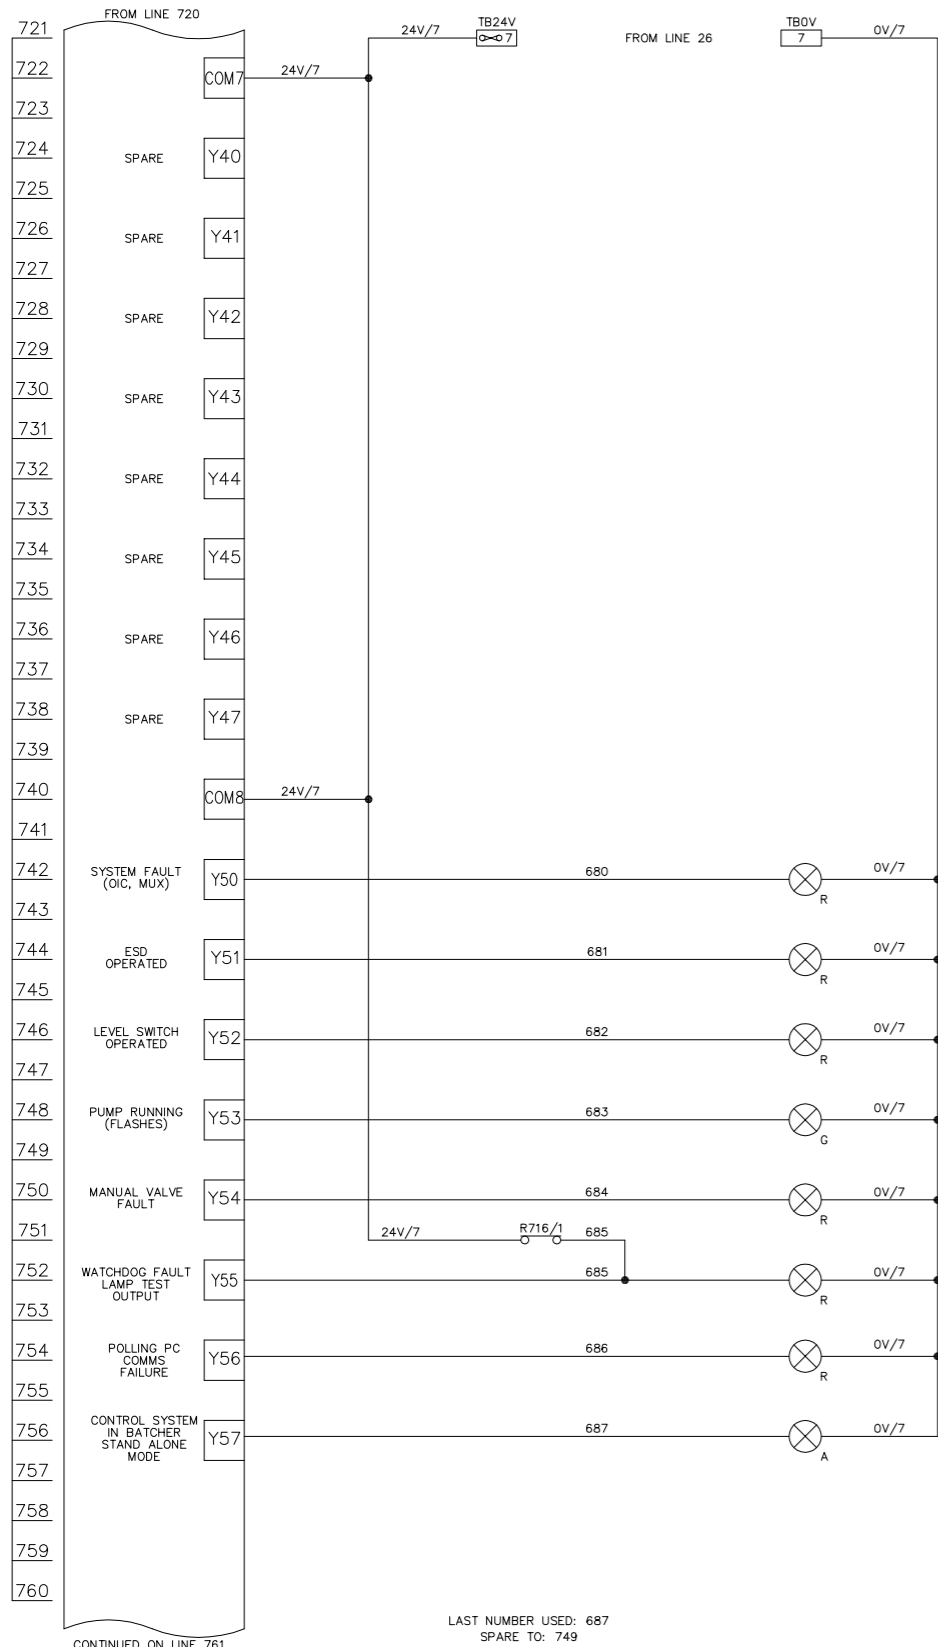

PLC DIGITAL OUTPUTS

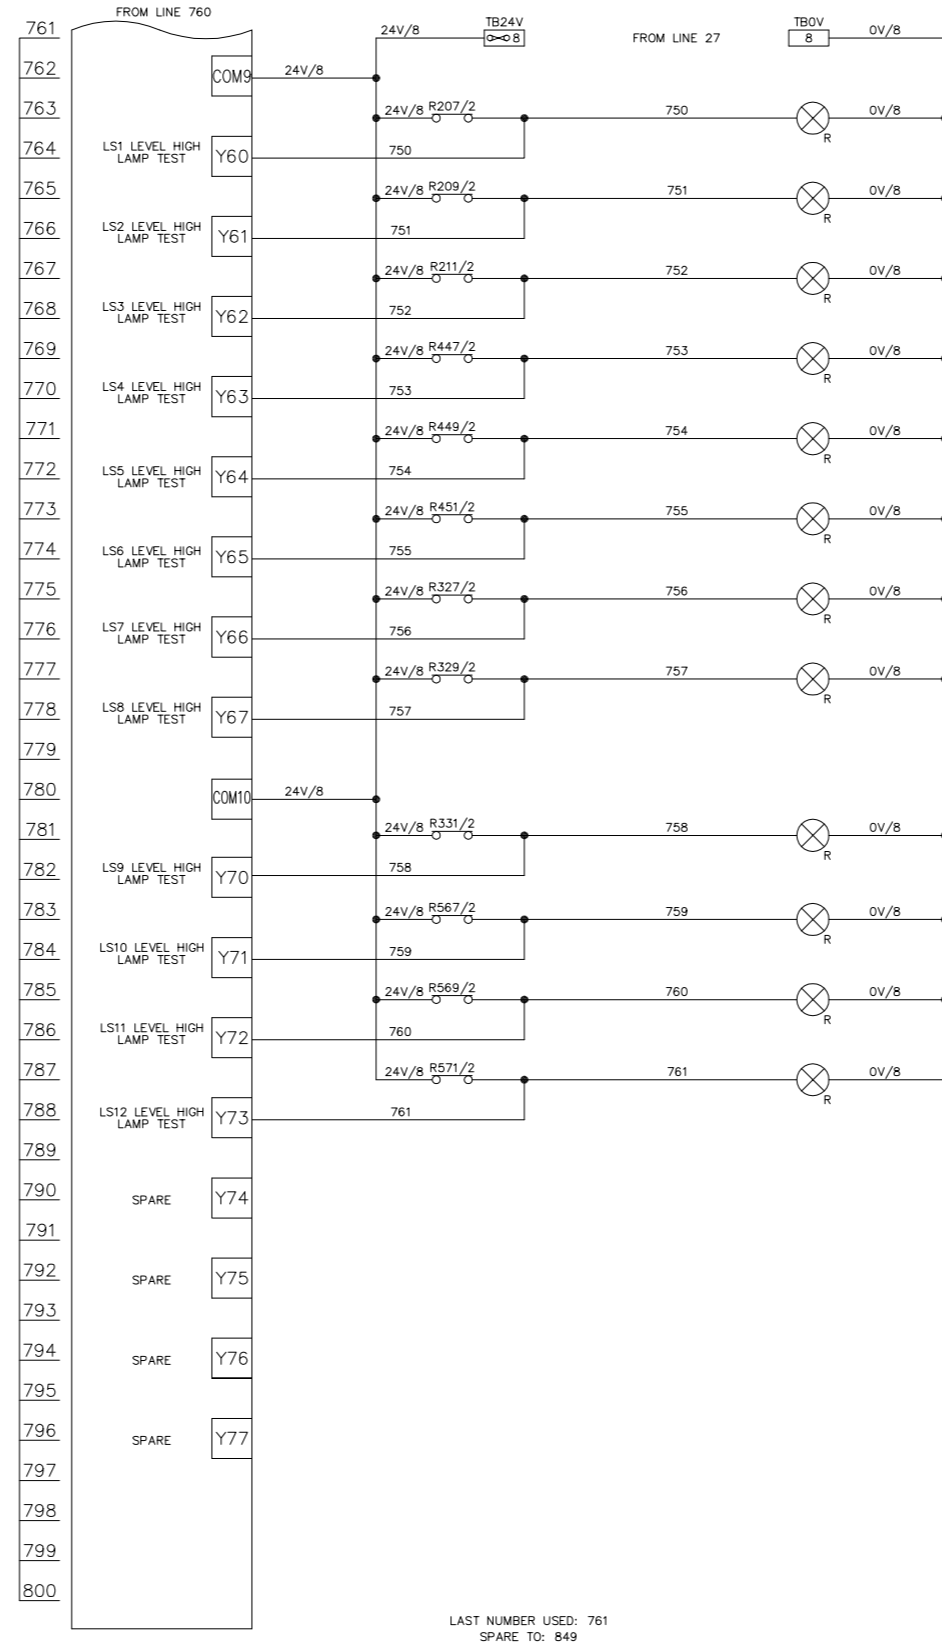

PUMP CONTROLS (240V)

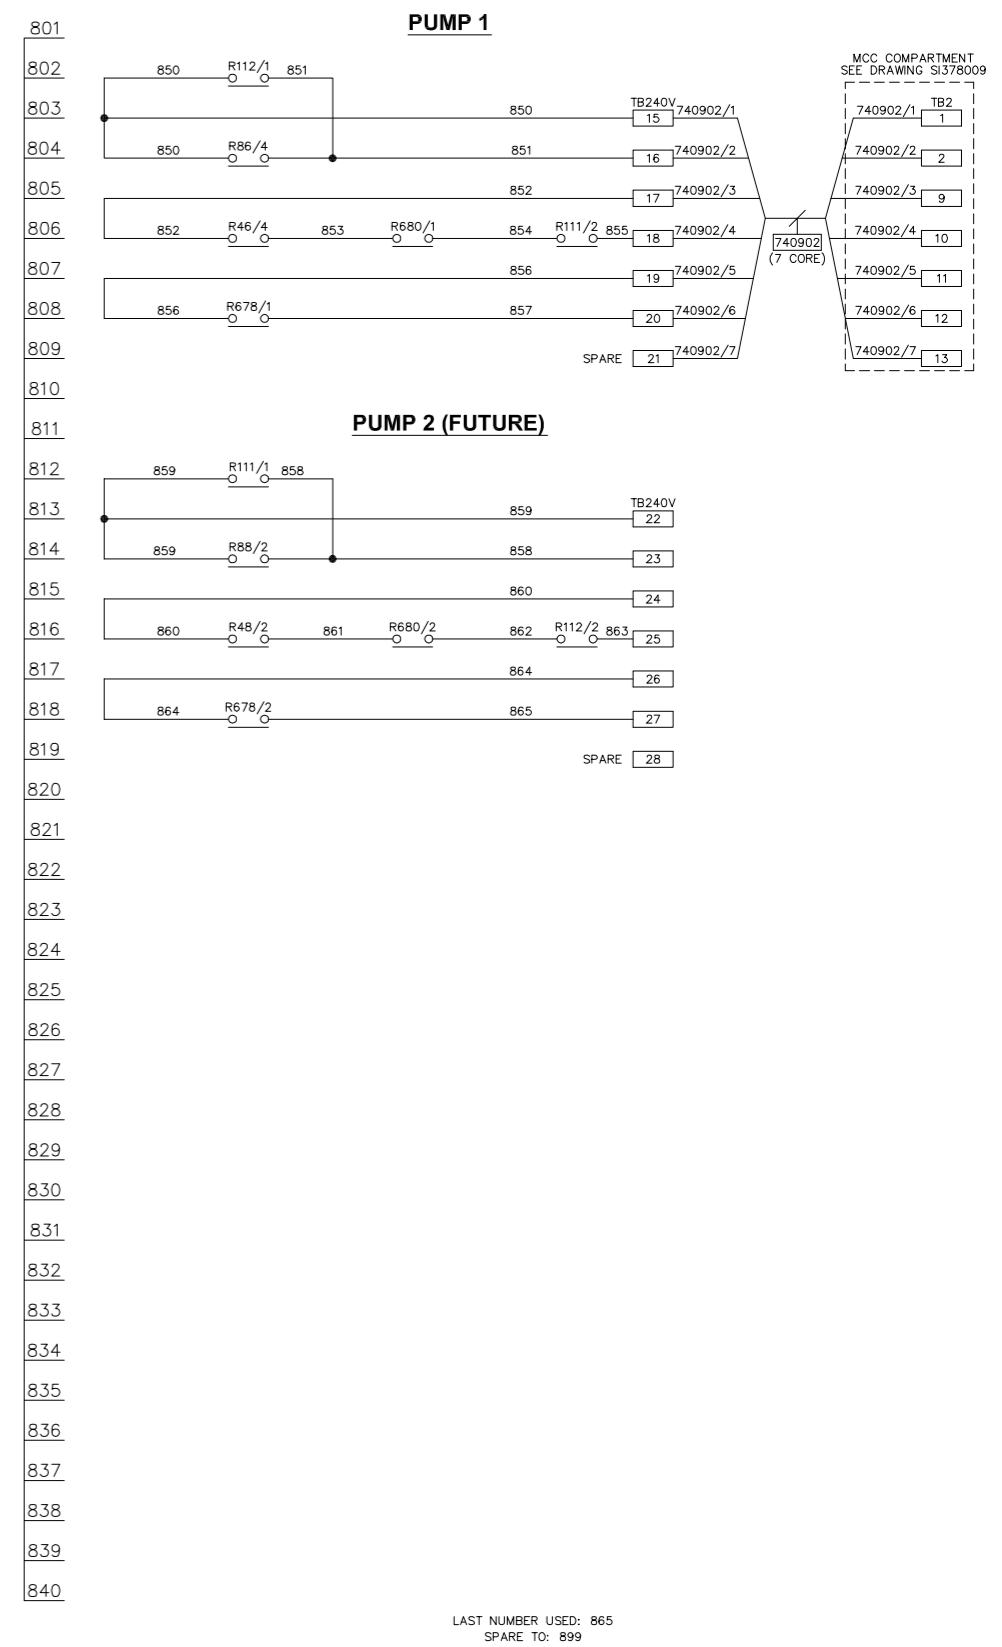


REV	DATE	BY	DRN	CHK'D	APP'D	DESCRIPTION	PLANT	FINA DERV RAIL LOADING SYSTEM
A	07/04/99	A.J.H	A.J.H	D.R.R	D.R.R	D.R.R	LOGIC 7	ORIGINAL ISSUE
B	02/07/99	D.P.	A.J.H	D.R.R	D.R.R	D.R.R	LOGIC 7	PANEL TEST MODS

02/07/99

**Simon Storage** TERMINALS IMMINGHAM STORAGE Co Ltd, IMMINGHAM EAST TERMINAL, SOUTH HUMBERSIDE

ELECTRICAL SCHEMATIC TEMPLATE SHEET 01 OF 01

CLIENT DRG. No. P&I DRG No. SI039008

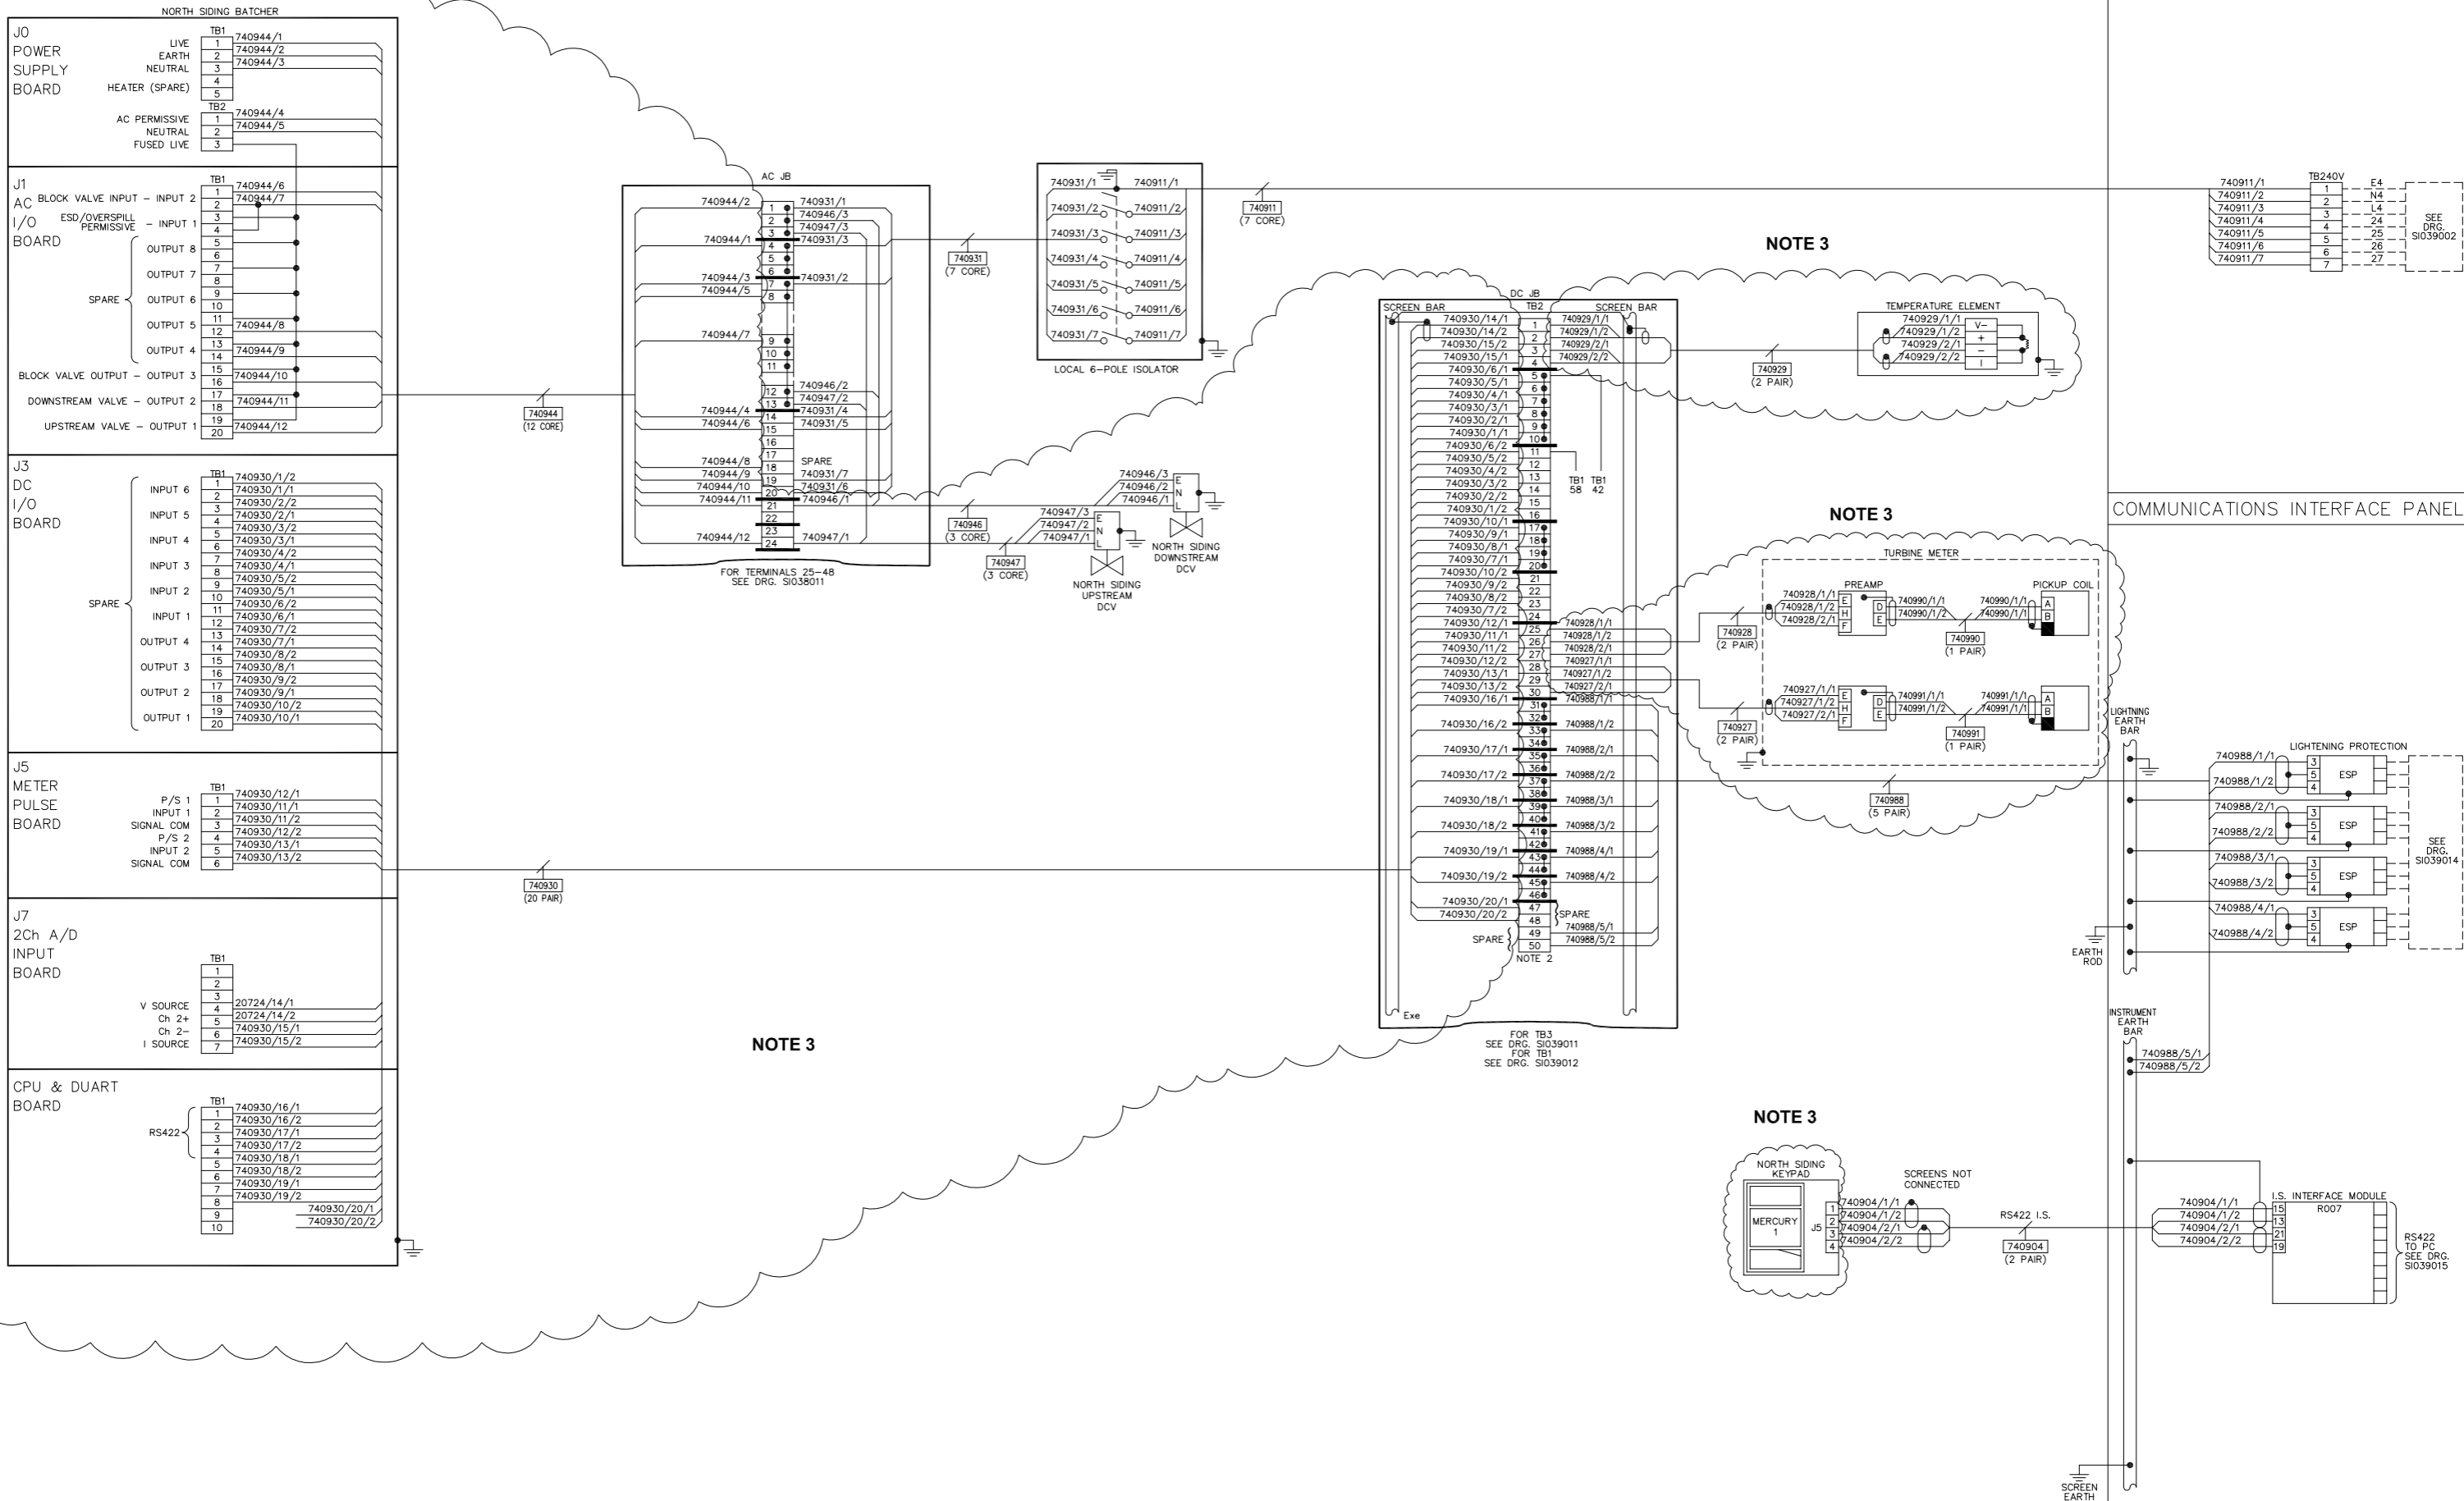

NOTE 3

NOTE 3

NOTE 3

NOTE 3

- NOTES**
1. ALL SCREENS NOT SHOWN FOR CLARITY.
  2. FOR COMMUNICATION INTERCONNECTIONS SEE DRAWING SI039014.
  3. DECOMMISSIONED BATCHING SYSTEM. FIELD EQUIPMENT REMOVED.



IF NOT SIGNED THIS DOCUMENT IS UNCONTROLLED

REV	DATE	BY	DRN	CHK'D	APP'D	DESCRIPTION
A	08/04/99	A.J.H.	A.J.H.	D.R.R.	D.R.R.	ORIGINAL ISSUE
B	02/07/99	D.P.	A.J.H.	D.R.R.	D.R.R.	GENERAL UPDATE
C	29/06/00	D.P.	A.B.	D.R.R.	D.R.R.	ON SITE CHANGES
D	14/09/10	D.B.F.	P.P.	M.M.	M.M.	SI760 MODIFICATIONS








PLANT	IMMINGHAM STORAGE Co. - EAST TERMINAL
TITLE	4-EAST RAIL LOADING SYSTEM NORTH SIDING BATCHING SYSTEM LOOP
CLIENT DRG. No.	P&I DRG No. SI039010_DWG

SAFETY PROTECTION	FLAMEPROOF & INCREASED SAFETY		CERTIFIED EQUIPMENT				CERTIFIED EQUIPMENT					
	REQUIRED	ACHIEVED	TAG No.	CERTIFICATE No.	CERTIFICATION AUTHORITY	TAG No.	CERTIFICATE No.	CERTIFICATION AUTHORITY	TAG No.	CERTIFICATE No.	CERTIFICATION AUTHORITY	
AREA CLASS	ZONE 1	XXXX	FQ01	93C.105.11123	EExd IIB T6	BASEEFA	AC JB	84B3299X	EE*x* IIC T6	BASEEFA		
GAS GROUP	IIB	XXXX	TE01	831045X	EExd IIC T6	BASEEFA						
TEMPERATURE CLASS	T3	XXXX	FT01	86B1336	EExd IIC T6	BASEEFA						






FIELD

CONTROL PANEL

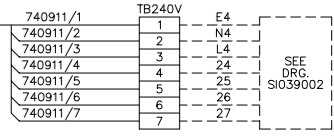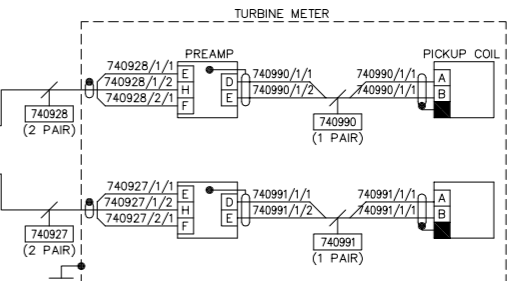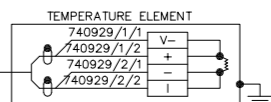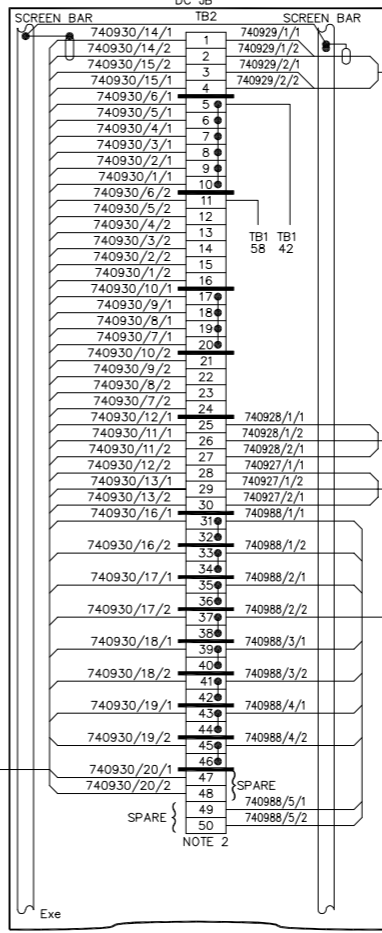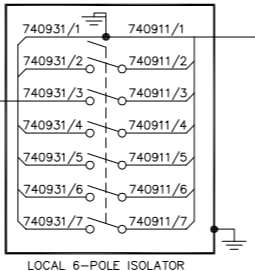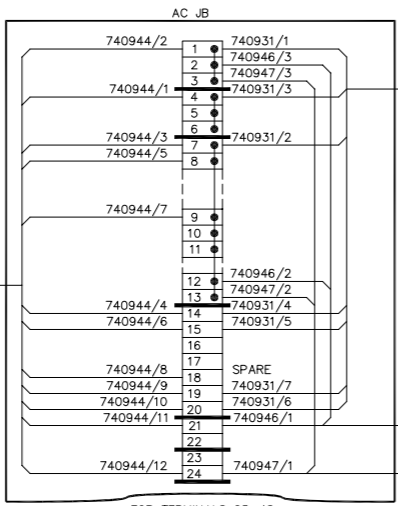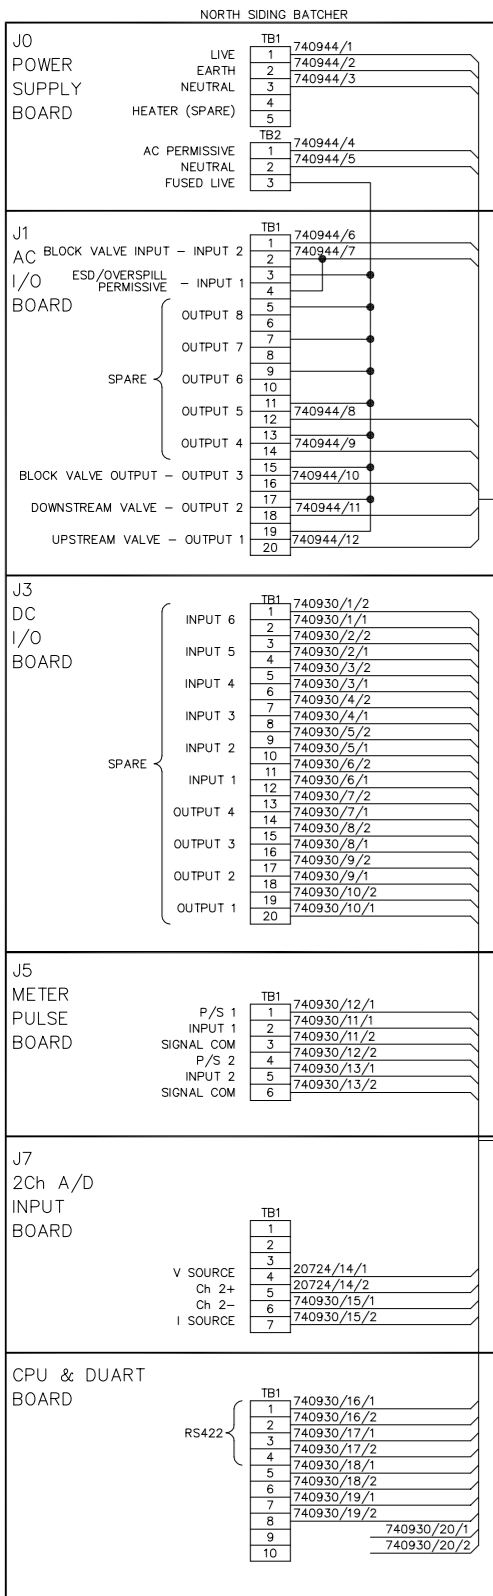

COMMUNICATIONS INTERFACE PANEL

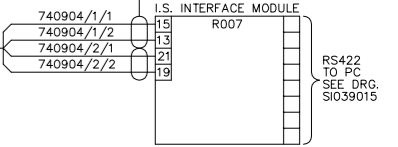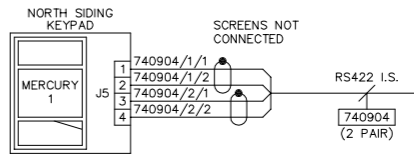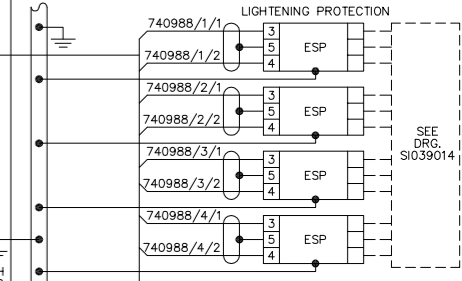


FLAMEPROOF & INCREASED SAFETY	CERTIFIED EQUIPMENT				CERTIFIED EQUIPMENT					
	REQUIRED	Achieved	TAG No.	CERTIFICATE No.	CERTIFICATION	AUTHORITY	TAG No.	CERTIFICATE No.	CERTIFICATION	AUTHORITY
AREA CLASS	ZONE 1	XXXX	FQ01	93C.105.11123	EExd IIB T6	BASEEFA	AC JB	84B3299X	EE'x'e' IIC T6	BASEEFA
GAS GROUP	IIB	XXXX	TE01	831045X	EExd IIC T6	BASEEFA				
TEMPERATURE CLASS	PI	XXXX	FT01	86B1336	EExd IIC T6	BASEEFA				
			DCV01A	TBA	TBA	TBA				
			DCV01B	TBA	TBA	TBA				
			DC JB	84B3299X	EE'x'e' IIC T6	BASEEFA				

- NOTES
1. ALL SCREENS NOT SHOWN FOR CLARITY
  2. FOR COMMUNICATION INTERCONNECTIONS SEE DRAWING SI039014

REV	DATE	BY	DRN	CHK'D	APP'D	DESCRIPTION
A	08/04/99	A.J.H.	A.J.H.	D.R.R.	D.R.R.	ORIGINAL ISSUE
B	02/07/99	D.P.	A.J.H.	D.R.R.	D.R.R.	GENERAL UPDATE
C	29/06/00	D.P.	A.B.	D.R.R.	D.R.R.	ON SITE CHANGES

PLANT	FINA DERV RAIL LOADING SYSTEM
TITLE	NORTH SIDING BATCHING SYSTEM LOOP
DATE	29/06/00
Client	IMMINGHAM STORAGE Co Ltd, IMMINGHAM EAST TERMINAL, SOUTH HUMBERSIDE
Storage	IMMINGHAM STORAGE Co Ltd, IMMINGHAM EAST TERMINAL, SOUTH HUMBERSIDE
Terminals	IMMINGHAM STORAGE Co Ltd, IMMINGHAM EAST TERMINAL, SOUTH HUMBERSIDE
INSTRUMENT LOOP SHEET FOR USE IN HAZARDOUS AREA	SHEET 01 OF 01
CLIENT DRG. No.	P&I DRG No. SI039010



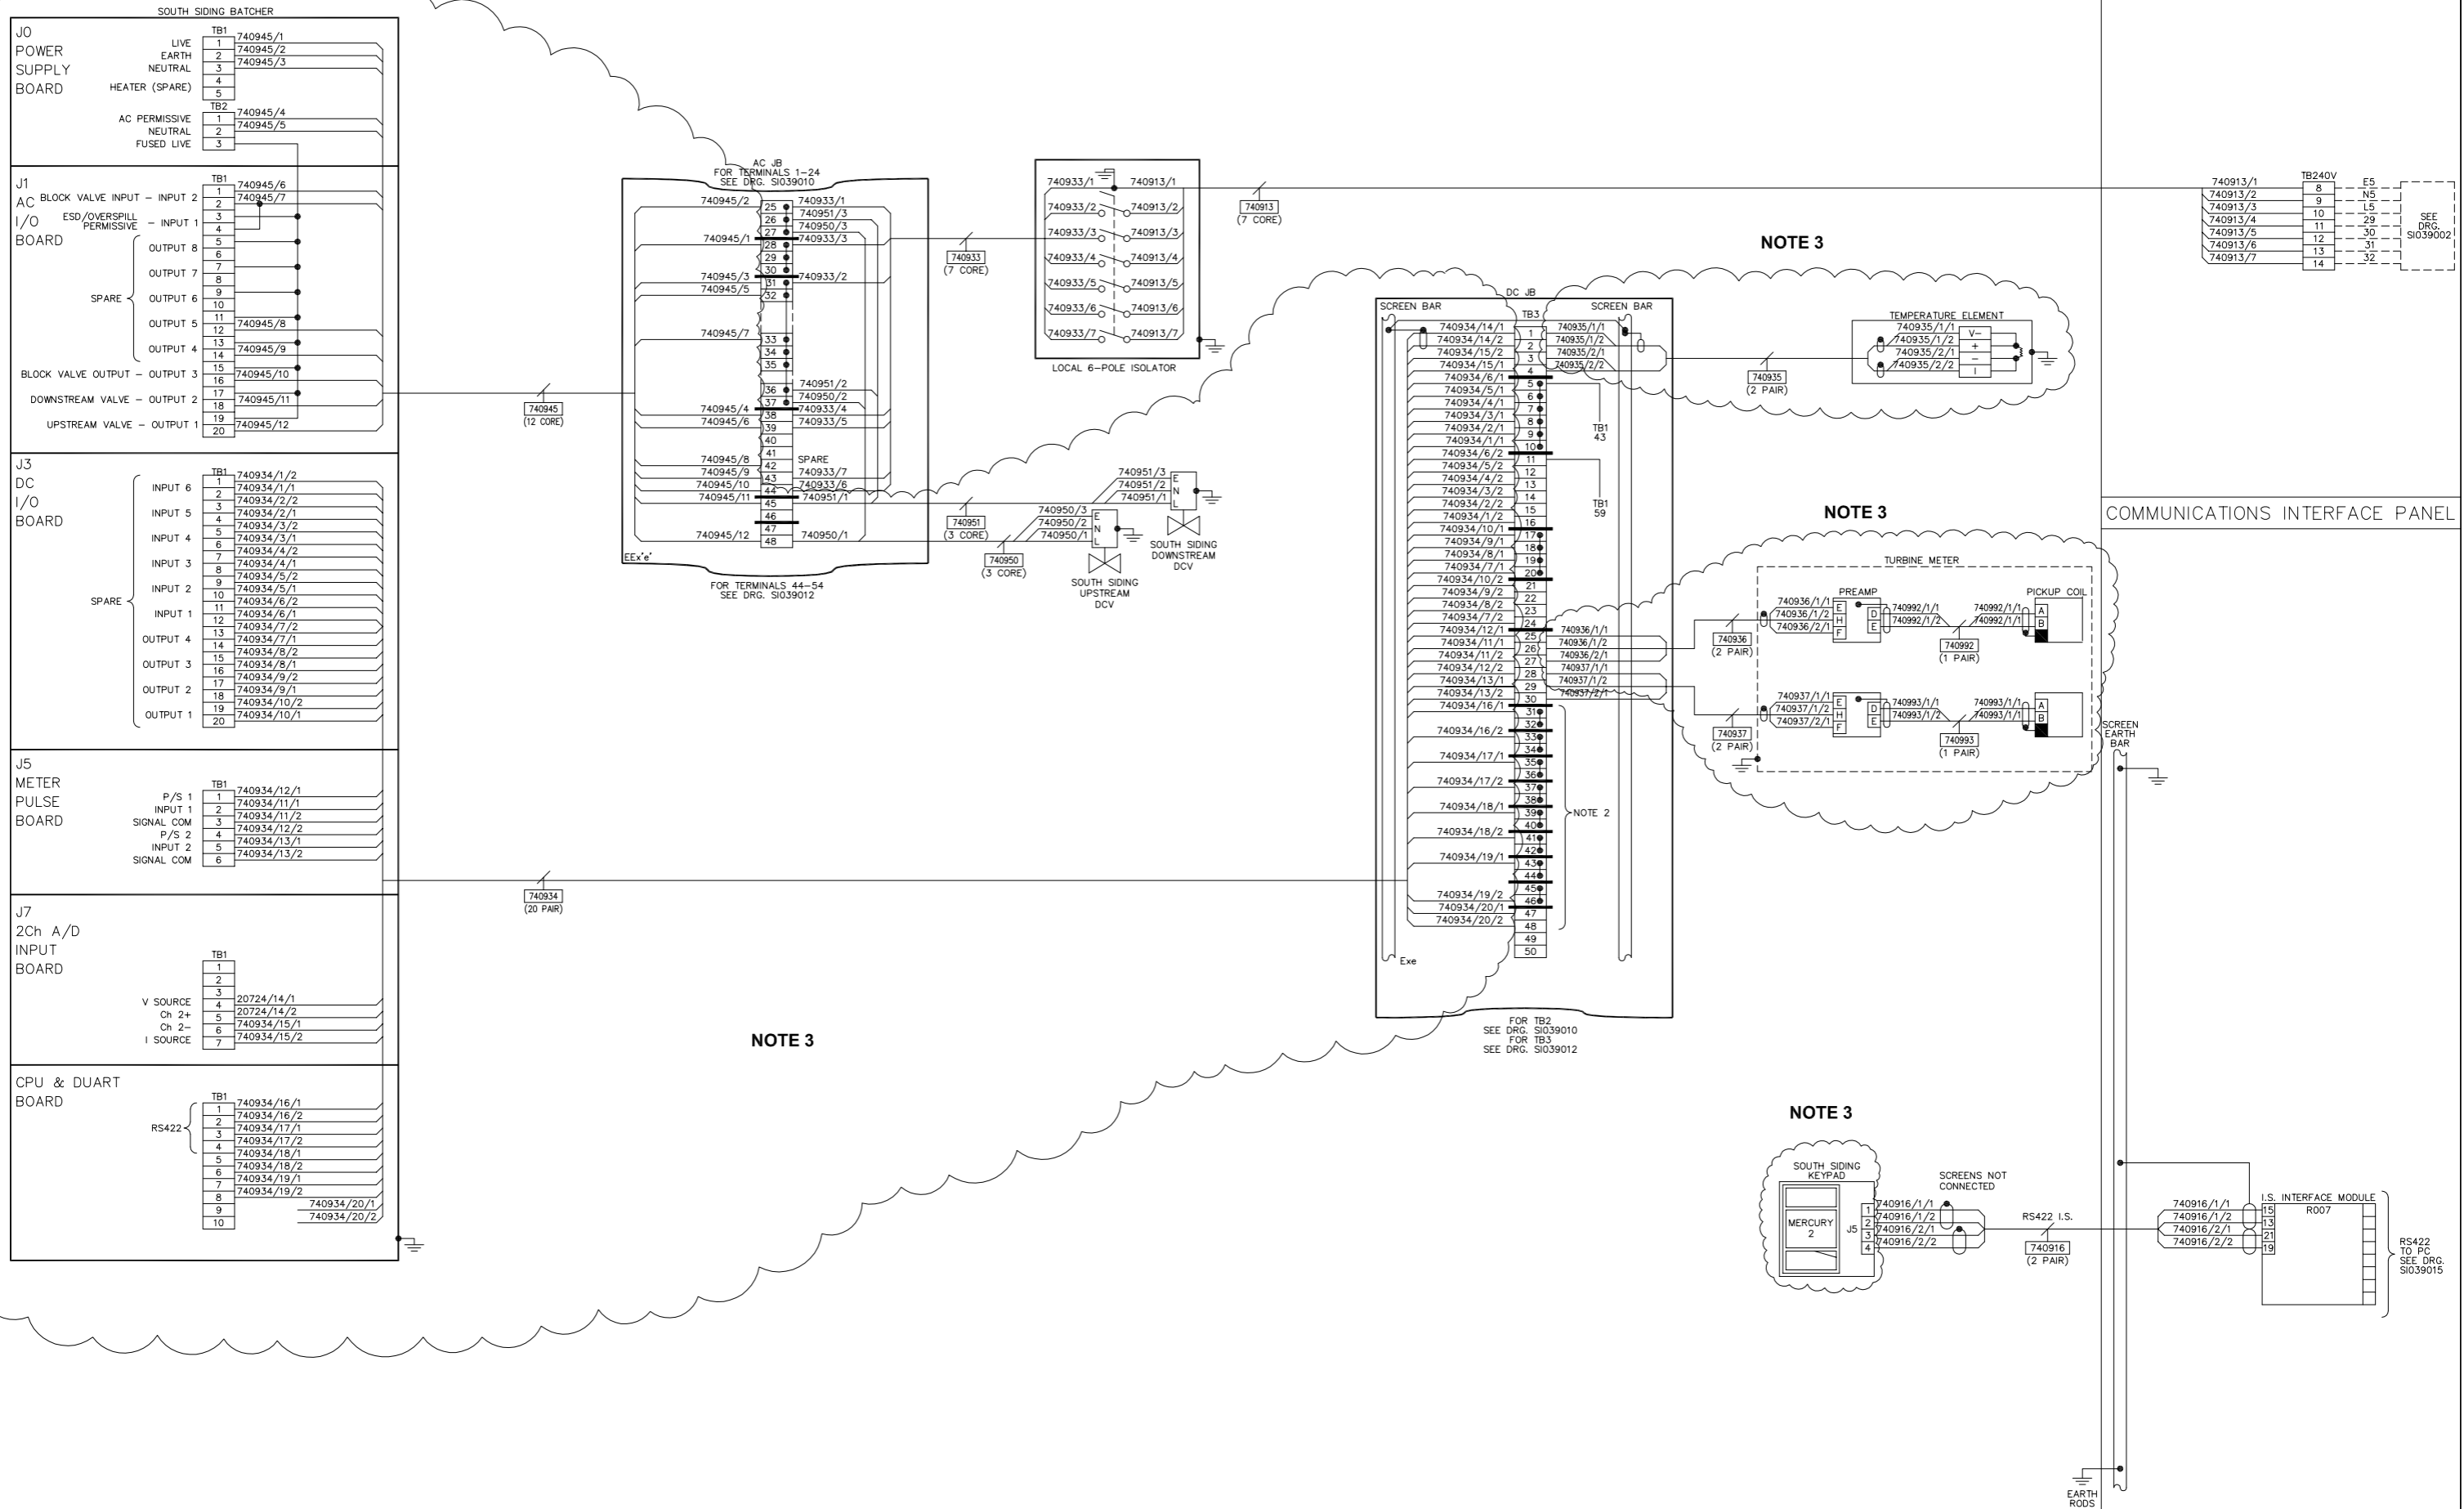

NOTE 3

NOTE 3

NOTE 3

NOTE 3

FOR TB2  
SEE DRG. SI039010  
FOR TB3  
SEE DRG. SI039012

- NOTES**
1. ALL SCREENS NOT SHOWN FOR CLARITY.
  2. FOR COMMUNICATION INTERCONNECTIONS SEE DRAWING SI039014.
  3. DECOMMISSIONED BATCHING SYSTEM. FIELD EQUIPMENT REMOVED.



IF NOT SIGNED THIS DOCUMENT IS UNCONTROLLED






REV	DATE	BY	DRN	CHK'D	APP'D	DESCRIPTION
A	08/04/99	A.J.H.	A.J.H.	D.R.R.	D.R.R.	ORIGINAL ISSUE
B	02/07/99	D.P.	A.J.H.	D.R.R.	D.R.R.	GENERAL UPDATE
C	29/06/00	D.P.	A.B.	D.R.R.	D.R.R.	ON SITE CHANGES
D	14/09/10	D.B.F.	P.P.	M.M.	M.M.	SI760 MODIFICATIONS

PLANT	IMMINGHAM STORAGE Co. - EAST TERMINAL
TITLE	4-EAST RAIL LOADING SYSTEM SOUTH SIDING BATCHING SYSTEM LOOP
CLIENT DRG. No.	P&I DRG No. SI039011_DWG


SAFETY PROTECTION	FLAMEPROOF & INCREASED SAFETY		CERTIFIED EQUIPMENT				CERTIFIED EQUIPMENT			
	REQUIRED	ACHIEVED	TAG No.	CERTIFICATE No.	CERTIFICATION AUTHORITY	TAG No.	CERTIFICATE No.	CERTIFICATION AUTHORITY		
AREA CLASS	ZONE 1	XXXX	FQ01	93C105.11123	EExd IIB T6	BASEEFA	AC JB	84B3299X	EE'x' IIC T6	BASEEFA
GAS GROUP	IIB	XXXX	TE01	831045X	EExd IIC T6	BASEEFA				
TEMPERATURE CLASS	T3	XXXX	FT01	86B1336	EExd IIC T6	BASEEFA				
			DCV02A	TBA	TBA	TBA				
			DCV02B	TBA	TBA	TBA				
			DC JB	84B3299X	EE'x' IIC T6	BASEEFA				

FIELD

CONTROL PANEL

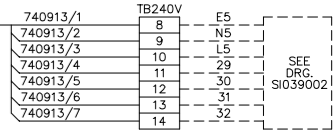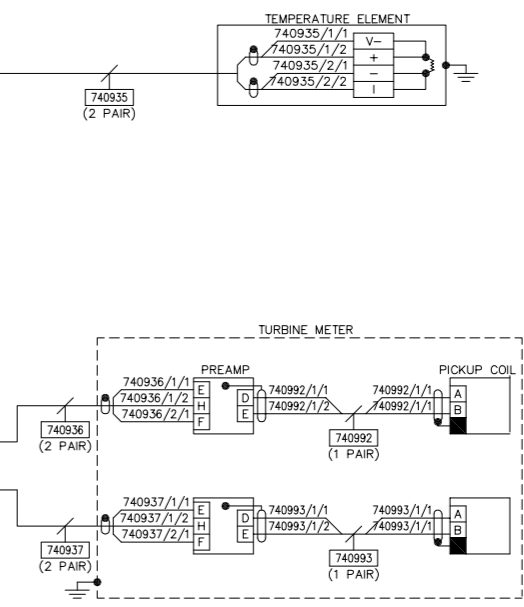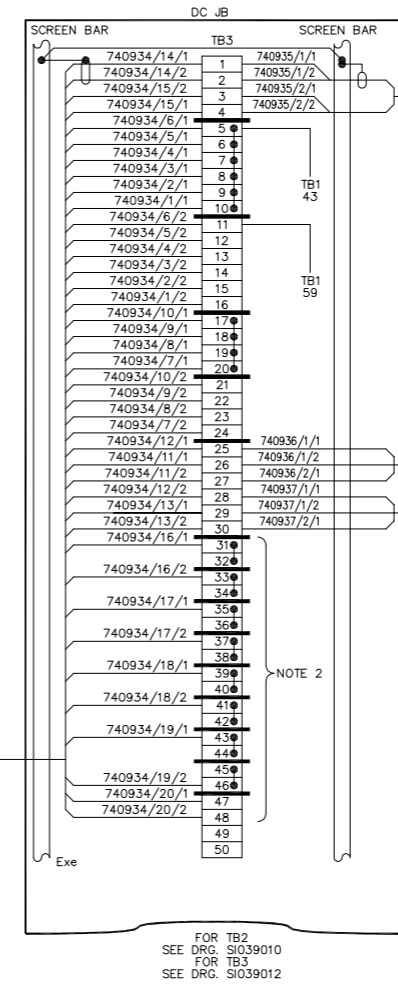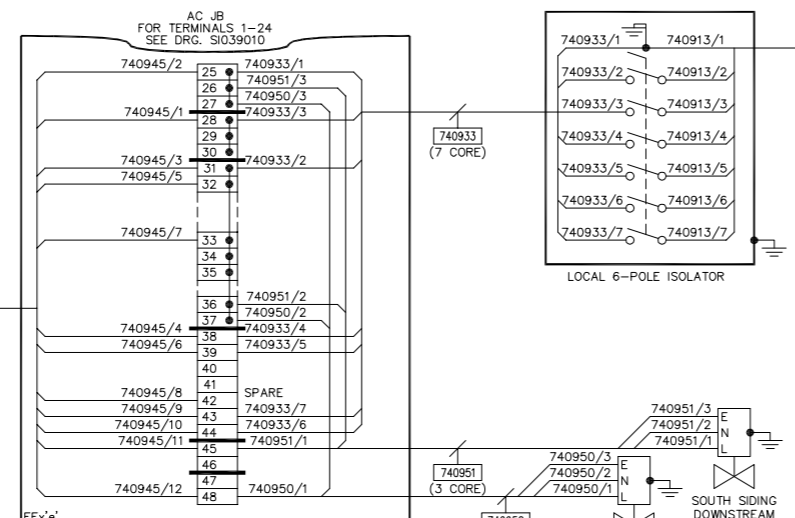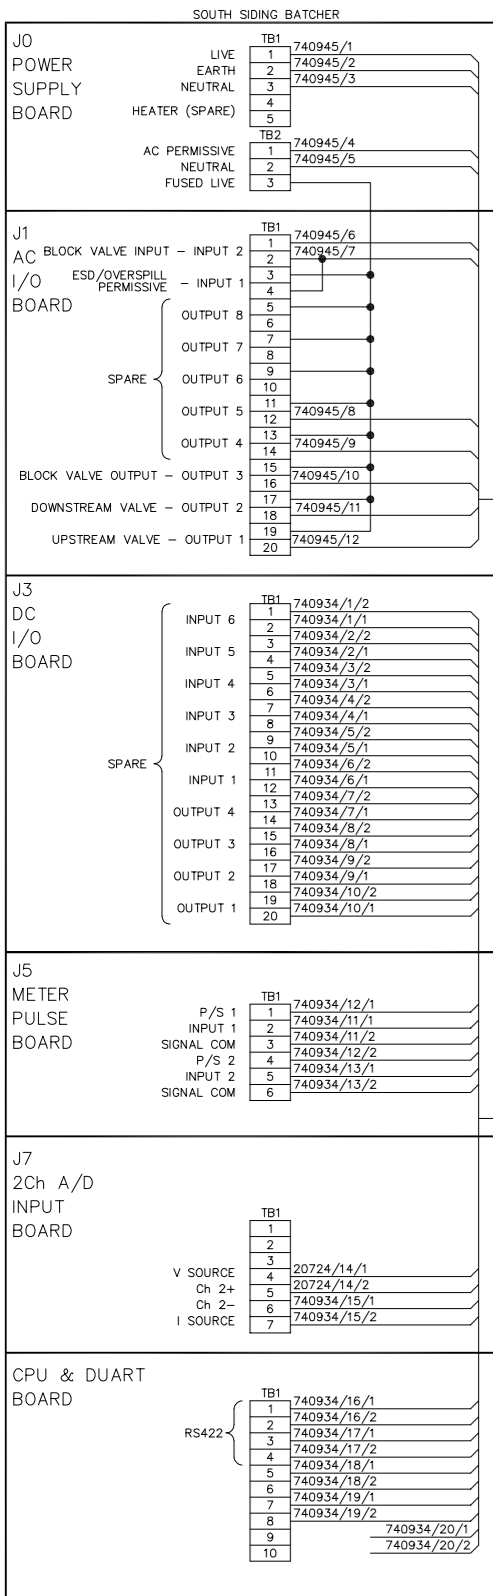

COMMUNICATIONS INTERFACE PANEL

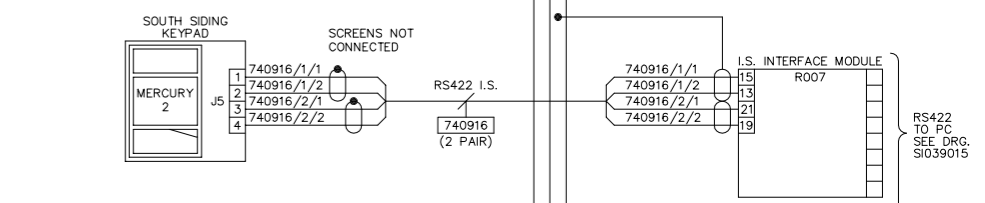

SAFETY PROTECTION	FLAMEPROOF & INCREASED SAFETY		CERTIFIED EQUIPMENT				CERTIFIED EQUIPMENT			
	REQUIRED	ACHIEVED	TAG No.	CERTIFICATE No.	CERTIFICATION	AUTHORITY	TAG No.	CERTIFICATE No.	CERTIFICATION	AUTHORITY
AREA CLASS	ZONE 1	XXXX	FQ01	93C.105.11123	EExd IIB T6	BASEEFA	AC JB	84B3299X	EEx'e' IIC T6	BASEEFA
GAS GROUP	IIB	XXXX	TE01	831045X	EExd IIC T6	BASEEFA				
TEMPERATURE CLASS	PI	XXXX	FT01	86B1336	EExd IIC T6	BASEEFA				
			DCV02A	TBA	TBA	TBA				
			DCV02B	TBA	TBA	TBA				
			DC JB	84B3299X	EEx'e' IIC T6	BASEEFA				

NOTES  
 1. ALL SCREENS NOT SHOWN FOR CLARITY  
 2. FOR COMMUNICATIONS INTERCONNECTIONS SEE DRAWING SI039014





REV	DATE	BY	DRN	CHK'D	APP'D	DESCRIPTION
A	08/04/99	A.J.H.	A.J.H.	P.J.P.	P.J.P.	D.R.R. ORIGINAL ISSUE
B	02/07/99	D.P.	A.J.H.	D.R.R.	D.R.R.	D.R.R. GENERAL UPDATE
C	29/06/00	D.P.	A.B.	D.R.R.	D.R.R.	D.R.R. ON SITE CHANGES

PLANT	FINA DERV RAIL LOADING SYSTEM
TITLE	SOUTH SIDING BATCHING SYSTEM LOOP
DATE	29/06/00
CLIENT DRG. No.	P&I DRG No. SI039011



IMMINGHAM STORAGE Co Ltd,  
 IMMINGHAM EAST TERMINAL,  
 SOUTH HUMBERSIDE

INSTRUMENT LOOP SHEET  
 FOR USE IN HAZARDOUS AREA  
 SHEET 01 OF 01

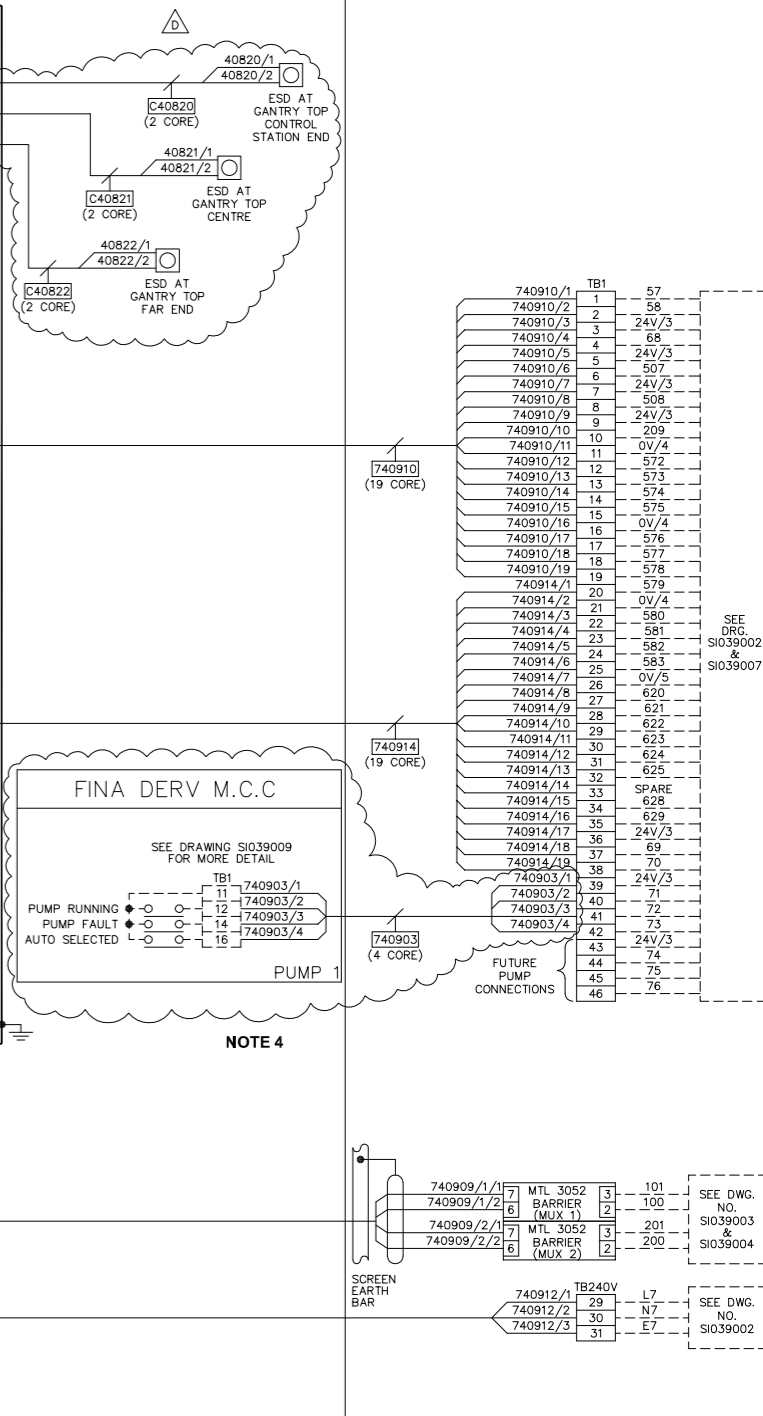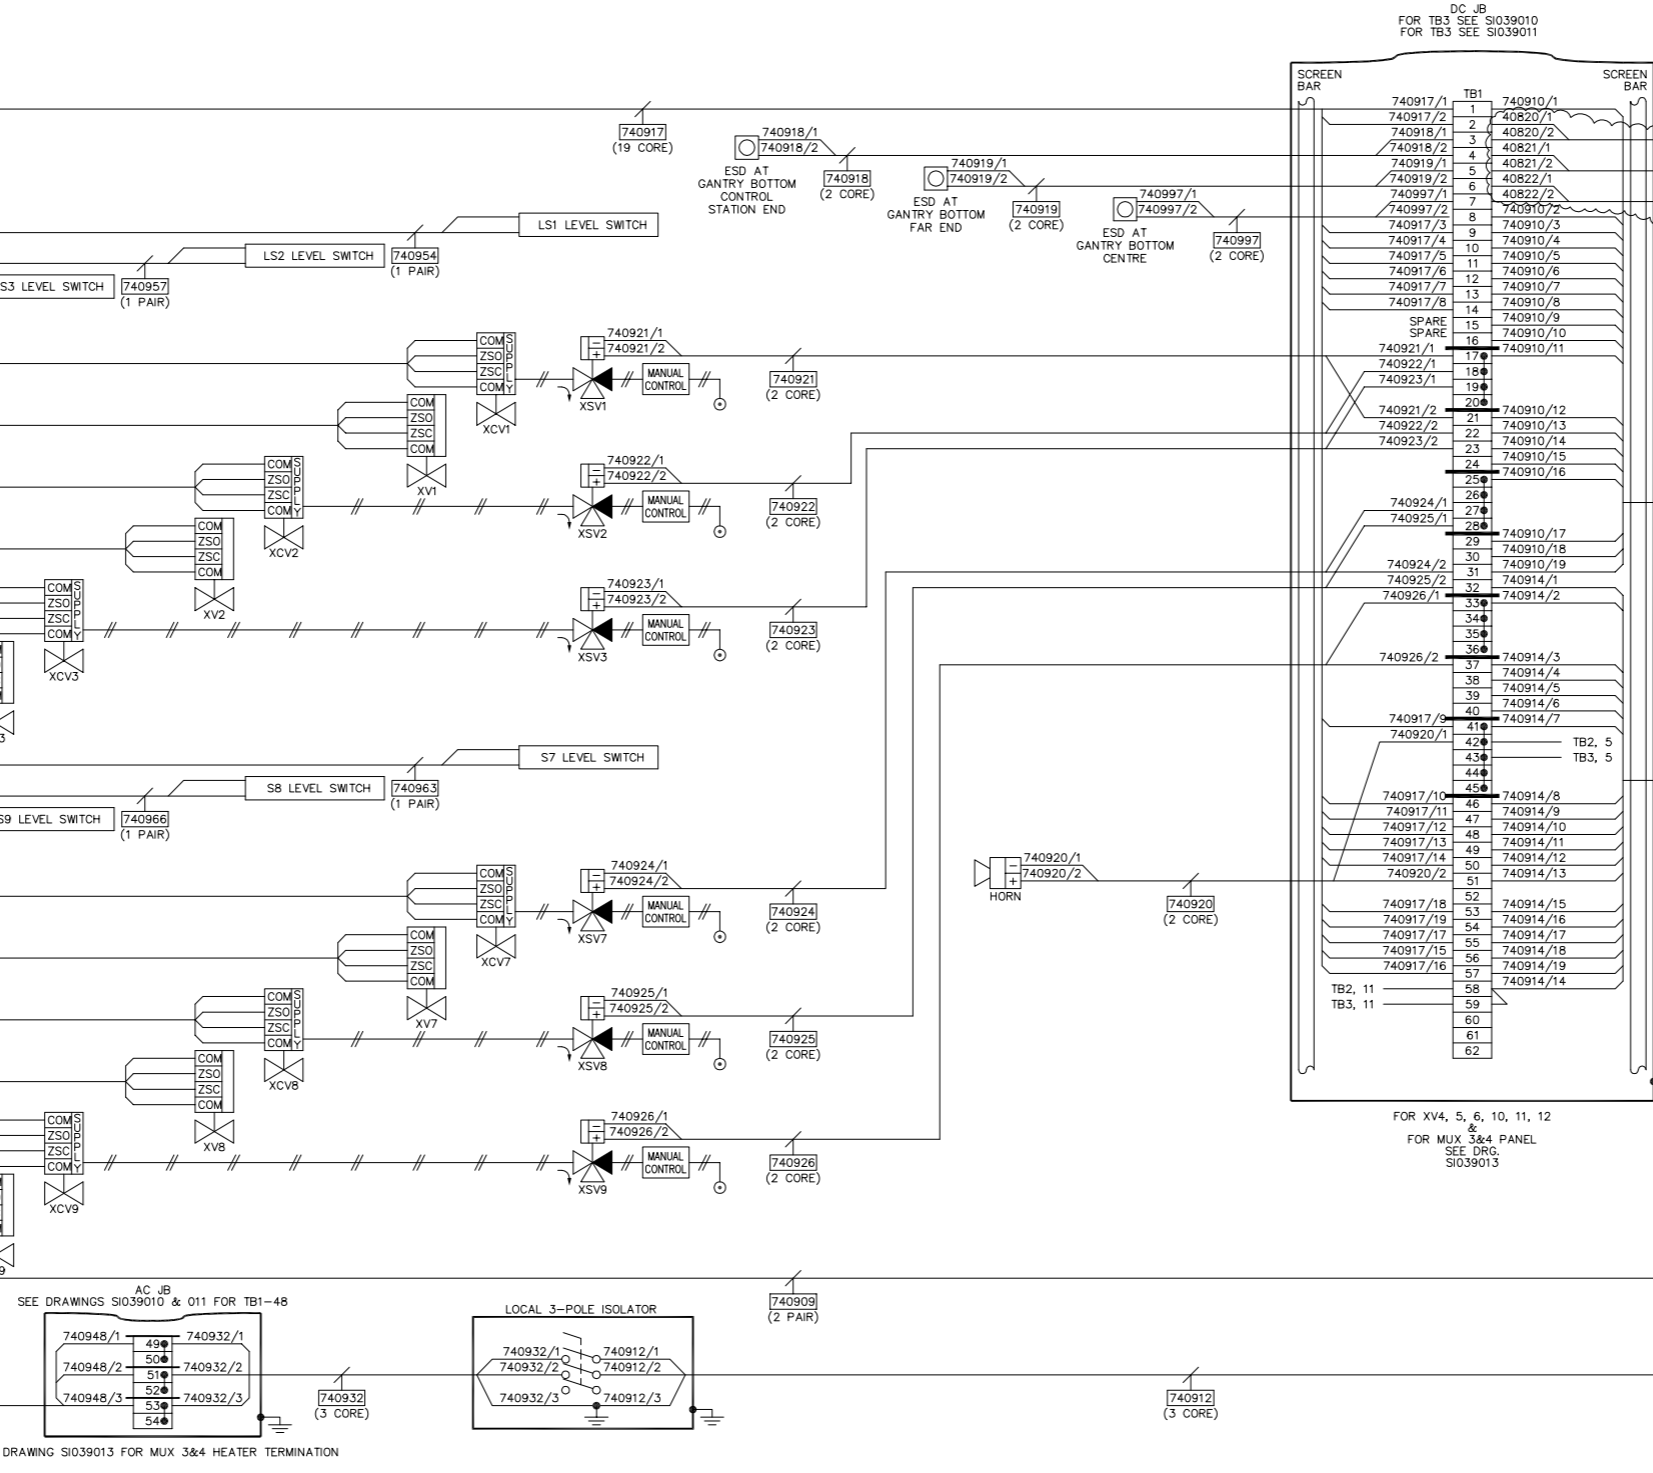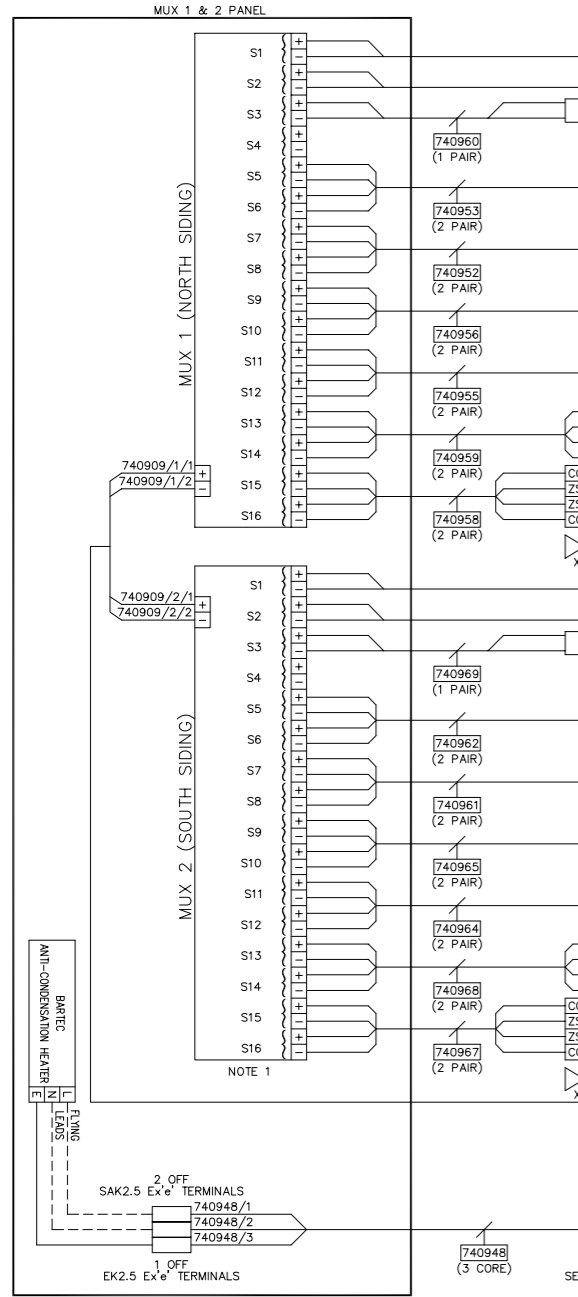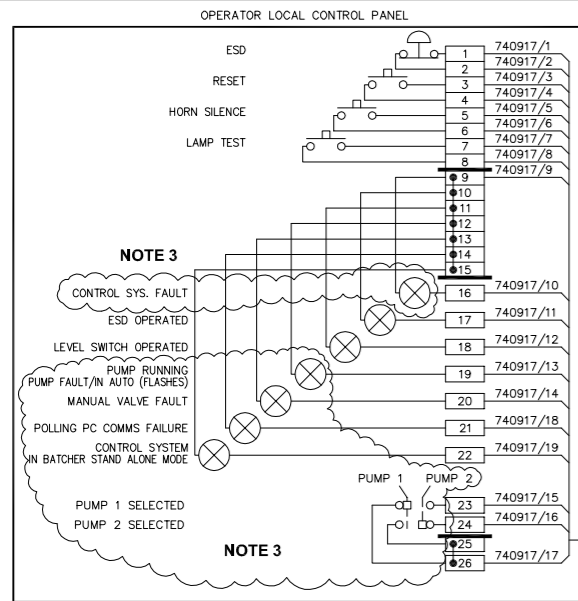

SAFETY PROTECTION	FLAMEPROOF & INCREASED SAFETY	REQUIRED	ACHIEVED
AREA CLASS	ZONE 1	XXXX	XXXX
GAS GROUP	IIB	XXXX	XXXX
TEMPERATURE CLASS	T3	PI	XXXX

CERTIFIED EQUIPMENT			
TAG No.	CERTIFICATE No.	CERTIFICATION AUTHORITY	THIRD PARTY AUTHORITY

**NOTES**







- ALL SCREENS NOT SHOWN FOR CLARITY.
- FOR COMMUNICATION INTERCONNECTIONS SEE DRAWING SI039014.
- LAMPS, SELECTOR SWITCH & ASSOCIATED WIRING HIGHLIGHTED TO BE REMOVED FROM THE LOCAL CONTROL PANEL & THE HOLES BLANKED.
- DECOMMISSIONED BATCHING SYSTEM.



IF NOT SIGNED THIS DOCUMENT IS UNCONTROLLED

REV	DATE	BY	DRN	CHK'D	APP'D	DESCRIPTION
A	08/04/99	A.J.H.	A.J.H.	D.R.R.	D.R.R.	ORIGINAL ISSUE
B	15/04/99	A.J.H.	A.J.H.	D.R.R.	D.R.R.	MUX BOX UPDATED
C	02/07/99	D.P.	A.J.H.	D.R.R.	D.R.R.	GENERAL UPDATE
D	14/09/10	D.B.F.	P.P.	M.M.	M.M.	SI760 MODIFICATIONS

PLANT	IMMINGHAM STORAGE Co. - EAST TERMINAL
TITLE	4-EAST RAIL LOADING SYSTEM MUX 1 & 2 PANEL LOOP
CLIENT DRG. No.	IMMINGHAM STORAGE Co. Ltd. IMMINGHAM EAST TERMINAL, IMMINGHAM DOCK, IMMINGHAM, SOUTH HUMBERSIDE
SHEET 1 OF 1	P&I Design Ltd. Tel: 01642 617444 www.pidesign.co.uk
P&I DRG. No.	SI039012_DWG

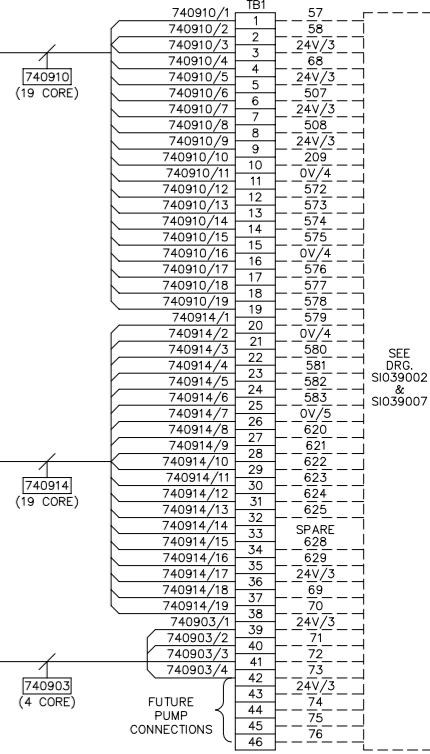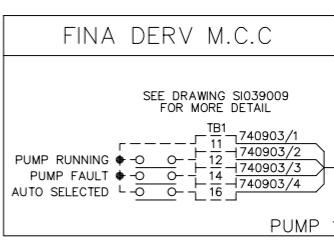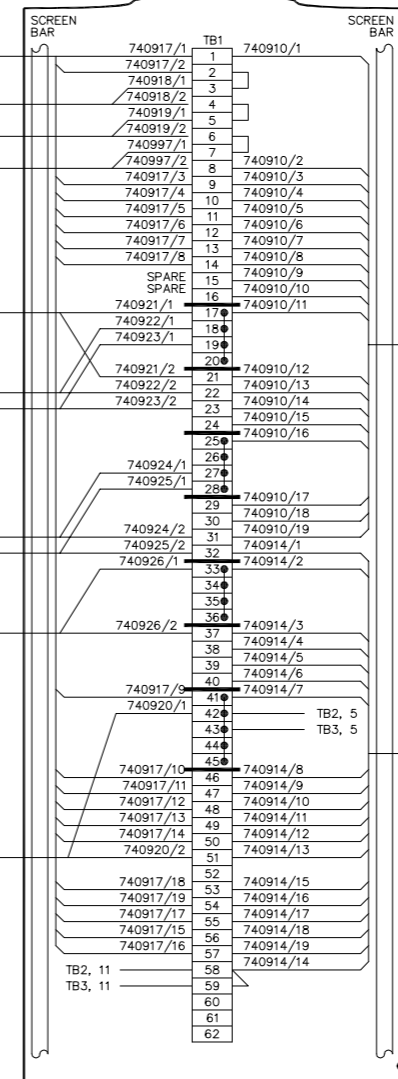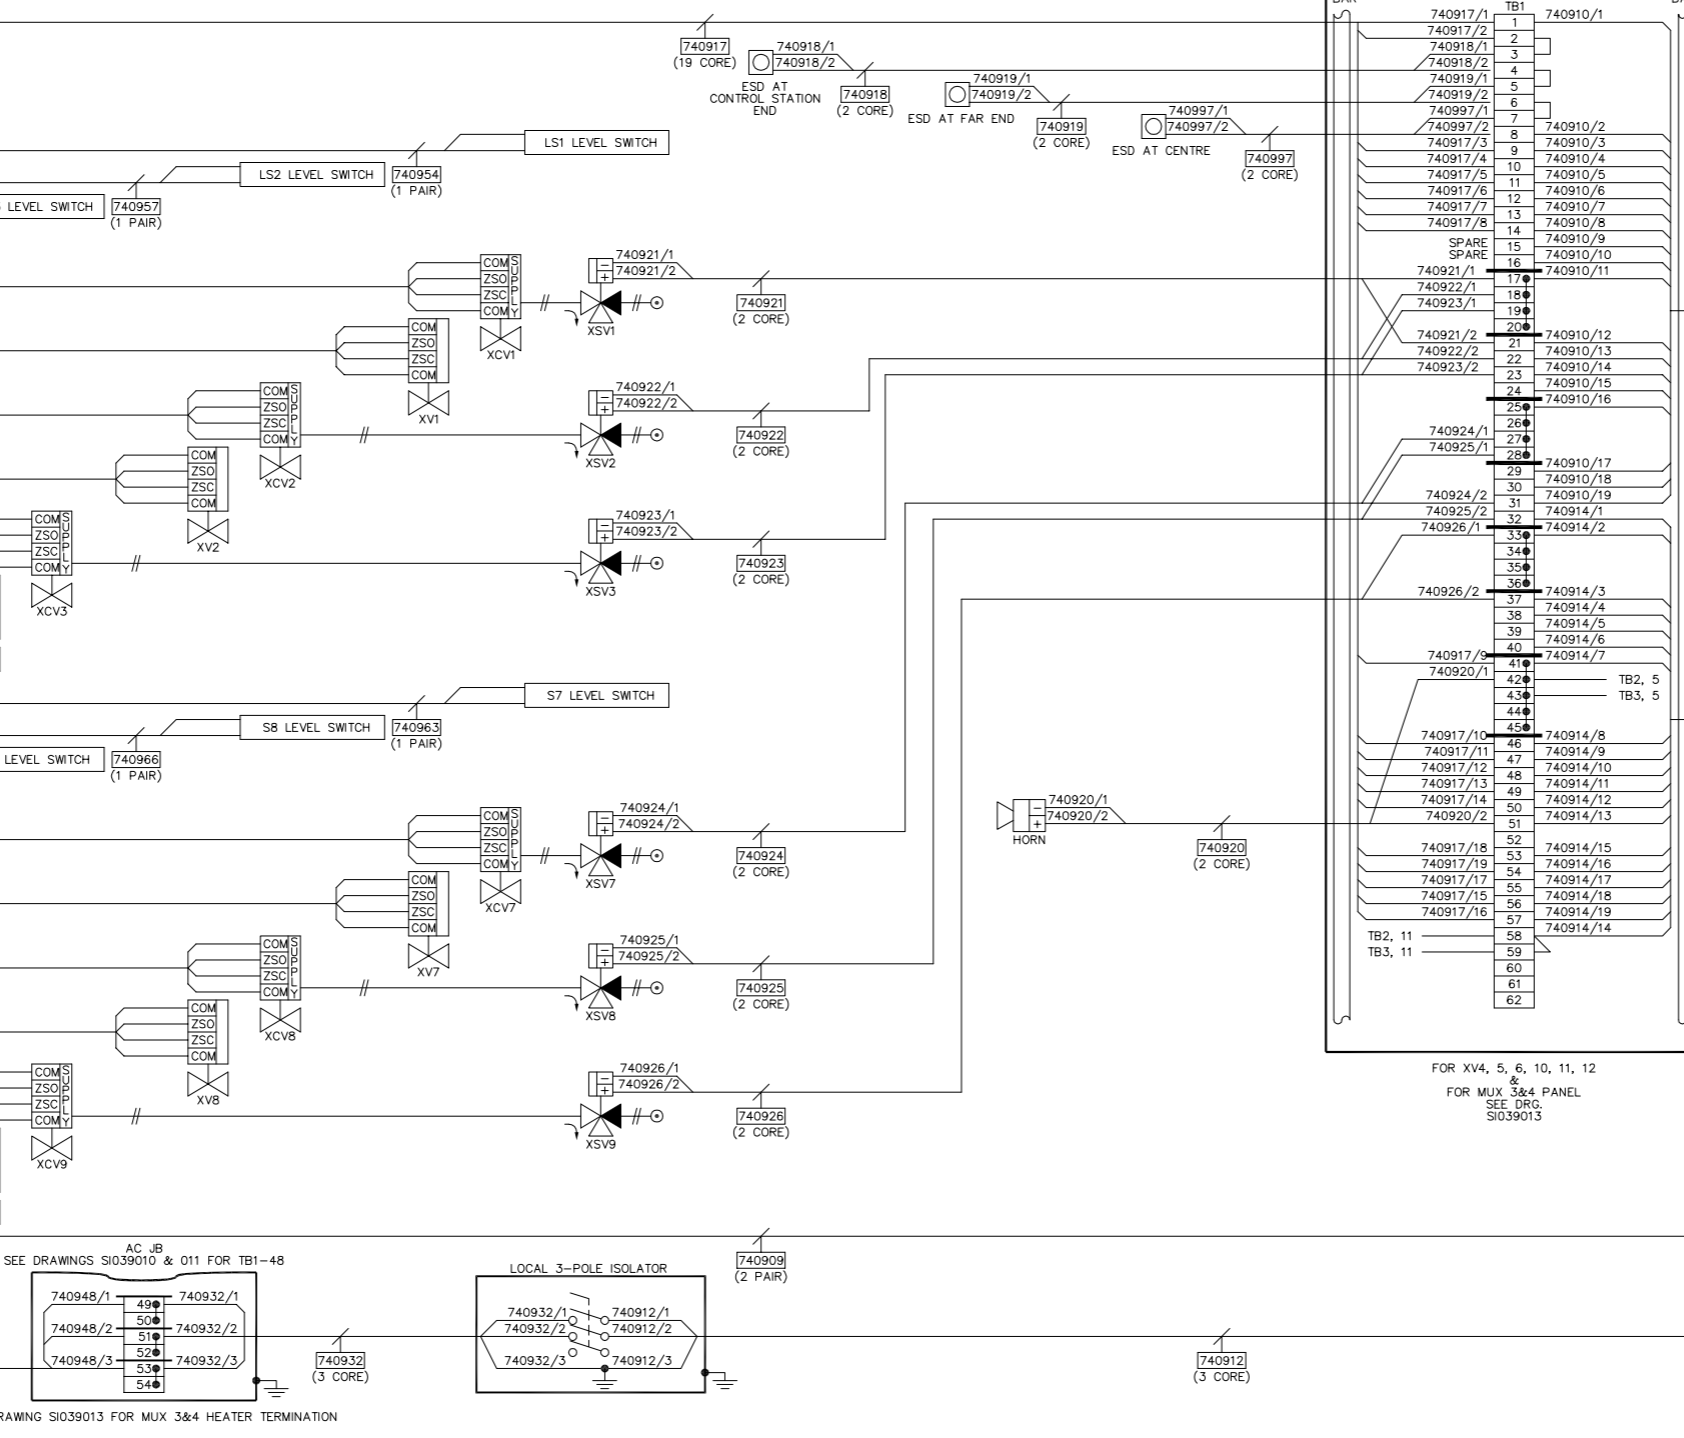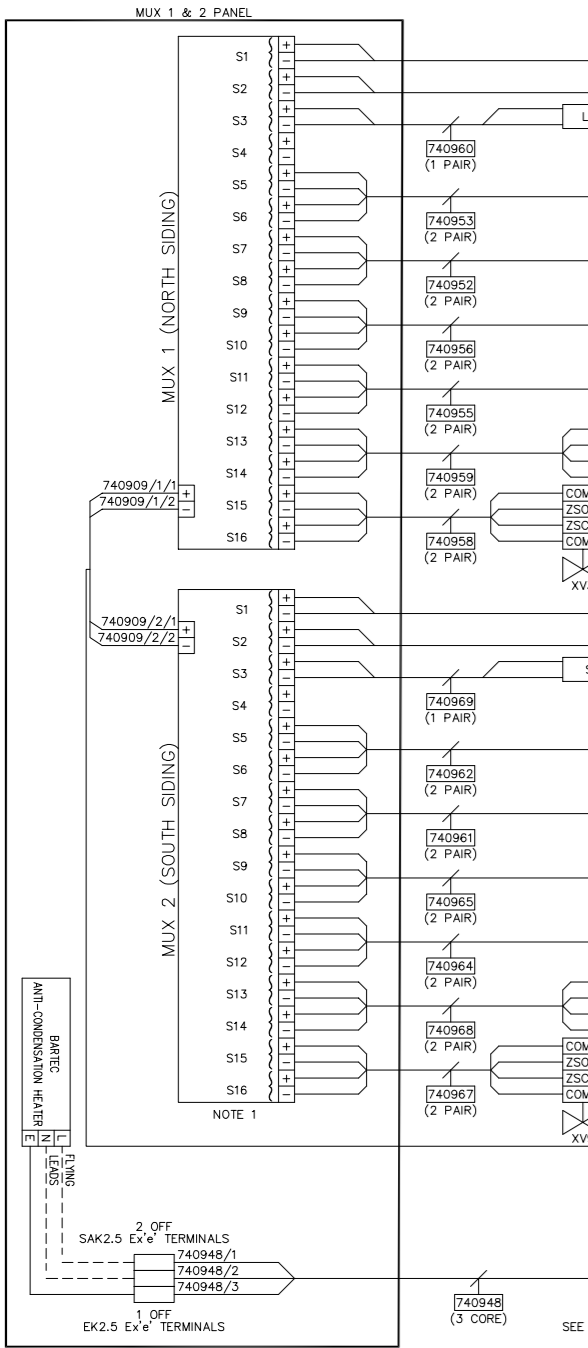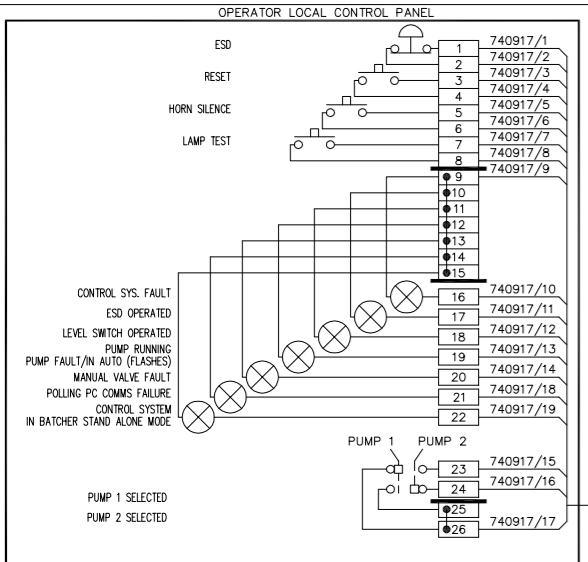

SEE DRAWING SI039003 & 4 FOR MORE DETAIL

FLAMEPROOF & SAFETY PROTECTION INCREASED SAFETY	REQUIRED	Achieved	XXXX
AREA CLASS	ZONE 1		XXXX
GAS GROUP	IIB		XXXX
TEMPERATURE CLASS	T3		XXXX

CERTIFIED EQUIPMENT				CERTIFIED EQUIPMENT			
TAG No.	CERTIFICATE No.	CERTIFICATION AUTHORITY		TAG No.	CERTIFICATE No.	CERTIFICATION AUTHORITY	


NOTES

- ALL SCREENS NOT SHOWN FOR CLARITY
- FOR COMMUNICATIONS INTERCONNECTIONS SEE DRAWING SI039014

REV	DATE	BY	DRN	CHK'D	APP'D	DESCRIPTION
A	08/04/99	A.J.H.	A.J.H.	D.R.R.	D.R.R.	ORIGINAL ISSUE
B	15/04/99	A.J.H.	A.J.H.	D.R.R.	D.R.R.	MUX_BOX UPDATED
C	02/07/99	D.P.	A.J.H.	D.R.R.	D.R.R.	GENERAL UPDATE

PLANT	FINA DERV RAIL LOADING SYSTEM
TITLE	MUX 1 & 2 PANEL LOOP
DATE	02/07/99
CLIENT DRG. No.	P&I DRG No. SI039012

INSTRUMENT LOOP SHEET FOR USE IN HAZARDOUS AREA  
 SHEET 01 OF 01

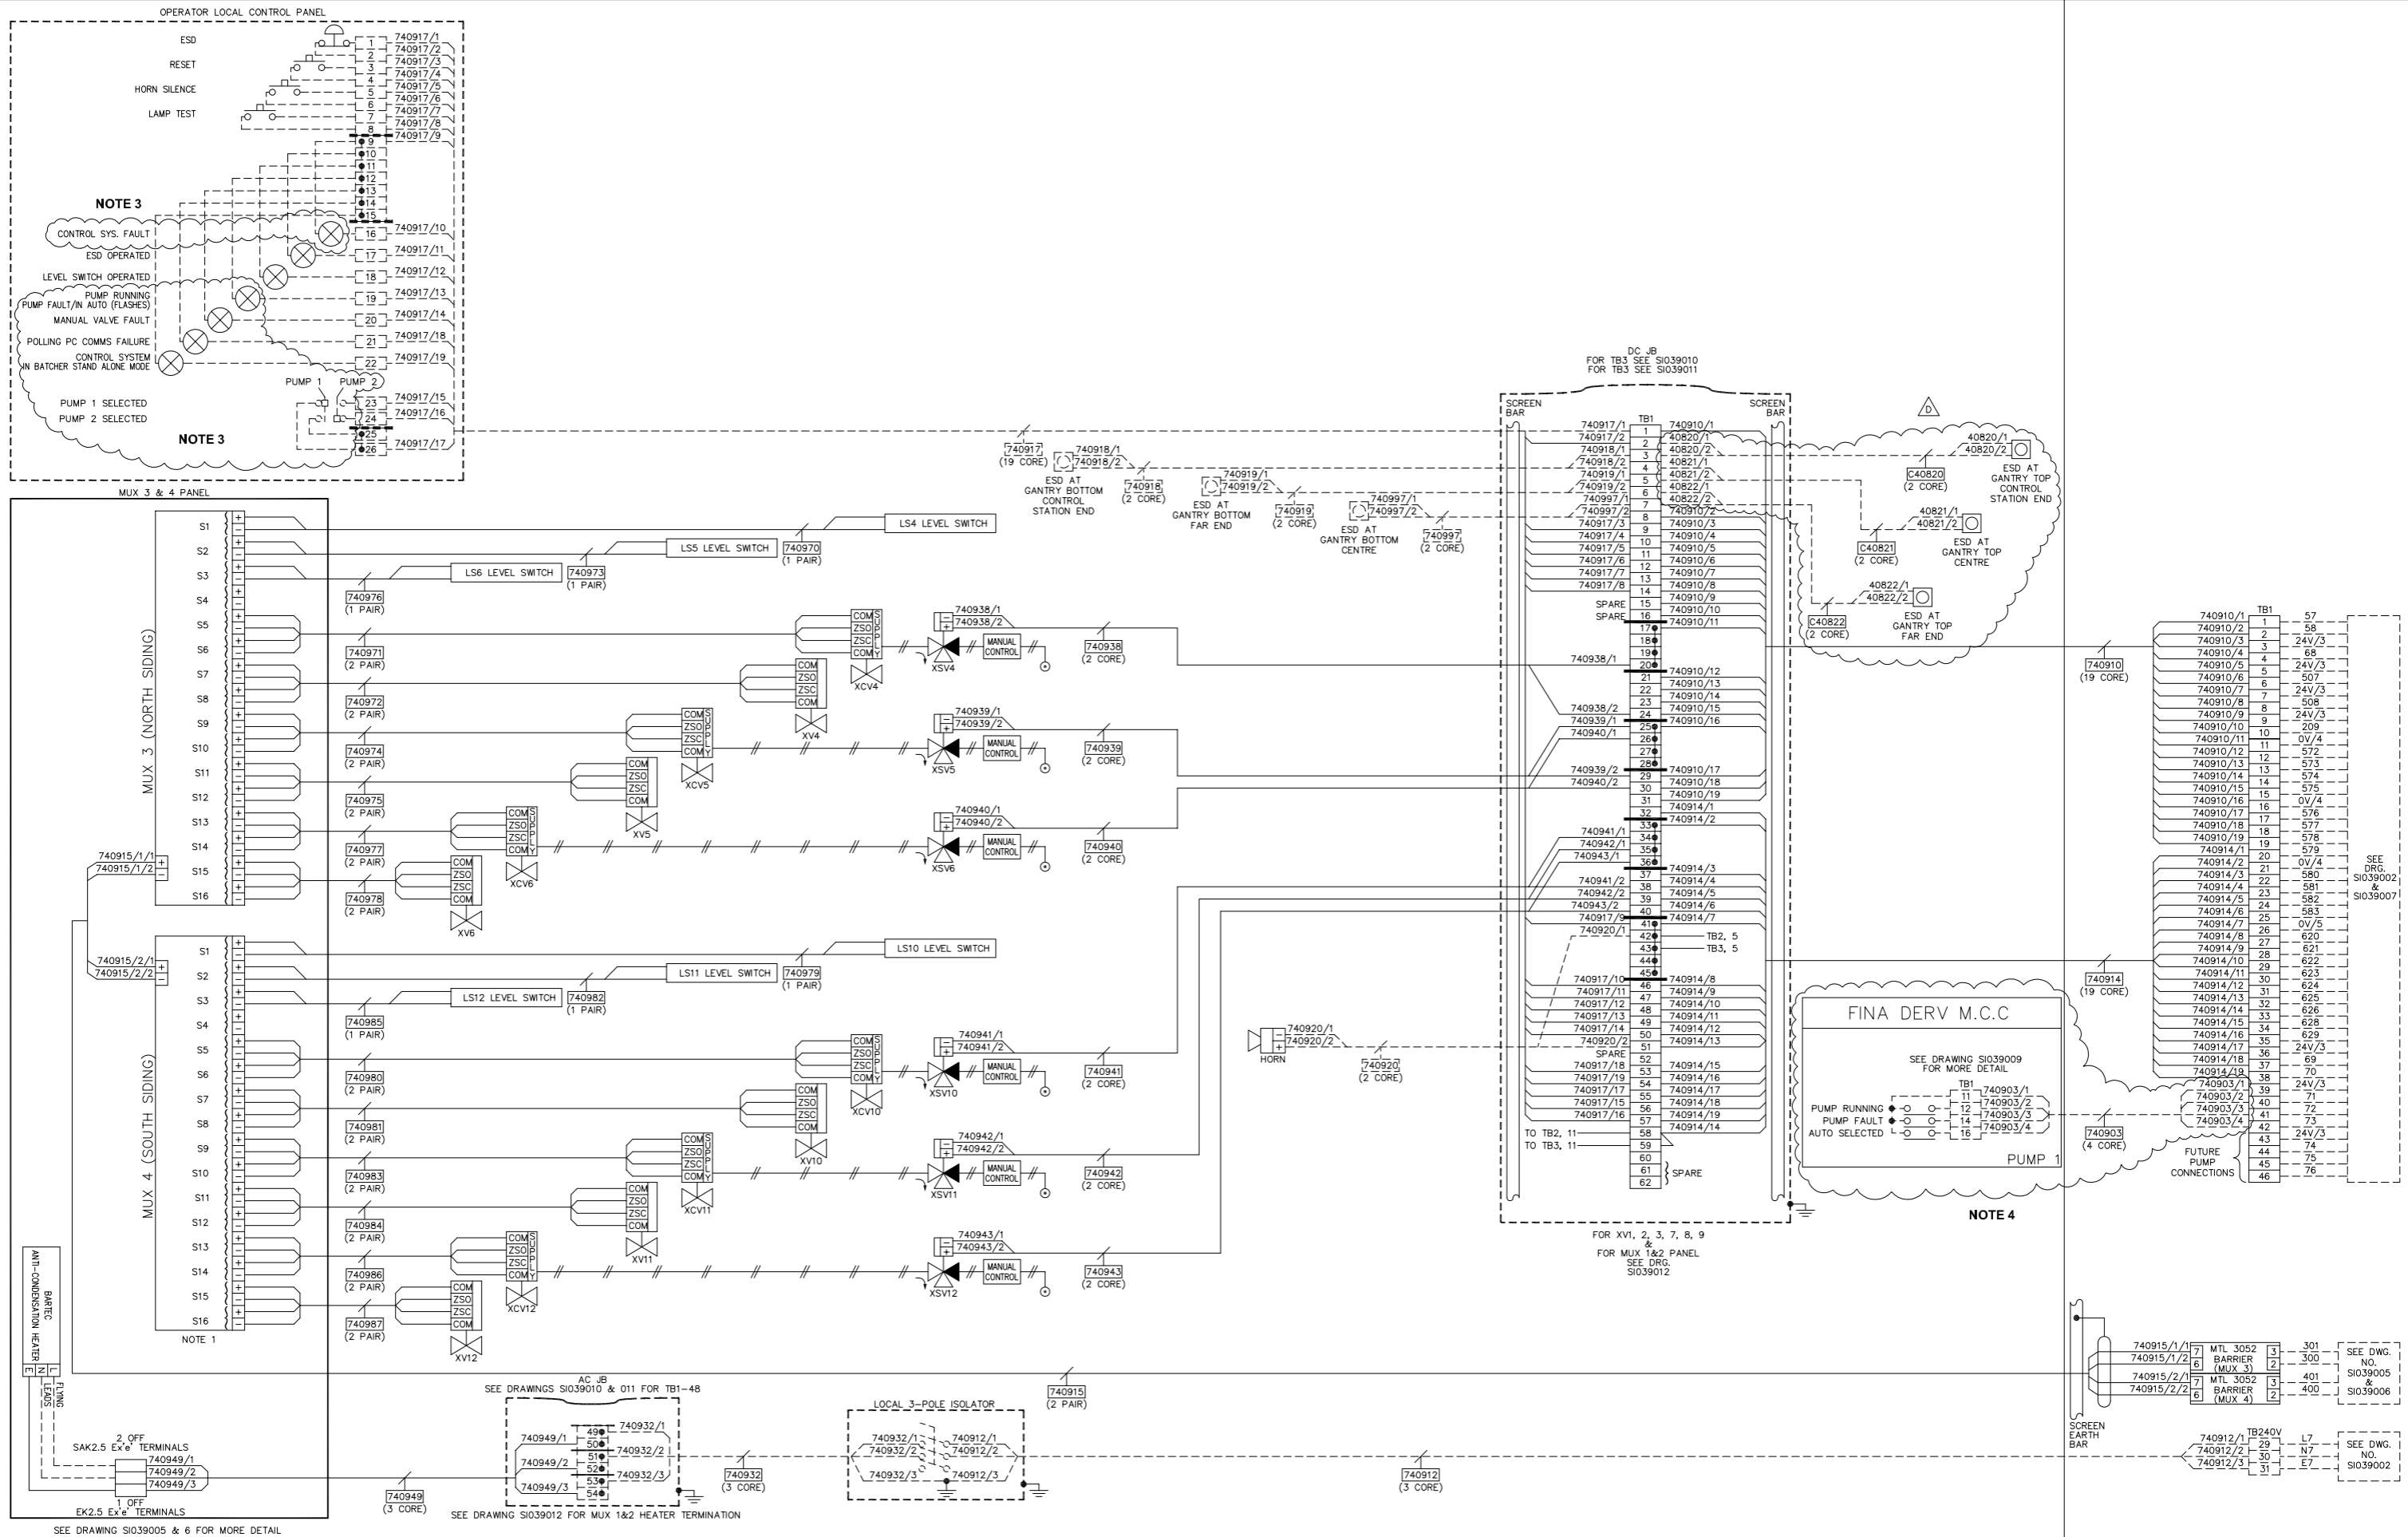

SAFETY PROTECTION REQUIRED	FLAMEPROOF & INCREASED SAFETY	CERTIFIED EQUIPMENT				CERTIFIED EQUIPMENT				
	ZONE 1	TAG No.	CERTIFICATE No.	CERTIFICATION AUTHORITY	TAG No.	CERTIFICATE No.	CERTIFICATION AUTHORITY	TAG No.	CERTIFICATE No.	CERTIFICATION AUTHORITY
GAS GROUP	IIB									
TEMPERATURE CLASS	T3									


- NOTES**
- ALL SCREENS NOT SHOWN FOR CLARITY.
  - FOR COMMUNICATION INTERCONNECTIONS SEE DRAWING SI039014.
  - LAMPS, SELECTOR SWITCH & ASSOCIATED WIRING HIGHLIGHTED TO BE REMOVED FROM THE LOCAL CONTROL PANEL & THE HOLES BLANKED.
  - DECOMMISSIONED BATCHING SYSTEM.



IF NOT SIGNED THIS DOCUMENT IS UNCONTROLLED

REV	DATE	BY	DRN	CHK'D	APP'D	DESCRIPTION
A	08/04/99	A.J.H.	A.J.H.	D.R.R.	D.R.R.	ORIGINAL ISSUE
B	15/04/99	A.J.H.	A.J.H.	D.R.R.	D.R.R.	MUX BOX UPDATED
C	02/07/99	D.P.	A.J.H.	D.R.R.	D.R.R.	GENERAL UPDATE
D	14/09/10	D.B.F.	P.P.	M.M.	M.M.	SI760 MODIFICATIONS

PLANT	IMMINGHAM STORAGE Co. - EAST TERMINAL		
TITLE	4-EAST RAIL LOADING SYSTEM MUX 3 & 4 PANEL LOOP		
CLIENT DRG. No.	IMMINGHAM STORAGE Co. Ltd. IMMINGHAM EAST TERMINAL, IMMINGHAM, SOUTH HUMBERSIDE	P & I DESIGN	SEE DWG. NO. SI039005 & SI039006
SHEET 1 OF 1	P&I DESIGN Ltd. Tel: 01642 617444 www.pidesign.co.uk		

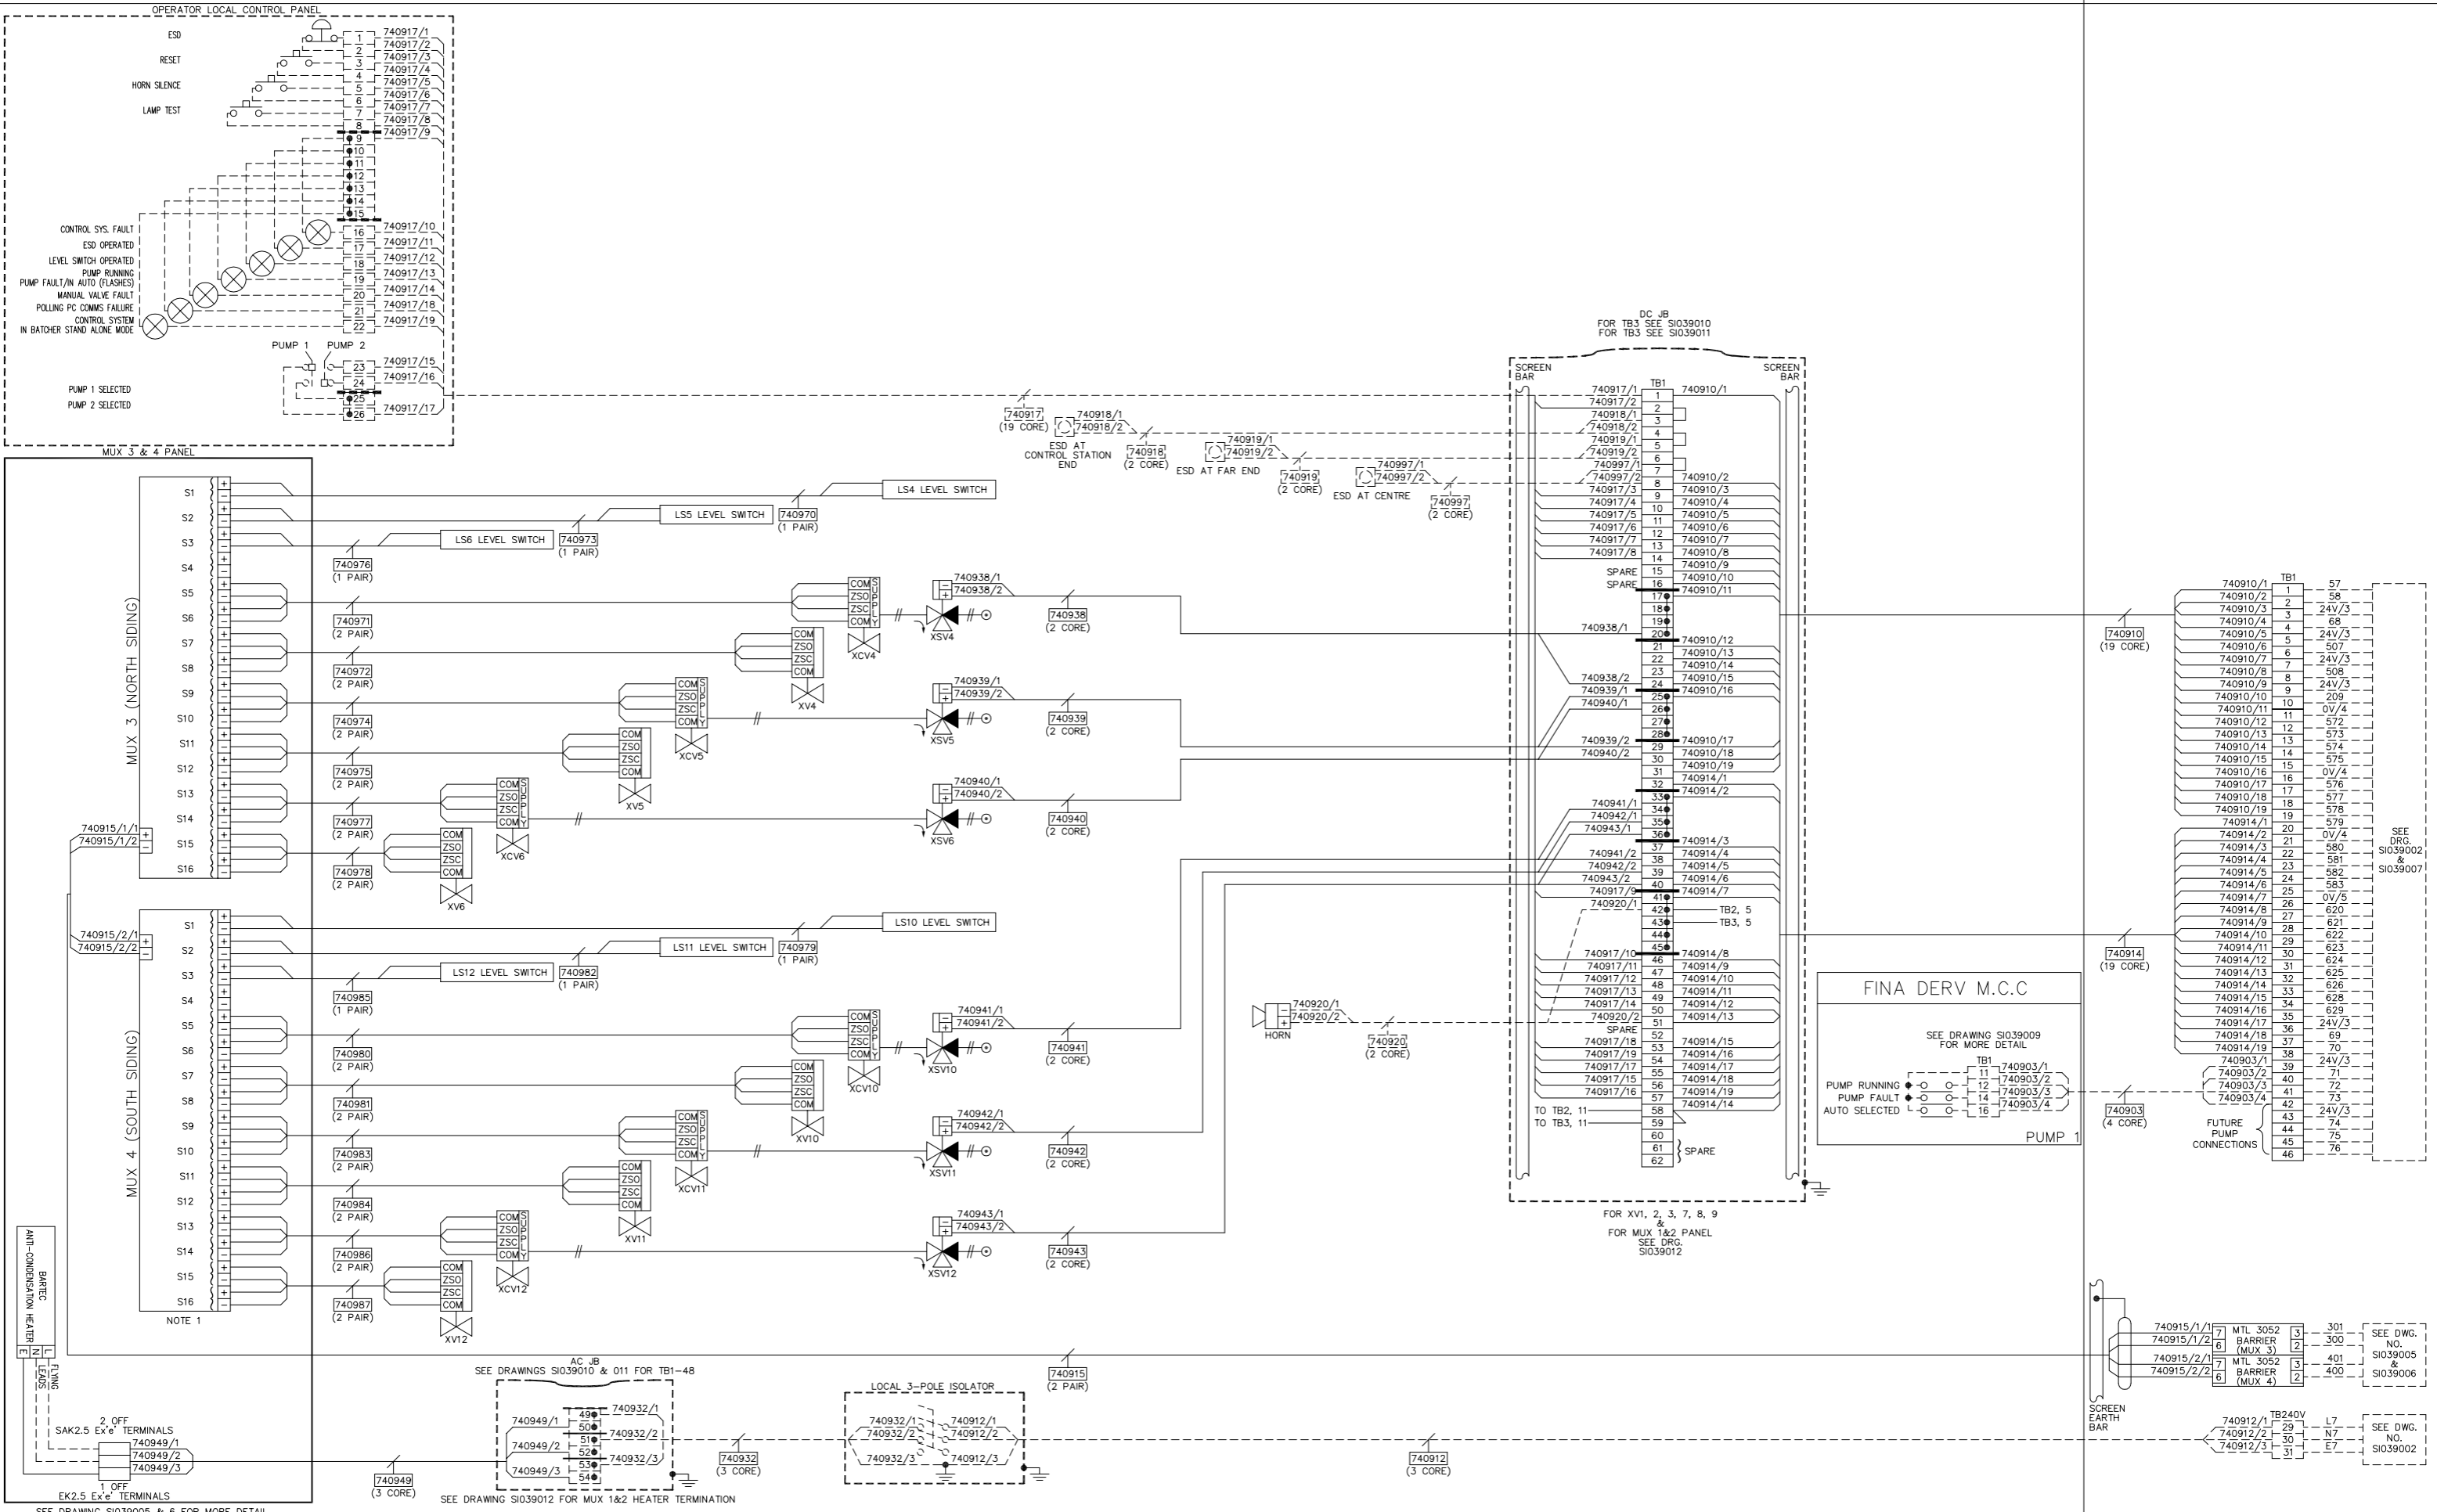

SEE DRAWING SIO39005 & 6 FOR MORE DETAIL

NOTE 1

AC JB SEE DRAWINGS SIO39010 & 011 FOR TB1-48

LOCAL 3-POLE ISOLATOR


SEE DRAWING SIO39012 FOR MUX 1&2 HEATER TERMINATION

FLAMEPROOF & SAFETY PROTECTION INCREASED SAFETY	REQUIRED	Achieved	XXXX
AREA CLASS	ZONE 1		
GAS GROUP	IIB		XXXX
TEMPERATURE CLASS	T3		XXXX



CERTIFIED EQUIPMENT				CERTIFIED EQUIPMENT			
TAG No.	CERTIFICATE No.	CERTIFICATION AUTHORITY		TAG No.	CERTIFICATE No.	CERTIFICATION AUTHORITY	

NOTES  
 1. ALL SCREENS NOT SHOWN FOR CLARITY  
 2. FOR COMMUNICATIONS INTERCONNECTIONS SEE DRAWING SIO39014

DC JB FOR TB3 SEE SIO39010 FOR TB3 SEE SIO39011

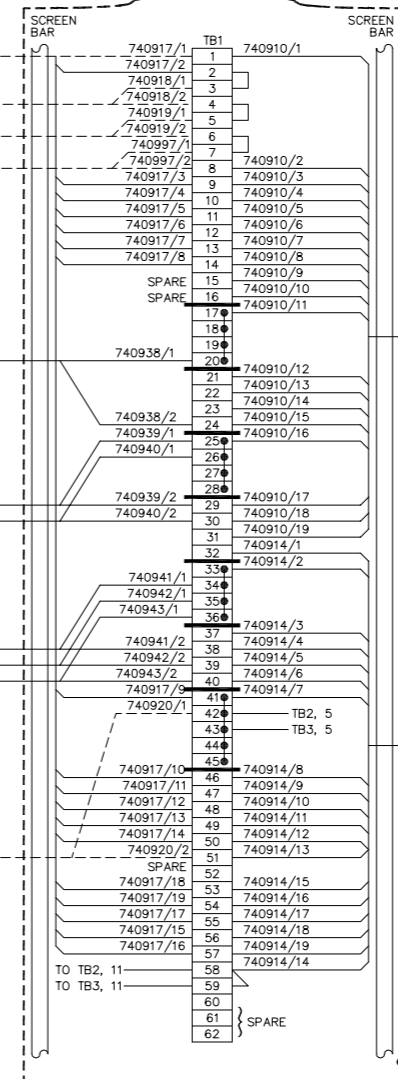

FOR XVI, 2, 3, 7, 8, 9 & FOR MUX 1&2 PANEL SEE DRG. SIO39012

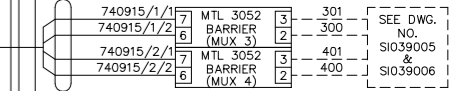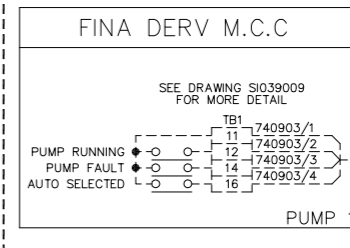

SEE DWG. NO. SIO39005 & SIO39006

SEE DWG. NO. SIO39002

REV	DATE	BY	DRN	CHK'D	APP'D	DESCRIPTION	PLANT	FINA DERV RAIL OFFLOADING SYSTEM
A	08/04/99	A.J.H.	A.J.H.	D.R.R.	D.R.R.	D.R.R.	ORIGINAL ISSUE	
B	15/04/99	A.J.H.	A.J.H.	D.R.R.	D.R.R.	D.R.R.	MUX_BOX UPDATED	
C	02/07/99	D.P.	A.J.H.	D.R.R.	D.R.R.		GENERAL UPDATE	

CLIENT DRG. No.	P&I DRG No. SIO39013
-----------------	----------------------

INSTRUMENT LOOP SHEET FOR USE IN HAZARDOUS AREA  
 SHEET 01 OF 01

RAIL LOADING SIDING


COMMUNICATIONS INTERFACE PANEL

DANLOAD 6000

DC JUNCTION BOX

LINE TERMINATION CABINET

PROTOCOL MANAGEMENT UNIT

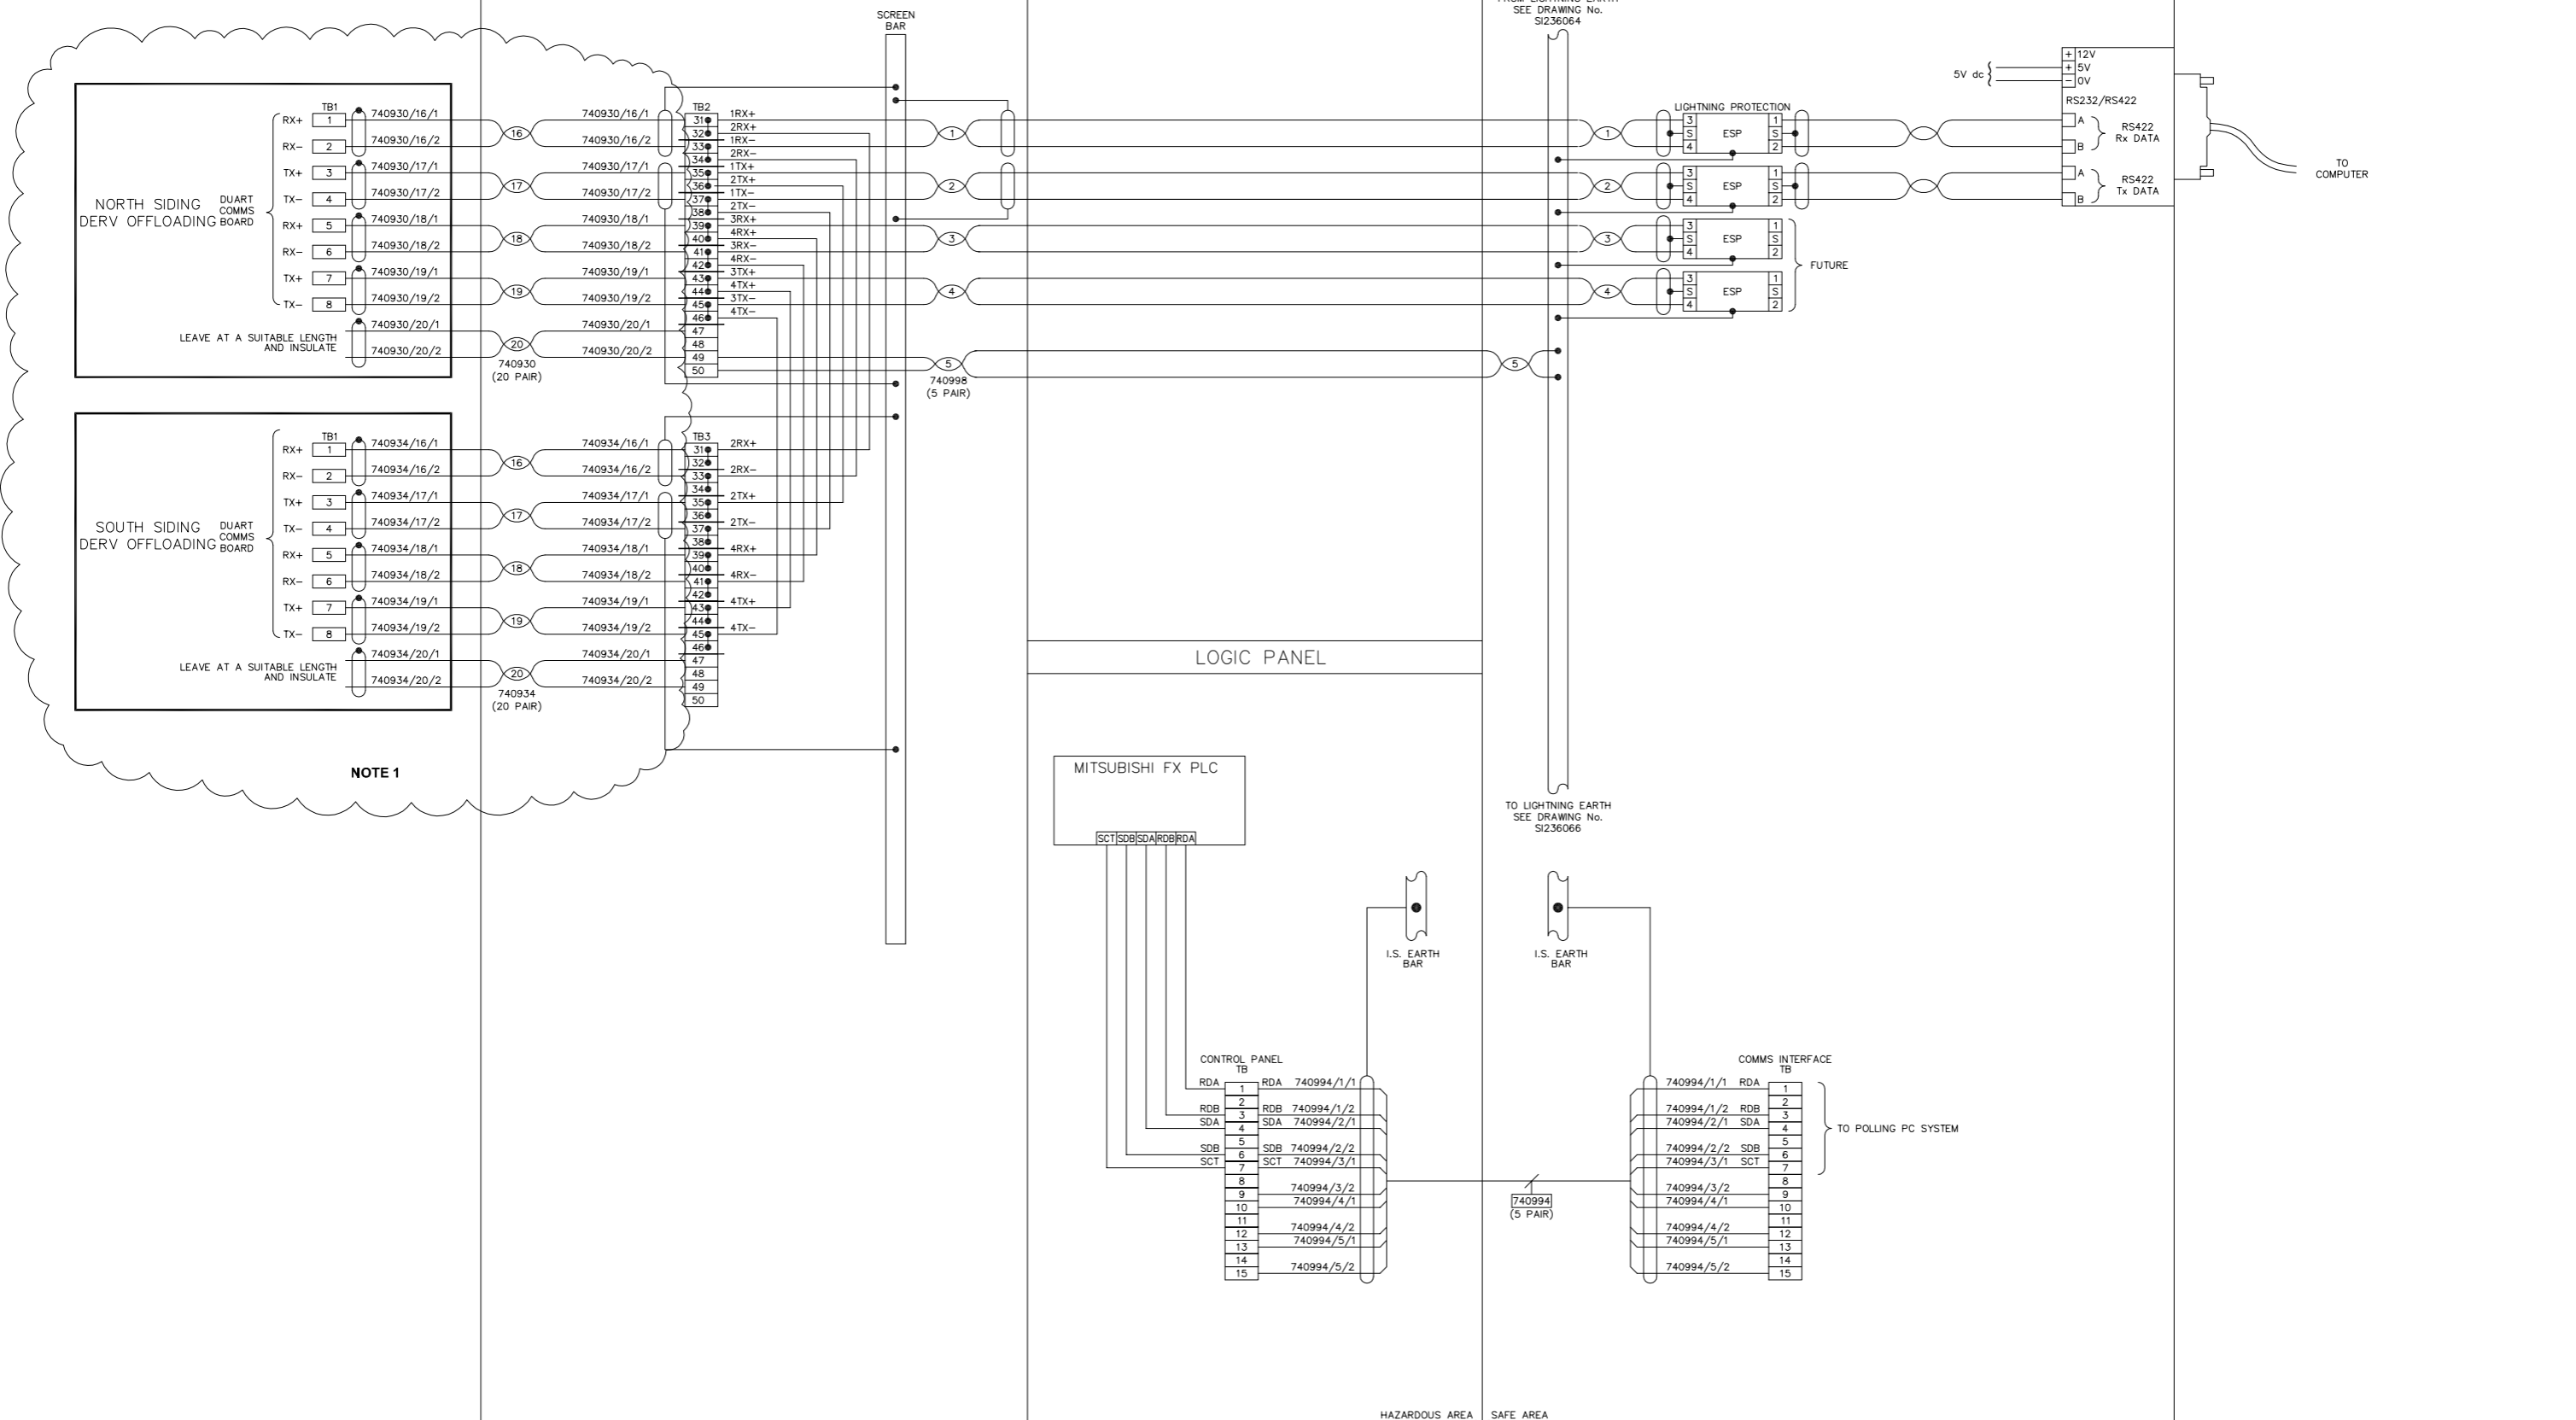

NOTE 1

NOTES  
1. DECOMMISSIONED BATCHING SYSTEM. FIELD EQUIPMENT REMOVED.



IF NOT SIGNED THIS DOCUMENT IS UNCONTROLLED

REV	DATE	BY	DRN	CHK'D	APP'D	DESCRIPTION
A	07/04/99	A.J.H	A.J.H	D.R.R	D.R.R	ORIGINAL ISSUE
B	13/07/99	A.J.H	A.J.H	D.R.R	D.R.R	CABLE 740994 ADDED
C	14/09/10	D.B.F	P.P.	M.M.	M.M.	SI760 MODIFICATIONS

PLANT	IMMINGHAM STORAGE Co. - EAST TERMINAL
TITLE	4-EAST RAIL LOADING SYSTEM DANLOAD TO PC COMMUNICATIONS DIAGRAM
CLIENT DRG. No.	IMMINGHAM STORAGE Co. Ltd. IMMINGHAM EAST TERMINAL, IMMINGHAM DOCK, IMMINGHAM, SOUTH HUMBERSIDE
	<b>P &amp; I DESIGN</b> P & I Design Ltd Tel. 01642 617444 www.pidesign.co.uk
	SHEET 1 OF 1
	P&I DRG No. SI039014_DWG



RAIL LOADING SIDING






COMMUNICATIONS INTERFACE PANEL

DANLOAD 6000

DC JUNCTION BOX

LINE TERMINATION CABINET

PROTOCOL MANAGEMENT UNIT

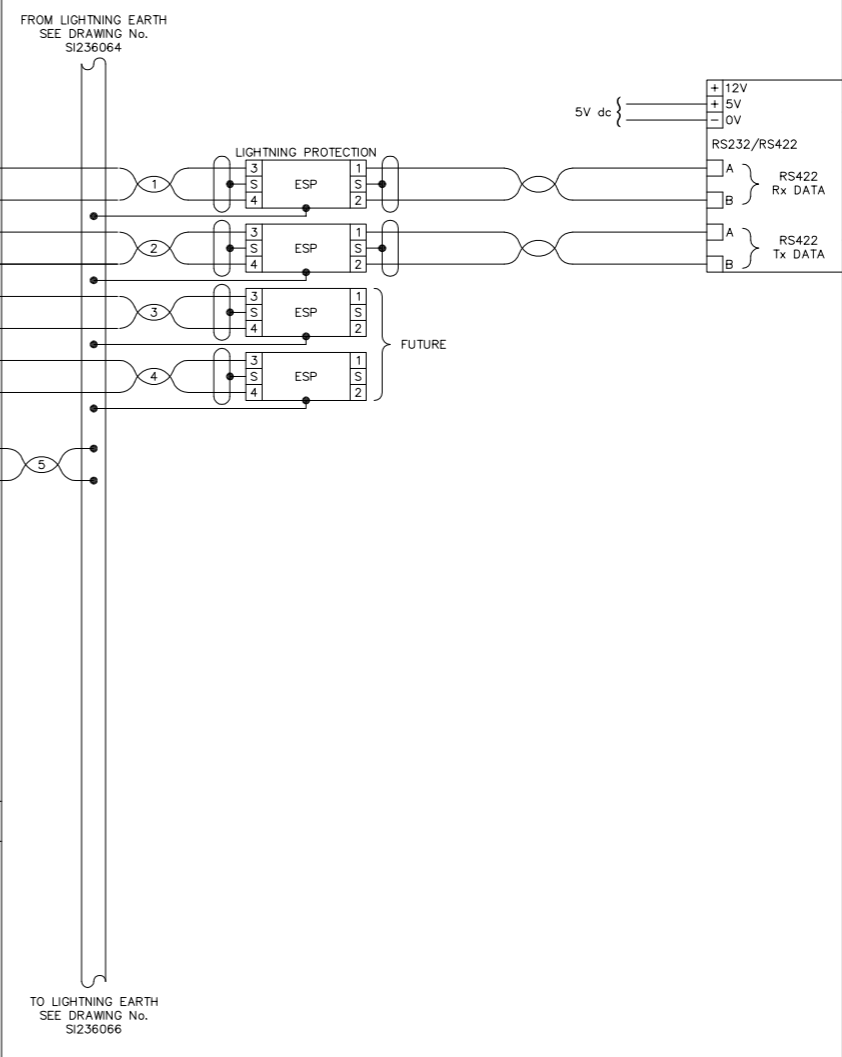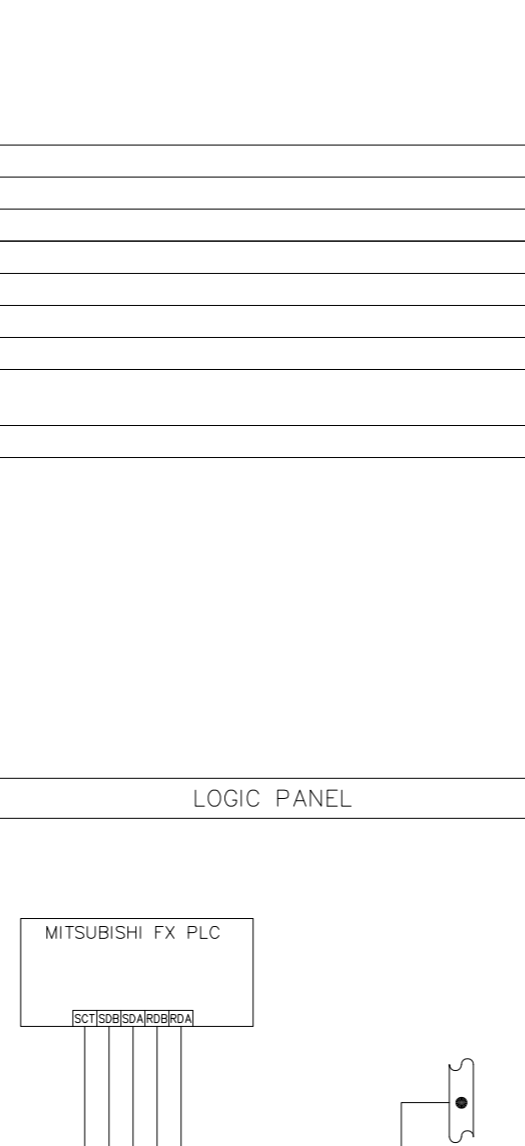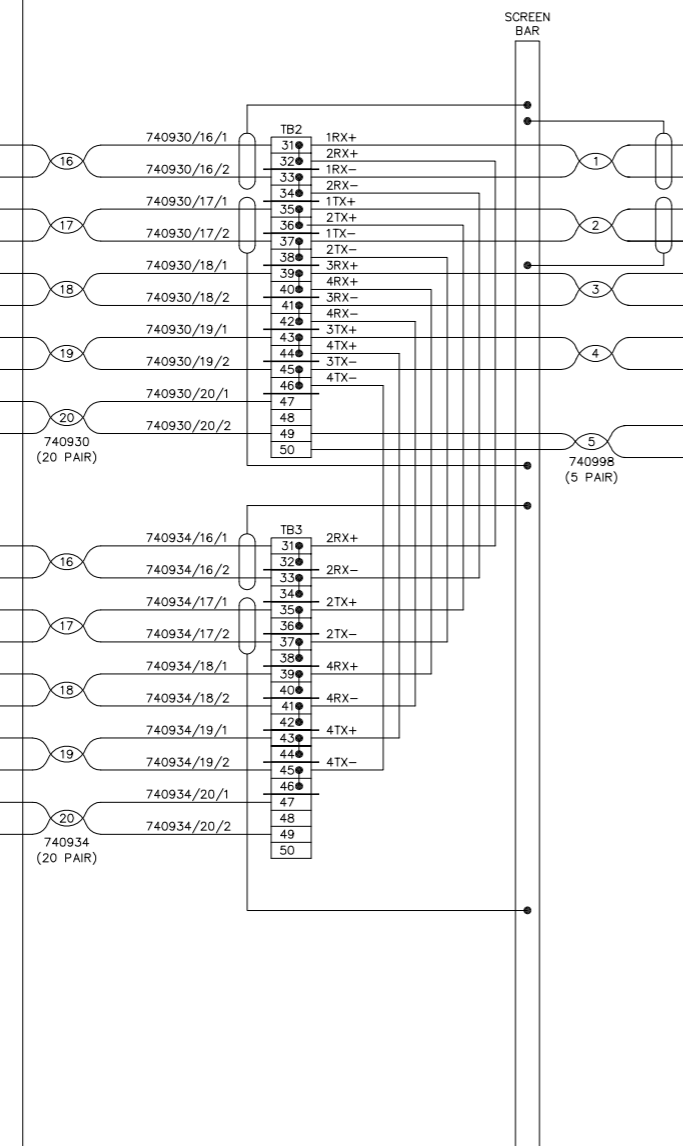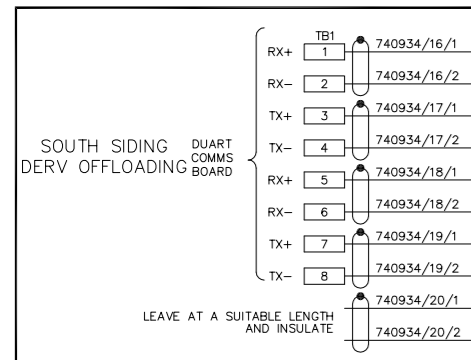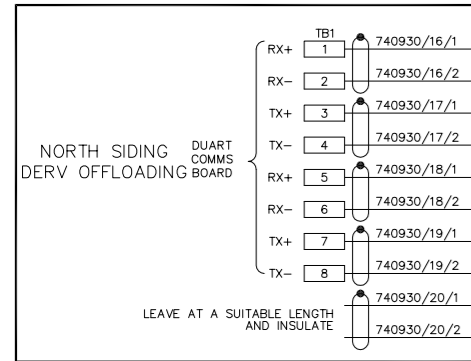

REV	DATE	BY	DRN	CHK'D	APP'D	DESCRIPTION	PLANT	FINA DERV RAIL LOADING SYSTEM
A	07/04/99	A.J.H	A.J.H	D.R.R	D.R.R	ORIGINAL ISSUE	TITLE	DANLOAD TO PC COMMUNICATIONS DIAGRAM
B	13/07/99	A.J.H	A.J.H	D.R.R	D.R.R	CABLE 740994 ADDED	13/07/99	

<b>Simon Storage</b>	IMMINGHAM STORAGE Co Ltd, IMMINGHAM EAST TERMINAL, IMMINGHAM DOCK, IMMINGHAM, SOUTH HUMBERSIDE	<b>P &amp; I DESIGN</b>
SHEET 01 OF 01		CLIENT DRG. No. P&I DRG No. SIO39014






No.5 SWITCHROOM

FIELD

MCC 5/2 COMPARTMENT A1

JB5/61

PUMP RAFT

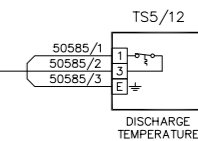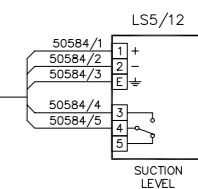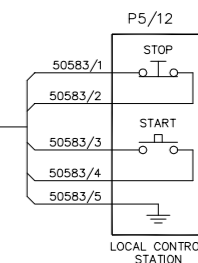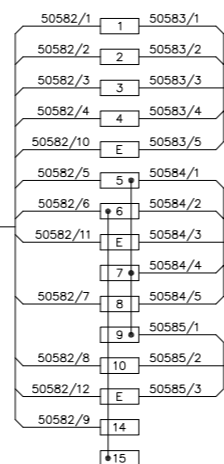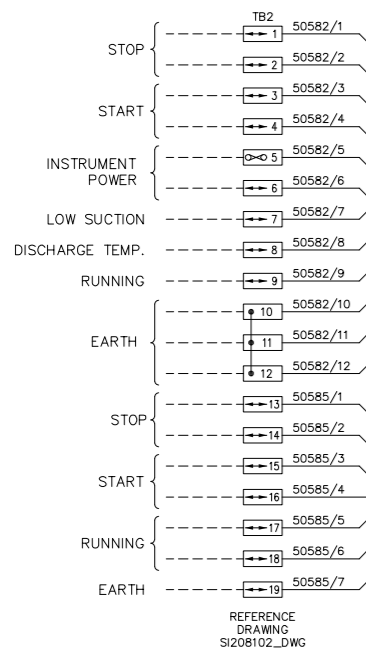

4-EAST RAIL LOADING GANTRY





No.4 SWITCHROOM

GANTRY TOP - BUFFER END CONTROL STATION

GANTRY TOP - CENTRE CONTROL STATION

GANTRY TOP - FAR END CONTROL STATION

4E RAIL LOADING LOGIC PANEL

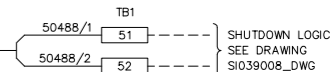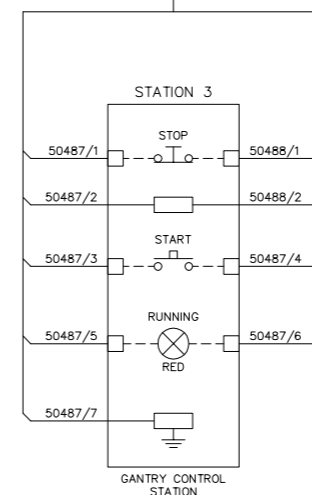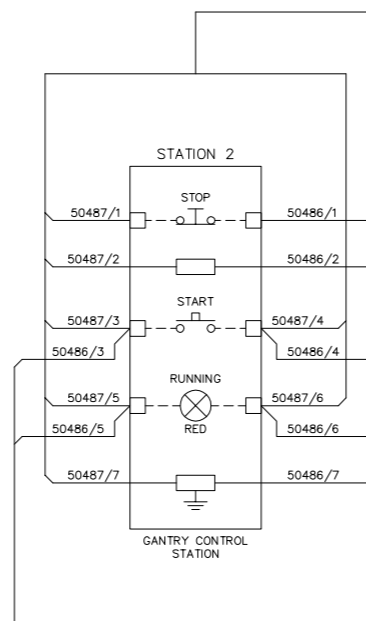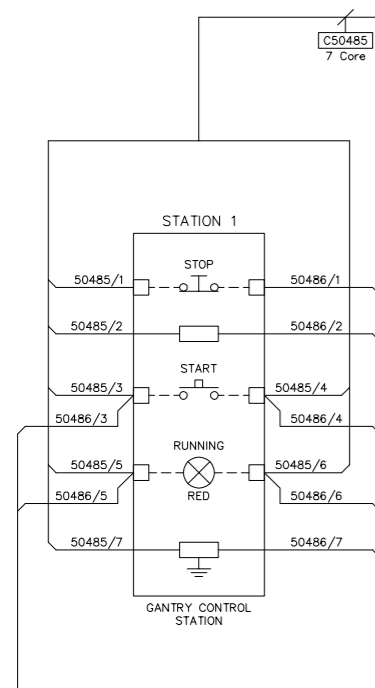

NOTES  
1)



IF NOT SIGNED THIS DOCUMENT IS UNCONTROLLED



REV	DATE	BY	DRN	CHK'D	APP'D	DESCRIPTION
A	01/10/10	P.P.	P.P.	D.B.F	M.M.	ISSUED FOR CONSTRUCTION

PLANT	IMMINGHAM STORAGE Co. - EAST TERMINAL
TITLE	4-EAST RAIL LOADING SYSTEM - PUMP P5/12 CONTROL JUNCTION BOX INTERCONNECTION DETAILS
CLIENT DRG. No.	P&I DRG No. SI76002_DWG

IMMINGHAM STORAGE Co. Ltd.  
IMMINGHAM EAST TERMINAL,  
IMMINGHAM DOCK,  
IMMINGHAM,  
SOUTH HUMBERSIDE

P & I DESIGN  
Tel. 01642 617444  
www.ptdesign.co.uk

SHEET 1 OF 1

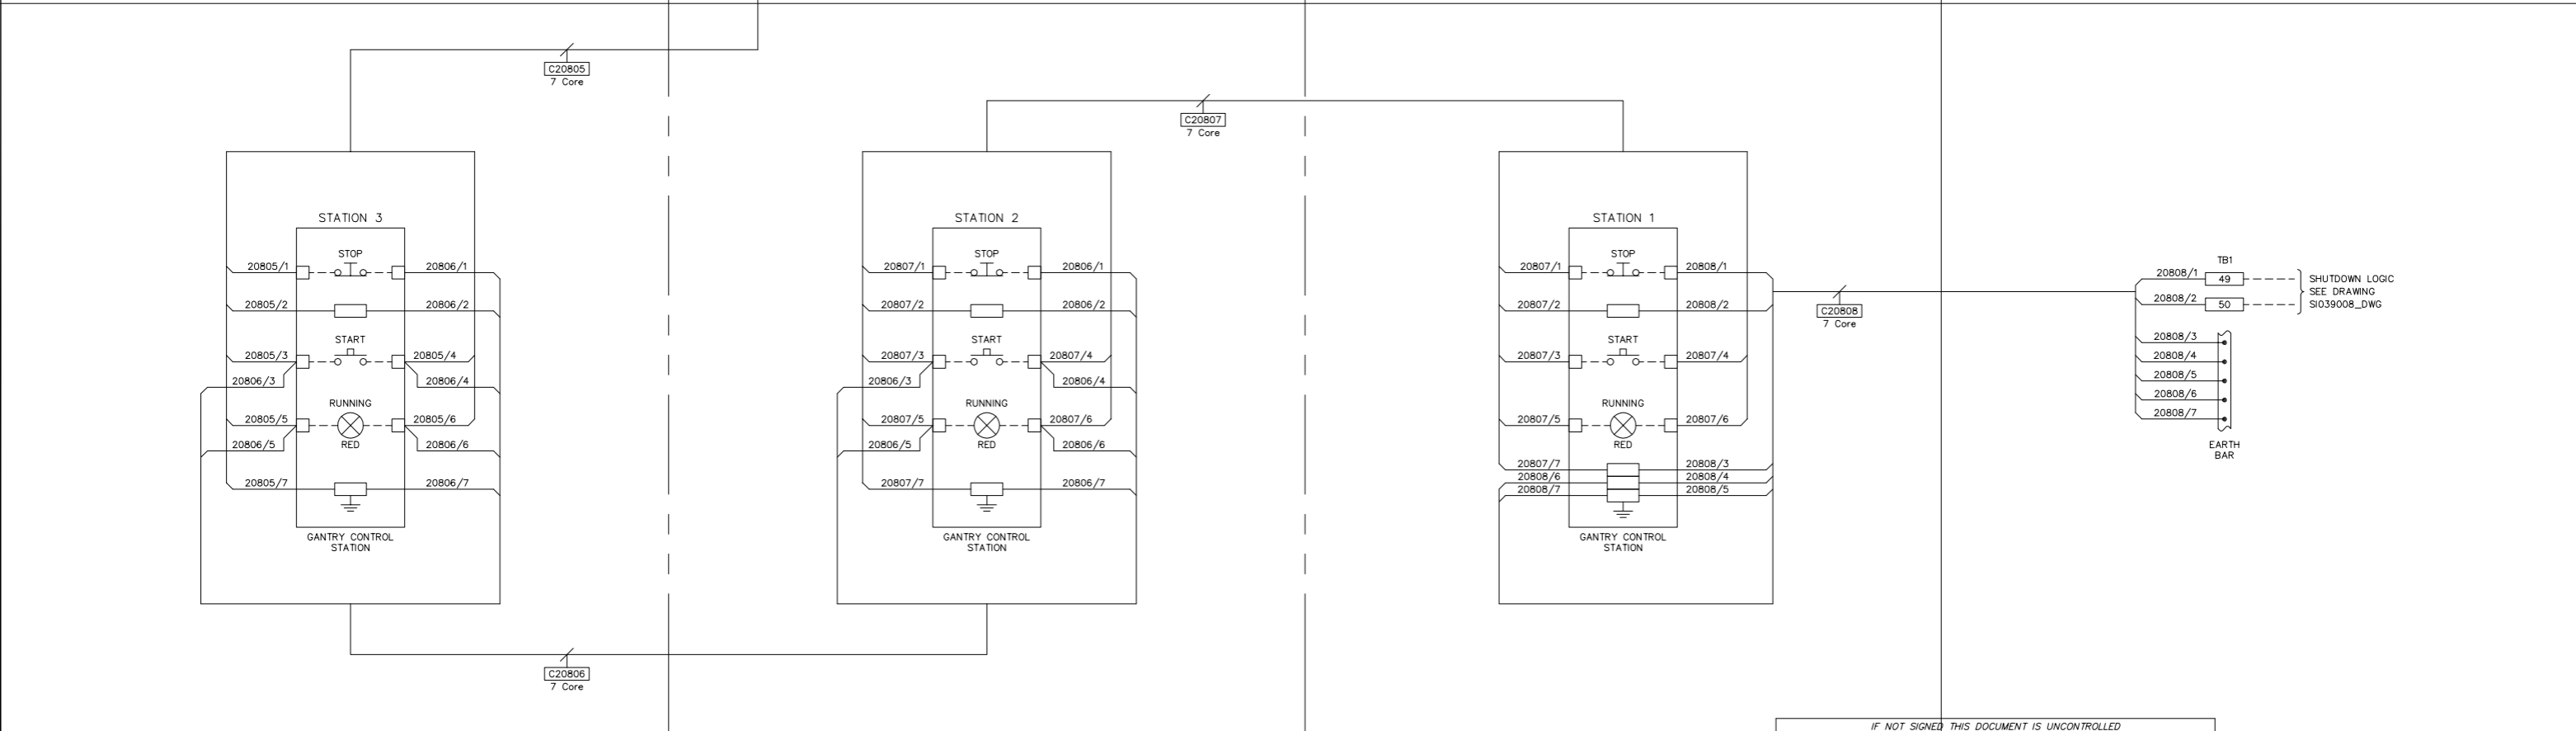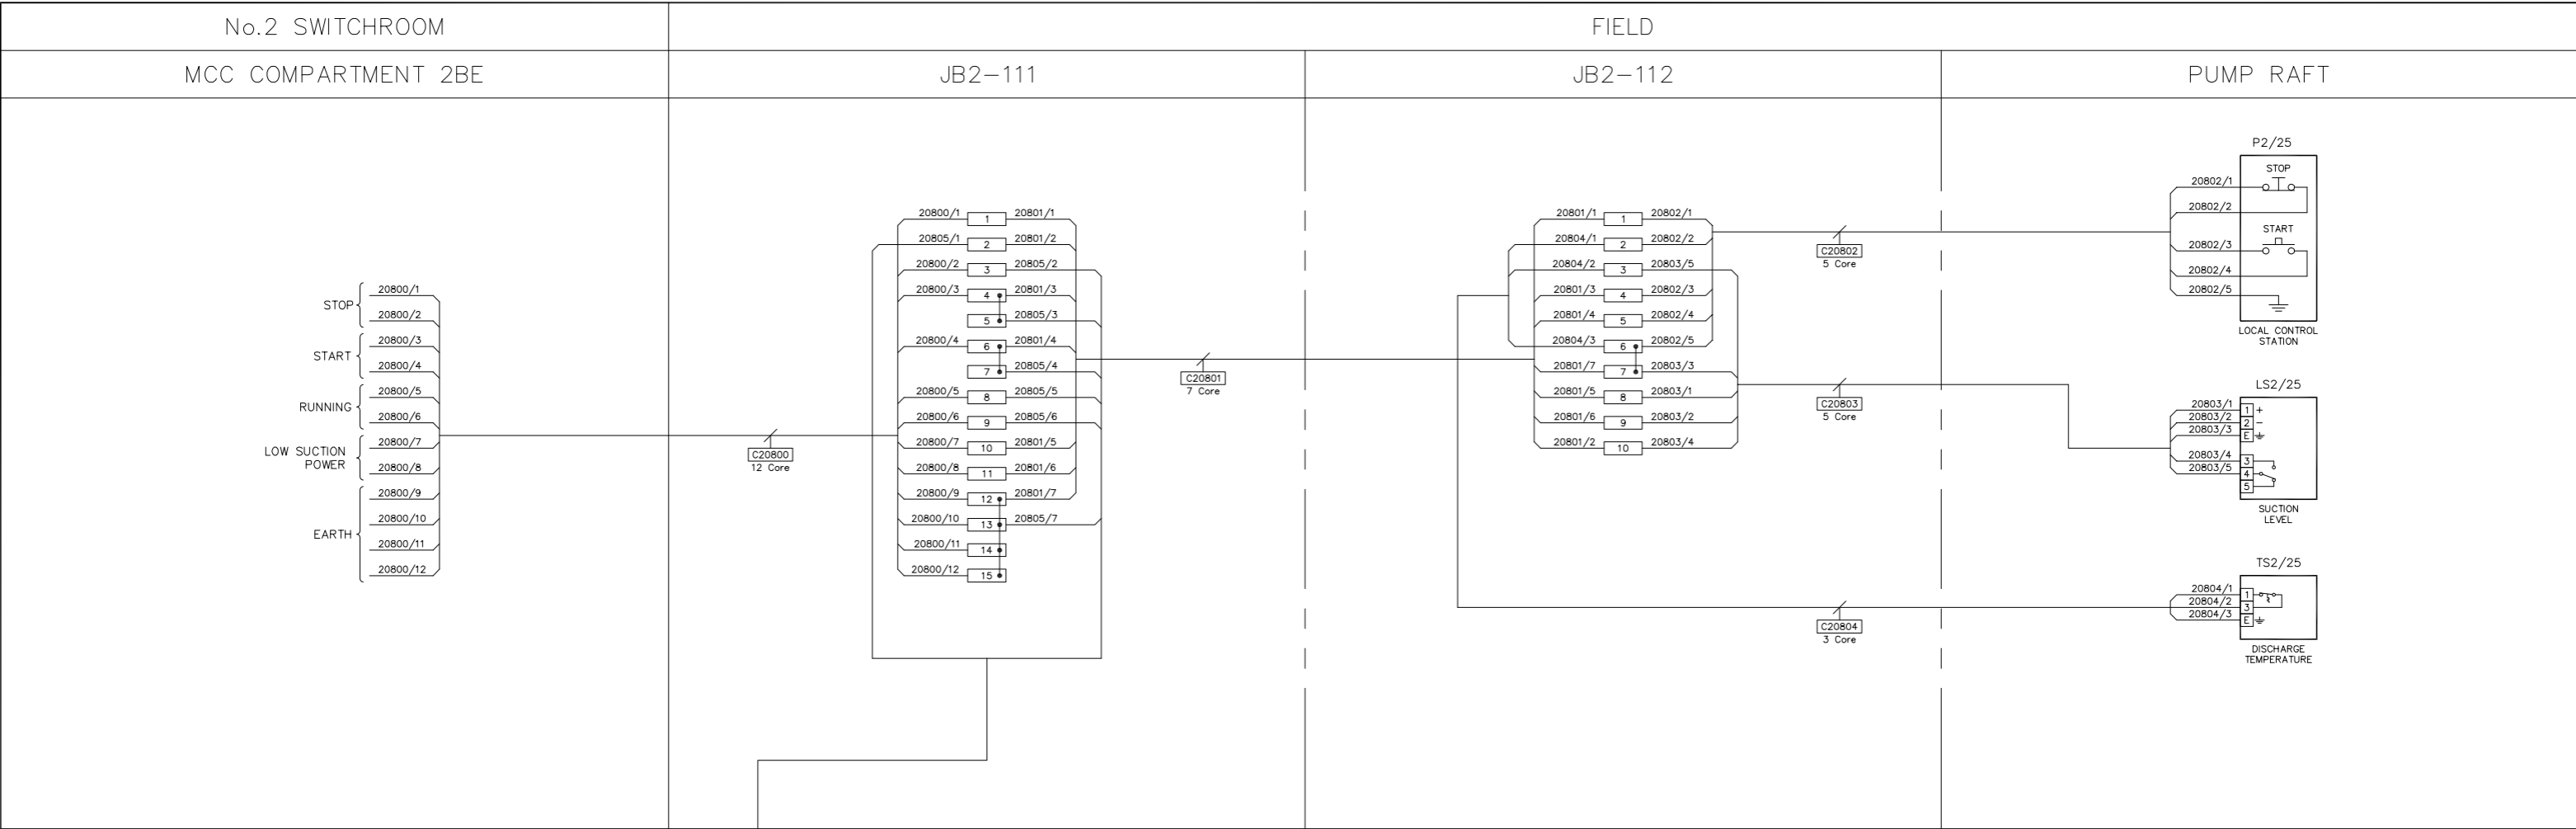

NOTES  
1)




IF NOT SIGNED THIS DOCUMENT IS UNCONTROLLED


REV	DATE	BY	DRN	CHK'D	APP'D	DESCRIPTION
A	01/10/10	P.P.	P.P.	D.B.F	M.M.	ISSUED FOR CONSTRUCTION

PLANT	IMMINGHAM STORAGE Co. - EAST TERMINAL
TITLE	4-EAST RAIL LOADING SYSTEM - PUMP P2/25 CONTROL JUNCTION BOX INTERCONNECTION DETAILS
CLIENT DRG. No.	P&I DRG No. SI760001_DWG

SHEET 1 OF 1

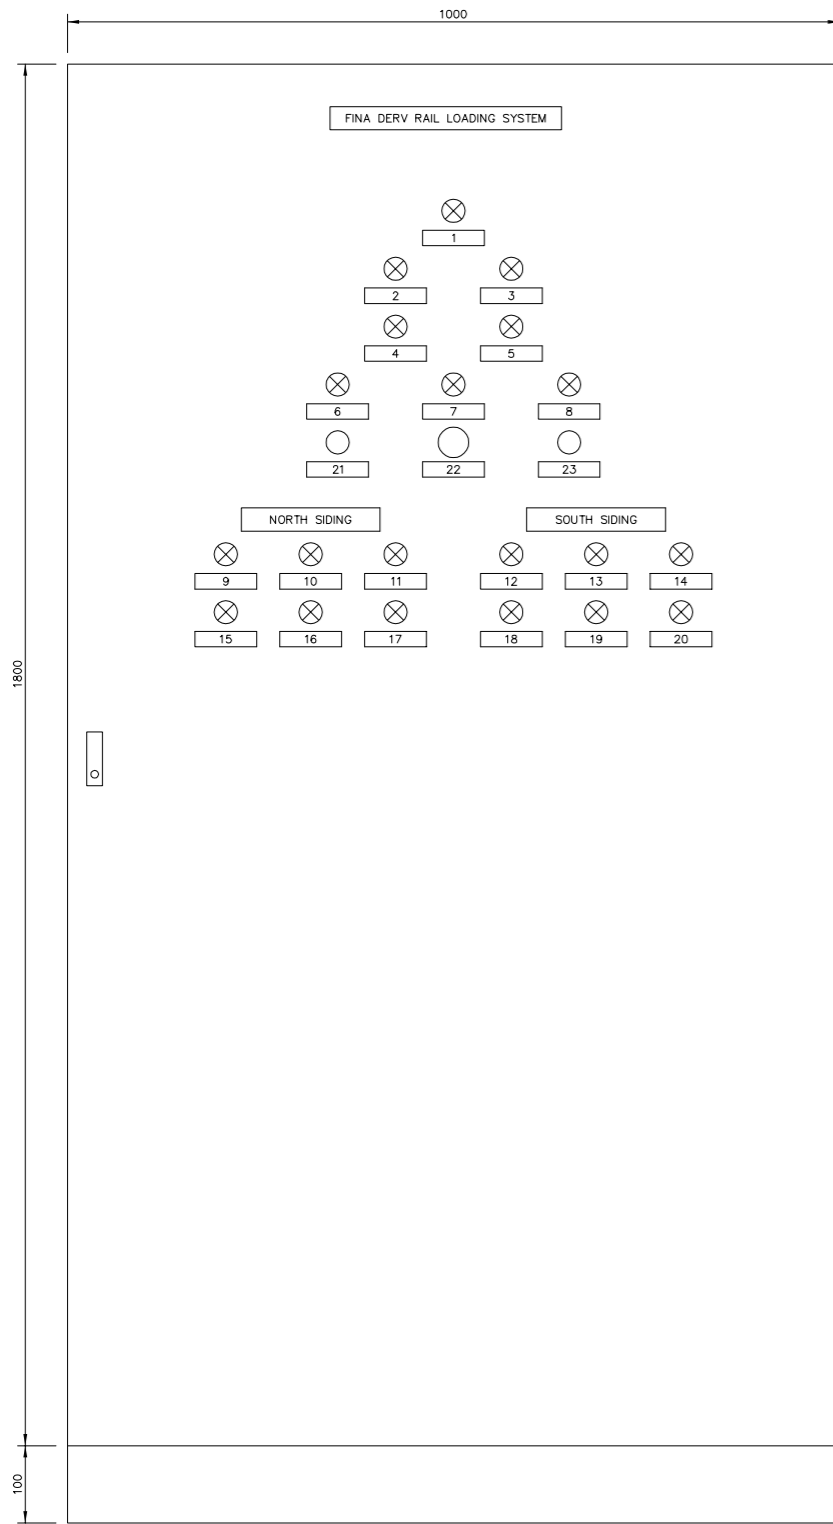


RITTAL ES 5084.600  
FRONT OF PANEL LAYOUT

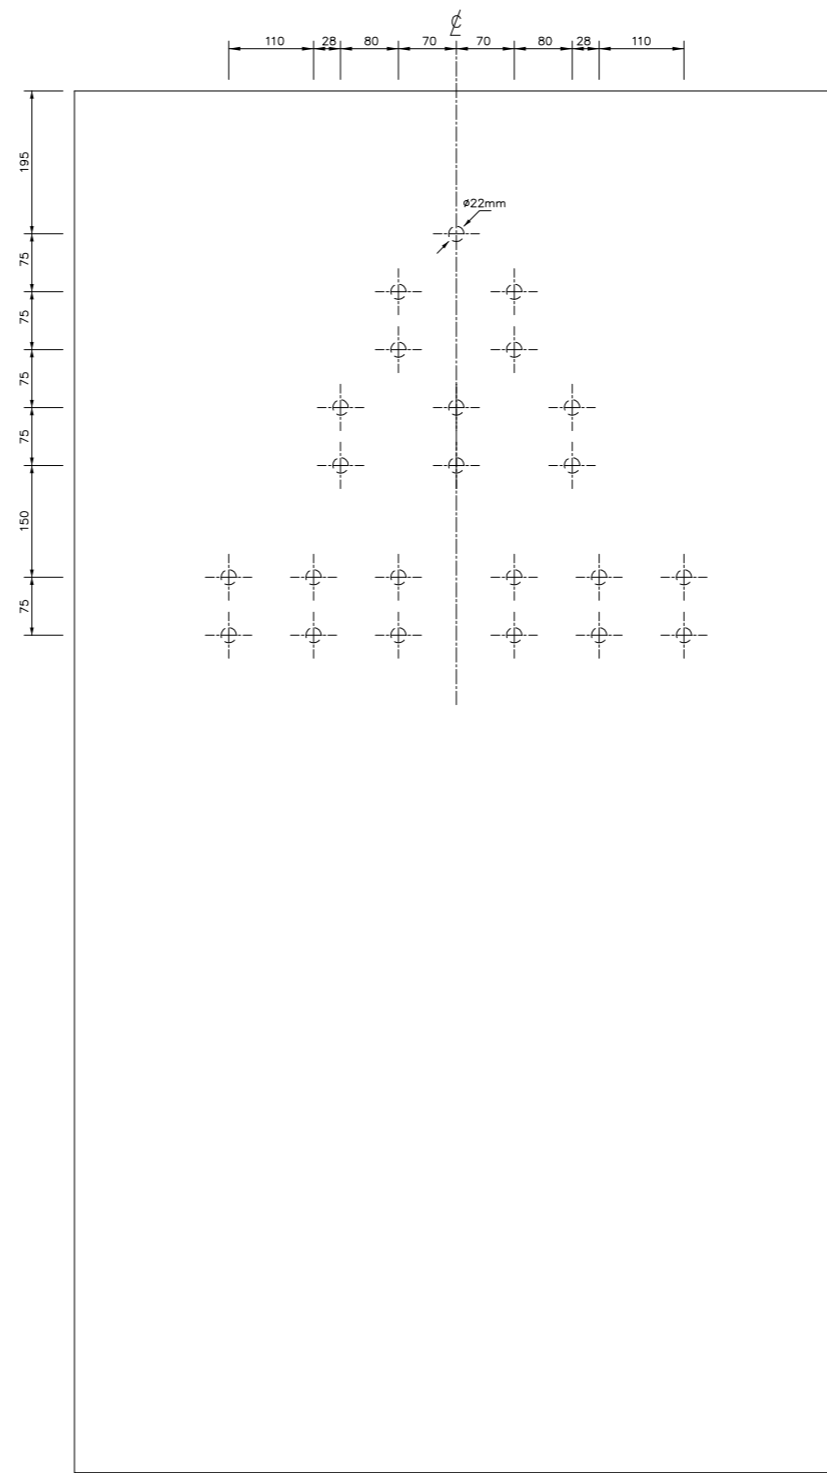

CUT-OUT DETAILS

LOCATION	QUANTITY	DESCRIPTION	STOCK CODE
A	38	RS 4-POLE RELAYS, 24Vdc COIL	RS 213-0793
B	1	RS 4-POLE TIMER RELAYS, 24Vdc COIL (ON DELAY)	RS 328-140
C	1	RS 4-POLE TIMER RELAYS, 24Vdc COIL (OFF DELAY)	RS 328-140
D	15	ASK1	XXXX
E	15	SAK 2.5	XXXX
F	12	ASK1	XXXX
G	12	SAK2.5	XXXX
H	12	EK2.5	XXXX
I	4	MTL 3052	XXXX
J	1	ISOLATOR 25A	XXXX
K	4	RS 4 POLE SAFETY RELAYS, 24Vdc COIL	RS 260-4373
L	6	RS 4-POLE RELAYS, 240VAC COIL	RS 213-0838

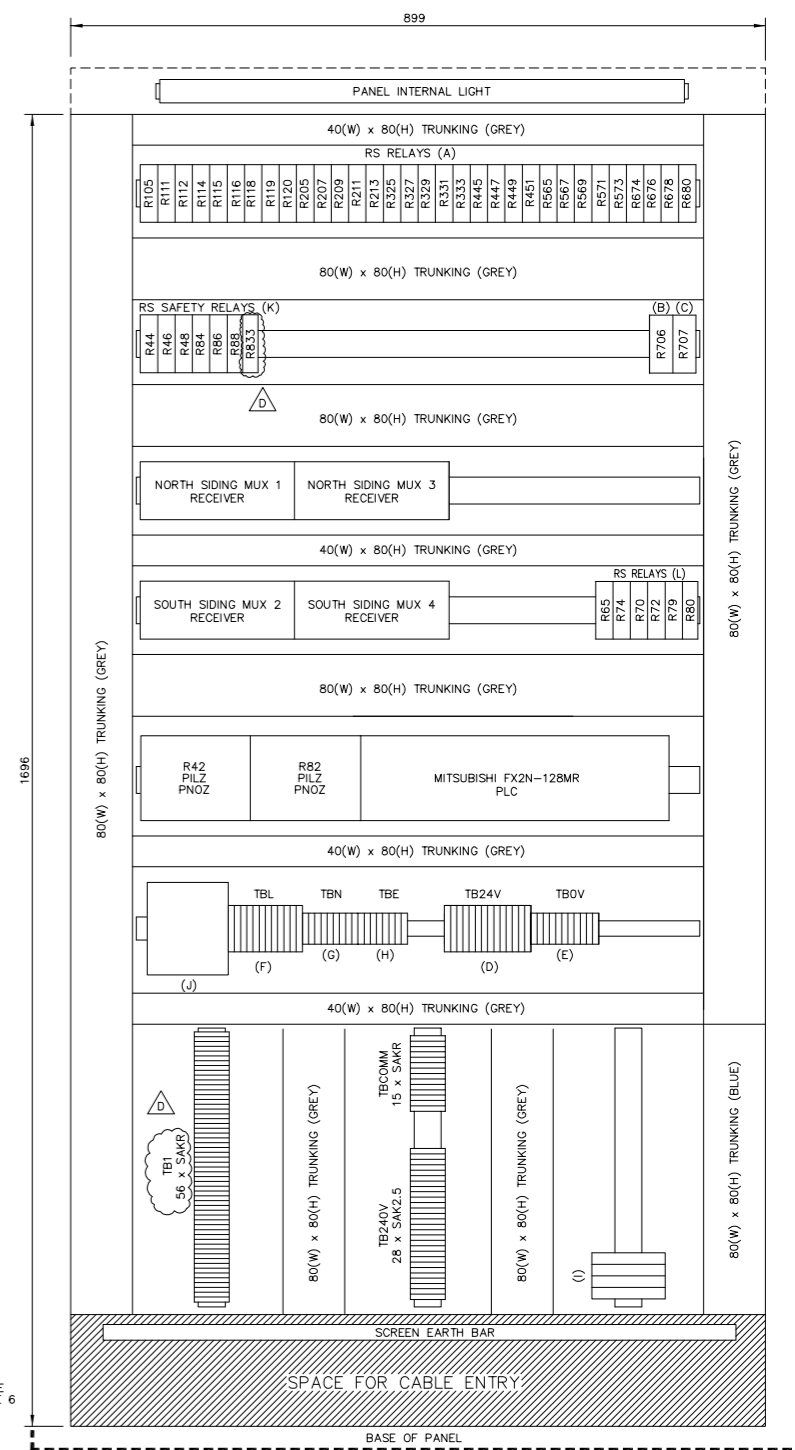

BACKPLATE

LOCATION	LABELS	DETAILS
1		PUMP RUNNING (FLASHES IF NOT IN AUTO OR IN FAULT)
2		POLLING PC COMMS FAILURE
3		CONTROL SYSTEM IN BATCHER STAND ALONE
4		MANUAL VALVE FAULT
5		LEVEL SWITCH OPERATED
6		SYSTEM FAULT
7		ESD OPERATED
8		WATCHDOG FAULT
9		LEVEL SWITCH 1 OPERATED
10		LEVEL SWITCH 2 OPERATED
11		LEVEL SWITCH 3 OPERATED
12		LEVEL SWITCH 7 OPERATED
13		LEVEL SWITCH 8 OPERATED
14		LEVEL SWITCH 9 OPERATED
15		LEVEL SWITCH 4 OPERATED
16		LEVEL SWITCH 5 OPERATED
17		LEVEL SWITCH 6 OPERATED
18		LEVEL SWITCH 10 OPERATED
19		LEVEL SWITCH 11 OPERATED
20		LEVEL SWITCH 12 OPERATED
21		STAND ALONE MODE
22		ESD
23		LAMP TEST

DO NOT SCALE: CONTRACTOR TO CHECK DIMENSIONS AND REPORT ANY OMISSIONS OR ERRORS

- NOTES
- ALL DIMENSIONS IN mm UNLESS OTHERWISE STATED.
  - INGRESS PROTECTION: IP 56
  - CABLE ENTRY: BOTTOM
  - PANEL DEPTH: 400
  - LABELS TO BE WHITE TRAFFOLYTE WITH BLACK ENGRAVING
  - 2-GANG 240VAC SOCKET & COUTANT LAMBDA DRP240-1 PSU TO BE MOUNTED ON THE PANEL SIDE.




IF NOT SIGNED THIS DOCUMENT IS UNCONTROLLED

REV	DATE	BY	DRN	CHK'D	APP'D	DESCRIPTION	
A	08/04/99	A.J.H	A.J.H	D.R.R	D.R.R	D.R.R	ORIGINAL ISSUE
B	14/03/99	A.J.H	A.J.H	D.R.R	D.R.R	D.R.R	GENERAL UPDATE
C	02/07/99	D.P.	A.J.H	D.R.R	D.R.R	D.R.R	TB COMMS ADDED
D	14/09/10	D.B.F	P.P.	M.M.	M.M.		SI760 MODIFICATIONS


PLANT	IMMINGHAM STORAGE Co. - EAST TERMINAL
TITLE	4-EAST RAIL LOADING SYSTEM CONTROL PANEL LAYOUT
CLIENT DRG. No.	P&I DRG No. SI039016_DWG



SHEET 1 OF 1

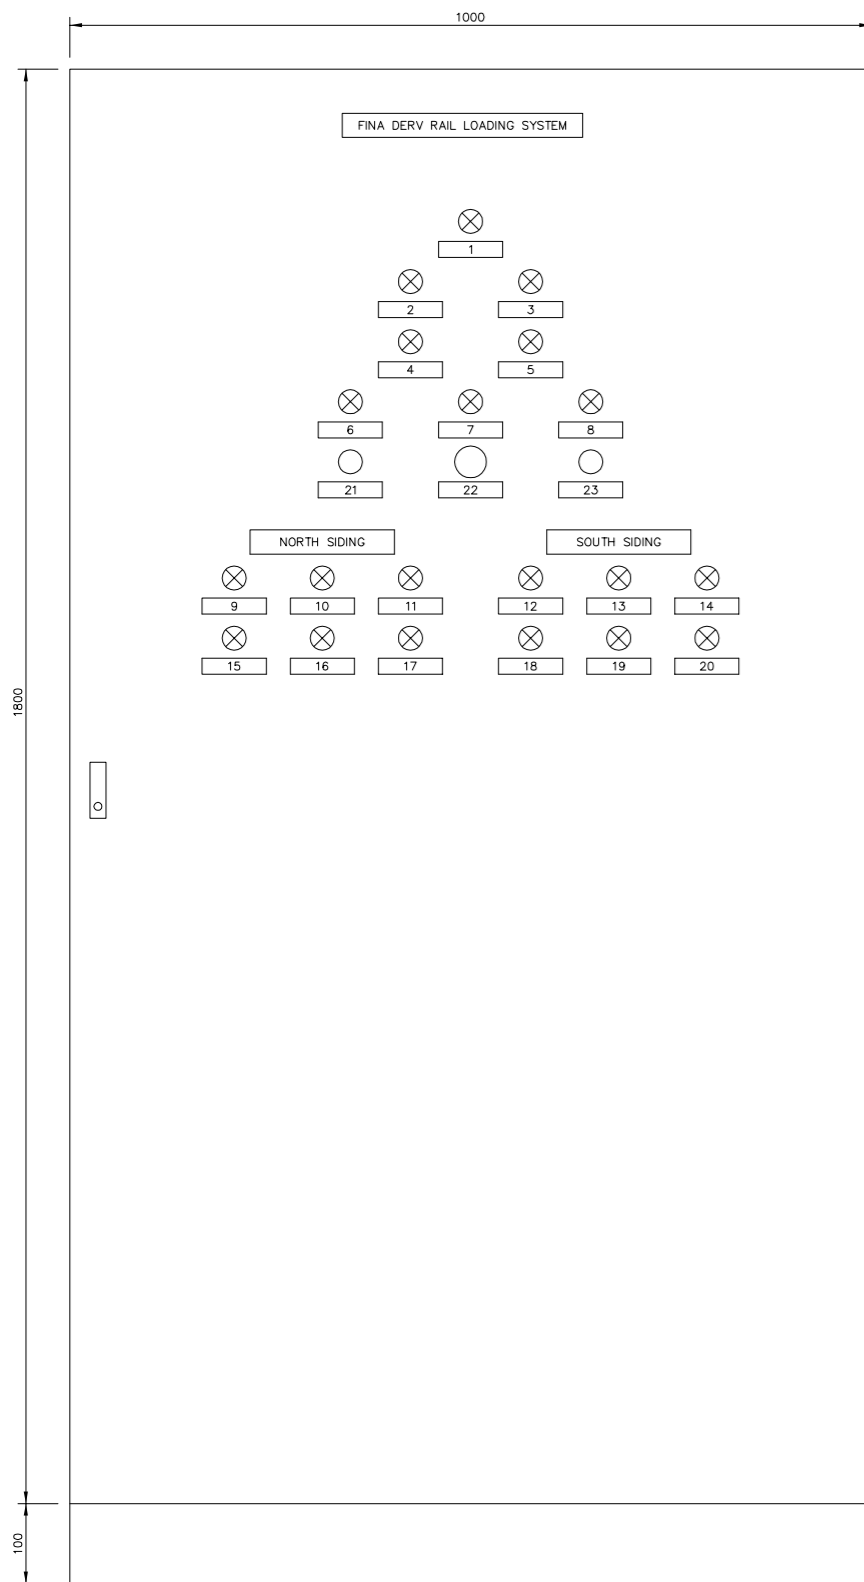


RITTAL ES 5084.600  
FRONT OF PANEL LAYOUT

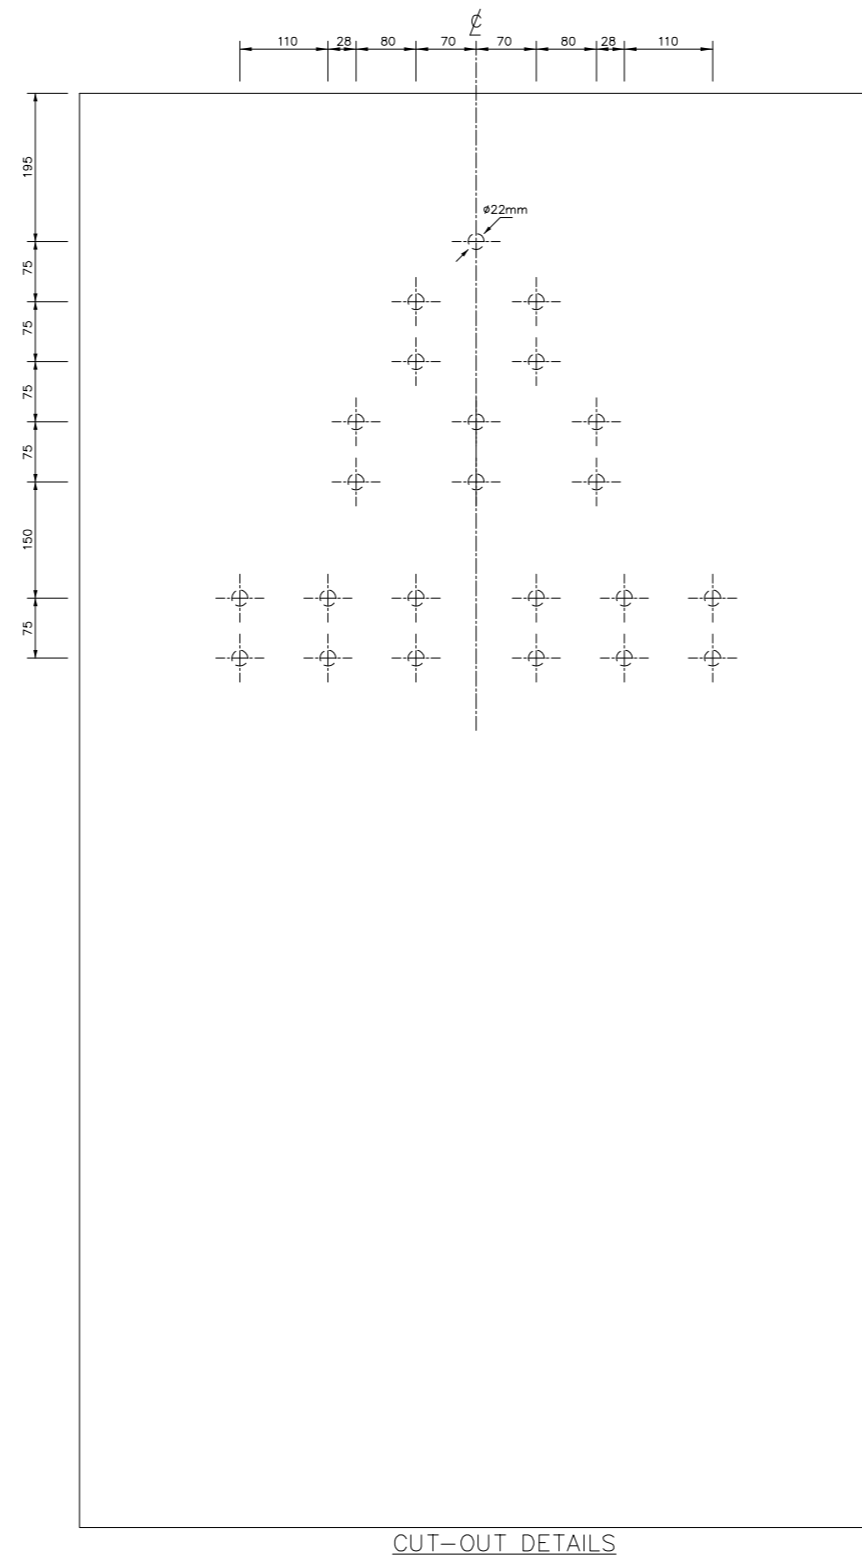

CUT-OUT DETAILS

LOCATION	QUANTITY	ITEMS	STOCK CODE
A	38	RS 4-POLE RELAYS, 24Vdc COIL	RS 213-0793
B	1	RS 4-POLE TIMER RELAYS, 24Vdc COIL (ON DELAY)	RS 328-140
C	1	RS 4-POLE TIMER RELAYS, 24Vdc COIL (OFF DELAY)	RS 328-140
D	15	ASK1	XXXX
E	15	SAK 2.5	XXXX
F	12	ASK1	XXXX
G	12	SAK2.5	XXXX
H	12	EK2.5	XXXX
I	4	MIL 3052	XXXX
J	1	ISOLATOR 25A	XXXX
K	4	RS 4 POLE SAFETY RELAYS, 24Vdc COIL	RS 260-4373
L	6	RS 4-POLE RELAYS, 240VAC COIL	RS 213-0838

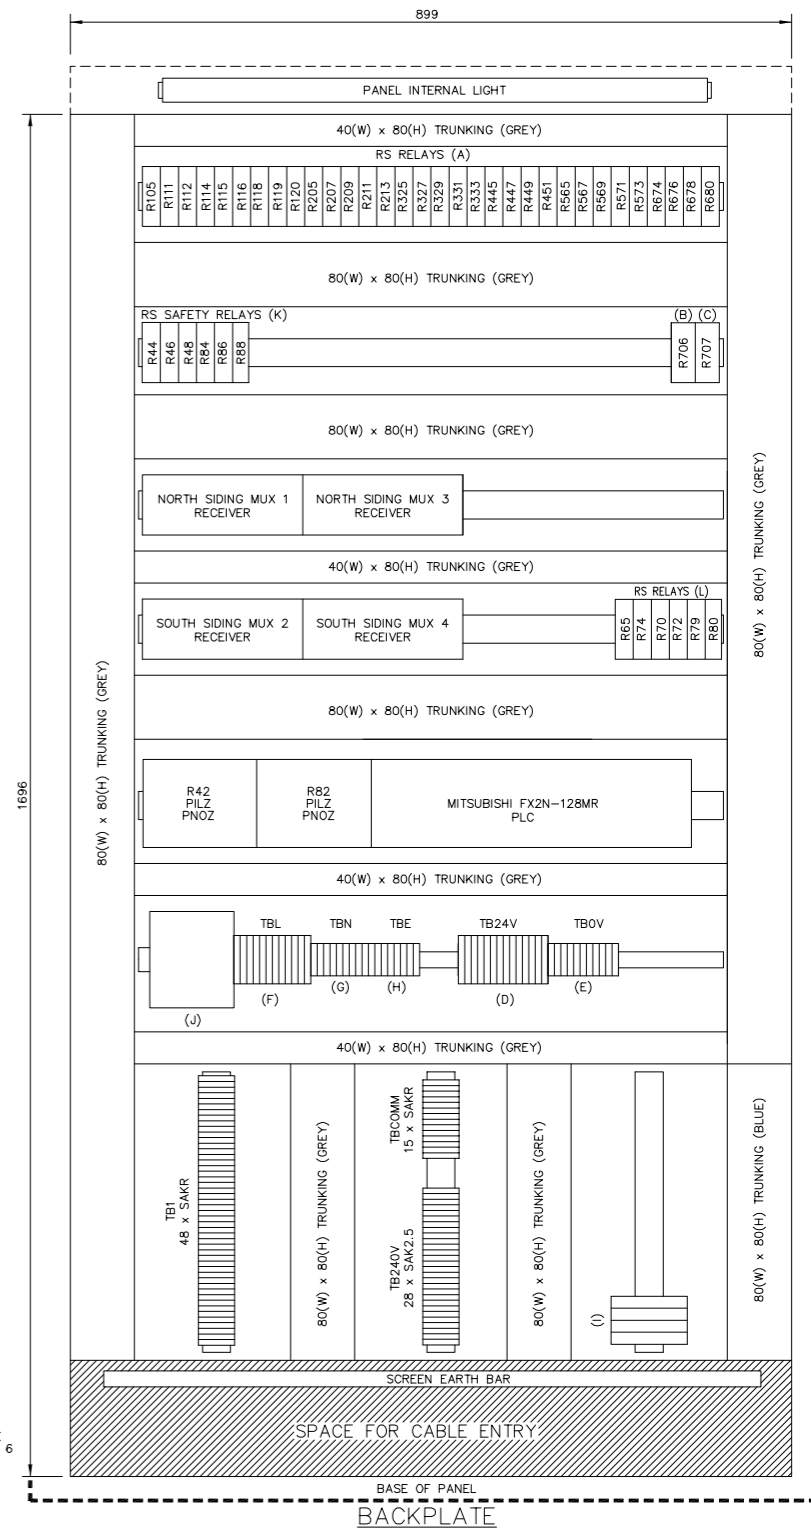

SEE NOTE 6

LOCATION	DETAILS
1	PUMP RUNNING (FLASHES IF NOT IN AUTO OR IN FAULT)
2	POLLING PC COMMS FAILURE
3	CONTROL SYSTEM IN BATCHER STAND ALONE
4	MANUAL VALVE FAULT
5	LEVEL SWITCH OPERATED
6	SYSTEM FAULT
7	ESD OPERATED
8	WATCHDOG FAULT
9	LEVEL SWITCH 1 OPERATED
10	LEVEL SWITCH 2 OPERATED
11	LEVEL SWITCH 3 OPERATED
12	LEVEL SWITCH 7 OPERATED
13	LEVEL SWITCH 8 OPERATED
14	LEVEL SWITCH 9 OPERATED
15	LEVEL SWITCH 4 OPERATED
16	LEVEL SWITCH 5 OPERATED
17	LEVEL SWITCH 6 OPERATED
18	LEVEL SWITCH 10 OPERATED
19	LEVEL SWITCH 11 OPERATED
20	LEVEL SWITCH 12 OPERATED
21	STAND ALONE MODE
22	ESD
23	LAMP TEST

DO NOT SCALE: CONTRACTOR TO CHECK DIMENSIONS AND REPORT ANY OMISSIONS OR ERRORS

NOTES

- ALL DIMENSIONS IN mm UNLESS OTHERWISE STATED.
- INGRESS PROTECTION: IP 56
- CABLE ENTRY: BOTTOM
- PANEL DEPTH: 400
- LABELS TO BE WHITE TRAFFOLYTE WITH BLACK ENGRAVING
- 2-GANG 240VAC SOCKET & COULANT LAMBDA DRP240-1 PSU TO BE MOUNTED ON THE PANEL SIDE.

SCALE 1:5  
WHEN PRINTED TO FULL A1  
SIZE ONLY

REV	DATE	BY	DRN	CHK'D	APP'D	DESCRIPTION	PLANT	FINA RAIL LOADING SYSTEM
A	08/04/99	A.J.H.	A.J.H.	D.R.R.	D.R.R.	D.R.R.	ORIGINAL ISSUE	TITLE CONTROL PANEL LAYOUT
B	14/04/99	A.J.H.	A.J.H.	D.R.R.	D.R.R.	D.R.R.	GENERAL UPDATE	02/07/99
C	02/07/99	D.P.	A.J.H.	D.R.R.	D.R.R.	TB COMMS ADDED		

IMMINGHAM STORAGE Co Ltd,  
 IMMINGHAM EAST TERMINAL,  
 IMMINGHAM DOCK, IMMINGHAM,  
 SOUTH HUMBERSIDE

SHEET 01 OF 01  
 CLIENT DRG. No. P&I DRG No. SIO39016

## **Appendix II**

### **Schedules**

Cable Schedule  
SI760001\_SCH\_A



# INSTRUMENT/ELECTRICAL CABLE SCHEDULE

CABLE		CONDUCTORS		CABLE ROUTE				APPROX. LENGTH METRES	REMARKS
REFERENCE	TYPE	AREA mm <sup>2</sup>	No.	FROM	GLAND TYPE	TO	GLAND TYPE		
<b>P2-25</b>									
M20132	J04	70	4 Core	No.2 Switchroom MCC Compartment 2BE	ATEX II 2 G EExed	P2-25 - Bund R Rail Loading Pump	ATEX II 2 G EExed	100	Cable Extended
M20132/1	J04	70	4 Core	No.2 Switchroom MCC Compartment 2BE	ATEX II 2 G EExed	P2-25 - Bund R Rail Loading Pump	ATEX II 2 G EExed	160	Extension
C20133	J04	N/A	4 Core	No.2 Switchroom MCC Compartment 2BE	ATEX II 2 G EExed	P2-25 Local Controls	ATEX II 2 G EExed	100	Remove
C20134	J02	N/A	2 Core	P2-25 Local Controls	ATEX II 2 G EExed	TS2-25 Discharge Temperature Switch	ATEX II 2 G EExed	5	Remove
C20800	J12	1.5	12 Core	No.2 Switchroom MCC Compartment 2BE	ATEX II 2 G EExed	JB2/111 - P2-25 Junction Box	ATEX II 2 G EExed	100	
C20801	J07	1.5	7 Core	JB2/111 - P2-25 Junction Box	ATEX II 2 G EExed	JB2/112 - P2-25 Local Junction Box	ATEX II 2 G EExed	5	
C20802	J05	1.5	5 Core	JB2/112 - P2-25 Local Junction Box	ATEX II 2 G EExed	P2-25 Stop/Start Station	ATEX II 2 G EExed	5	
C20803	J05	1.5	5 Core	JB2/112 - P2-25 Local Junction Box	ATEX II 2 G EExed	LS2-25 Dry Run Protection Switch	ATEX II 2 G EExed	5	
C20804	J03	1.5	3 Core	JB2/112 - P2-25 Local Junction Box	ATEX II 2 G EExed	TS2-25 Discharge Temperature Switch	ATEX II 2 G EExed	5	
C20805	J07	1.5	7 Core	JB2/111 - P2-25 Junction Box	ATEX II 2 G EExed	P2-25 Stop/Start/Run Station 3 at 4 East Rail Gantry	ATEX II 2 G EExed	Reuse C40279	Station 3 @ Far End
C20806	J07	1.5	7 Core	P2-25 Stop/Start/Run Station 3 at 4 East Rail Gantry	ATEX II 2 G EExed	P2-25 Stop/Start/Run Station 2 at 4 East Rail Gantry	ATEX II 2 G EExed	40	Station 2 @ Centre
C20807	J07	1.5	7 Core	P2-25 Stop/Start/Run Station 2 at 4 East Rail Gantry	ATEX II 2 G EExed	P2-25 Stop/Start/Run Station 1 at 4 East Rail Gantry	ATEX II 2 G EExed	40	Station 1 @ Control End
C20808	J02	1.5	2 Core	P2-25 Stop/Start/Run Station 1 at 4 East rail Gantry	ATEX II 2 G EExed	4 East Switch Room Rail Loading Logic Panel	ATEX II 2 G EExed	TBC	Re-use C40279 7c Option
<b>P5-12</b>									
C50485	J07	1.5	7 Core	No.5 Switchroom MCC 5/2 Compartment A1	ATEX II 2 G EExed	P5-12 Stop/Start/Run Station 1 at 4 East Rail Gantry	ATEX II 2 G EExed	TBC	Station 1 @ Control End
C50486	J07	1.5	7 Core	P5-12 Stop/Start/Run Station 1 at 4 East Rail Gantry	ATEX II 2 G EExed	P5-12 Stop/Start/Run Station 2 at 4 East Rail Gantry	ATEX II 2 G EExed	40	Station 2 @ Centre
C50487	J07	1.5	7 Core	P5-12 Stop/Start/Run Station 2 at 4 East Rail Gantry	ATEX II 2 G EExed	P5-12 Stop/Start/Run Station 3 at 4 East Rail Gantry	ATEX II 2 G EExed	40	Station 3 @ Far End
C50488	J02	1.5	2 Core	P5-12 Stop/Start/Run Station 3 at 4 East Rail Gantry	ATEX II 2 G EExed	4 East Switch Room Rail Loading Logic Panel	ATEX II 2 G EExed	TBC	Re-use X40356 1 Pr Option
<b>4 EAST RAIL GANTRY</b>									
C40820	J03	1.5	3 Core	JB 4-86 DC Junction Box	ATEX II 2 G EExed	ESD @ Gantry Top Control End	ATEX II 2 G EExed	TBC	
C40821	J03	1.5	3 Core	JB 4-86 DC Junction Box	ATEX II 2 G EExed	ESD @ Gantry Top Centre	ATEX II 2 G EExed	TBC	
C40822	J03	1.5	3 Core	JB 4-86 DC Junction Box	ATEX II 2 G EExed	ESD @ Gantry Top Far End	ATEX II 2 G EExed	TBC	
C40823	J03	1.5	3 Core	No.4 Switchroom Rail Loading Control Panel	ATEX II 2 G EExed	ESD Valve Solenoid	ATEX II 2 G EExed	TBC	
<b>4 EAST SWITCHROOM</b>									
C40824	J02	1.5	2 Core	No.4 Switchroom Rail Loading Control Panel	ATEX II 2 G EExed	No.4 Switchroom Extension Annunciator Node Panel	ATEX II 2 G EExed	30	
C40825	J02	1.5	2 Core	No.4 Switchroom Rail Loading Control Panel	ATEX II 2 G EExed	No.4 Switchroom Dupline Panel	ATEX II 2 G EExed	20	
							TOTAL	695	

**NOTES:**

1) Refer to P&I Design Cable Specifications for details on Cable Type.

IF NOT SIGNED THIS DOCUMENT IS UNCONTROLLED

REV	DATE	BY	DRN	CHK'D	APP'D	DESCRIPTION	PLANT	TITLE
A	30/09/10	DBF	DBF	MM	MM	Issued for Tender	Immingham East - 4 East	4 East Rail Loading Cable Schedule

- Denotes Cable Modified
- Denotes Cable Deleted
- Denotes Cable Added
- Future Cables



## Appendix III

### Cable Specifications

Type 'E'

Type 'J'





<b>TYPE</b>	J
<b>DESCRIPTION</b>	XLPE Insulated Power Cable - Armoured
<b>MANUFACTURING SPECIFICATION</b>	BS5467
<b>SERVICE</b>	Power Distribution / Control (Max. 440V ac.)
<b>VOLTAGE</b>	600/1000V.
<b>CONDUCTORS</b>	Stranded Copper
<b>INSULATION</b>	XLPE (Cross Linked Polyethylene)
<b>CORE COLOUR CODE</b>	1 core    Brown 2 cores    Brown, Blue 3 cores    Brown, Black, Grey 4 cores    Brown, Black, Grey, Blue 5 cores    Brown, Black, Grey, Blue, Green/Yellow 7 cores    } 12 cores         White insulation with core number indelibly marked at 19 cores         regular maximum intervals of 50mm 27 cores    } 37 cores      48 cores    }
<b>SHEATH</b>	Black PVC
<b>ARMOUR BEDDING</b>	PVC
<b>ARMOUR</b>	Single Core - Aluminium Wire Multi Core - Galvanised Steel Wire
<b>NOTES</b>	The cable type shall be followed by a number that defines the number of cores within a given cable.  e.g. J12 indicates a twelve core type J cable.

<b>TYPE</b>	E				
<b>DESCRIPTION</b>	Twisted Pairs, Collectively Screened - Armoured One pair, Two pair, Five pair, Ten pair or Twenty pair.				
<b>MANUFACTURING SPECIFICATION</b>	BS5308 Part 1 Type 2				
<b>SERVICE</b>	24V dc (Nominal) Digital, Pulse and Analogue Instrument Signals				
<b>CONDUCTORS</b>	Stranded Copper 0.5mm <sup>2</sup> to 1.5 mm <sup>2</sup>				
<b>INSULATION</b>	Polyethylene, with one core black and one core blue.				
<b>MULTI-PAIR IDENTIFICATION</b>	Both cores of each pair shall be indelibly numbered with the pair number at regular maximum intervals of 50mm				
<b>LAYING UP</b>	Cores twisted together in pairs.				
<b>COLLECTIVE SCREEN</b>	Laminated tape with the metallic side down and in continuous contact with a tinned copper drain wire.				
<b>ARMOUR BEDDING</b>	Polyethylene				
<b>ARMOUR</b>	Galvanised Steel Wire				
<b>SHEATH</b>	PVC For intrinsically safe circuits the sheath colour shall be blue, for other circuits the sheath colour shall be black (See Notes).				
<b>NOTES</b>	The cable type shall be followed by a number that defines the number of cores / pairs / triads within a given cable.  In addition a suffix may be added where applicable as follows.  <table border="0"><tr><td>Suffix</td><td>Description</td></tr><tr><td>I</td><td>Intrinsically Safe Circuit</td></tr></table> e.g. E10I indicates a ten pair type E cable with a blue sheath.	Suffix	Description	I	Intrinsically Safe Circuit
Suffix	Description				
I	Intrinsically Safe Circuit				

## **Appendix IV**

### **Standard Specification for Instrument & Electrical installations**

SI003001\_INS\_A



# *P & I Design Ltd*

Process Instrumentation Consultancy & Design

2 Reed Street, Gladstone Industrial Estate,  
Thornaby, TS17 7AF, United Kingdom.  
Tel. +44 (0) 1642 617444 Fax. +44 (0) 1642 616447  
Web Site: [www.pidesign.co.uk](http://www.pidesign.co.uk)

**SIMON STORAGE LTD.**

**IMMINGHAM EAST TERMINAL**

**STANDARD SPECIFICATION FOR  
INSTRUMENT & ELECTRICAL INSTALLATION**

Rev	Date	By	Checked	Approved	Description	Client Ref.
A	17/02/09	DBF	MM	MM	Original Issue	
						Document No. SI003001.INS
						<b>Page 1 of 14</b>

*IF NOT SIGNED THIS DOCUMENT IS UNCONTROLLED*

## CONTENTS

- 1 Introduction
- 2 General Requirements
- 3 Methods of Work and Materials

## APPENDICES

- I Applicable Standards



## 1 INTRODUCTION

This document details the specifications required to install instrument and electrical equipment and associated systems at Simon Storage Ltd. ISCO East Terminal. This document covers all aspects of industrial instrument and electrical installation work and may contain sections that may not be relevant to every project.

## 2 GENERAL REQUIREMENTS

The Contractor is to supply all labour, cables, cable tray/ladder racking, equipment and materials necessary to complete the works detailed.

### 2.1 General Conditions of Contract

The Contractor is required to work to the Employer's Condition of Contract;

### 2.2 Requirement of Contract

To carry out works to install the instrument and electrical element of the project. Works will be carried out while surrounding systems are under construction and care must be taken to avoid any clash with other trades. It may be necessary to carry out some of the works during agreed shutdowns. The Engineer will liaise closely with the Contractor to ensure that the required systems are made available.

### 2.3 Safety

The Contractor is required to work to the Employer's Safety Conditions.

Following Tender assessment, the successful Tenderer will be required to attend a meeting and participate fully in the formulation and regular update of the final Health and Safety Plan for the Project.

### 2.4 Installation

All labour, including unskilled, skilled and supervisory staff involved in the off-loading of equipment at the site and in the complete installation, assembly and testing of all the items included in the contract.

All materials required for the contract including earth conductors and furse clamp/fixings, cable ladder, tray, channel, supports, cable as detailed in the schedules.

All tools and equipment, including lifting equipment, scaffolding, general plant required in the performance of the contract and all necessary testing equipment.

The provision of all site facilities and any temporary electricity supplies.

All builders work including drilling and fixing to the civil structure, any necessary grouting and the sealing of holes, ducts and trenches after cable installations. All fixings, nuts, bolts,



2.4 *Installation (Cont.)*

studs, washers, gaskets and any other appurtenances necessary to provide a complete and operational installation.



### **3 METHODS OF WORK AND MATERIALS**

#### **3.1 Installation Standards**

Equipment and installation shall comply with all relevant standards, statutory instruments, regulations and authorities current and governing at the time, with particular reference to those detailed in Appendix IV.

If interpretation of the standards shall prejudice any part of this specification, where requirements may be in excess of those called for in the standards, the Purchaser's standards shall apply.

#### **3.2 Materials**

All materials used in manufacture, construction or installation shall be new and specifically suited for their duty or purpose.

The Contractor shall provide all miscellaneous materials, not of free-issue nor specifically defined by the Company, which are necessary to complete any installation to the required standard.

#### **3.3 Electrical Contractor**

All work carried out shall be performed by a qualified electrical contractor, approved by the National Inspection Council for Electrical Installation (NICEIC). Work shall comply with the relevant British Standards. The contractor shall ensure that either:-

All electricians employed on the project have suitable experience of working on hazardous area equipment or a qualification for working on Electrical Equipment in Hazardous Areas (CompEx),

or,

that the complete installation is checked and certified by a CompEx certified person.

#### **3.4 Position of Electrical Equipment and Appliances**

The approximate positions of electrical apparatus such as motors, instruments, and distribution boards are shown on the drawings, but their exact positions shall be determined on site by an appointed representative of the Engineer.

The position of electrical apparatus shown on the drawings shall be assumed to be correct for the purposes of tendering, but they may be reasonably varied without extra cost.

The Contractor shall ascertain on site that his work will not foul other engineering services or equipment and any work which has to be re-done, due to negligence, in this respect shall be his responsibility.





### 3.5 Segregation of Service

All cable supports and cables shall be prevented from coming into contact with process equipment and piping by a spacing of 150mm.

Cables operating at a voltage of 110V AC and above shall be segregated from cables operating at a voltage of 24V DC and below.

Intrinsically safe circuits shall not share multicore cables with none intrinsically safe circuits.

### 3.6 Fixings

No structural steelwork shall be drilled for any purposes without the approval of the Engineer. In general, all fixing to steelwork shall be by means of studs welded to the steelwork or by clamp brackets or hook bolts. Permission shall be obtained from the Engineer for any other type of fixing. Any protective coating damaged by welding, etc. should be made good by a method approved by the Engineer.

The supply and fixing of all support brackets, clamps and spacers and any other steelwork, whether or not shown in detail on the drawings or otherwise, which may be required for the proper and effective fixing of any equipment shall be considered to be included in the material and labour for the supply and fixing of that equipment, unless this work is specifically detailed in the Schedules.

Where PVC sheathed cable is used, cable cleats and supports shall be as recommended by the cable manufacturer. They shall be designed to avoid any damage to the PVC sheaths by sharp edges and excess pressure.

Cables erected on walls or steelwork shall, so far as is practicable, be so supported that no flexing can occur. Generally cables shall be supported on cleats which clamp the cables to prevent longitudinal movement.

Lightweight equipment and conduit saddles may be fixed to the building structure by means of screws in metal or plastic plugs. Wood or fibre plugs shall not be used.

Fixing to brickwork shall be made in the bricks and not in the joint. If it is not possible to make all the fixings in the brickwork, then the equipment shall be positioned to enable the upper fixings to be made in the brickwork.

Shot fixing bolts shall not be used.

Any additional scaffolding required will be included within the Contractor's Scope of Work. Note: Existing scaffold in place to assist with the Mechanical Pipework Installation may be used.



### 3.7 Clean Up

During and on completion of installation work the Contractor shall remove all surplus equipment and material and leave areas in a 'brush clean' condition. Refuse shall be disposed of as directed by the Engineer.

Prior to testing (where damage could arise) and before offering any part of the installation for acceptance, the Contractor shall clean out all electrical enclosures and wipe down painted surfaces. If necessary, damage to paintwork shall be made good by touch-up.

Before finally leaving the site, the Contractor shall remove all his accommodation, plant, tackle and tools of the trade to the satisfaction of the Engineer.

### 3.8 Earthing

#### 3.8.1 General Soil Conditions

No information is available.

#### 3.8.2 System Earthing

The neutral shall not be regarded as an earth conductor.

In areas where earth rods are to be driven into the ground, it shall be the contractors responsibility to ensure that there are no other underground services in the immediate vicinity.

#### 3.8.3 Equipment Earthing

The main earthing bar as identified in the specific project documentation will be connected by a separate earth conductor to its main earth point. All non-live metalwork shall be directly or indirectly bonded to the main earth bar. Such metalworks will include electrical equipment enclosures, motor frames, tray/ladder rack to be continuously bonded, cable armouring and glands. All glands which are through clearance holes require an earth tag and connection to the earth system by 6 sq.mm cable. Care must be taken to ensure that paint, etc. is cleaned away from under earth connections so that there is good earth continuity.

Direct bonding shall be taken to mean dedicated earth conductors within, or separate from, plant cable. Separate conductors shall be multi-stranded copper with a green/yellow sheath, size as specified in the drawings. Indirect bonding shall be taken as earth paths through armouring.

Note: (Dedicated earth conductors preferred).

However, a combination of both may be employed, providing that the value of the earth loop impedance allows flow of fault current sufficient to rupture associated protective fuses within five (5) seconds.



### 3.8.4 Lightning Protection

Lightning protection is not anticipated for the plant.

## 3.9 Cabling

### 3.9.1 General

The schedules detail the cables with the estimated lengths for tendering purposes only. It is the Installation contractors responsibility to site measure prior to any cable installation and any cost variation must be advised to the Engineer for approval before installation.

All cables above 16 sq mm section shall have shaped conductors.

Before any armoured cable is installed, triplicate copies of the test certificate giving details of these tests shall be submitted to the Engineer for approval.

When delivered to site, each coil of cable shall have attached the manufacturer's test certificate.

When cables are steel wire armoured, the conductance of the armour shall be not less than 50% of the conductance of one phase core.

### 3.9.2 Installation

Bending radii shall conform to the maker's recommendations but in no case shall be less than:

8 x OD for armoured cables.

Cables shall be identified with durable, non-corrodible tags, of the Critchley K type or equivalent, inscribed with the reference number allocated in the cable schedules and fixed securely to the cable.

All cables shall be tagged as follows:

- a. At each termination.
- b. Where they enter and leave underground ducts.
- c. At each side of any barrier through which they run.
- d. Where they rise from one level to another.

All cores shall be terminated using approved crimped lugs of appropriate size. Spare cores shall be made off to unused terminals.

The cores of cables of section larger than 4mm<sup>2</sup> shall be connected by a means approved by the Engineer.



### 3.9.2 *Installation (Cont.)*

Cable joints shall not be used unless specified or on the written authority of the Engineer.

Cores shall be marked to comply with the references given in the cable schedules using Critchley Z type or equivalent. They shall be identified having black characters reading from the terminals outwards. Clip-on ferrules will not be accepted.

Insulated cables shall have standard compression type gland of the appropriate size. Particular ATEX certification requirements will be detailed on cable schedules.

Each gland shall be bonded to its cable armouring, where applicable and unless otherwise specified, and to be complete with earth tag and locknut.

Cables shall be protected against mechanical damage at vulnerable points. This particularly applies in exposed locations where cables emerge from ground or floor.

### 3.9.3 Cables in Ground

When excavating trenches for underground cables, due account shall be taken of ground conditions. Cables in normal ground shall be laid in trenches 500mm deep minimum unless agreed otherwise. Before any excavation starts, the Contractor shall check if there is any record of other underground services along the route.

Trench bottoms shall be cleared of irregular and sharp objects before applying bedding.

Cables shall be laid the appropriate distance apart (dictated by rating factors) on a bed of clean, dry, builders' sand, 75mm deep.

Cables shall be blinded with a similar layer as soon as possible after installation.

The trench shall be backfilled a further 150mm with riddled, excavated spoil.

Interlocking cable tiles or continuous marker tape, giving clear warning or danger, shall be placed over each cable or closely associated groups of cables.

Backfill to surface shall be allowed to settle before final topping and grading.

Approved route markers shall be installed where cables enter or leave buildings, at changes of direction and at appropriate intermediate intervals.

Pilot cables shall run continuously with their associated main cable, where the route is common.



### 3.10 CABLE SUPPORTS

#### 3.10.1 Cable Ladder

Cable ladder should be installed as required in this specification.

The ladder shall be Swift type which is Hot Dip Galvanised to BS729:1971.

Standard metric widths shall be used.

Radius bends, tees, sets, reducers or other fittings shall be proprietary type by the ladder manufacturer and his installation instructions shall be followed. Earth Continuity connectors are to be fitted to all racking.

It shall be the contractors responsibility to provide the main supports for the racks as well as the fixing of the racks to the main supports.

Non Standard fittings will only be allowed where expressly agreed.

Cables shall not be tiered more than two deep, in which case the larger should be nearer to the end of the ladder.

Ladders shall be supported over their full width and secured to each support.

All bolts, nuts or washers shall be metric and sheradised, plated or otherwise effectively protected against corrosion.

Excessive bolt projections which may make the removal of nuts at a later date difficult will not be accepted.

When fully loaded, no span shall have a sag detectable by the eye.

Ladder runs shall be completely erected before cable laying commences and any rags, burrs or raw edges suitable treated.



### 3.10.2 Cable Trays

Cable trays shall be heavy-duty pattern formed from galvanised sheet steel. The tray shall have side flanges not less than 25mm deep with returned edges and be coated fabrication. Material gauge shall be 1.5mm (16 SWG) minimum except that for tray widths less than 400mm, the gauge may be reduced subject to the flange depth and the approval of the engineer. Factory made tee sections and bends shall be used where possible.

The cutting of trays shall be kept to a minimum but where unavoidable, the edges shall be suitably treated. Fasteners shall not present any obstruction on the tray. Capacity amounting to 25% usable tray area shall be left spare.

For those portions of cable route where the cables are to be laid on cable tray, they shall be laid flat and straight and shall be properly dressed into position and fastened to the tray at intervals not greater than 500mm. Where the tray is run horizontally but arranged in the vertical plane, fastener spacing shall be as detailed in the IEE Regulations. Care shall be taken to space the cables to allow adequate cooling in accordance with the IEE Wiring Regulations and not more than two layers of cables shall be run on one tray.

### 3.10.3 Channel

"Unistrut" type channel may be used for individual cable runs. Where cables are installed in the channel, capping is to be fitted. The channel and capping are to be of the galvanised type.

Where channel is to be used it must be with the approval of the Engineer.

### 3.10.4 Routes

Specific routing will be influenced by local circumstances.

Final details of all routes shall also be agreed with the Engineer before commencing pulling.

In all cases particular attention shall be paid to installation to as to prevent:

- a. Cable support fixings adversely affecting the strength of structures to which they are attached.
- b. Cable routes fouling access to other equipment and plant areas.
- c. Cables being at risk of damage caused by normal circumstances.



### 3.11 Testing and Commissioning

#### 3.11.1 Testing

On completion of any installation work the Contractor shall carry out tests to ensure that it has been correctly executed and is safe to commission. This section provides a guide to the minimum normal requirements. Additional or special testing of particular equipment or components may be necessary and if so shall be carried out in accordance with any applicable instructions or recommendations.

On completion of the installation, an inspection of hazardous area equipment is to be conducted as detailed in EN60079-17 Type: Initial, Grade: Detailed. All results are to be fully recorded. These tests must be carried out by a CompEx or equivalent certified person.

Safety Procedures, for any tests which may involve danger to personnel, the Contractor shall 'tape off' the area and display warning notices.

Earth Tests, as soon as possible after establishment, the value of the plant earth(s) shall be measured, preferably using an instrument specifically for this purpose. Tests shall preferably be carried out in dry weather.

Continuity of all earth paths shall be checked, loop impedance values shall be measured and recorded for all or sample circuits at the discretion of the Engineer. Any sample testing shall involve circuits furthest from the point of supply.

Insulation Tests, insulation tests shall be carried out on all cables and equipment using a 'Megger' of appropriate voltage. Low voltage devices (e.g. electronic circuitry) which could suffer damage thereby, shall be disconnected prior to testing.

Di-electric tests on insulating oil shall be carried out only if required by the Engineer.

Pressure Tests, it may be assumed that pressure testing (over-potential) of equipment will have taken place at works prior to despatch and need be repeated only if required by the Engineer.

In general and unless expressly excluded, all HV cables shall undergo a site pressure test prior to energising.

Injection Tests, injection tests on protective relays shall be carried out at the discretion of the Engineer.

Phase Rotation, supplies to principle load centres shall be checked for correct phase rotation.



3.11.1 *Testing (Cont.)*

Rotating Machines, all motors shall be 'jogged' on agreement with the Engineer, for direction then run on light load (with overload relays set low) to check for noise and vibration. Any drain plugs shall be removed to check for condensation, then replaced.

Lighting Levels, illumination levels shall be measured against specification in the absence of daylight.

Noise Levels, will not normally require measuring unless required by the Engineer.

Witnessing, the Contractor shall give reasonable notice of testing to the Engineer who may wish to witness same.

Records, all test results shall be recorded.

3.11.2 Commissioning

Electrical

The installation shall be pre-commissioned by carrying out full functional tests at rated voltages.

These operations will normally be carried out jointly by the Engineer and the Contractor and will include:-

Prolonged running of rotating machines (on load if possible) to check for smooth operation and temperature rise. During these tests the Contractor shall check metered currents, where applicable, and set overload relays and ammeter markers to suit conditions.

Active tests on all circuits to ensure that all components are operating correctly.

Sequence tests on all circuits to prove interlock and alarm features.

If required by the Engineer, the Contractor shall provide qualified assistance on a standby basis during full plant commissioning under process conditions.

Rates would be agreed in advance, in this event.





## APPENDIX I

### Applicable Standards

Specifications and Codes of Practice of the BSI

Regulations under the Electricity Acts

Requirements of HM Factory Inspectorate

Any applicable requirements of other National or Local Authorities

Simon Storage Safety Regulations for Contractors

Simon Storage General Conditions of Contract. (Latest Edition)

The Contractor is to request a copy of Simon Storage Regulations and Conditions of contract if not already in possession.

British Standard EN60079-14 Electrical Installation in hazardous areas.

British Standard EN60079-17 Inspection and Maintenance of electrical installations in hazardous areas.

British Standard BS7671:2008 Requirements for Electrical Installations (IEE Wiring Regulations 17th Edition)



# *P & I Design Ltd*

Process Instrumentation Consultancy & Design

2 Reed Street, Gladstone Industrial Estate,  
Thornaby, TS17 7AF, United Kingdom.  
Tel. +44 (0)1642 617444 Fax. +44 (0)1642 616447  
Web Site: www.pidesign.co.uk

**IMMINGHAM STORAGE Co LTD**

**ISCo EAST TERMINAL**

**INSTRUMENT & ELECTRICAL INSTALLATION**

**INSTALLATION SCOPE OF WORK**

**600 SERIES ROVOVs**

<b>Rev</b>	<b>Date</b>	<b>By</b>	<b>Checked</b>	<b>Approved</b>	<b>Description</b>	<b>Client Ref.</b>
A	02.12.10	D.B.Faulkner	MM	MM	Issued for Construction	
						Document No. SI760002_INS
						<b>Page 1 of 3</b>

*IF NOT SIGNED THIS DOCUMENT IS UNCONTROLLED*

## CONTENTS

- 1 INTRODUCTION
- 2 SCOPE OF WORK
  - 2.1 Scope of Work – No.2 Switchroom
  - 2.2 Scope of Work – Field
  - 2.3 Contractor Supplied Equipment
  - 2.4 Free Issue Equipment

## APPENDIX

- I Cable Overview Drawings
- II Schedules & Specifications

### Revision History

Revision A – Original issue



## 1 INTRODUCTION

This document details the scope of work to provide the Instrument/electrical installation works for 600 series tank 601, 602 & 603 rail loading export ROSOVs at ISCo East Terminal. It is to be read in conjunction with specification SI003001\_INS - Standard Specification for Instrument & Electrical Installations.

This scope is a variation to the main installation contract defined in document SI760001\_INS. All terms and conditions applicable to the main contract apply to these variation works also.

## 2 SCOPE OF WORK

The scope of work is as detailed in the following sections and as shown on the documentation listed below.

Cable Schedules	SI760002_SCH_A
Junction Box Schedules	SI277010_SCH_C
Loop Sheets	SI760005_DWG_A
MCC Drawing	SI478006_DWG_H

### 2.1 Scope of Work – No2 Switchroom

Modifications and tie ins to MCC compartments B2E & B2F.

### 2.2 Scope of Work – Field

Cables and containment to be installed from No.2 switchroom MCC panel to new valve assemblies XV60103, XV60203 & XV60303. Valve assemblies will be mechanically installed by others. Air lines to be installed from air header within 10 meters of the valves. JB4/89 is existing, contractor to modify or replace.

Note - 24Vdc power in JB4/89 from No4 switchroom SIS logic panel, contractor to apply relevant warning label and comply with SIS modification procedures.

### 2.3 Contractor Supplied Equipment

The contractor shall supply and install the following equipment. All equipment shall be suitably rated for the environment in which it is to be installed (site hazardous area drawing available on request). Where not fully specified, equipment shall conform with normal site standards for similar installations.

#### ROSOV Local Controls

- 3 off Pneumatic Open/Close Stations
- 1 off JB4/89 See section 2.2

#### Switchroom Equipment

- 1 off PILZ PNOZ s2 Safety relay.
- Terminals & Fuses

### 2.4 Free Issue Equipment

No Free Issue equipment.



## Appendix I

### Drawings

SI760005\_DWG\_A  
SI478006\_DWG\_H




600 SERIES TANK FARM

SAFE AREA


TANK 601 RAIL LOADING VALVE XV60103

JB4/89  
TANK ISOLATION PUSHBUTTON JUNCTION BOX



No.2 SWITCHROOM - MCC COMPARTMENT B2F

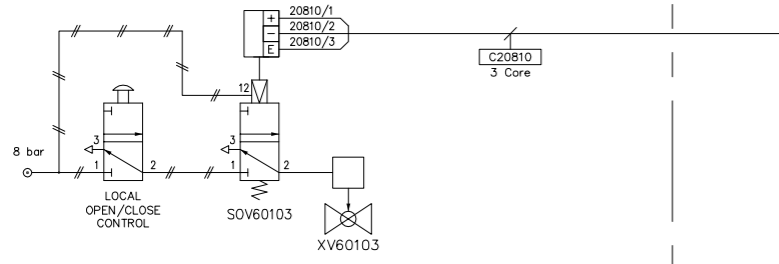


TANK 602 RAIL LOADING VALVE XV60203

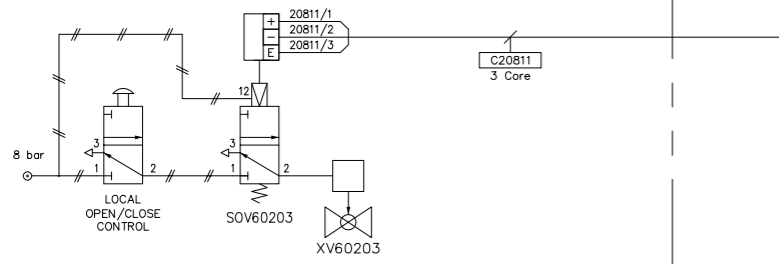

TANK 603 RAIL LOADING VALVE XV60303

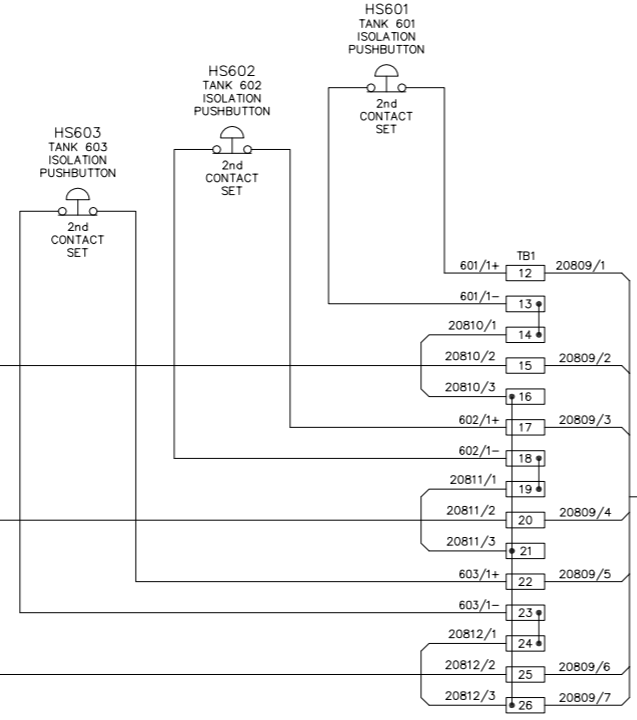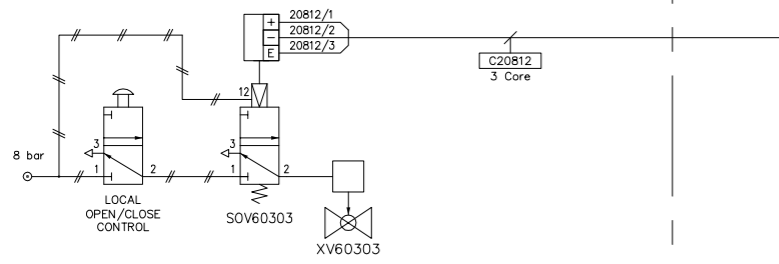

**NOTE**  
PUSHBUTTON CONTACT SET 1 IS FED FROM No.4 SWITCHROOM AND IS PART OF THE SIS SYSTEM

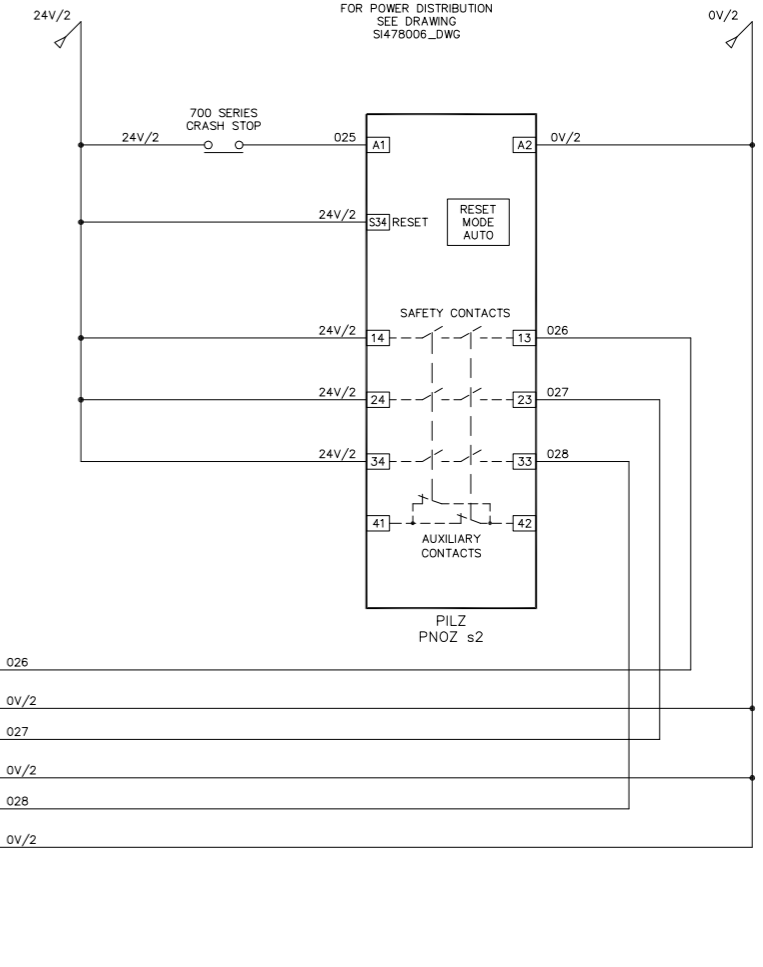

NOTES  
1)



IF NOT SIGNED THIS DOCUMENT IS UNCONTROLLED

REV	DATE	BY	DRN	CHK'D	APP'D	DESCRIPTION
A	30/11/10	P.P.	P.P.	D.B.F	M.M.	ISSUED FOR CONSTRUCTION

PLANT	IMMINGHAM STORAGE Co. - EAST TERMINAL
TITLE	4-EAST RAIL LOADING SYSTEM TANK 601, 602 & 603 RAIL LOADING VALVE LOOP SHEET
CLIENT DRG. No.	P&I DRG No. SI760005_DWG




IMMINGHAM STORAGE Co. Ltd.  
IMMINGHAM EAST TERMINAL,  
IMMINGHAM DOCK,  
IMMINGHAM,  
SOUTH HUMBERSIDE  
Tel. 01642 617444  
www.pidesign.co.uk

SHEET 1 OF 1

No.2 SWITCHROOM - MCC COMPARTMENT B2E

FIELD

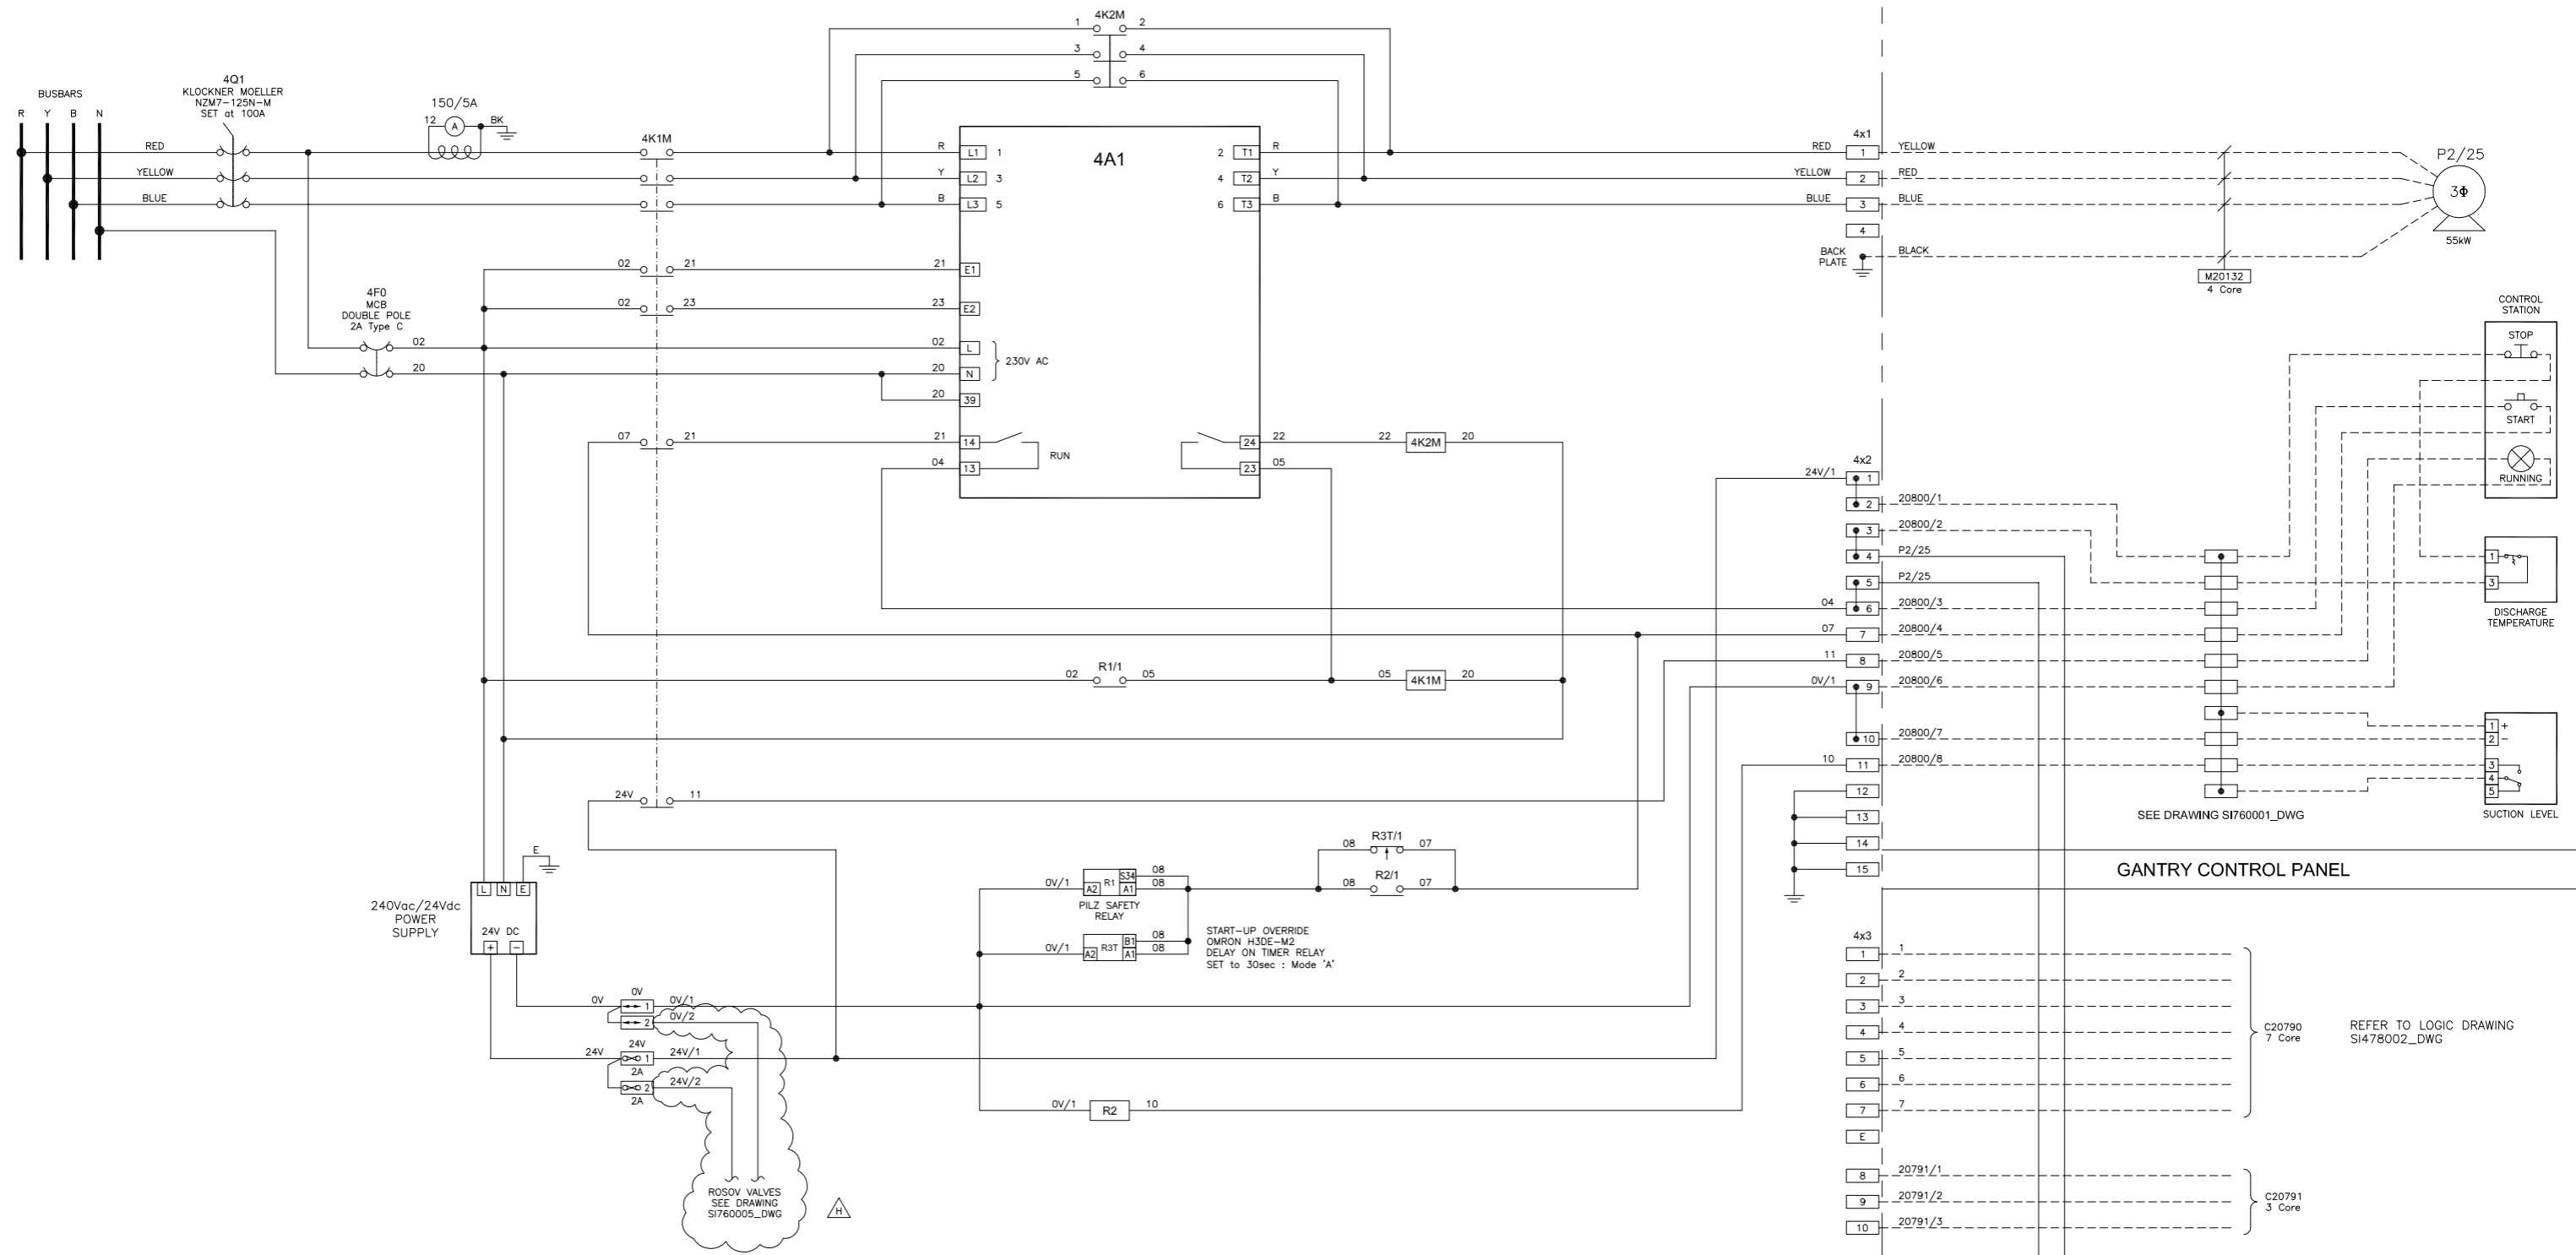

No.2 SWITCHROOM - MCC COMPARTMENT B2F

- NOTES
- 1) JETTY STOP – RELAY ENERGIZED TO STOP DRIVE.
  - 2) THIS DRAWING REPLACES SITE DRAWING SPW-03-688.DWG



REV	DATE	BY	DRN	CHK'D	APP'D	DESCRIPTION	REV	DATE	BY	DRN	CHK'D	APP'D	DESCRIPTION	
H	30/11/10	P.P.	P.P.	D.B.F	M.M.	ROSOV VALVE POWER ADDED	A	10/12/98	A.J.H	A.J.H	D.R.R	D.R.R	D.R.R	ORIGINAL ISSUE
							B	19/01/99	A.J.H	A.J.H	D.R.R	D.R.R	D.R.R	GENERAL UPDATE
							C	01/02/99	A.J.H	A.J.H	D.R.R	D.R.R	D.R.R	SOFT START CHANGED
							D	17/03/99	A.J.H	A.J.H	D.R.R	D.R.R	D.R.R	PANEL TEST MODS.
							E	23/06/00	M.M.	A.B.	D.R.R	D.R.R	D.R.R	SOFT START MODS.
							F	19/10/10	P.P.	P.P.	D.B.F	D.R.R	M.M.	COMPARTMENT RE-WIRED
							G	28/10/10	P.P.	P.P.	D.B.F	D.R.R	M.M.	PUMP CONTROLS REVISED

IF NOT SIGNED THIS DOCUMENT IS UNCONTROLLED		PLANT	IMMINGHAM STORAGE Co. – EAST TERMINAL
TITLE	P2/25 PUMP MCC DIAGRAM		
			P&I Design Ltd Tel: 01642 617444 www.pidesign.co.uk
CLIENT DRG. No.	SHEET 1 OF 1		
	P&I DRG No. SI478006_DWG		

## Appendix II

### Schedules & Specifications

SI760002\_SCH\_A  
SI277010\_SCH\_C





## INSTRUMENT/ELECTRICAL CABLE SCHEDULE

CABLE		CONDUCTORS		CABLE ROUTE				APPROX. LENGTH METRES	REMARKS
REFERENCE	TYPE	AREA mm <sup>2</sup>	No.	FROM	GLAND TYPE	TO	GLAND TYPE		
C20809	J07	1.5	7 Core	No.2 Switchroom MCC Compartment B2F	ATEX II 2 G EExed	JB4_89 Tank Isolation Pushbutton Junction Box	ATEX II 2 G EExed	100	Note 2
C20810	J03	1.5	3 Core	JB4_89 Tank Isolation Pushbutton Junction Box	ATEX II 2 G EExed	Tank 601 Rail Loading Valve - XSV60103 Soleniod	ATEX II 2 G EExed	220	
C20811	J03	1.5	3 Core	JB4_89 Tank Isolation Pushbutton Junction Box	ATEX II 2 G EExed	Tank 602 Rail Loading Valve - XSV60203 Soleniod	ATEX II 2 G EExed	190	
C20812	J03	1.5	3 Core	JB4_89 Tank Isolation Pushbutton Junction Box	ATEX II 2 G EExed	Tank 603 Rail Loading Valve - XSV60303 Soleniod	ATEX II 2 G EExed	160	
<b>TOTAL</b>								670	

**NOTES:**

1) Refer to P&I Design Cable Specifications for details on Cable Type. 2) Cables to be relocated to ROSOV Control Panel in future, allow spare length.

- Denotes Cable Modified
- Denotes Cable Deleted
- Denotes Cable Added
- Future Cables

*IF NOT SIGNED THIS DOCUMENT IS UNCONTROLLED*

REV	DATE	BY	DRN	CHK'D	APP'D	DESCRIPTION	PLANT	TITLE
A	30/11/10	DBF	DBF	MM	MM	Issued for Construction	Immingham East - 2 East	600 Series ROSOVs Cable Schedule



FIELD							JB4/89					SWITCHROOM 4 - TANK OVERFILL MONITORING PANEL (SIS)												
FIELD INSTRUMENT	TERMINAL No.	CABLE DETAILS					TERMINAL No.	JUNCTION BOX DETAILS					TERMINAL No.	PANEL TERMINATION DETAILS					INST. TERMINAL No.	INST. LOOP DIAGRAM	REMARKS			
		CABLE No.	TYPE	CORE No.	FERRULE No.	LENGTH METRES		CABLE No.	TYPE	CORE No.	FERRULE No.	LENGTH METRES		CABLE No.	TYPE	CORE No.	FERRULE No.	LENGTH METRES						
							<b>TB1</b>																	
HS601	12		1 Core		601+		1	X40358	E05	Pr 1+	40358/1+		<b>TB3</b>	27										
	11		1 Core		601-		2			Pr 1-	40358/1-			28									Tank 601 Isolation	
HS602	12		1 Core		602+		3			Pr 2+	40358/2+			29										Tank 602 Isolation
	11		1 Core		602-		4			Pr 2-	40358/2-			30										
HS603	12		1 Core		603+		5			Pr 3+	40358/3+			31										Tank 603 Isolation
	11		1 Core		603-		6			Pr 3-	40358/3-			32										
							7			Pr 4+	40358/4+			Earth Bar										Spare
							8			Pr 4-	40358/4-			Earth Bar										Spare
							9			Pr 5+	40358/5+			Earth Bar										Spare
							10			Pr 5-	40358/5-			Earth Bar										Spare
							11			SCN	40358/SCN			Earth Bar										Screen

FIELD							JB4/89					SWITCHROOM 2 - 600 SERIES ROSOV CONTROL PANEL												
FIELD INSTRUMENT	TERMINAL No.	CABLE DETAILS					TERMINAL No.	JUNCTION BOX DETAILS					TERMINAL No.	PANEL TERMINATION DETAILS					INST. TERMINAL No.	INST. LOOP DIAGRAM	REMARKS			
		CABLE No.	TYPE	CORE No.	FERRULE No.	LENGTH METRES		CABLE No.	TYPE	CORE No.	FERRULE No.	LENGTH METRES		CABLE No.	TYPE	CORE No.	FERRULE No.	LENGTH METRES						
							<b>TB1</b>						<b>TB1</b>											
HS601	22		1 Core		601/1+		12	C20809	J07	Core 1	20809/1		1											Tank 601 Solenoid +ve
	21		1 Core		601/1-		13																	
XSV60103	+	C20910	3 Core	1	20810/1		14																	
	-			2	20810/2		15			Core 2	20809/2		2											Tank 601 Solenoid -ve
	E			3	20810/3		16																	
HS602	22		1 Core		602/1+		17			Core 3	20809/3		3											Tank 602 Solenoid +ve
	21		1 Core		602/1-		18																	
XSV60203	+	C20911	3 Core	1	20811/1		19																	
	-			2	20811/2		20			Core 4	20809/4		4											Tank 602 Solenoid -ve
	E			3	20811/3		21																	
HS603	22		1 Core		603/1+		22			Core 5	20809/5		5											Tank 603 Solenoid +ve
	21		1 Core		603/1-		23																	
XSV60303	+	C20912	3 Core	1	20812/1		24																	
	-			2	20812/2		25			Core 6	20809/6		6											Tank 603 Solenoid -ve
	E			3	20812/3		26			Core 7	20809/7		Earth Bar											Earth

IF NOT SIGNED THIS DOCUMENT IS UNCONTROLLED												PLANT	ISCO EAST - TANK OVERFILL SIS	
ABBREVIATIONS	REFERENCE DRAWINGS	REV	DATE	BY	DRN	CHECKED	APPROVED	DESCRIPTION	TITLE					
Revision C Modifications	SI277120_DWG	A	27/03/08	P.P.	P.P.	D.S.R	D.S.R	D.R.R	D.R.R	Issued for Tender	JB4/89 TANK ISOLATION PUSHBUTTON J/B CONNECTION SCHED.			
	SI277121_DWG	B	24/04/08	P.P.	P.P.	D.S.R	D.S.R	D.R.R	D.R.R	Issued for Construction				
	SI277122_DWG	C	30.11.10	DBF	DBF	MM		MM		Issued for Construction				
	SI277123_DWG													
	SI277124_DWG													
	SI277125_DWG													
	SI760005_DWG													



# *P & I Design Ltd*

Process Instrumentation Consultancy & Design

2 Reed Street, Gladstone Industrial Estate,  
Thornaby, TS17 7AF, United Kingdom.  
Tel. +44 (0)1642 617444 Fax. +44 (0)1642 616447  
Web Site: www.pidesign.co.uk

## **SIMON STORAGE**

### **ISCo EAST TERMINAL**

#### **4 EAST RAIL LOADING MODIFICATIONS**

#### **INSTALLATION SPECIFICATION**

<b>Rev</b>	<b>Date</b>	<b>By</b>	<b>Checked</b>	<b>Approved</b>	<b>Description</b>	<b>Client Ref.</b>
A	30.09.10	D.B.Faulkner	MM	MM	Issued for Tender	
						Document No. SI760001_INS
						<b>Page 1 of 14</b>

*IF NOT SIGNED THIS DOCUMENT IS UNCONTROLLED*

## CONTENTS

- 1 INTRODUCTION
- 2 GENERAL REQUIREMENTS
- 3 METHODS OF WORK AND MATERIALS
- 4 SCOPE OF WORK
  - 4.1 Contractor supplied equipment
  - 4.2 Free issue equipment
- 5 CONTRACT PRICING CONTENTS
  - 5.1 Introduction Contractor Supplied Equipment
  - 5.2 Pricing Preambles/Notes on Pricing
  - 5.3 Schedule of Rates
  - 5.4 Programme
- 6 TENDER PRICING SUMMARY

## APPENDIX

- I Drawings
- II Schedules
- III Cable Specifications
- IV Standard Specification for Instrument & Electrical Installations

### Revision History

Revision A – Issue for tender.



## **1 INSTRUCTIONS TO TENDERERS**

### **1.1 Introduction**

This document details the scope of work to provide the cabling and containment installation for 4 east Rail Loading modifications at ISCo East Terminal. It is to be read in conjunction with specification SI003001\_INS - Standard Specification for Instrument & Electrical Installations.

The Tender shall be in respect of the proposed works and shall be completed and submitted strictly in accordance with these instructions to tenderers.

### **1.2 Date, Time and Mode of Delivery**

The completed tender packages together with any covering letter and with the remainder of the containing document all in originally bound form (taking account of additions/omissions, etc., notified in writing during the tender period) together with other requirements, shall be submitted by the time stated in the purchaser's letter of invitation to tender.

The envelope must not be marked nor delivered in any way which might disclose the identity of the tenderer.

### **1.3 Alterations of Tender Documents**

No authorised alteration shall be made in the Tender or the accompanying documents.

### **1.4 Enquiries to be Made Concerning the Tender**

Any query in connection with the tender shall be submitted to:-

Mr D.B.Faulkner  
P & I Design Limited  
2 Reed Street  
Gladstone Industrial Estate  
Thornaby.  
Tel: (01642) 617444  
Fax: (01642) 616447  
[df@pidesign.co.uk](mailto:df@pidesign.co.uk)

A site visit is required to ensure that the work associated with this project is fully understood. The site visit is to be organised by contacting D.B.Faulkner at P & I Design Ltd.



## **1.5 Sufficiency of Tender**

Before submitting a tender the tenderer should obtain all information, familiarise himself with means of access, location, extent and nature of the site, extent and nature of the services to be provided, conditions under which the services and works will be carried out, conditions affecting supply of staff and labour and any other matters which may affect his tender. applications for costs etc. on the ground of lack of knowledge in any respect of the aforementioned will be refused.

## **1.6 Confidentiality**

The particulars of this document and any tender submitted in respect hereof are private and confidential and shall not be used for any purpose other than the proposed contract. In the event of a tender not being submitted or accepted all documents and drawings shall be returned to the person named in Clause 4 of these instructions to tenderers.

## **1.7 Contravention of Tender Requirements**

Contravention of any of the requirements of these instructions to tenderers with regard to tendering shall render any tender concerned liable to disqualification at the sole discretion of Simon Storage Ltd.

## **1.8 Contract Agreement**

The contractor shall, when called upon, enter into and execute a contract agreement.

## **1.9 Information to be Supplied by the Purchaser**

In addition to the information to be provided by the purchaser prior to the contract award the tenderer shall attach a schedule of any further information which may be required from the purchaser, together with a programme indicating when it will be required.

## **1.10 Tender Price**

The contractor shall make his tender open for acceptance for a period of one month from date of receipt by the Purchaser.



## 2 GENERAL REQUIREMENTS

Detailed in document SI003001\_INS - Standard Specification for Instrument & Electrical Installation Section 2 with the following additional information -

### Section 2.2 – Requirement

A “For Construction” drawing package will be issued prior to contract. Modifications from the “For Tender” package will be highlighted.

The contractor is to supply details of labour usage to complete the installation within the programme. The contractor shall also supply day rate costs.

Normal site working hours 8.00am to 6.00pm Monday to Friday.

### Section 2.4 - Installation

All scaffolding requirements will be included within the contractor’s Scope of Work.



### 3 METHODS OF WORK AND MATERIALS

Detailed in document SI003001.INS - Standard Specification for Instrument & Electrical Installation Section 3 with the following additional information -

#### Section 3.5 – Segregation of Service

The schedules will indicate cables exceeding 110V AC.

#### Section 3.6 – Fixings

No fixings shall be made to the bund walls.

#### Section 3.8.3 – Equipment Earthing

Main earth bars within switchrooms.

#### Section 3.11.1 – Testing

No commissioning will commence until handover of cable test certificates and CompEx inspections by the contractor. The contractor will be responsible for providing installation handover to the engineer in good time to progress the commissioning programme.

#### Section 3.11.2 – Commissioning

The contractor will not be required to carry out commissioning. The contractor will not power any equipment without the consent of the engineer.

#### Pneumatics

The contractor shall supply all labour and materials to install or modify the pneumatic supplies to all actuated valves utilising 6mm OD black PVC tubing and push in fittings. Each tube shall be identified with durable, non-corrodible tags, of the Critchley K type or equivalent, inscribed with the valve tag number and fixed securely to the tube.

A distribution Manifold will be installed by the mechanical contractor within 10 metres of the valve. The contractor shall use this length for his costing for every valve.





## 4 SCOPE OF WORK

As part of the 4 East Rail Loading project P2-25 will be re-located from No.2 East loading yard to Bund R pump raft, P2-25 and P5-12 pump control systems will be modified. All inline batching equipment and associated electrical equipment will be removed to allow for line pigging.

The scope of work is as detailed in the following sections and as shown on the documentation listed below.

	Existing	Modified/New
Cable Schedules		SI760001_SCH_A
Cable Overview Drawing	SI039001_DWG_C	SI039001_DWG_D
Logic Drawings	SI039002_DWG_C	SI039002_DWG_D
	SI039003_DWG_B	SI039003_DWG_C
	SI039004_DWG_B	SI039004_DWG_C
	SI039005_DWG_B	SI039005_DWG_C
	SI039006_DWG_B	SI039006_DWG_C
	SI039007_DWG_B	SI039007_DWG_C
	SI039008_DWG_B	SI039008_DWG_C
Loop Sheets	SI039010_DWG_C	SI039010_DWG_D
	SI039011_DWG_C	SI039011_DWG_D
	SI039012_DWG_C	SI039012_DWG_D
	SI039013_DWG_C	SI039013_DWG_D
	SI039014_DWG_B	SI039014_DWG_C
		SI760001_DWG_A
		SI760002_DWG_A
Panel Layout Drawing	SI039016_DWG_C	SI039016_DWG_D

The contractor shall make provision for the following works –

### General

Relabeling of all equipment as required, removal of all FINA references.

Detailed CompEx inspections to be carried out to all existing equipment modified under this scope.

### P2-25

Isolate and de-gland motor cable M20132 to allow relocation of pump by others. M20132 to be extended to new location via M20132/1.

Isolate, de-gland and remove control cables C20133 & C20134.

Modifications to P2-25 controls to include supply/installation of 240 Vac to 24Vdc/5A PSU. Remove of P2-25 jetty controls from the dupline system. Relabeling as required.



## No.4 Switchroom

Re-programming of dupline system to provide a Site Fire Alarm output and wire to 4 pole relay within No.4 Switchroom dupline panel.

Modifications to 4 East Rail Loading panel as detailed on logic drawings.

## Gantry

Replacement of 12 off free issue Exd Solenoids – 12 off original units to be removed, contractor to allow for re-landing and testing.

Supply and install local pneumatic Open/Close control stations on rail loading valves and ESD valve.

Relocation of telephone extension No.310 from loading yard adjacent to tanks 560/599 to control end of gantry.

Removal of cables –

740927, 740928, 740929, 740930, 740934, 740935, 740936, 740937, 740944, 740945, 740946, 740947, 740950, 740951, 740990, 740991, 740992 & 740993

Removal of associated north & south siding field equipment –

2 off Danloads

4 off preamps

2 off Mercury units (cable to be installed into a contractor supplied JB)

Isolate and de-gland associated north & south siding field equipment for removal by others

4 off pickup coils,

2 off RTD's

2 off downstream DCV's

2 off upstream DCV's

All removed equipment to be retained.

Modifications to remove/blank or re-label Operator Control Panel Lamps

Three contractor supplied boards are to be mounted on the gantry top, each board will have a P2-25 stop/start/run a P5-12 stop/start/run and an 4 East Rail ESD pushbutton, the boards will be located at the control panel end, the centre and the far end of the gantry. The boards need to be of sufficient size to allow for A3 sized operating instructions to be attached.



## 4.1 Contractor Supplied Equipment

The contractor shall supply and install the following equipment. All equipment shall be suitably rated for the environment in which it is to be installed (site hazardous area drawing available on request). Where not fully specified, equipment shall conform with normal site standards for similar installations.

### 4 East Rail Loading Valves

- 12 off Pneumatic Open/Close Stations

### 4 East Rail Loading ESD Valve

- 1 off Pneumatic Open/Close Stations

### P2-25 Delivery Pump Exde Installation

- 1 off Pump local momentary start/momentary stop station.
- 1 off JB2-111
- 1 off JB2-112
- 3 off Pump momentary start/momentary stop/run stations - Red 24Vdc Lamp

### P5-12 Delivery Pump Exde Installation

- 3 off Pump momentary start/momentary stop/run stations - Red 24Vdc Lamp

### 4 East Rail ESD

- 3 off Stay Put Stop ESD Pushbuttons

### General

- 3 off Boards for control stations on gantry top
- 2 off JB's to replace Mercury terminals

## 4.2 Free Issue Equipment

The contractor shall supply labour and materials to take delivery, offload and position the following free issue equipment. Equipment requiring a direct connection into the process lines will be mechanically completed by others.

### P2-25 Delivery Pump Exd Local Controls

- 1 off Exd discharge temperature switch - Original unit to be reused, contractor to allow for de-glanding removal of cable.
- 1 off Exd dry run protection switch.

### Gantry Instrumentation

- 13 off Exd solenoids (12 off replacements, 1 new)



## **5 CONTRACT PRICING CONTENTS**

### **5.1 Introduction**

The Tenderer must complete the Schedules attached in Sections 5.3.4 & 6 completing the lists of categories of unit rates for variations. The Tenderer must not re-type or make any other alterations to the wording.

Engineer authorised variations in respect of the provision of the aforementioned services to be paid in accordance with Section 5.3.4.

Payment under hourly/day rates for variations to Contract will only be made to the Contractor for Personnel approved by the Purchaser and will only be made in respect of all approved hours worked, or pro-rata to the nearest half hour, half day or whole day respectively.

### **5.2 Pricing Preambles/Notes on Pricing**

#### **5.2.1 General**

These Pricing Preambles relate to Rates, Sums and Amounts entered in Schedules which form part of the Contract.

In arriving at said Rates, Sums and Amounts, the Contractor will be deemed to have taken account of the Conditions of Contract, the Specification/Scope of Work, the Particular Specification, these Pricing Preambles and any other matters which affects said Rates, Sums and Amounts.

Rates, Sums and Amounts, except where otherwise provided in the Contract shall be fixed for the duration of the Contract.

Completion of Lump Sums, Normal Time Rates.

- 5.2.1.1** A Rate, Sum or Amount shall be entered by the Contractor against each reference or item and reference or items against which no Rate, Sum or Amount is entered shall be deemed to be covered by other Rates, Sums or Amounts entered elsewhere in the Schedules.
- 5.2.1.2** The Contractor shall omit from his Tender any Value Added Tax chargeable or any taxable supplies made under Contract to the Purchaser and payable by him as a taxable person to the Commissioners of Customs and Excise.
- 5.2.1.3** The Contractor shall allow for compliance in all respects with the applicable British Standard, Codes of Practice and any other Standards or Codes specified. The Contractor shall be fully responsible for obtaining such documents and familiarising himself with same.
- 5.2.1.4** The Contractor shall allow for compliance with all statutory safety regulations, including those of the Purchaser, and executing the Services in such an order or sequence as may be required to accord with the overall Project programme requirements.



## **5.3 Schedule of Rates**

### **5.3.1 General**

#### **5.3.1.1 Schedule of Rates**

A schedule of rates is to accompany the tender.

#### **5.3.1.2 Man-hours**

The Man-hour Rates which the Contractor inserts in the Schedule shall be deemed to include, but not necessarily be restricted to all allowances required for the following:

All cost associated with the employment of labour including the requirements of Government enactment's (V.A.T. excepted) and/or other suitable National Working Rule Agreement.

Supervision by non-working trade supervisors, other than those allowed separately by the Contractor in the General Preliminaries section of the Tender.

All man-hours and costs associated with collecting "Free Issue" materials from the Purchaser's stores or compounds and transporting to the Contractor's store or workshop, including all loading, unloading, stacking and storage. Also any costs associated with off-loading, stacking and storage of materials supplied by the Contractor. Compilation of stores record system and final reconciliation for all "Free Issue" materials. Generally this store will be located on the site.

Loading and transporting from the Contractor's store or compound and assembling and installing in the final position.

The installation of all work and operations required by the Specifications and Works Rules and Regulations.

The carrying out of any tests including submission of samples where required. Any necessary site measurement and sketching for fabrication and erection purposes.

Marking up construction drawings to record the "As Built" installation.

All necessary allowances for small hand tools and consumables which are not included as Constructional Plant in the General Preliminaries section of the Tender.

Protecting the works during construction period from damage and for making good /reinstating damage caused.

All required allowances for overhead and profit.



### 5.3.2 Materials

The material prices which the Contractor inserts in the Schedule of Rates shall be deemed to include the following:-

All costs associated with delivery to the Contractor's site stores or compound.

Any demurrage charges or costs associated with returning packing cases, drums and the like for materials supplied by the Contractor.

All necessary allowances for waste.

All necessary allowances for consumables.

All necessary fixing devices.

### 5.3.3 Testing

The man-hour rates shall include for all testing.

### 5.3.4 Schedule of Day work Rates

Variations shall be valued on a lump sum basis. Such lump sums shall be derived from the Schedule of Rates below and the man-hour estimates for the variations which the Engineer has agreed in writing and all of which shall be subject to the issue of a Variation Order.

Position	40 Hour Rate	Time & ½ Rate	Double Time
Site Supervision			
Working Foreman			
CompEx Approved Technician			
Approved Electrician			
Electrician			
Labourer			

Percentage to be added to net cost of materials %

### Site Establishment

Cost inclusive of site management, office facilities, £  
messing, toilets and constructional equipment at a weekly rate.



## 5.4 Programme

### 5.4.1 Provisional Programme

The following information is supplied for the guidance of the Tenderer and is provisional only, based upon the information available at the time of issue of the Tender:

1. Site visit – TBA (if required)
2. Tender required by – ASAP
3. Earliest date on which work can commence – Immediate
4. No.5 Switchroom 415V MCC delivery to site – w/c 25/10/10
5. Latest date for completion, including all testing – 29/10/10

The tenderer shall include a provisional programme with the tender to include key milestones for delivery of equipment within their supply.



## 6. Tender Pricing Summary

This tender summary to be completed by the tenderer, applies to the Scope of Work for the Arcton area stripping pump and sump pump project for ISCo East terminal.

- |    |  |   |
|----|--|---|
| 1. | Supply and installation of containment | £ |
| 2. | Supply and Installation of cabling     | £ |
| 3. | Supply and installation of earthing    | £ |
| 4. | Testing and Documentation              | £ |
| 5. | Miscellaneous (Please State)           |   |

**Sub Total** £

**Site Establishment Total** (based on ..... weeks) £  
(See Section 5.3.4)

**Total Tender Price** £





## Appendix I

### Drawings

Cable Overview Drawing

SI039001\_DWG\_C & D

Logic Drawings

SI039002\_DWG\_C & D

SI039003\_DWG\_B & C

SI039004\_DWG\_B & C

SI039005\_DWG\_B & C

SI039006\_DWG\_B & C

SI039007\_DWG\_B & C

SI039008\_DWG\_B & C

Loop Sheets

SI039010\_DWG\_C & D

SI039011\_DWG\_C & D

SI039012\_DWG\_C & D

SI039013\_DWG\_C & D

SI039014\_DWG\_B & C


SI760001\_DWG\_A

SI760002\_DWG\_A

Panel Layout Drawing

SI039016\_DWG\_C & D



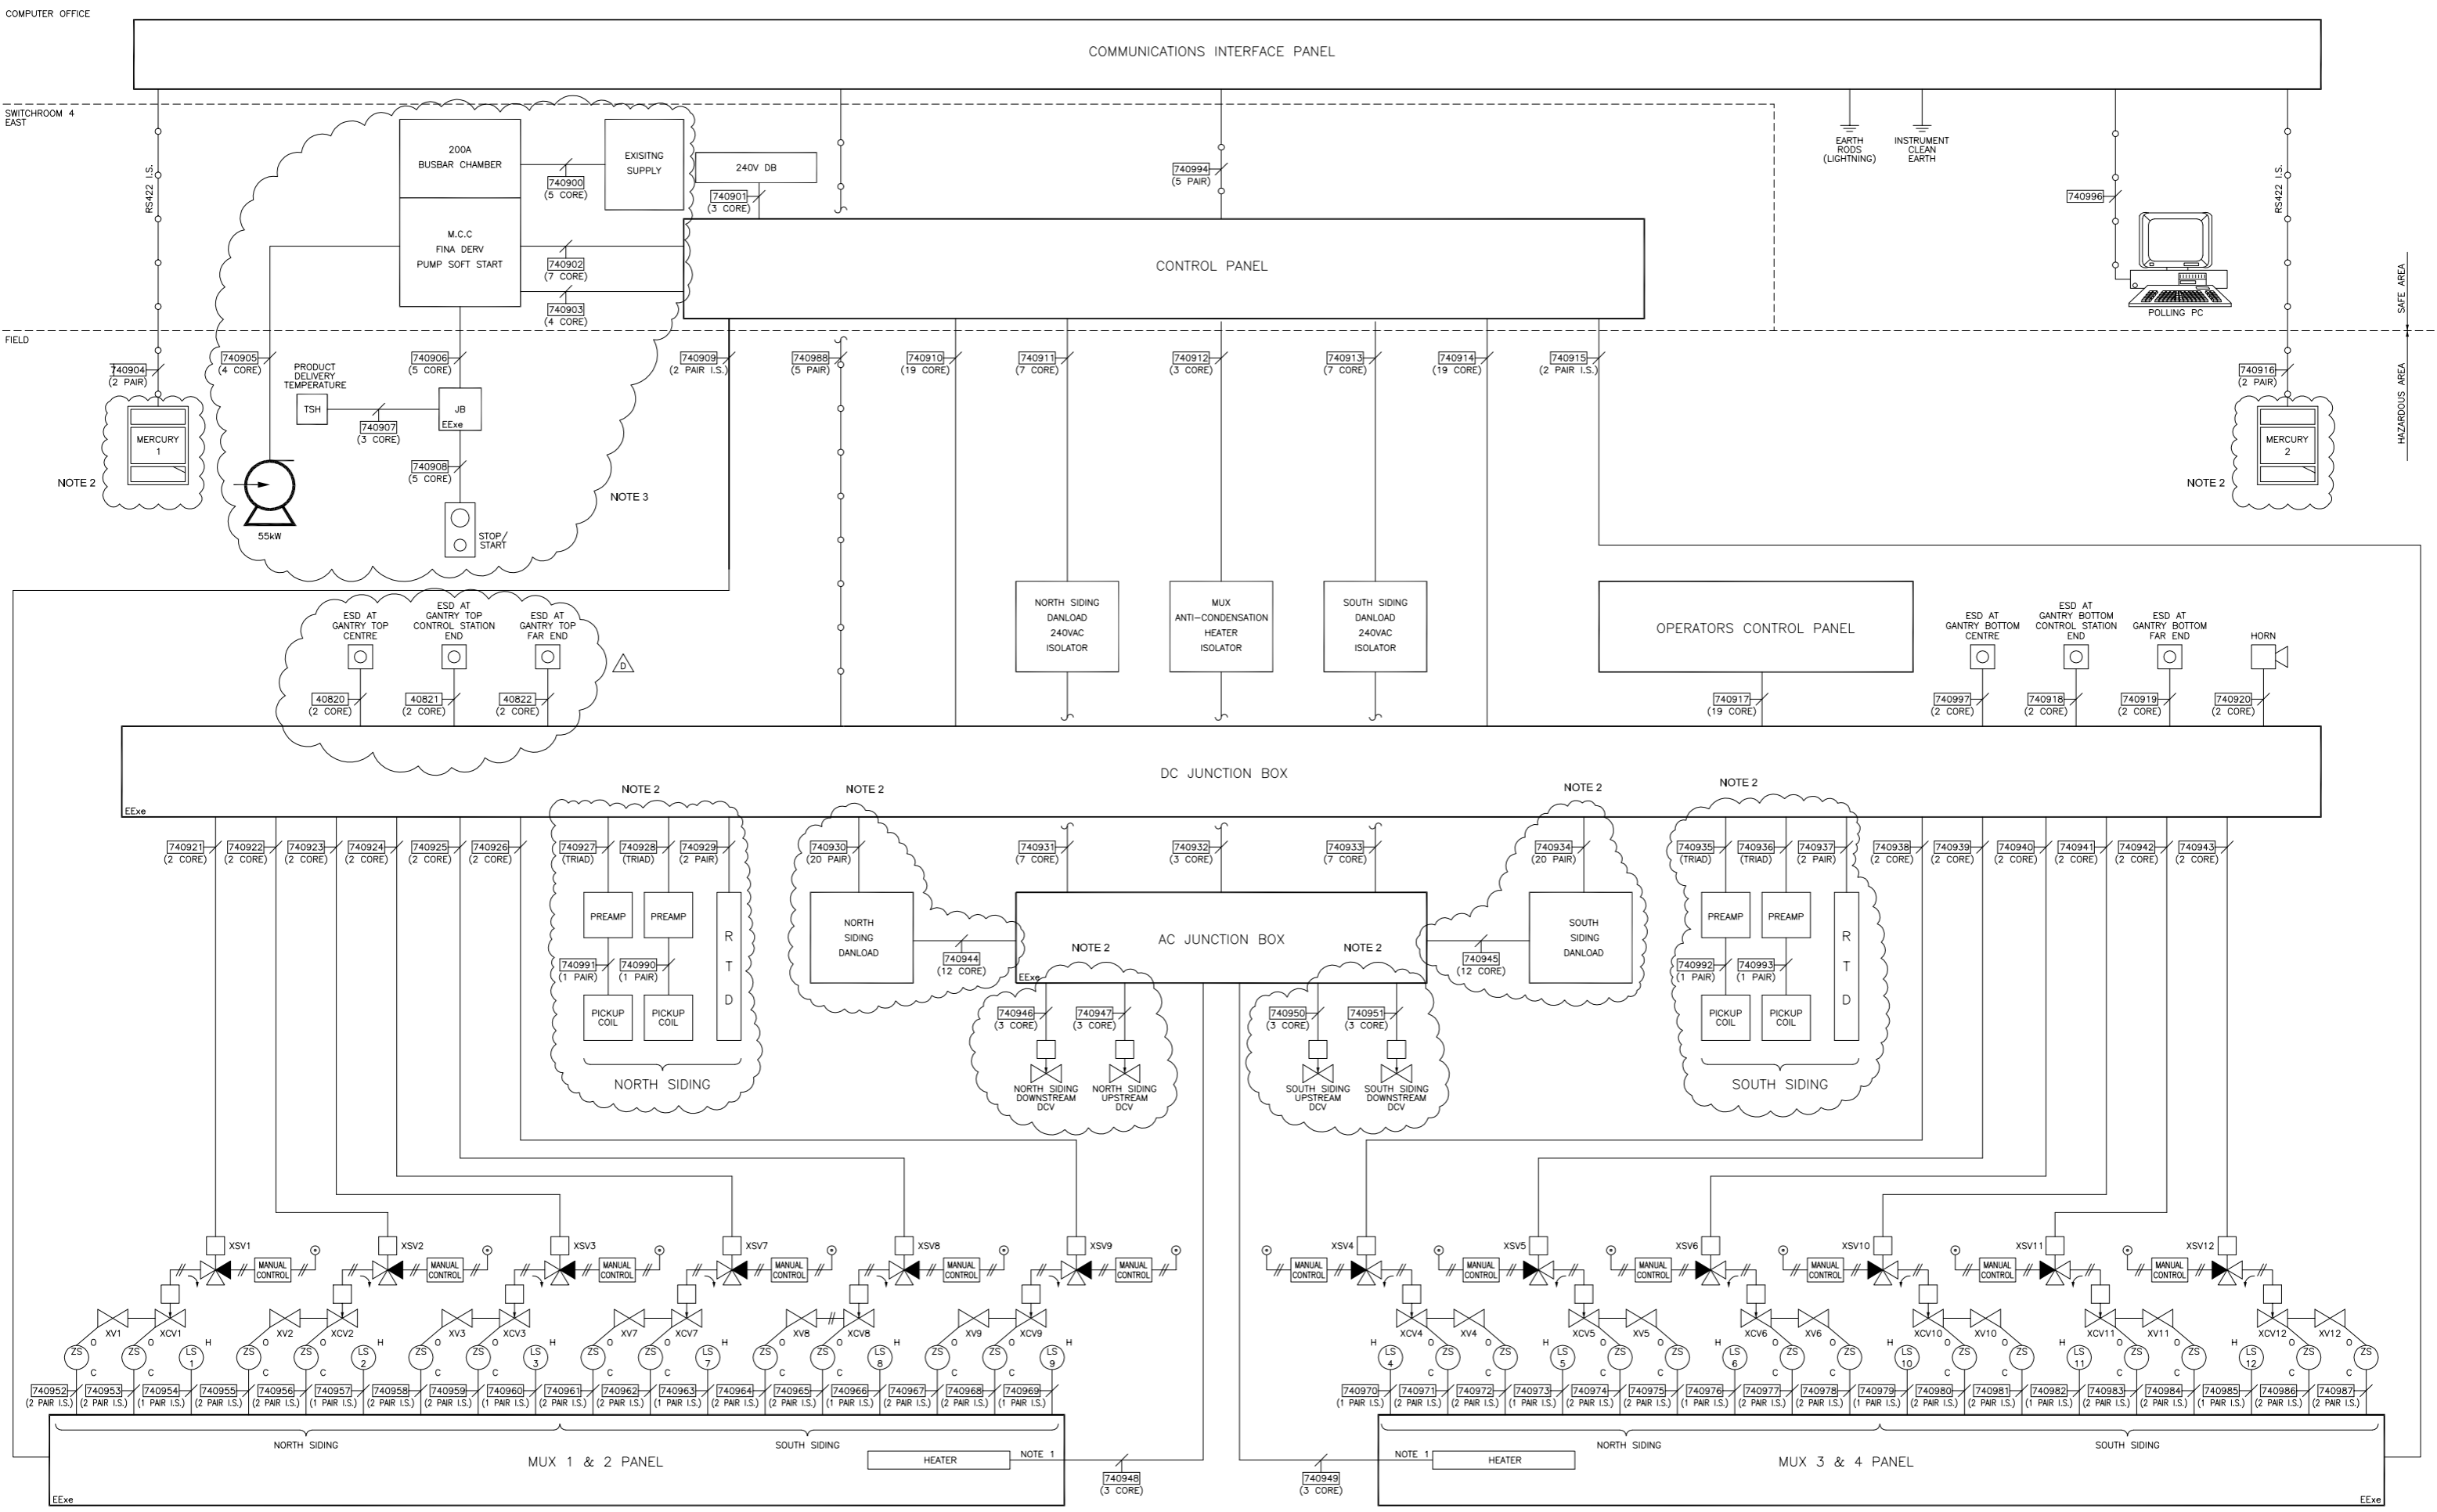

- NOTES**
- VIA SAK2.5 EEx'e' TERMINALS
  - EQUIPMENT HIGHLIGHTED TO BE REMOVED.
  - DECOMMISSIONED BATCHING SYSTEM.



IF NOT SIGNED THIS DOCUMENT IS UNCONTROLLED							PLANT	IMMINGHAM STORAGE Co. - EAST TERMINAL
REV	DATE	BY	DRN	CHK'D	APP'D	DESCRIPTION	TITLE	4-EAST RAIL LOADING SYSTEM OVERVIEW
A	18/02/99	D.R.R.	A.J.H.	P.J.P.	P.J.P.	D.R.R. D.R.R.	ORIGINAL ISSUE	
B	07/04/99	A.J.H.	A.J.H.	D.R.R.	D.R.R.	D.R.R. D.R.R.	GENERAL UPDATE	
C	02/07/99	D.P.	A.J.H.	D.R.R.	D.R.R.	D.R.R. D.R.R.	EARTH RODS UPDATED	
D	17/09/10	D.B.F.	P.P.	M.M.	M.M.		SI760 MODIFICATIONS	


CLIENT DRG. No.	P&I DRG No. SI039001_DWG
-----------------	--------------------------

IMMINGHAM STORAGE Co. Ltd.  
 IMMINGHAM EAST TERMINAL  
 IMMINGHAM DOCK,  
 IMMINGHAM,  
 SOUTH HUMBERSIDE

**simon**

**P & I DESIGN**  
 P & I Design Ltd  
 Tel. 01642 617444  
 www.pidesign.co.uk

SHEET 1 OF 1

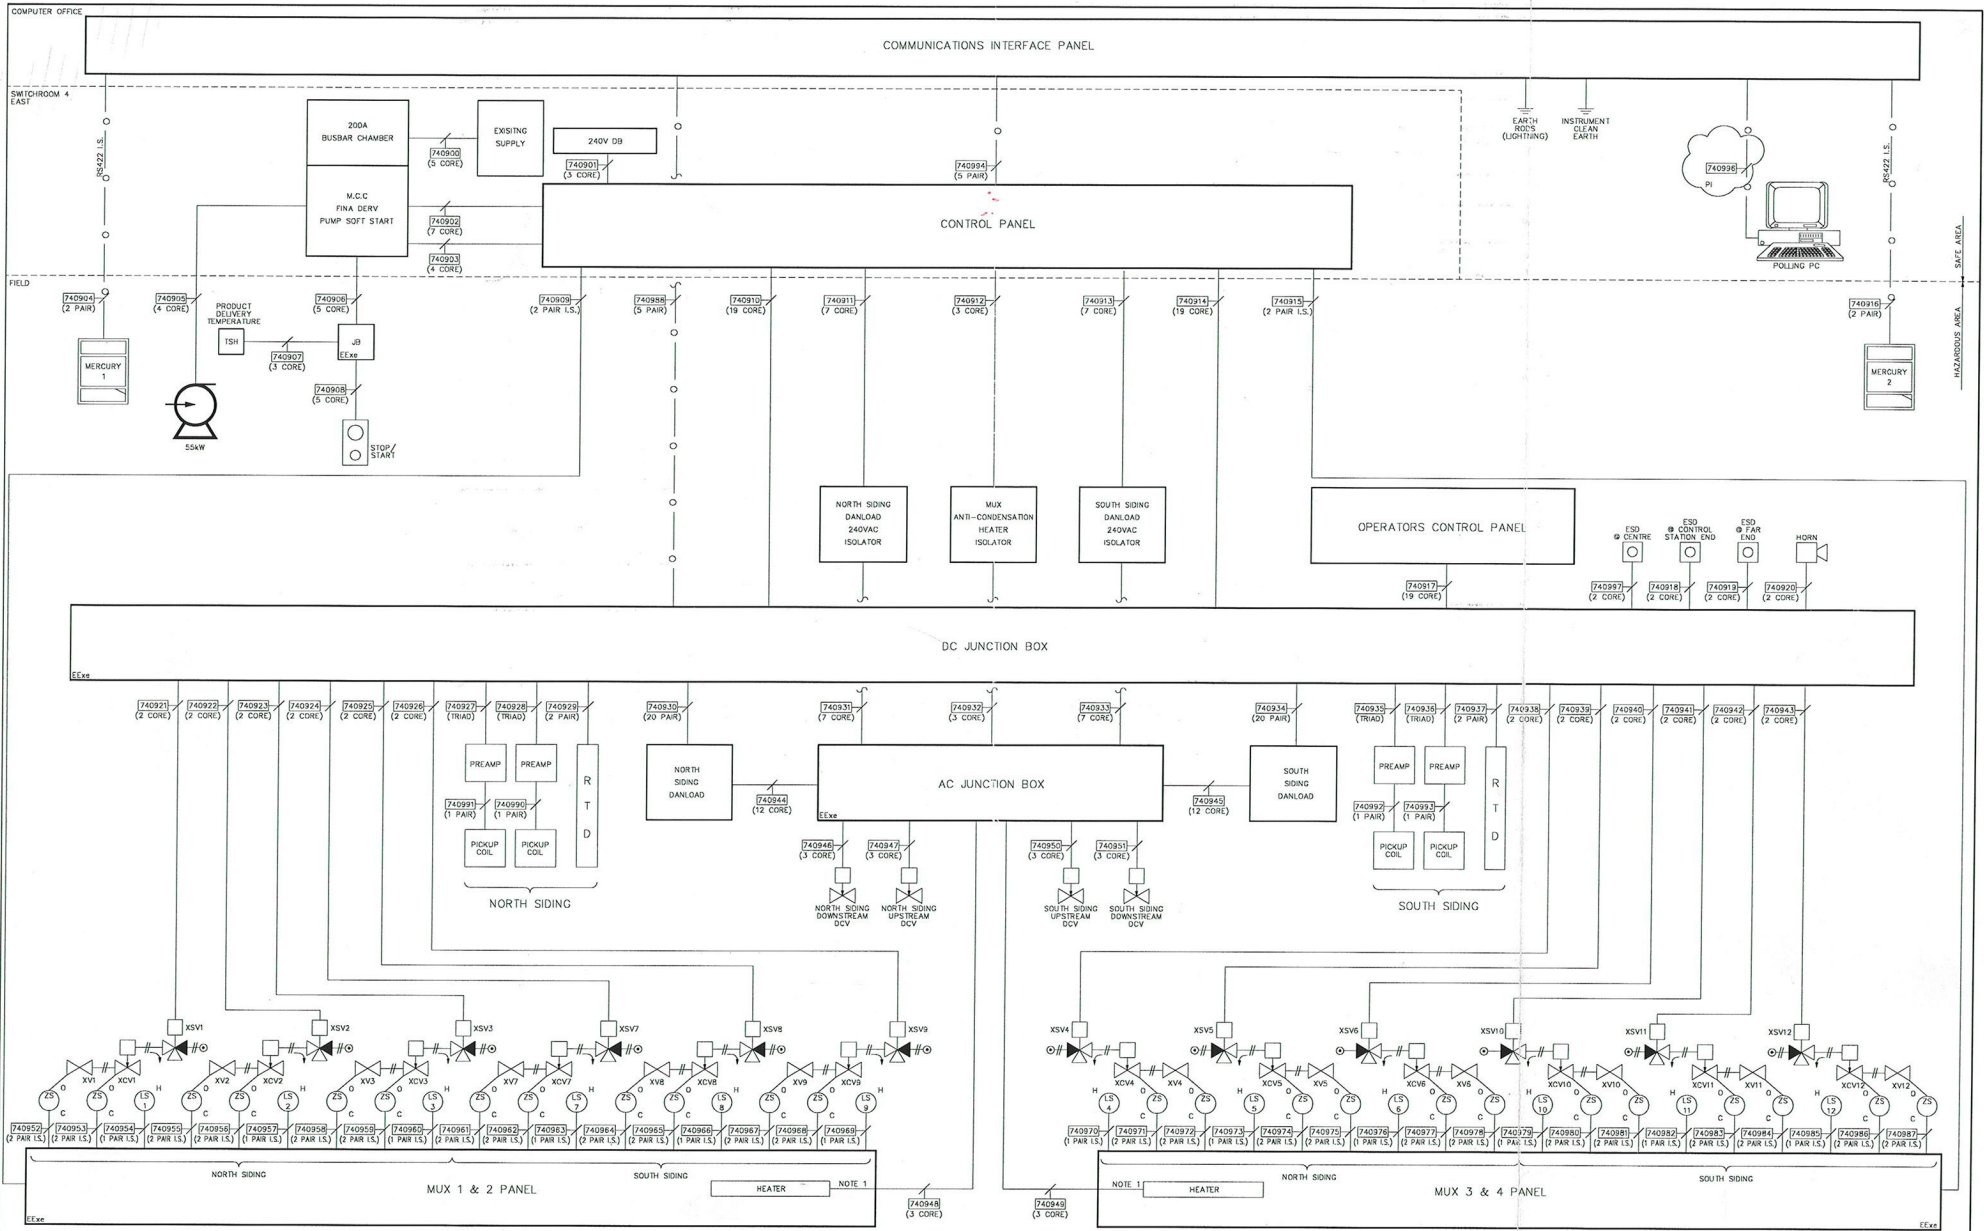


NOTES  
 1. VIA SAK2.5 EEx'a TERMINALS

REV	DATE	BY	DRN	CHK'D	APP'D	DESCRIPTION	PLANT	FNA DERV RAIL LOADING SYSTEM
A	18/02/99	D.R.R.	A.J.H.	P.J.P.	P.J.P.	D.R.R.	ORIGINAL ISSUE	
B	07/04/99	A.J.H.	A.J.H.	D.R.R.	D.R.R.	D.R.R.	GENERAL UPDATE	
C	02/07/99	D.P.	A.J.H.	D.R.R.	D.R.R.	D.R.R.	EARTHING RODS UPDATED	02/07/99

<b>Simon Storage Terminals</b>	IMMINDAH STORAGE Co. Ltd. IMMINDAH EAST TERMINAL IMMINDAH DOCK, IMMINDAH, SOUTH AUSTRALIA	01 OF 01
CLIENT DRG. No.		P&I DRG. No. SID9001






LEGEND OF GRAPHICAL SYMBOLS (ALL CONTACTS SHOWN IN THE DE-ENERGISED STATE)

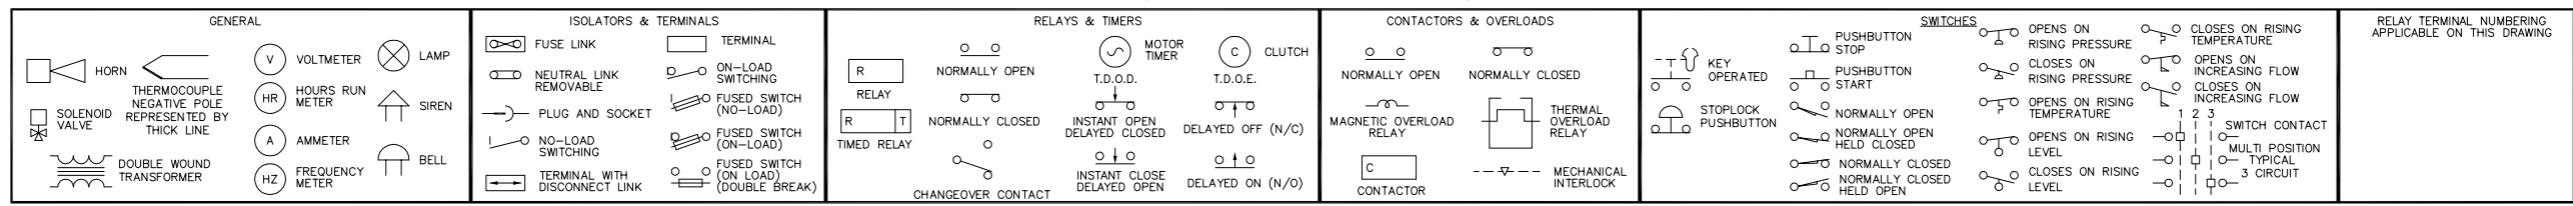

**POWER DISTRIBUTION**

**LEVEL**

**ESD**

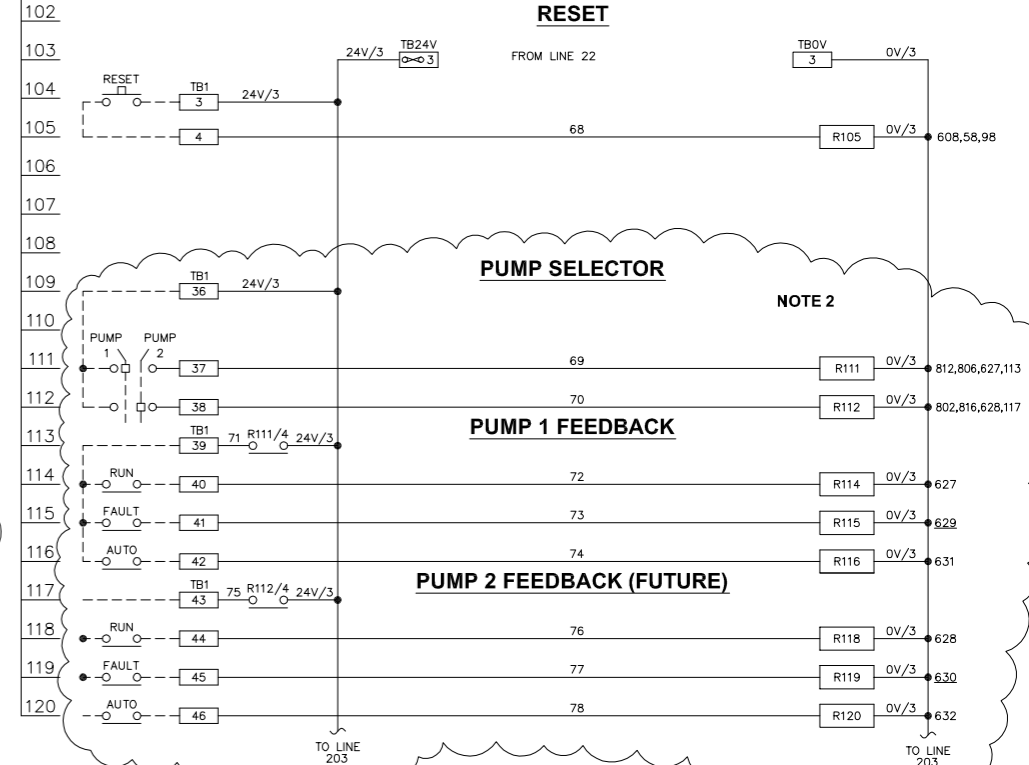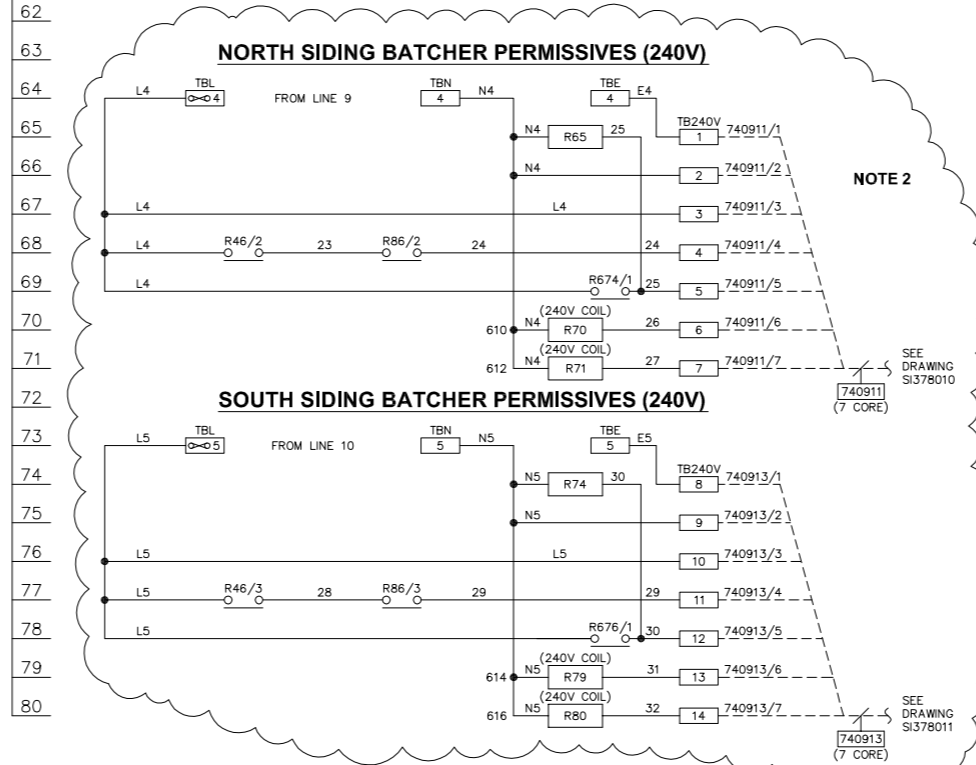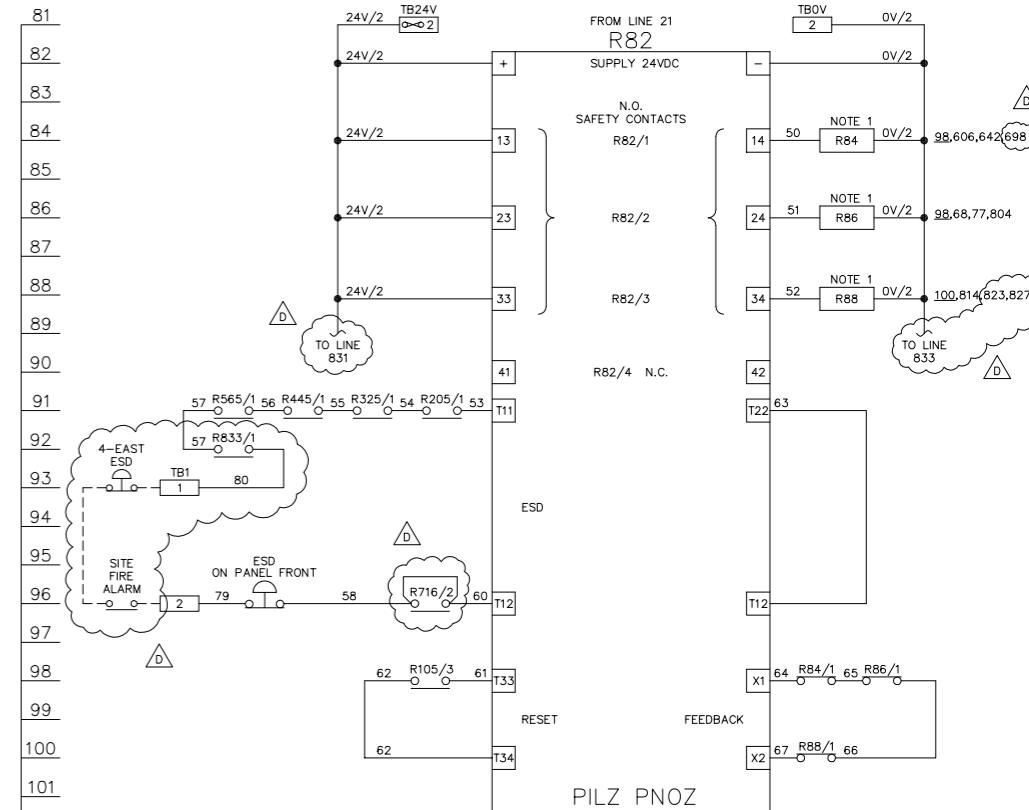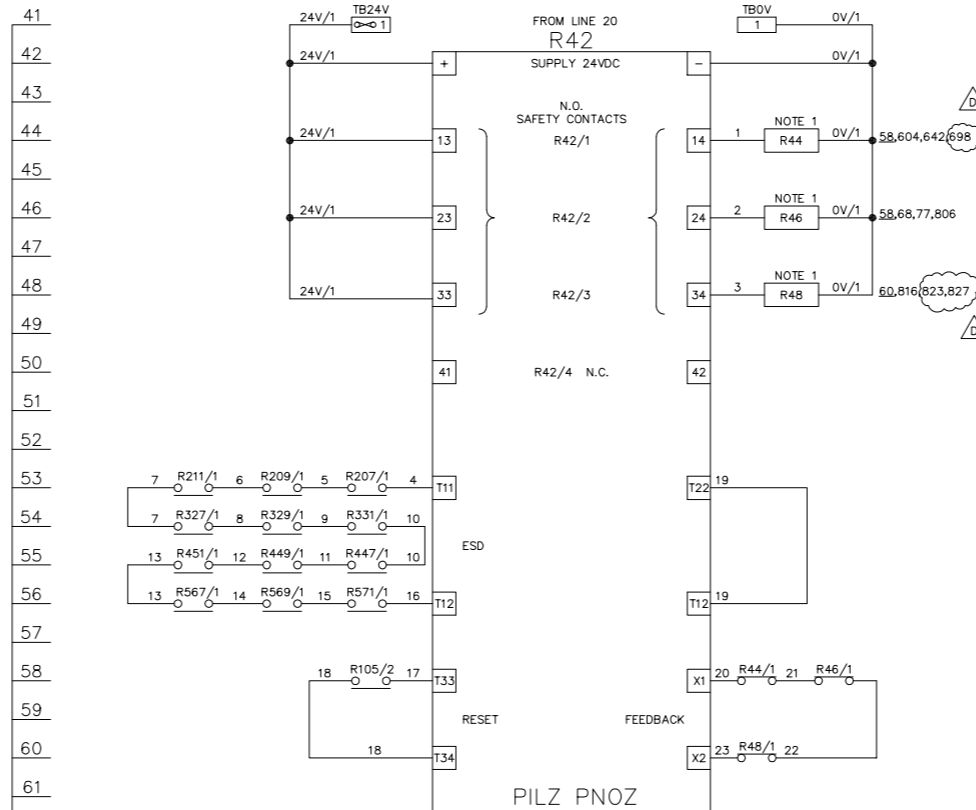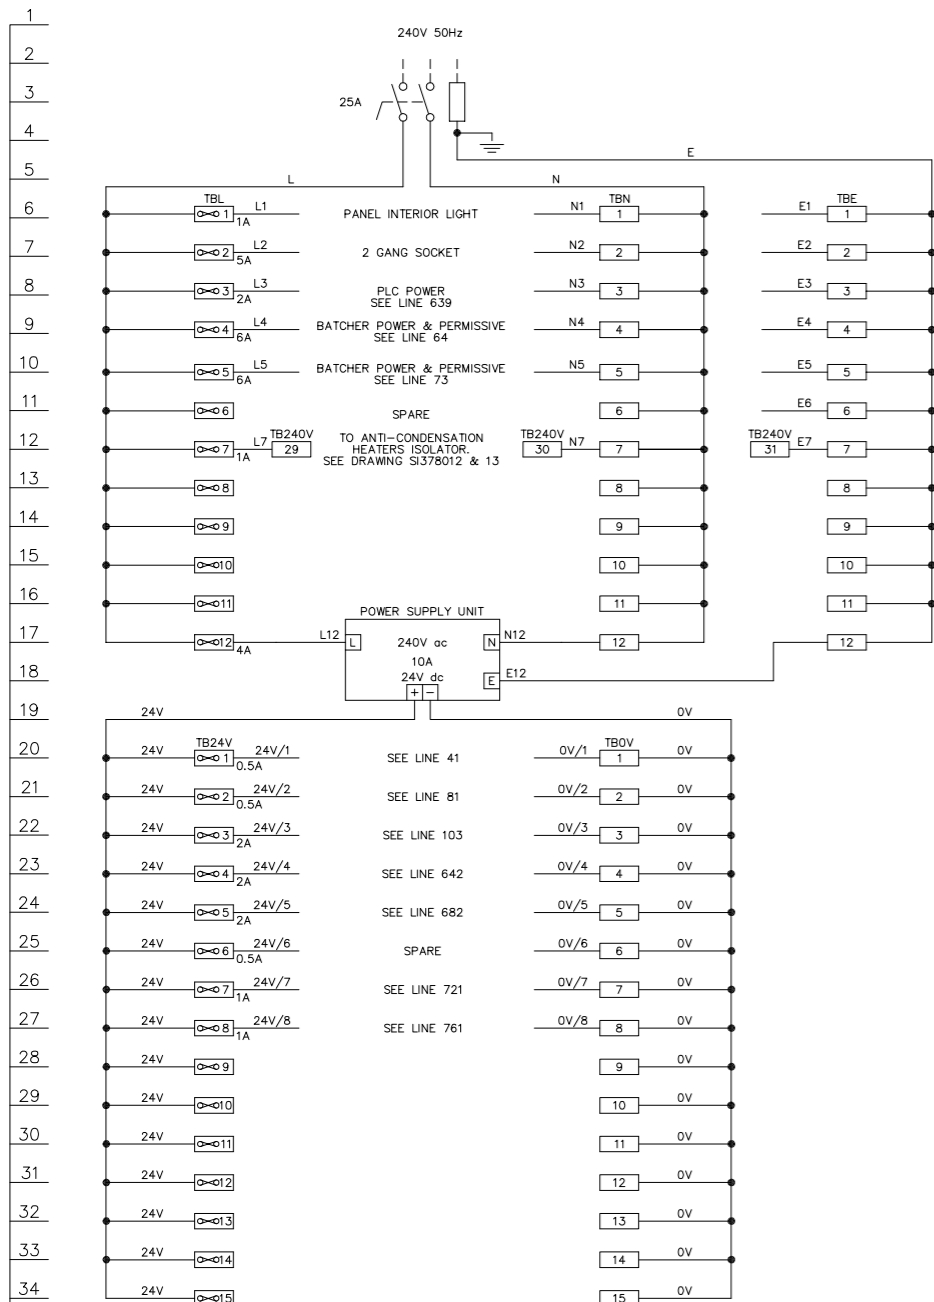

- NOTES**  
 1. OMRON G7S-4A2B GUIDED CONTACT RELAY (RS260-4373)  
 2. DECOMMISSIONED BATCHING SYSTEM. INPUTS NOT USED IN PLC




REV	DATE	BY	DRN	CHK'D	APP'D	DESCRIPTION
A	07/04/99	A.J.H.	A.J.H.	D.R.R.	D.R.R.	ORIGINAL ISSUE
B	14/03/99	A.J.H.	A.J.H.	D.R.R.	D.R.R.	GENERAL UPDATE
C	01/07/99	D.P.	A.J.H.	D.R.R.	D.R.R.	PANEL TEST MODS
D	14/09/10	D.B.F.	P.P.	M.M.	M.M.	SI760 MODIFICATIONS


PLANT	IMMINGHAM STORAGE Co. - EAST TERMINAL
TITLE	4-EAST RAIL LOADING SYSTEM PANEL LOGIC DRAWING 1
CLIENT DRG. No.	IMMINGHAM STORAGE Co. Ltd. IMMINGHAM EAST TERMINAL, IMMINGHAM DOCK, IMMINGHAM, SOUTH HUMBERSIDE
P&I DRG No.	SI039002_DWG




LEGEND OF GRAPHICAL SYMBOLS (ALL CONTACTS SHOWN IN THE DE-ENERGISED STATE)

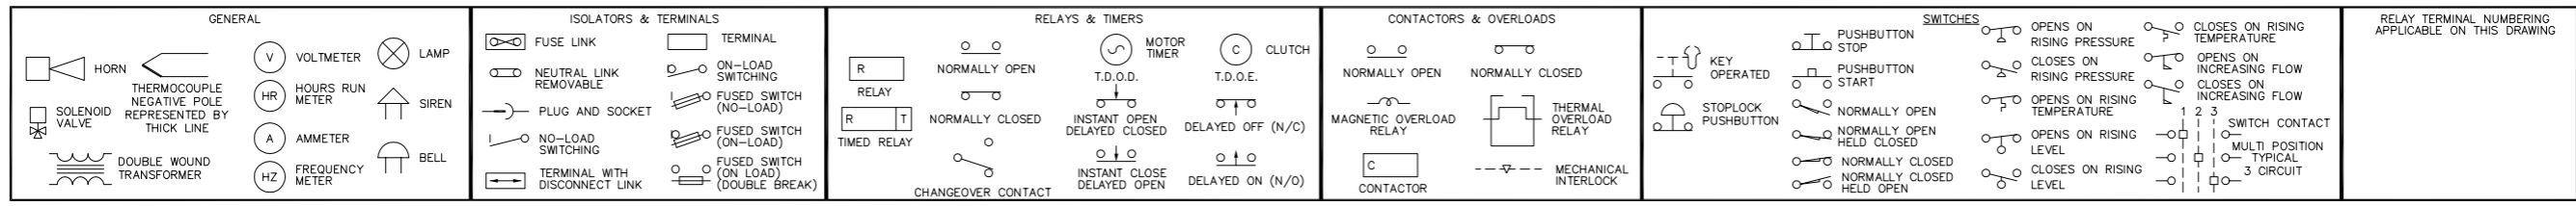


**POWER DISTRIBUTION**

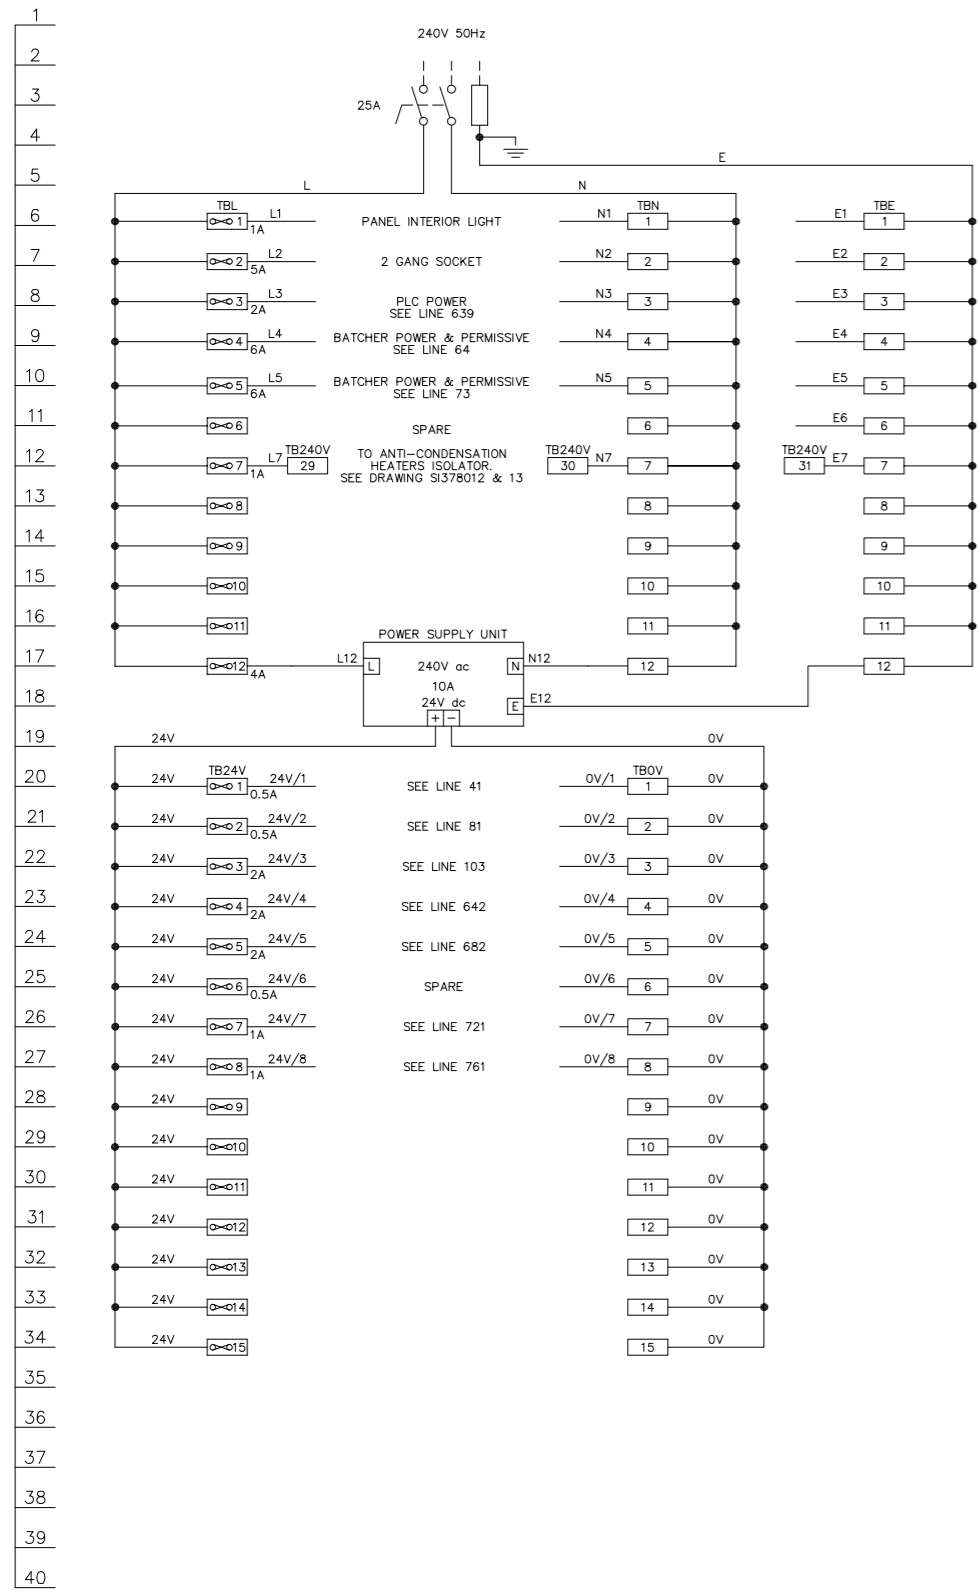


**LEVEL**

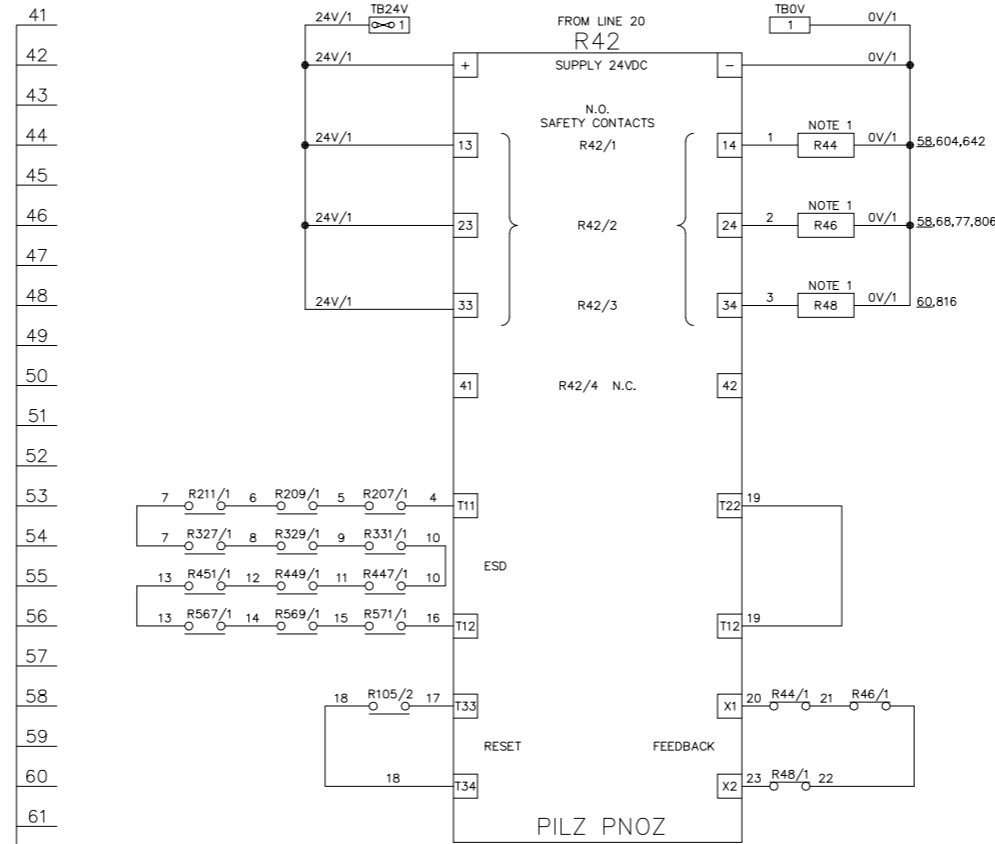


**ESD**

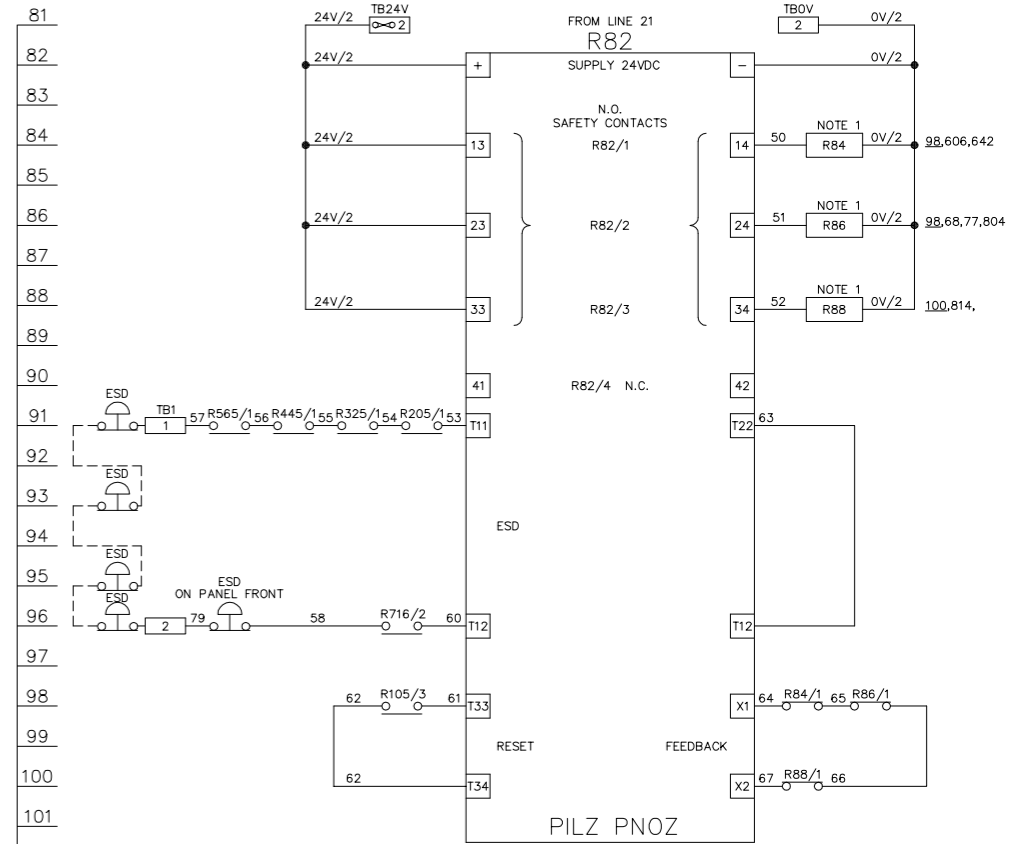


**NORTH SIDING BATCHER PERMISSIVES (240V)**

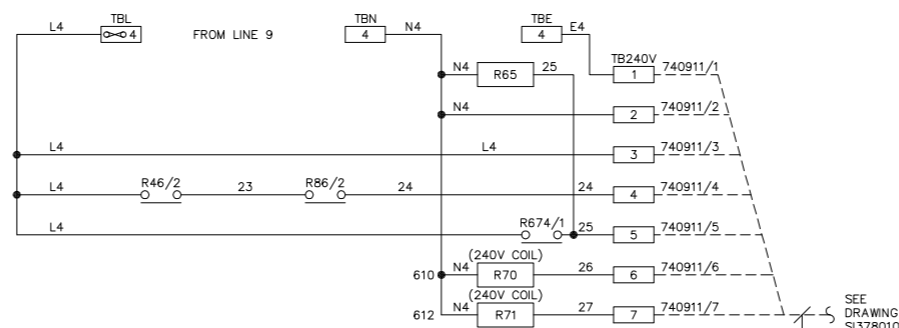

**SOUTH SIDING BATCHER PERMISSIVES (240V)**

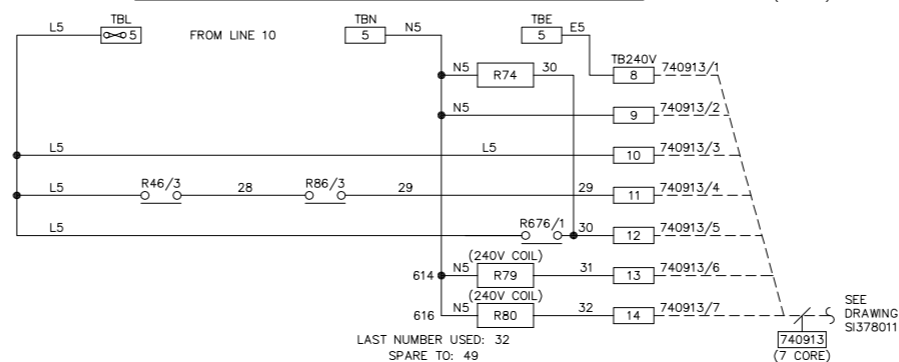

**RESET**

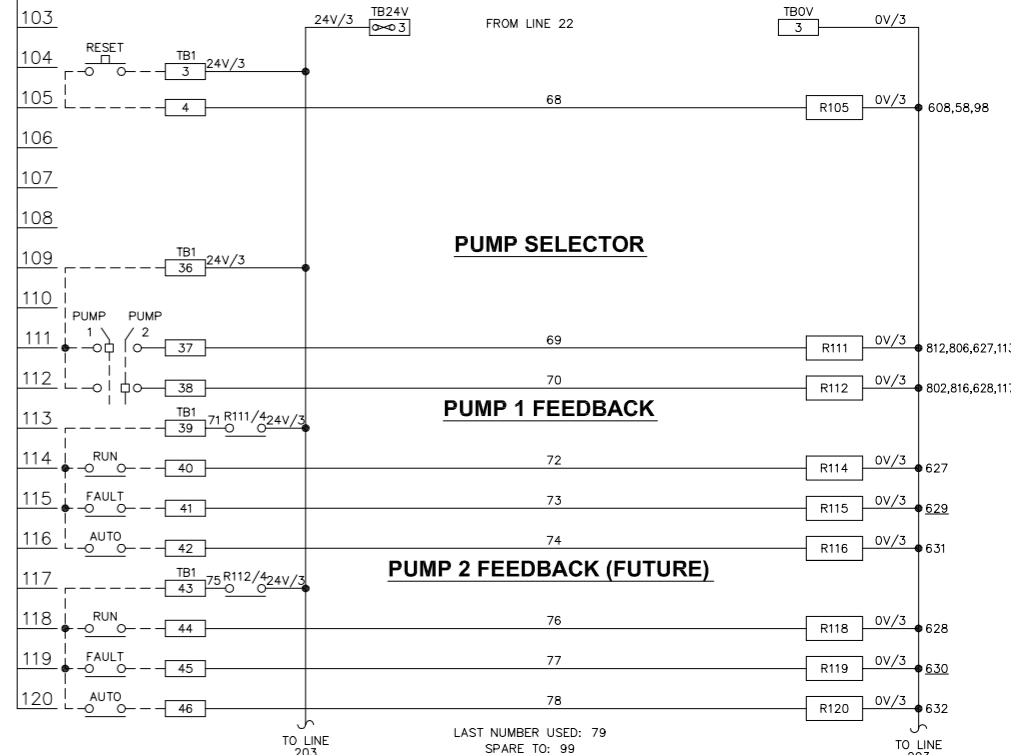

**PUMP SELECTOR**

**PUMP 1 FEEDBACK**

**PUMP 2 FEEDBACK (FUTURE)**

**NOTES**  
 1. RELAY WITH POSITIVELY GUIDED CONTACTS RS STOCK CODE (RS260-4373)

REV	DATE	BY	DRN	CHK'D	APP'D	DESCRIPTION	PLANT	FINA DERV RAIL LOADING SYSTEM
A	07/04/99	A.J.H	A.J.H	P.J.P	P.J.P	D.R.R	D.R.R	ORIGINAL ISSUE
B	14/03/99	A.J.H	A.J.H	D.R.R	D.R.R	D.R.R	D.R.R	GENERAL UPDATE
C	01/07/99	D.P.	A.J.H	D.R.R	D.R.R	D.R.R	D.R.R	PANEL TEST MODS

LAST NUMBER USED: 32 SPARE TO: 49  
 LAST NUMBER USED: 79 SPARE TO: 99

TO LINE 203 TO LINE 203


CLIENT DRG. No. P&I DRG No. SIO39002

02/07/99  
**Simon Storage** TERMINALS  
 IMMINGHAM STORAGE Co Ltd,  
 IMMINGHAM EAST TERMINAL,  
 IMMINGHAM DOCK, IMMINGHAM,  
 SOUTH HUMBERSIDE


**P & I DESIGN**

ELECTRICAL SCHEMATIC TEMPLATE SHEET 01 OF 01  
 CLIENT DRG. No. P&I DRG No. SIO39002

LEGEND OF GRAPHICAL SYMBOLS (ALL CONTACTS SHOWN IN THE DE-ENERGISED STATE)

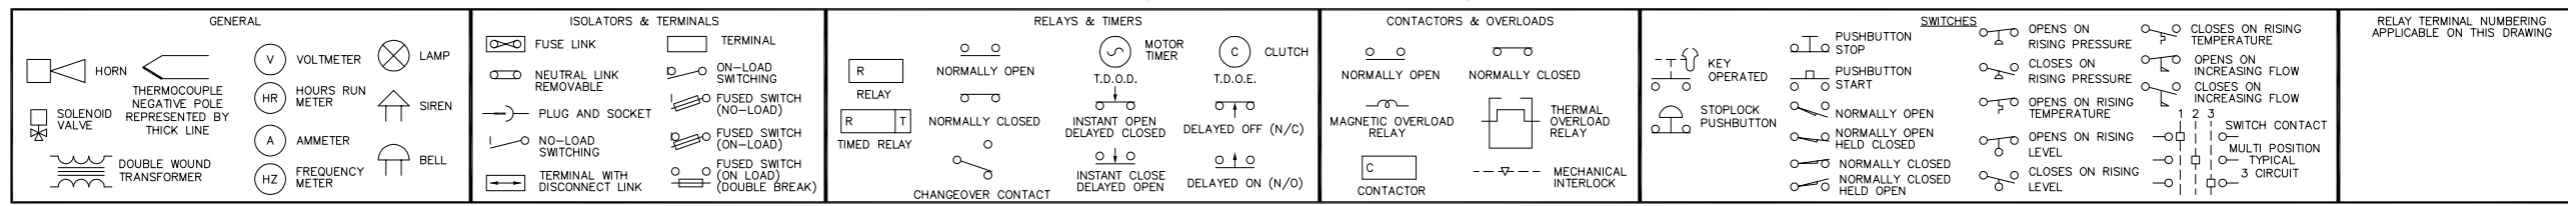

**MUX 1 (NORTH SIDING)**

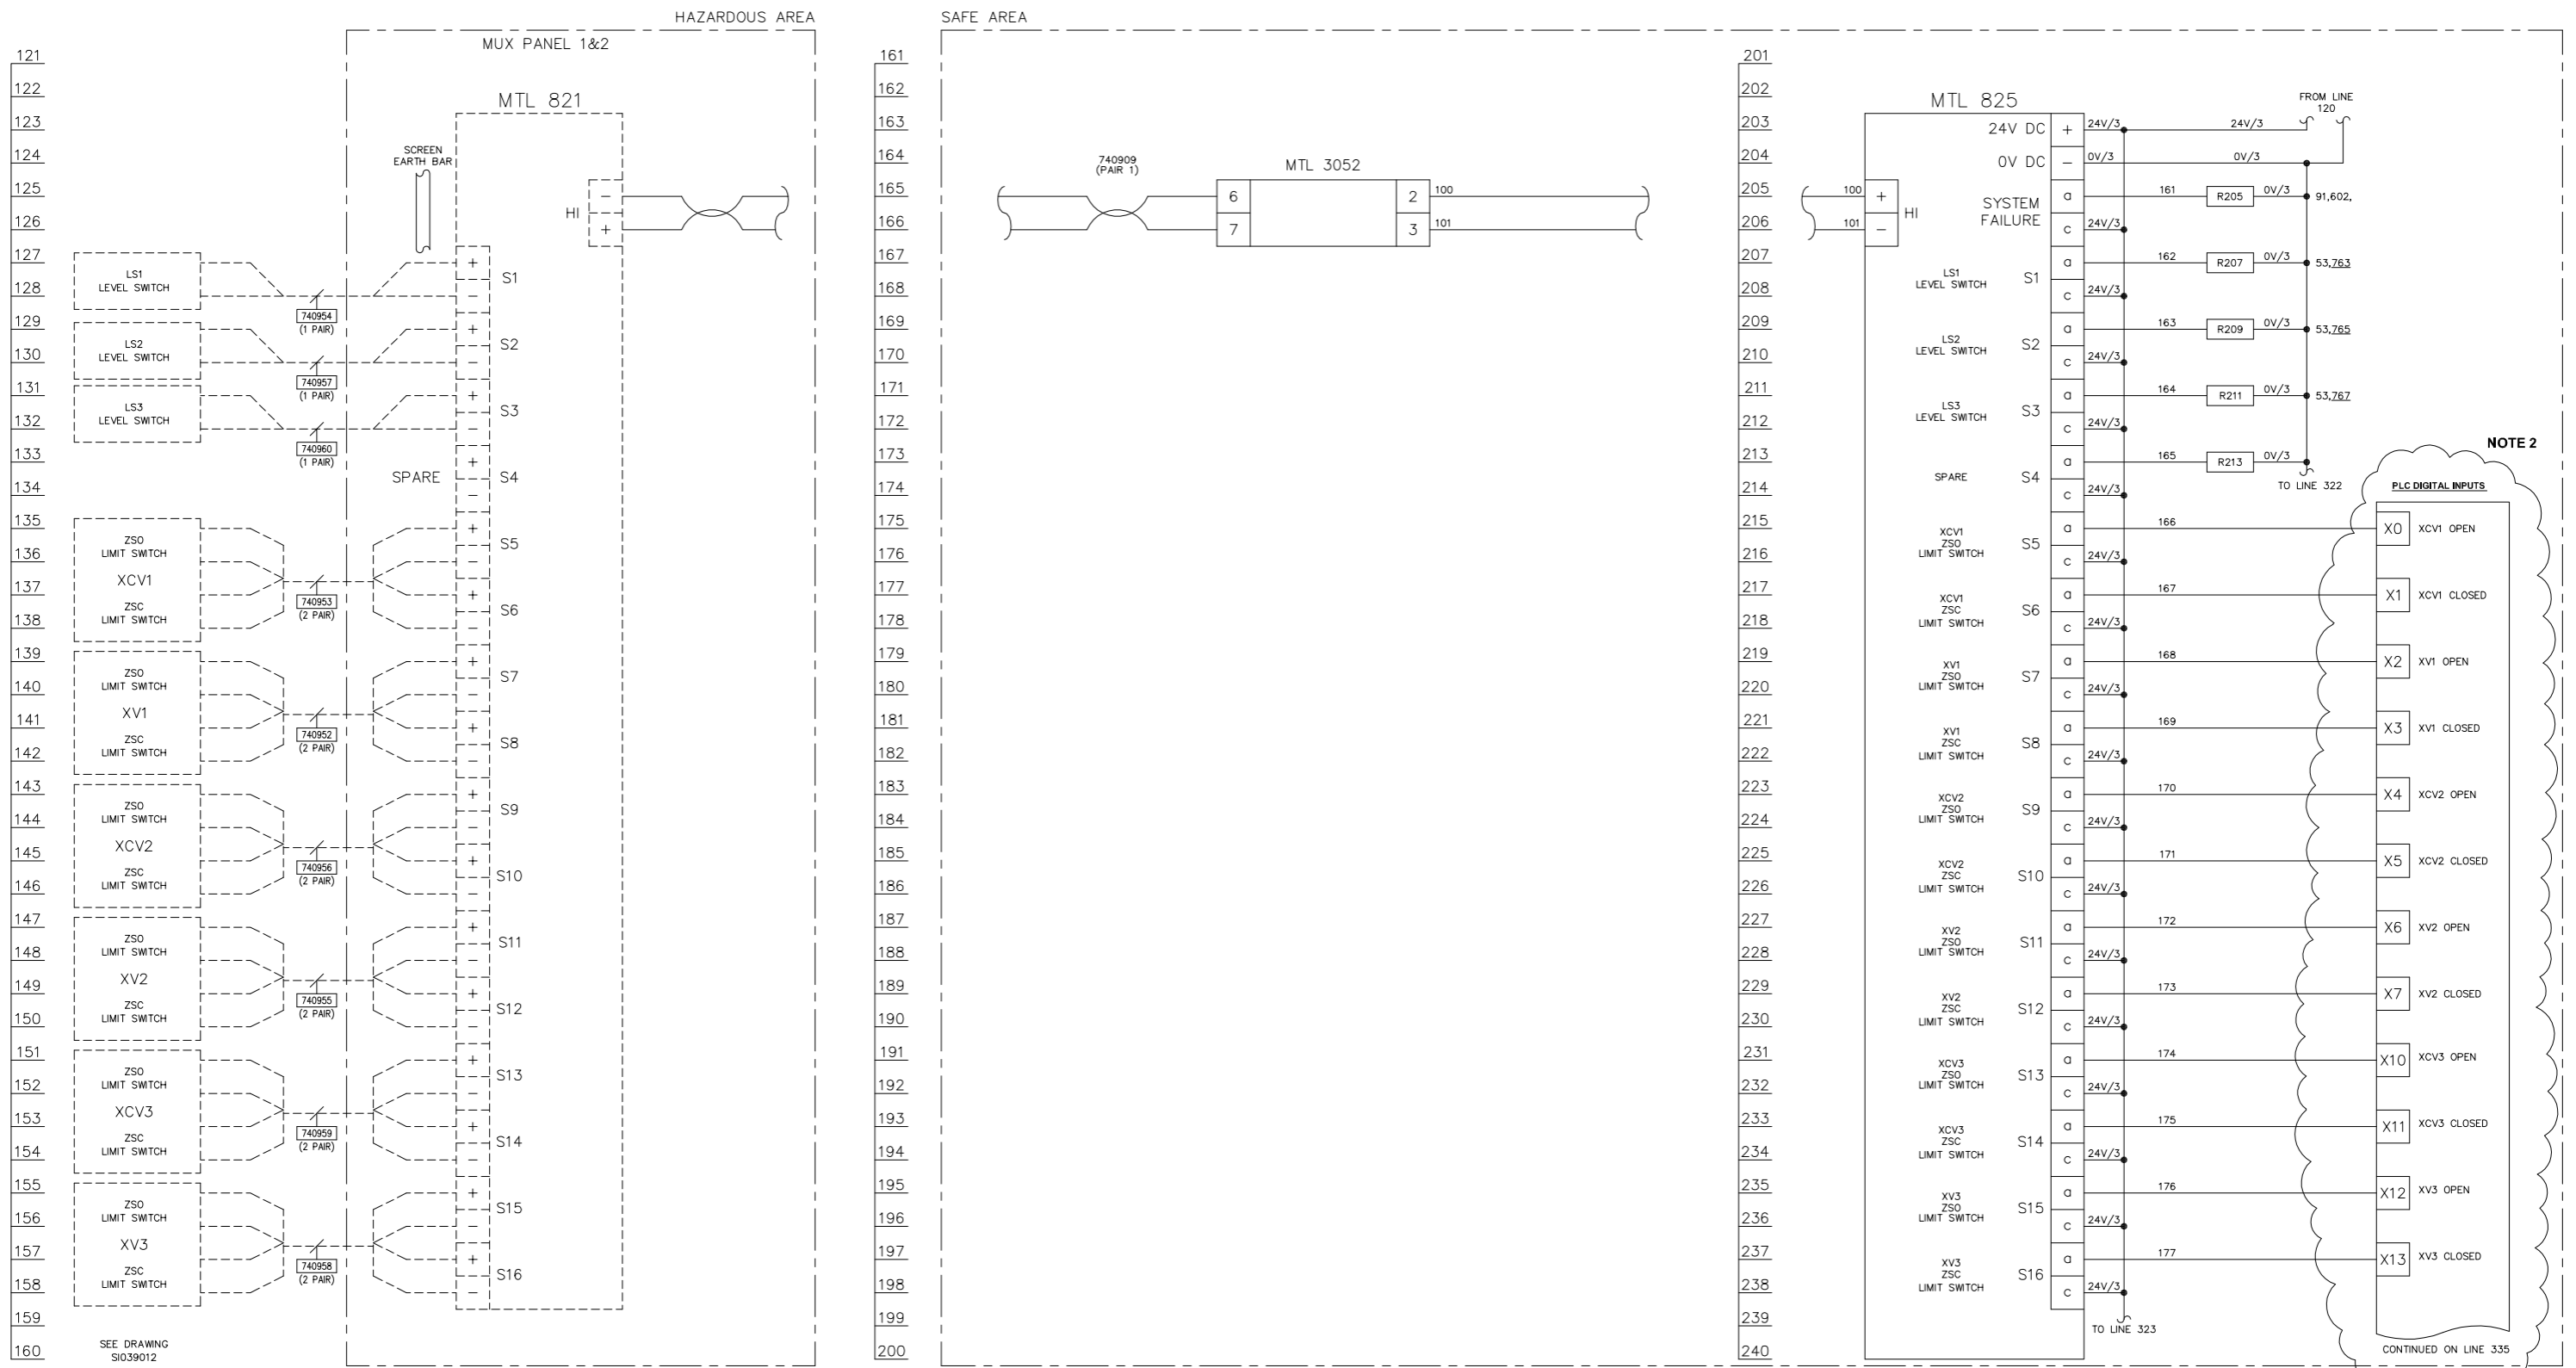

LAST NUMBER USED: 101  
 SPARE TO: 160

LAST NUMBER USED: 177  
 SPARE TO: 199

**NOTES**


- SCREEN EARTHS NOT SHOWN FOR CLARITY.
- DECOMMISSIONED BATCHING SYSTEM. INPUTS NOT USED IN PLC




IF NOT SIGNED THIS DOCUMENT IS UNCONTROLLED

REV	DATE	BY	DRN	CHK'D	APP'D	DESCRIPTION
A	07/04/99	A.J.H	A.J.H	D.R.R	D.R.R	ORIGINAL ISSUE
B	07/07/99	A.J.H	A.J.H	D.R.R	D.R.R	COMMS POLARITY REVERSED
C	14/09/10	D.B.F	P.P.	M.M.	M.M.	SI760 MODIFICATIONS

PLANT	IMMINGHAM STORAGE Co. - EAST TERMINAL
TITLE	4-EAST RAIL LOADING SYSTEM PANEL LOGIC DRAWING 2
CLIENT DRG. No.	IMMINGHAM STORAGE Co. Ltd. IMMINGHAM EAST TERMINAL, IMMINGHAM DOCK, IMMINGHAM, SOUTH HUMBERSIDE
P&I DESIGN	P & I Design Ltd Tel. 01642 617444 www.pidesign.co.uk
SHEET 1 OF 1	
P&I DRG No.	SI039003_DWG

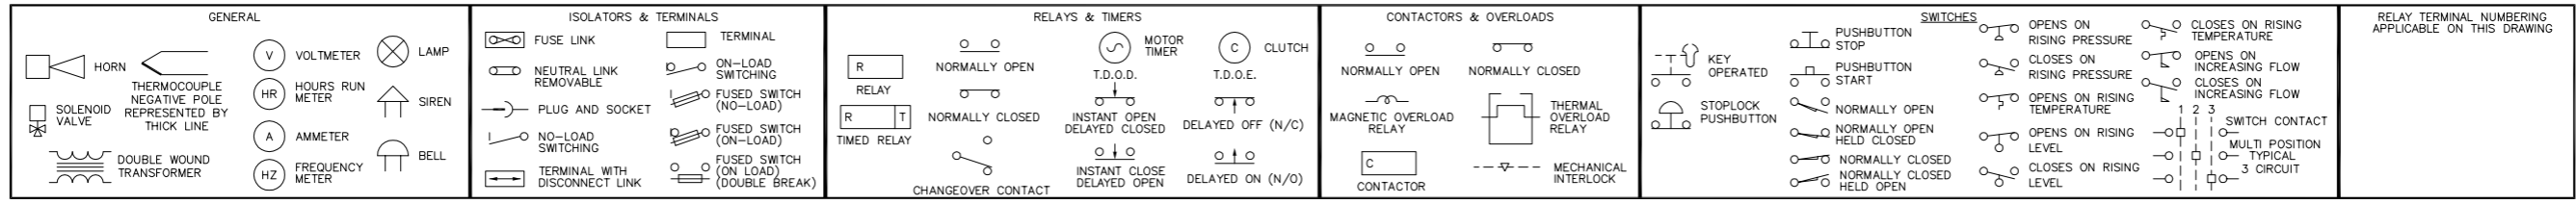

**MUX 1 (NORTH SIDING)**

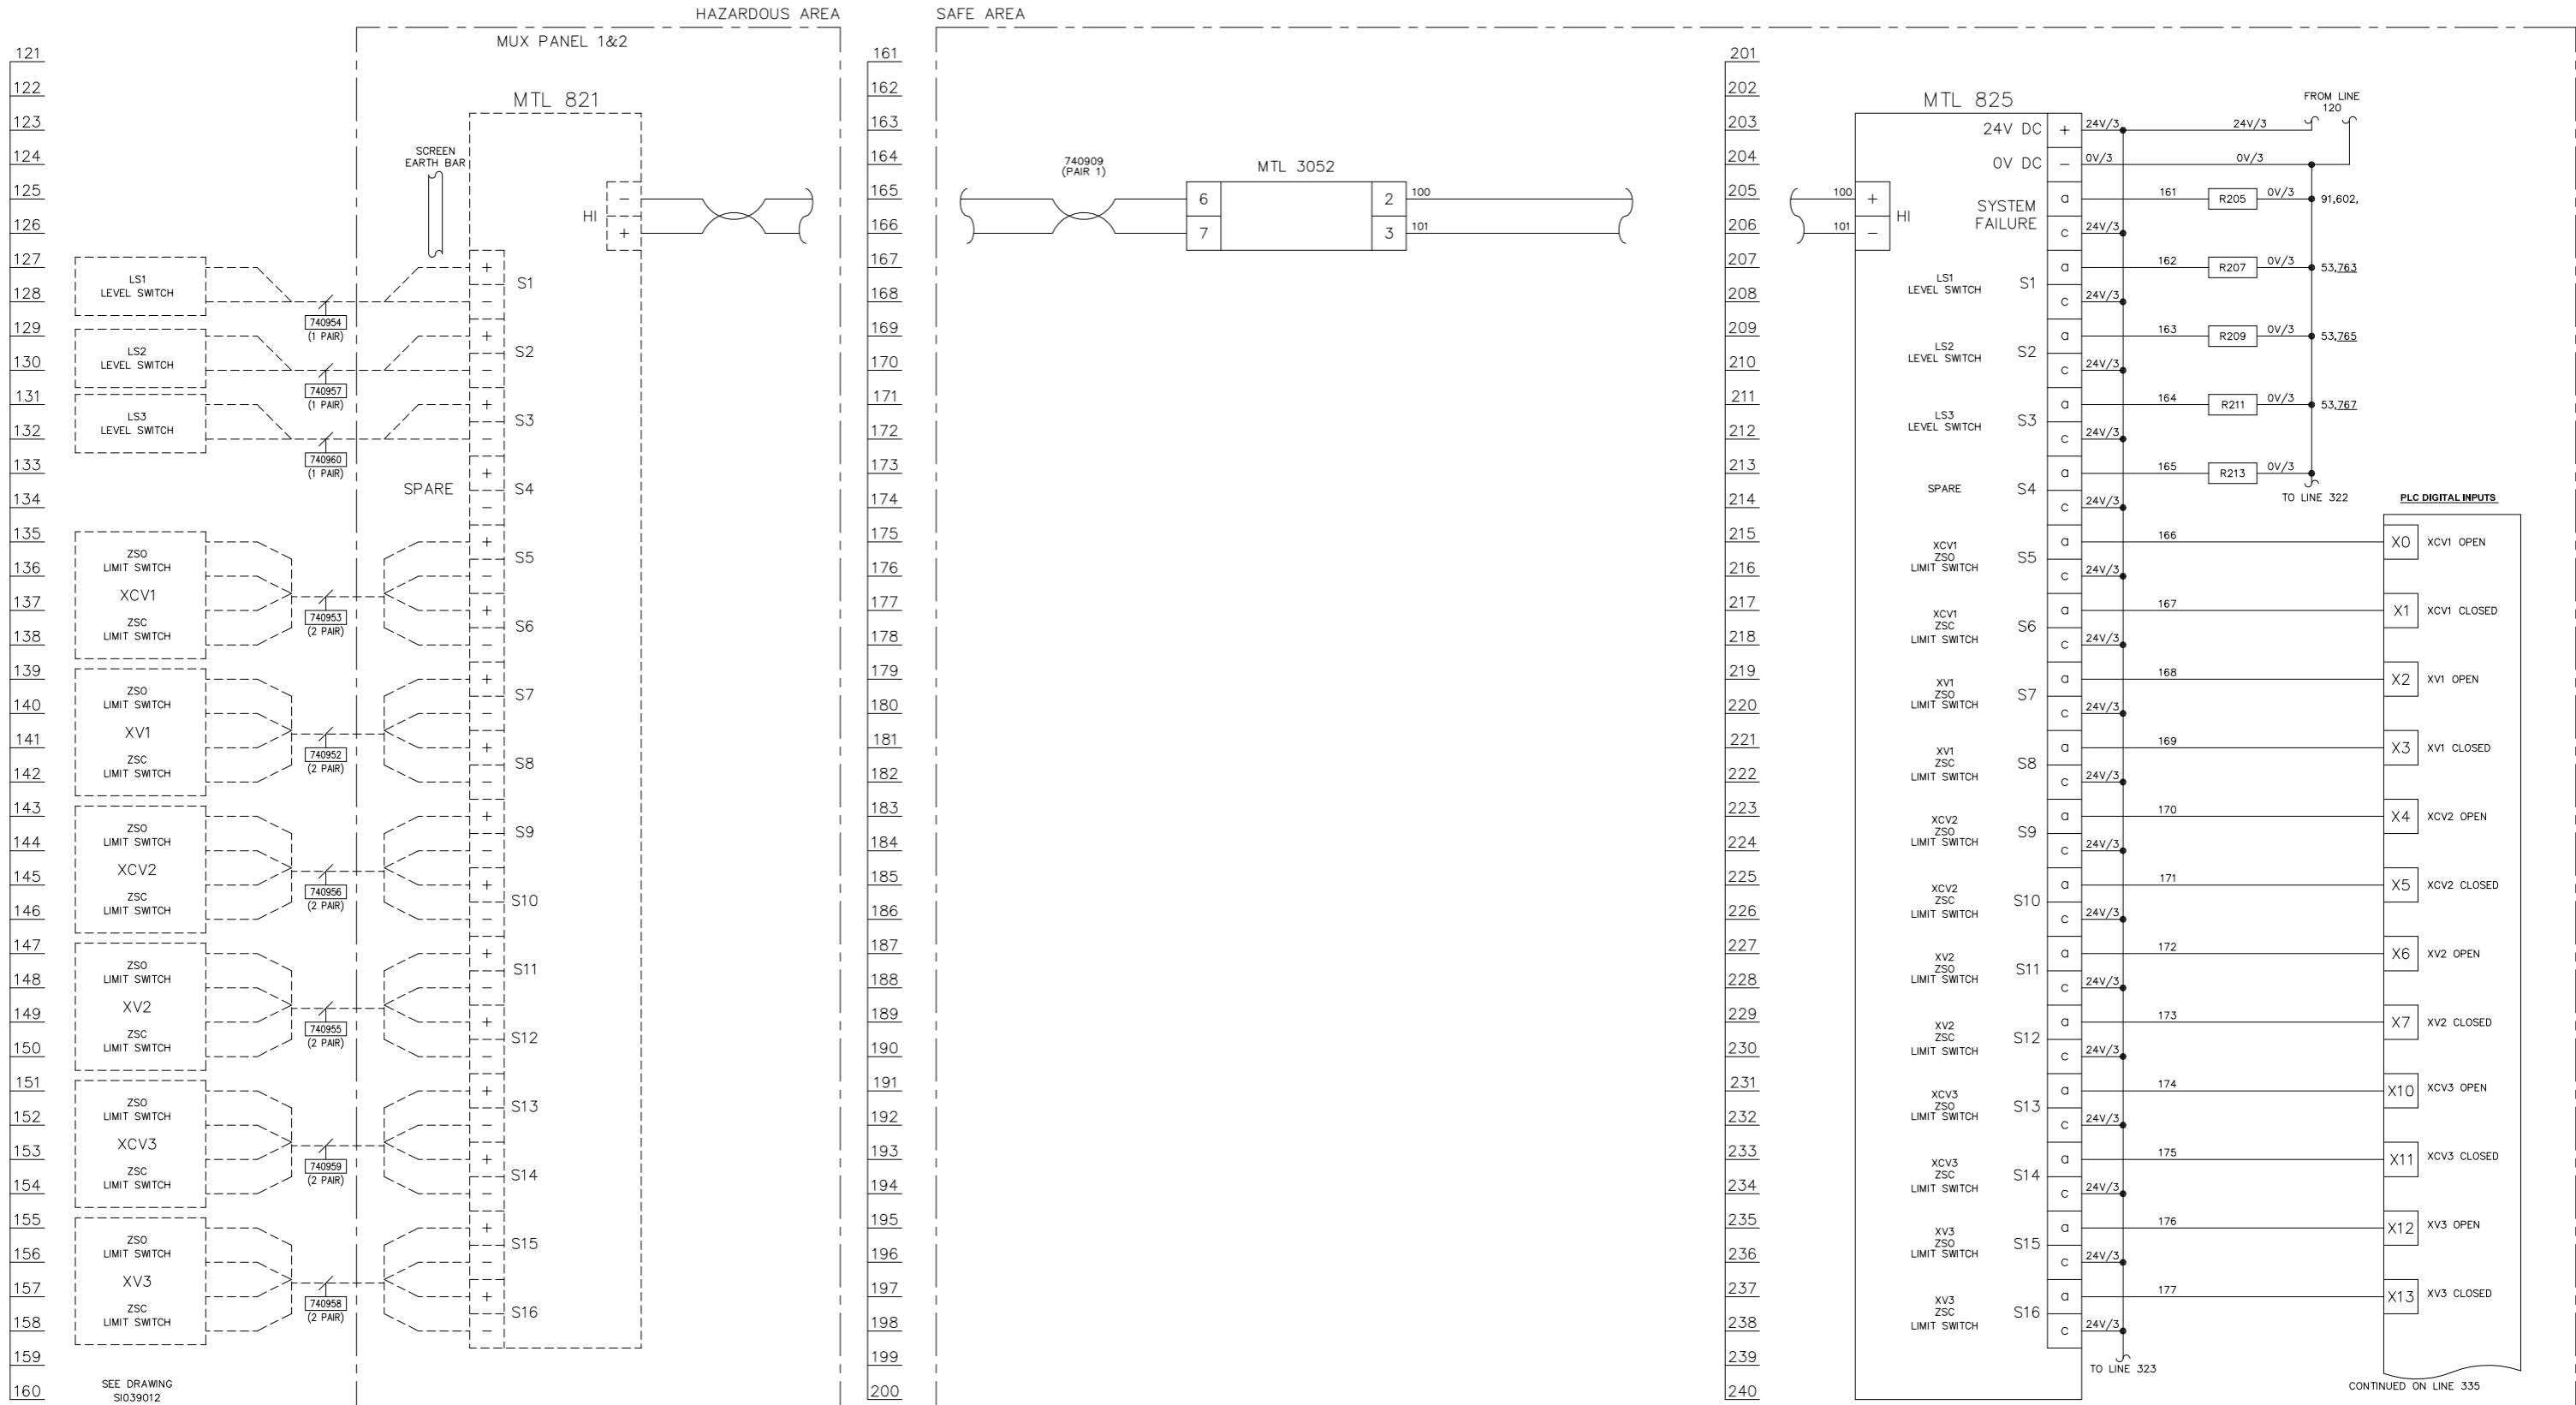

LAST NUMBER USED: 101  
SPARE TO: 160

LAST NUMBER USED: 177  
SPARE TO: 199

**NOTES**  
1. SCREEN EARTHS NOT SHOWN FOR CLARITY.

REV	DATE	BY	DRN	CHK'D	APP'D	DESCRIPTION	PLANT	FINA DERV RAIL LOADING SYSTEM
A	04/03/99	A.J.H	A.J.H	P.J.P	P.J.P	ORIGINAL ISSUE	TITLE	LOGIC 2
B	02/07/99	A.J.H	A.J.H	D.R.R	D.R.R	COMMS POLARITY REVERSED		

02/07/99


**Simon Storage** TERMINALS IMMINGHAM STORAGE Co Ltd, IMMINGHAM EAST TERMINAL, IMMINGHAM DOCK, IMMINGHAM, SOUTH HUMBERSIDE

**P & I DESIGN**


ELECTRICAL SCHEMATIC TEMPLATE SHEET 01 OF 01

CLIENT DRG. No. P&I DRG No. SIO39003

LEGEND OF GRAPHICAL SYMBOLS (ALL CONTACTS SHOWN IN THE DE-ENERGISED STATE)

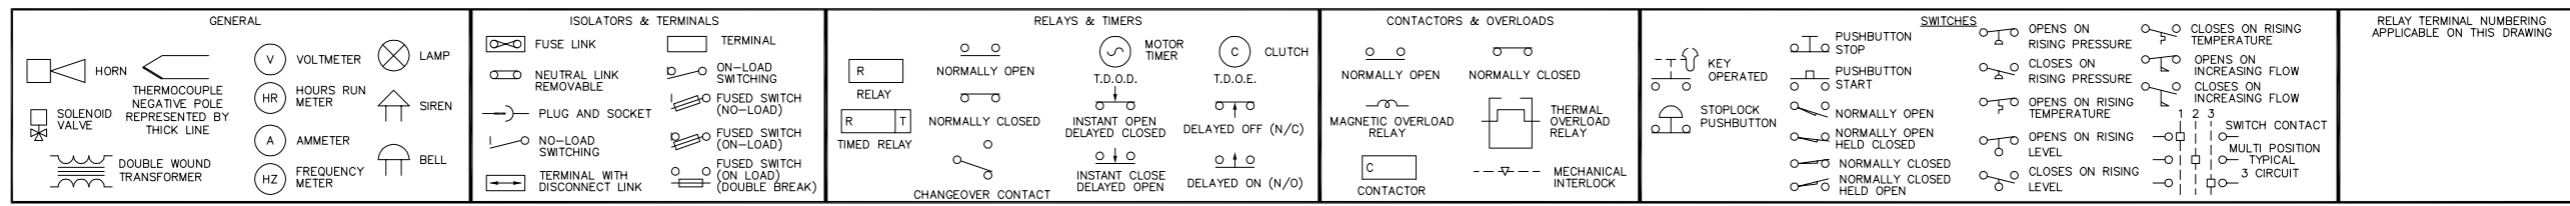

**MUX 2 (SOUTH SIDING)**

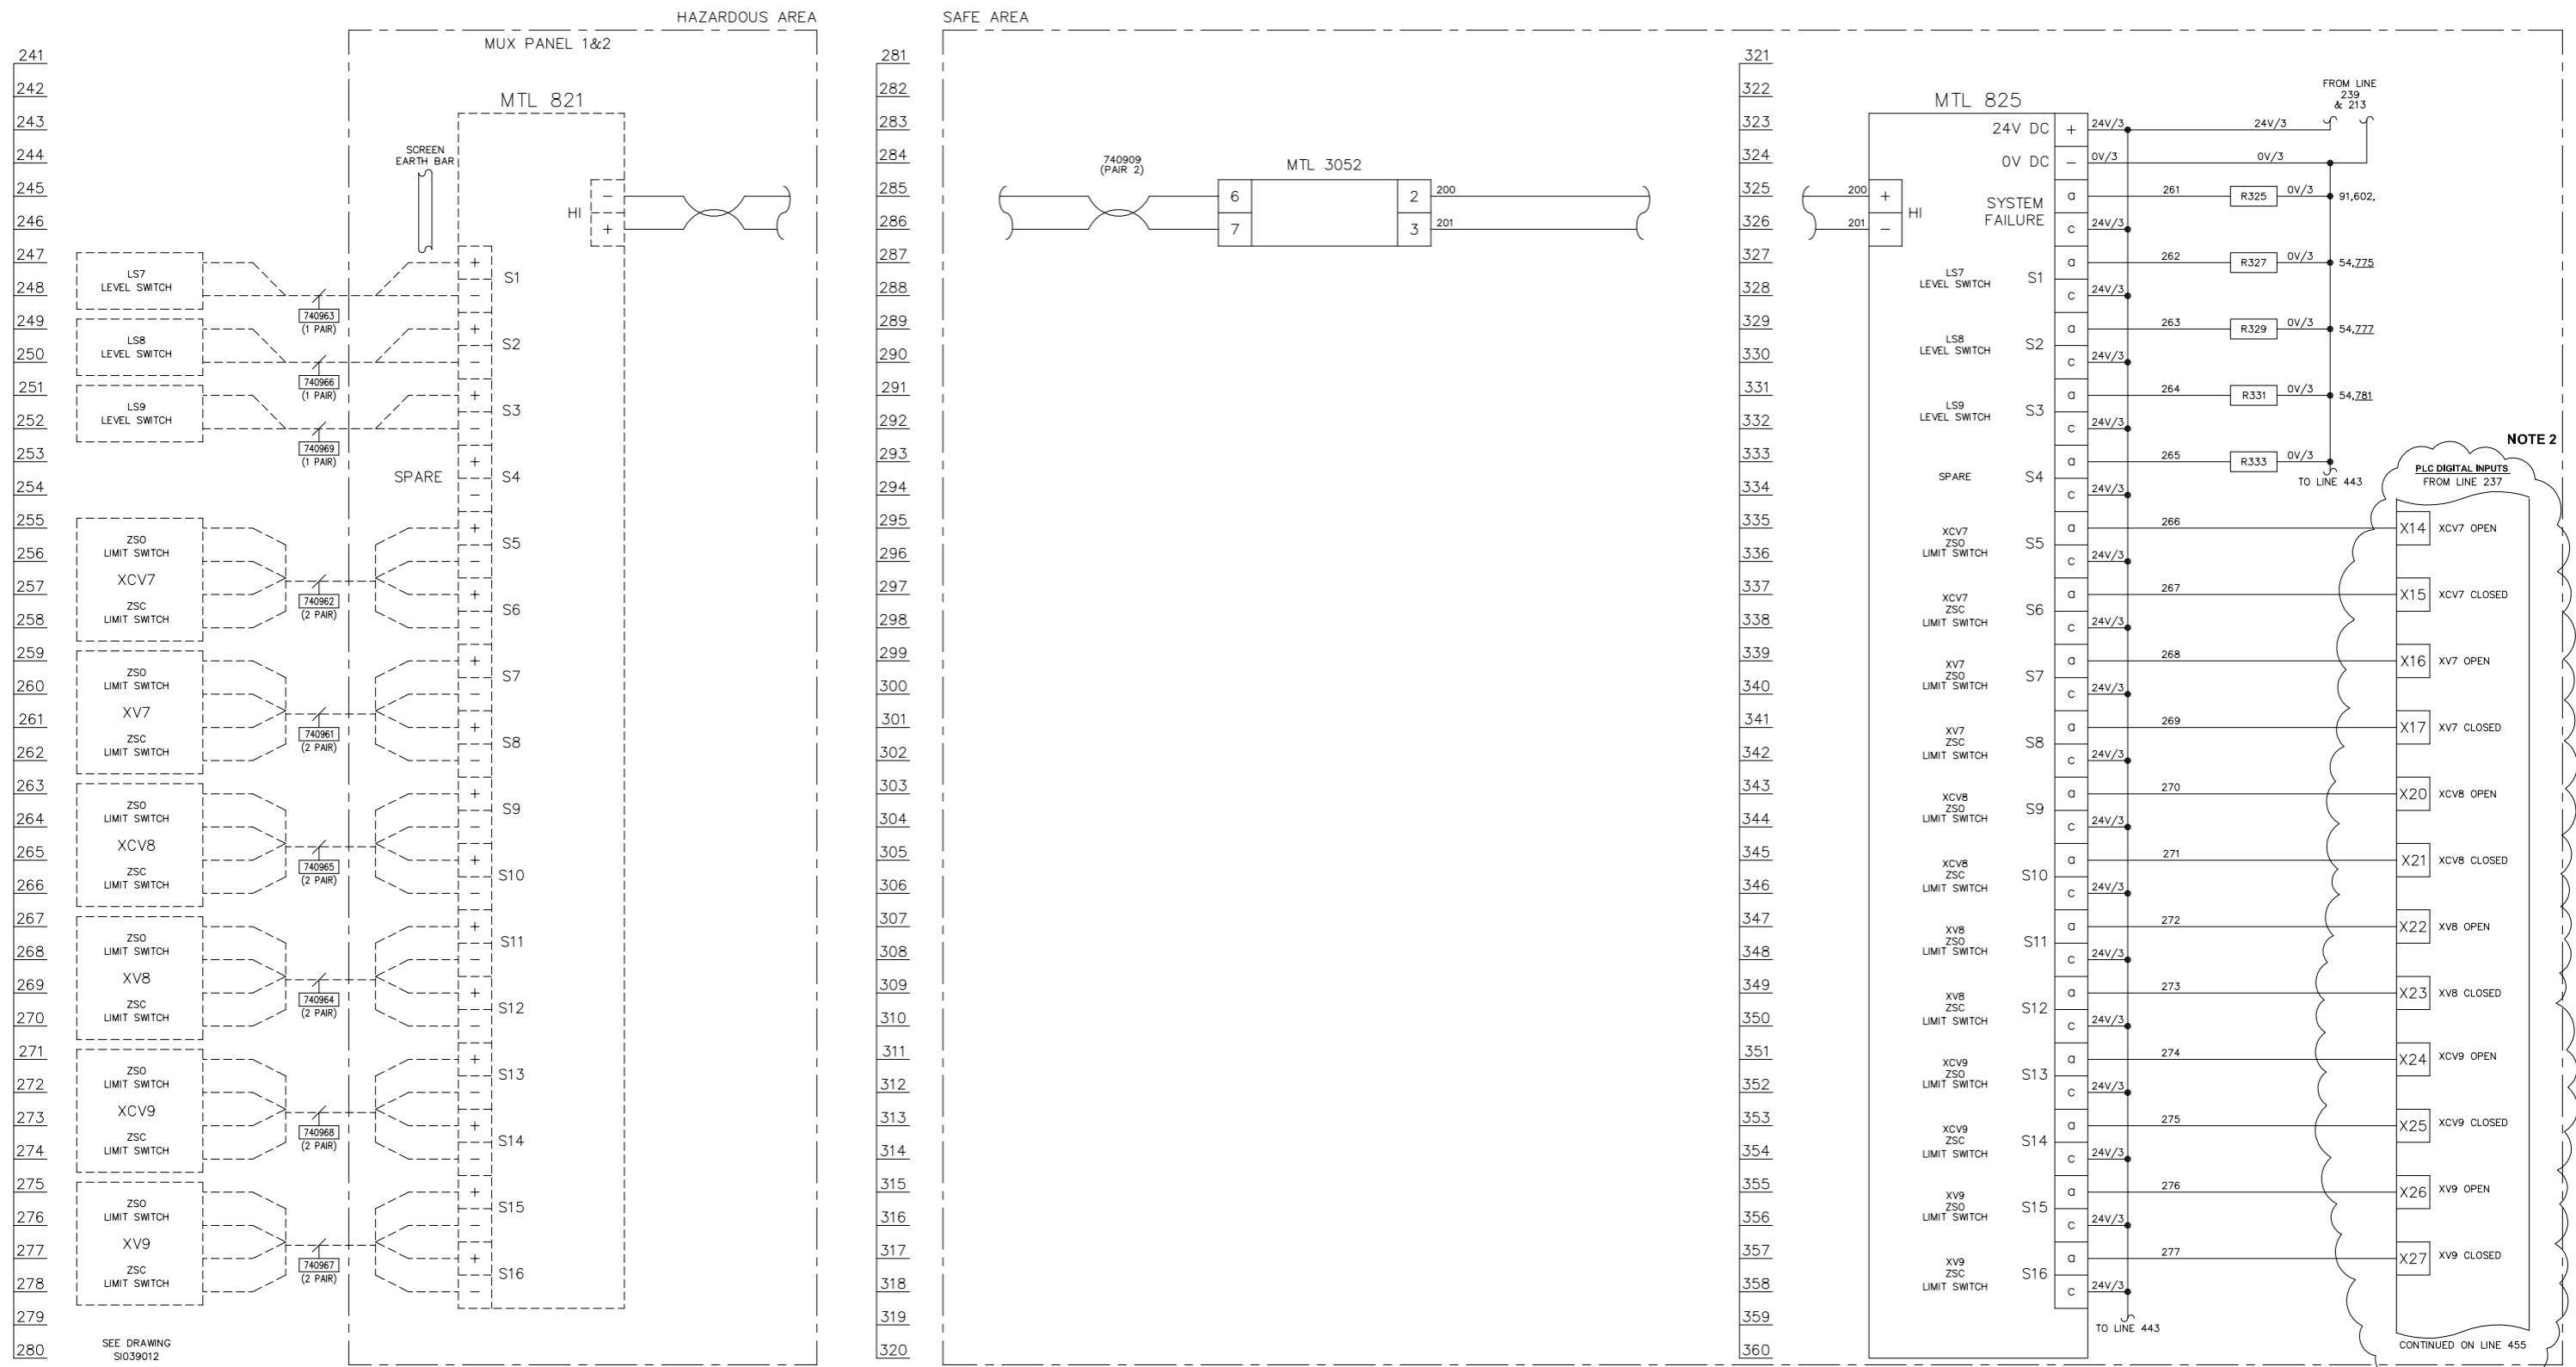

LAST NUMBER USED: 201  
 SPARE TO: 260

LAST NUMBER USED: 277  
 SPARE TO: 299

- NOTES**  
 1. SCREEN EARTHS NOT SHOWN FOR CLARITY.  
 2. DECOMMISSIONED BATCHING SYSTEM. INPUTS NOT USED IN PLC




IF NOT SIGNED THIS DOCUMENT IS UNCONTROLLED


REV	DATE	BY	DRN	CHK'D	APP'D	DESCRIPTION
A	04/03/99	A.J.H	A.J.H	P.J.P	P.J.P	D.R.R D.R.R ORIGINAL ISSUE
B	02/07/99	A.J.H	A.J.H	D.R.R	D.R.R	D.R.R D.R.R COMMS POLARITY REVERSED
C	14/09/10	D.B.F	P.P.	M.M.	M.M.	SI760 MODIFICATIONS

PLANT	IMMINGHAM STORAGE Co. - EAST TERMINAL
TITLE	4-EAST RAIL LOADING SYSTEM PANEL LOGIC DRAWING 3
CLIENT DRG. No.	IMMINGHAM STORAGE Co. Ltd. IMMINGHAM EAST TERMINAL, IMMINGHAM DOCK, IMMINGHAM, SOUTH HUMBERSIDE
	<b>P &amp; I DESIGN</b> P & I Design Ltd Tel. 01642 617444 www.ptdesign.co.uk
	SHEET 1 OF 1
	P&I DRG No. SI039004_DWG



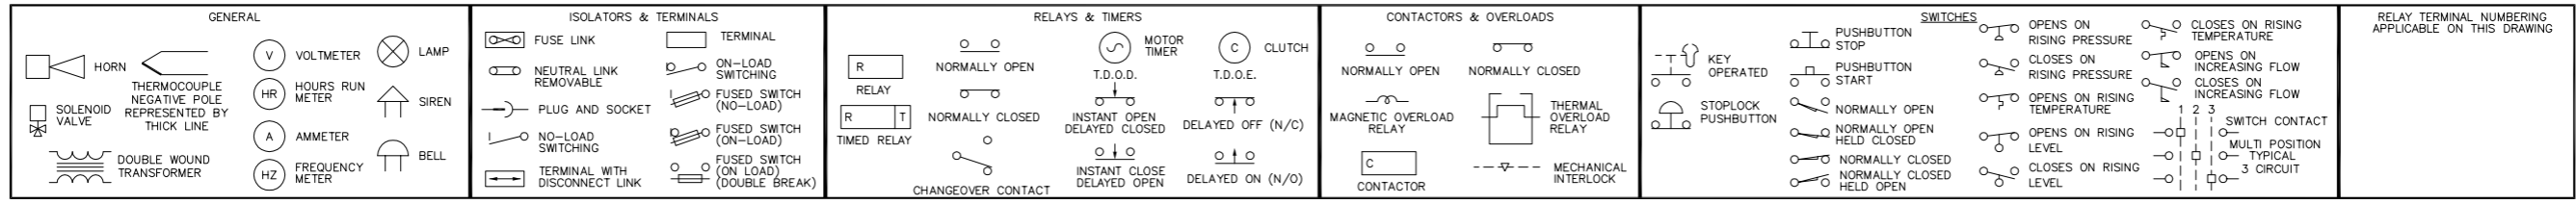

**MUX 2 (SOUTH SIDING)**

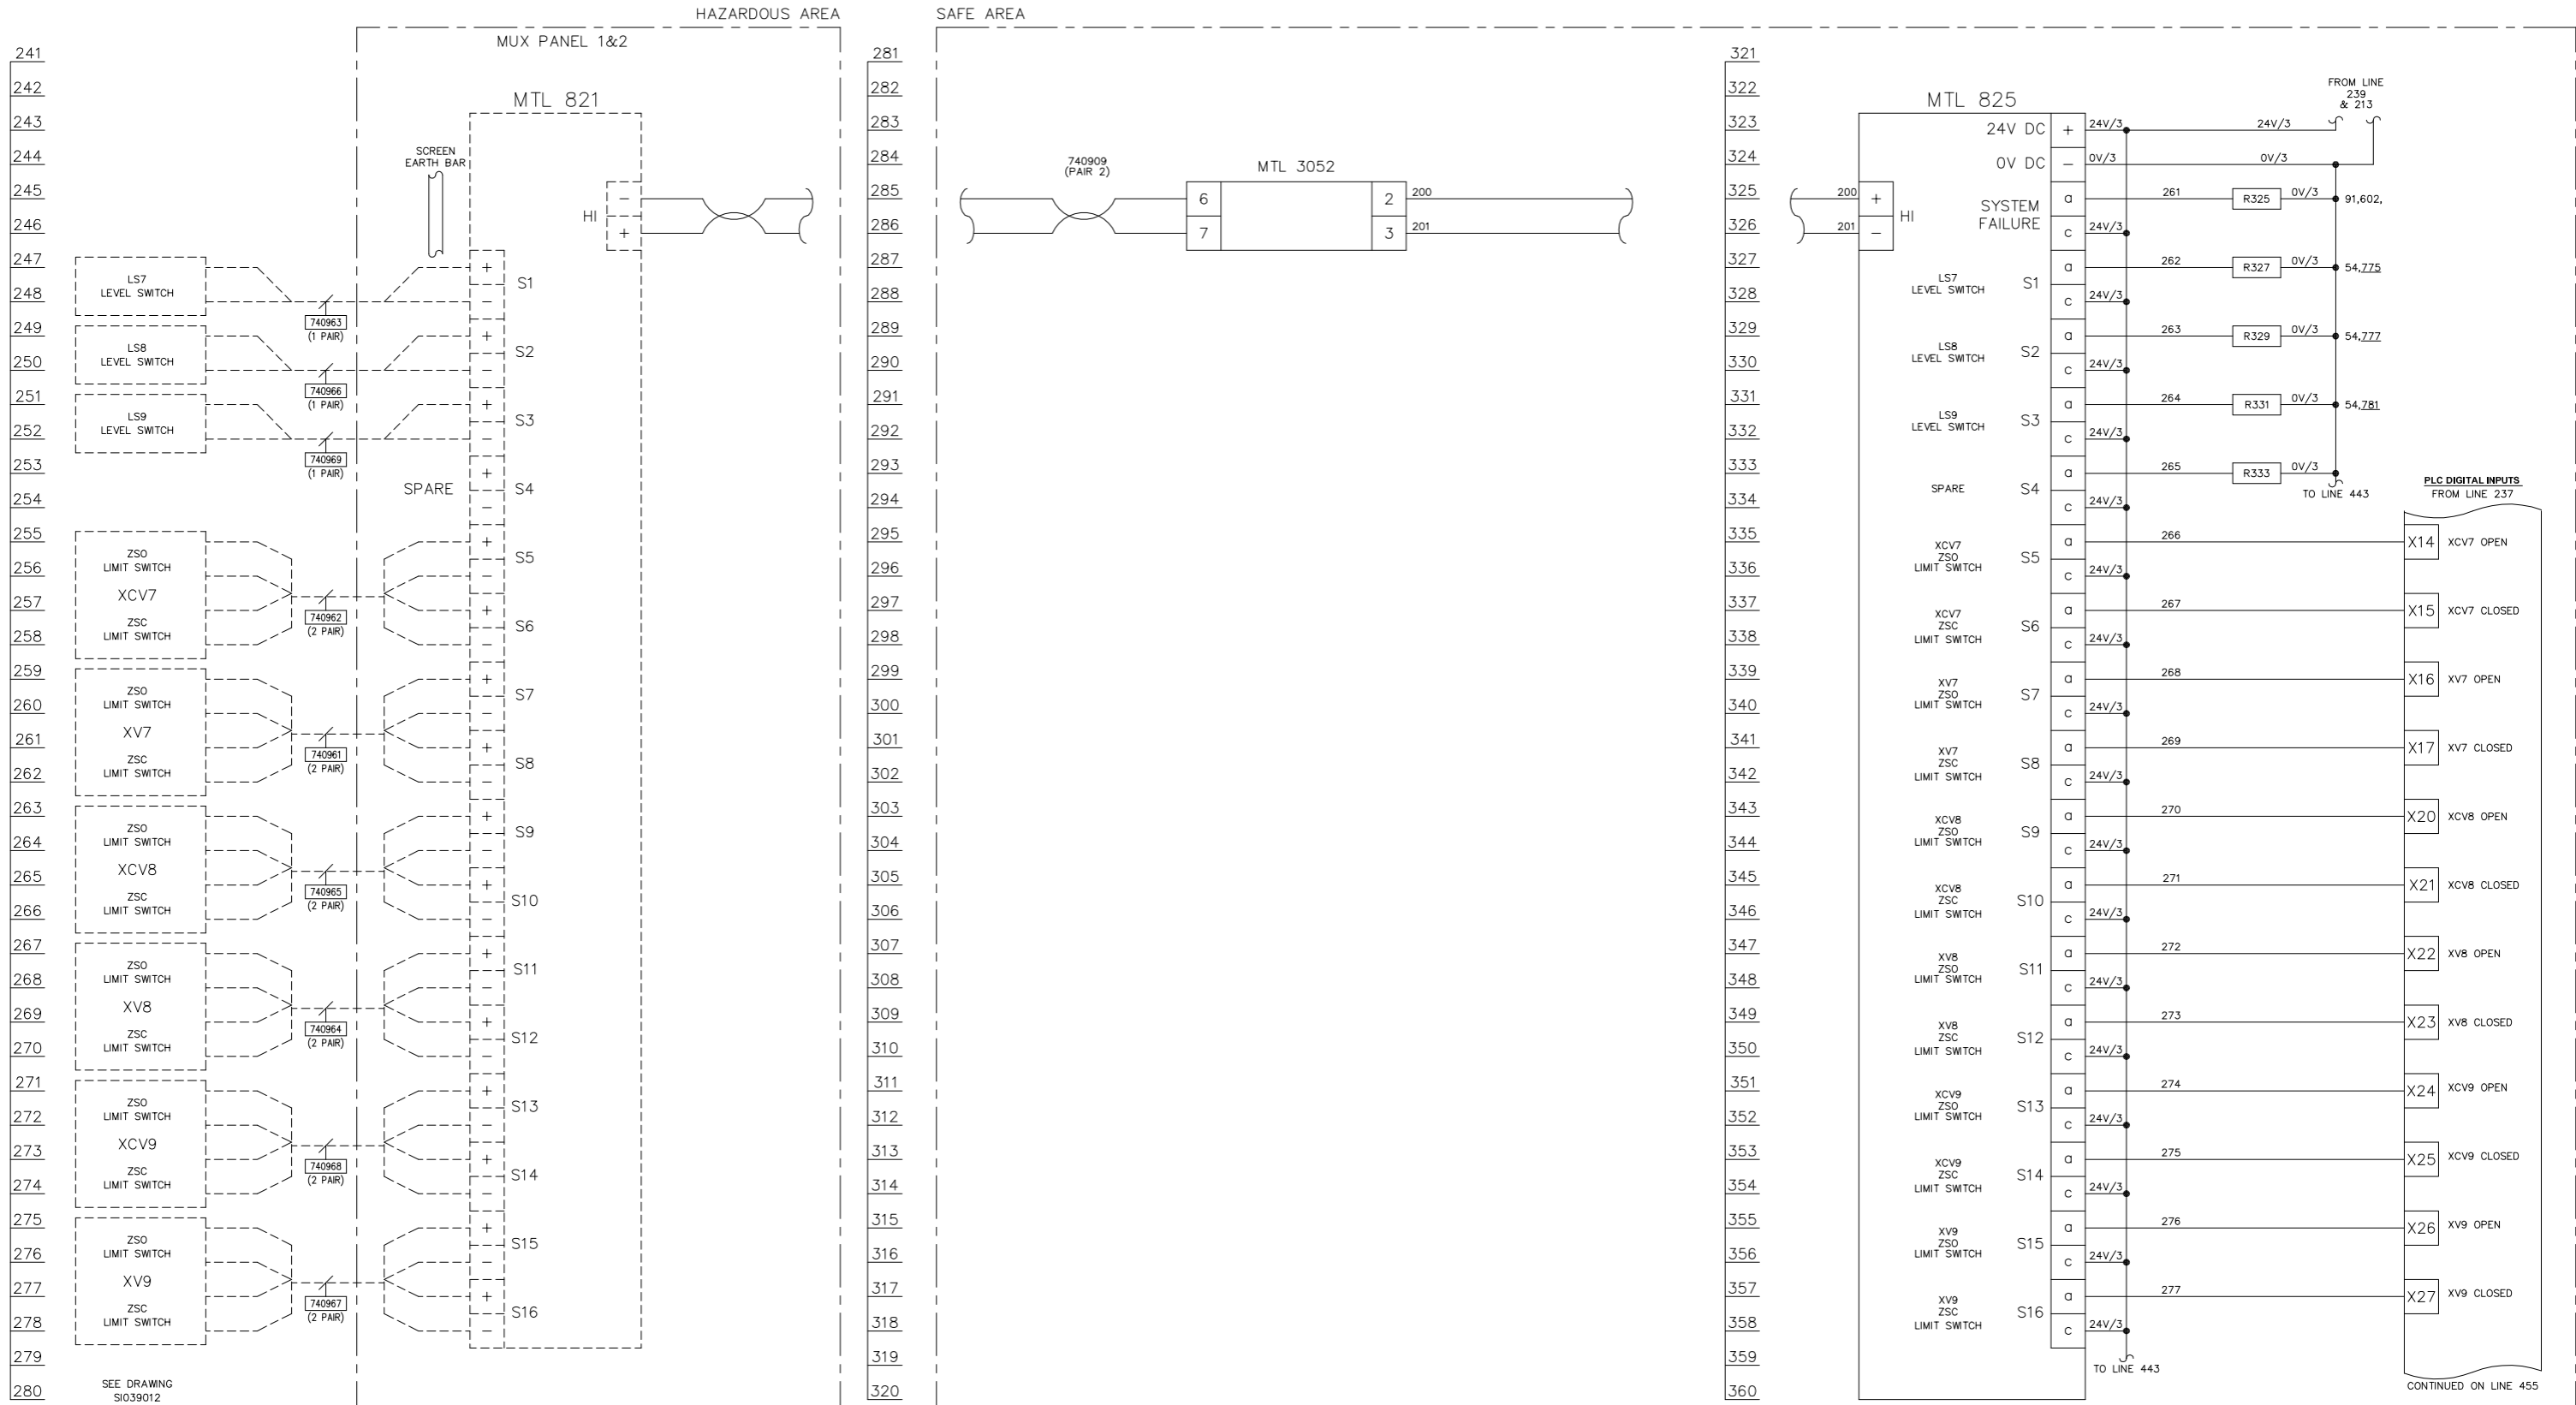

LAST NUMBER USED: 201  
 SPARE TO: 260

LAST NUMBER USED: 277  
 SPARE TO: 299

**NOTES**  
 1. SCREEN EARTHS NOT SHOWN FOR CLARITY.

REV	DATE	BY	DRN	CHK'D	APP'D	DESCRIPTION	PLANT	FINA DERV RAIL LOADING SYSTEM
A	04/03/99	A.J.H	A.J.H	P.J.P	P.J.P	ORIGINAL ISSUE	TITLE	LOGIC 3
B	02/07/99	A.J.H	A.J.H	D.R.R	D.R.R	COMMS POLARITY REVERSED		

02/07/99


**Simon Storage Terminals** IMMINGHAM STORAGE Co Ltd, IMMINGHAM EAST TERMINAL, IMMINGHAM DOCK, IMMINGHAM, SOUTH HUMBERSIDE

**P & I DESIGN**


ELECTRICAL SCHEMATIC TEMPLATE SHEET 01 OF 01

CLIENT DRG. No. P&I DRG No. SI039004

LEGEND OF GRAPHICAL SYMBOLS (ALL CONTACTS SHOWN IN THE DE-ENERGISED STATE)

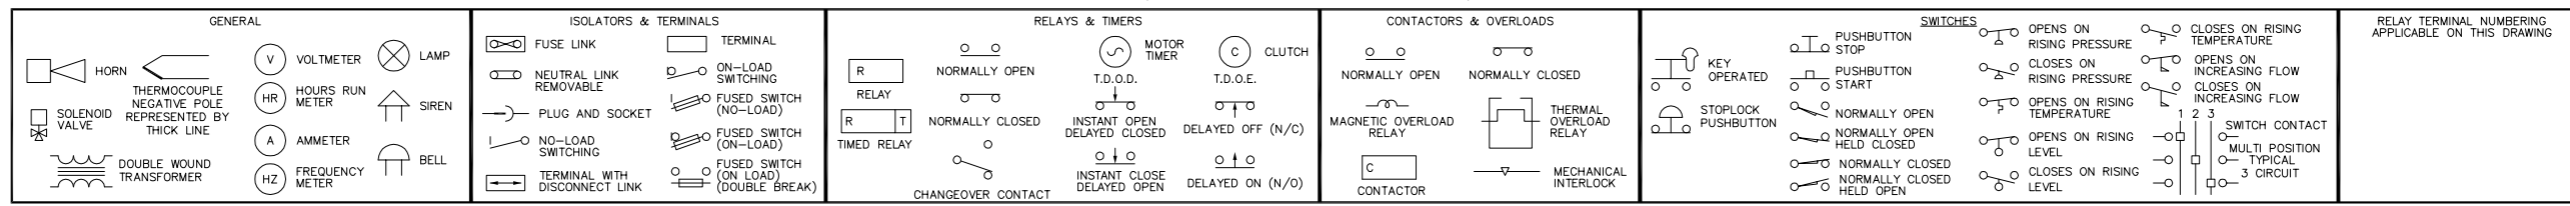

**MUX 3 (NORTH SIDING)**

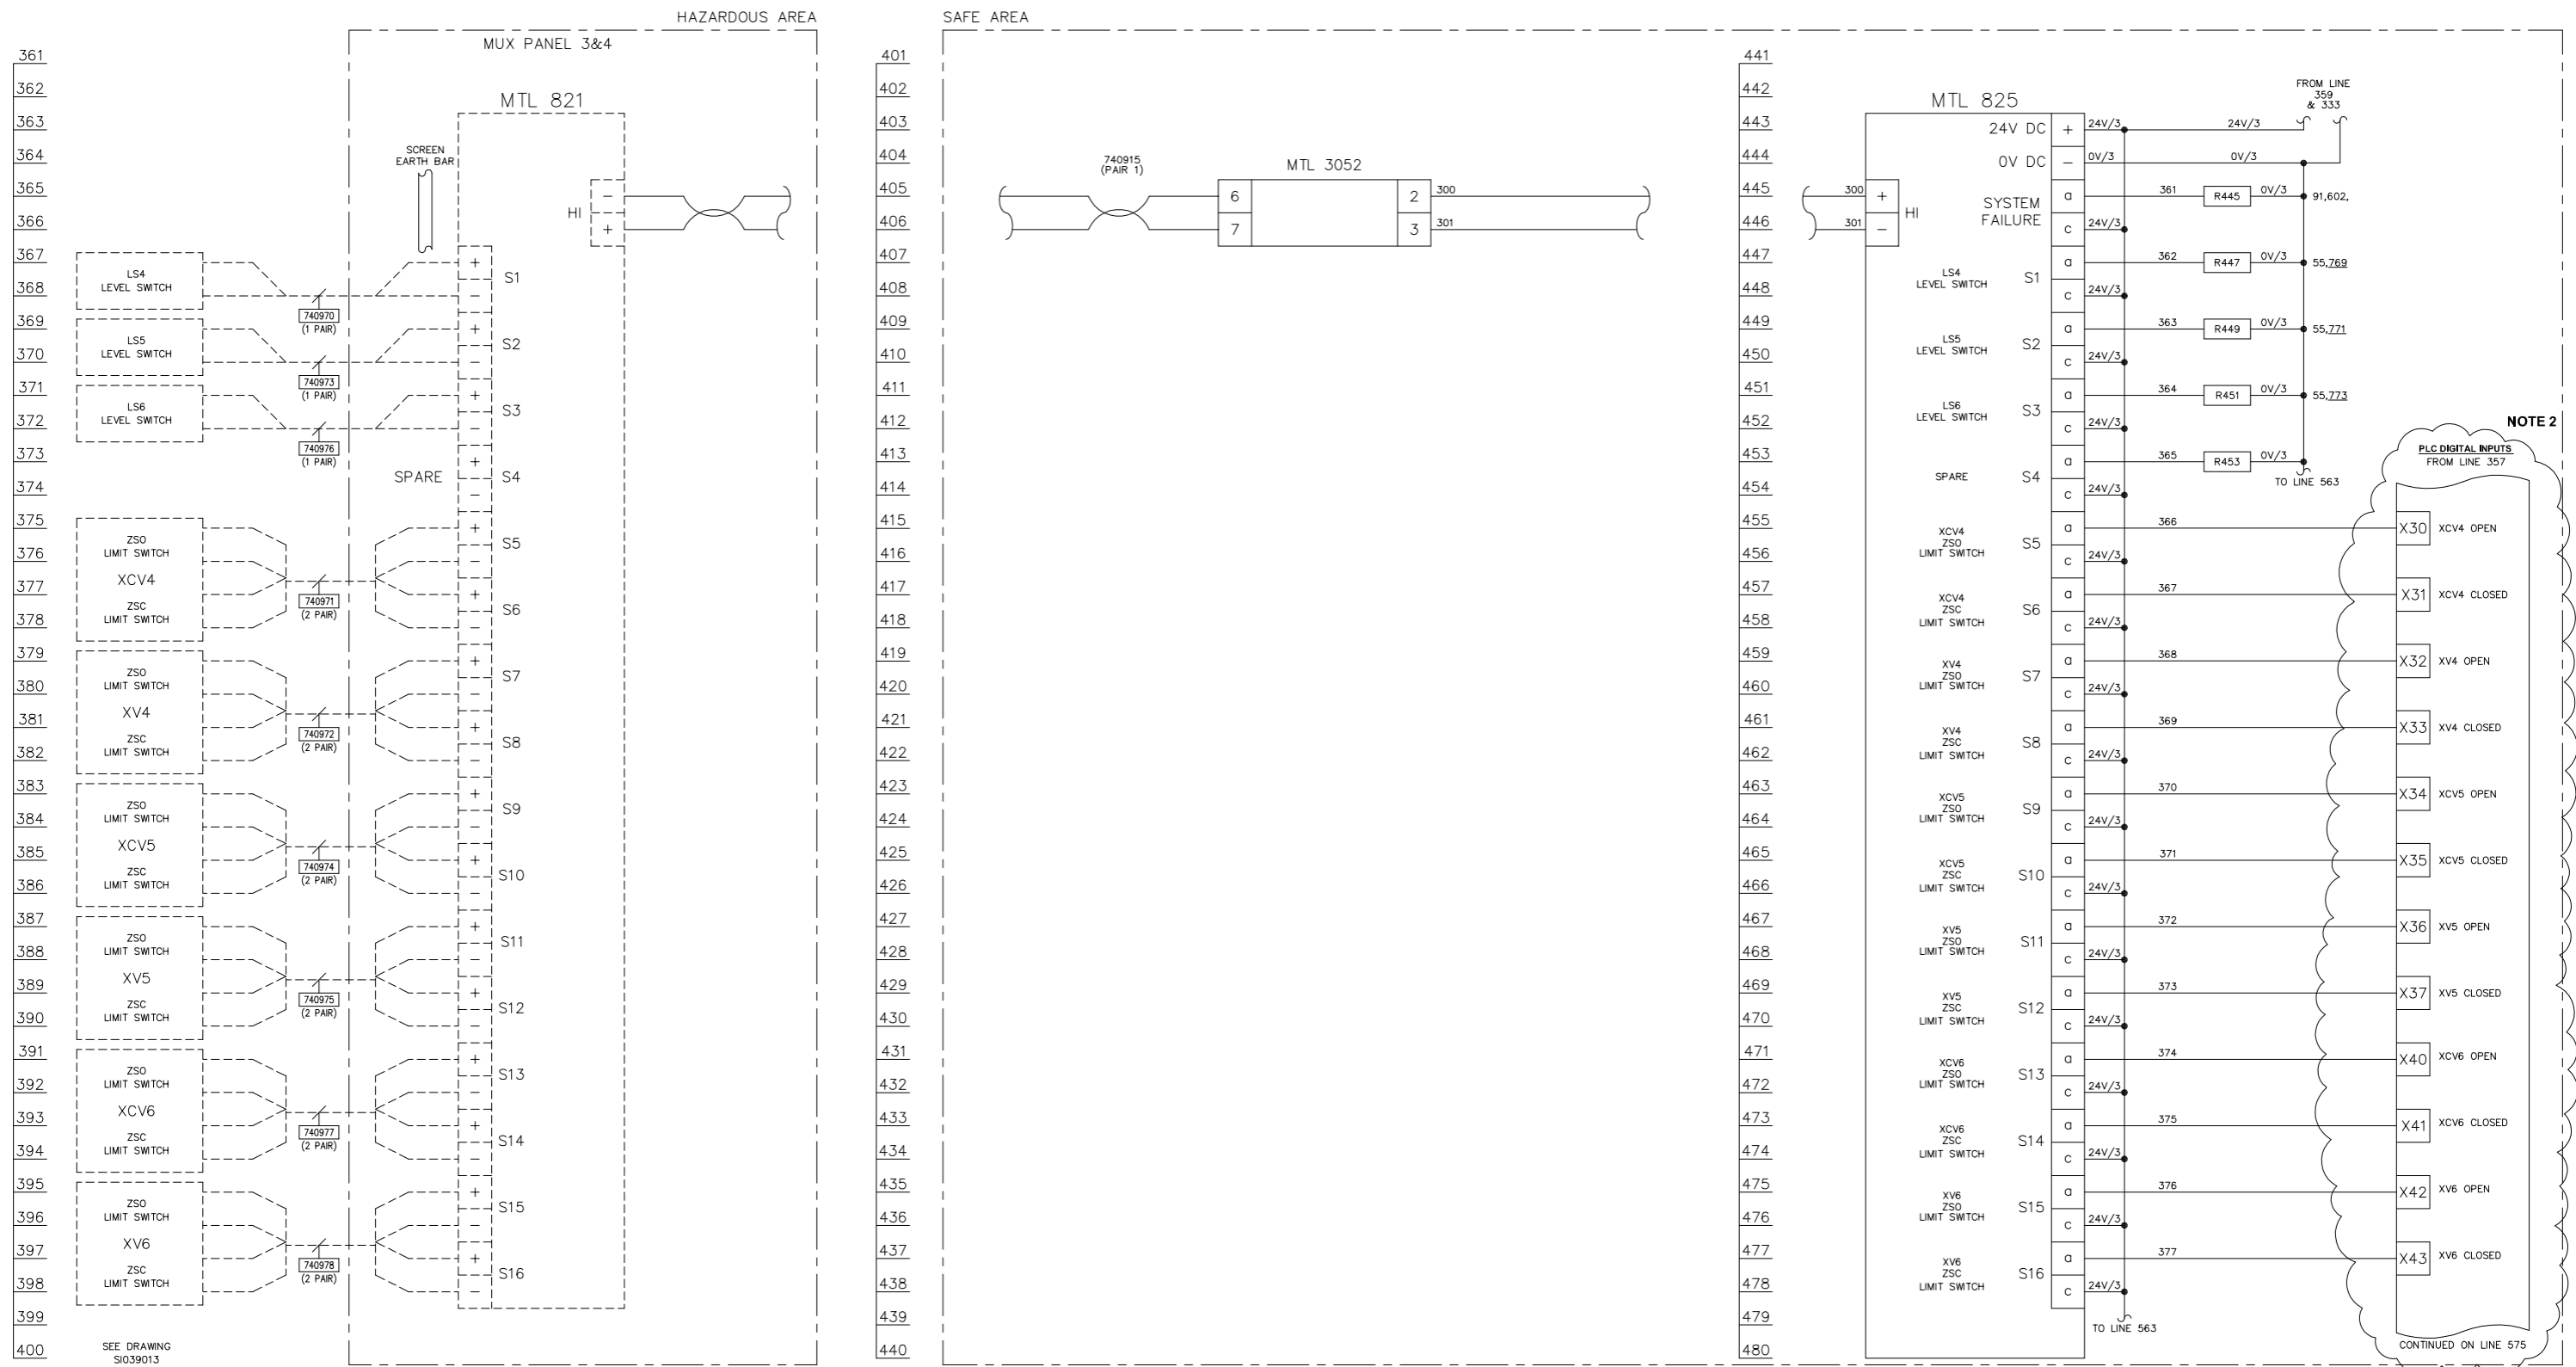


**NOTES**

- SCREEN EARTHS NOT SHOWN FOR CLARITY.
- DECOMMISSIONED BATCHING SYSTEM. INPUTS NOT USED IN PLC




IF NOT SIGNED THIS DOCUMENT IS UNCONTROLLED						
REV	DATE	BY	DRN	CHK'D	APP'D	DESCRIPTION
A	04/03/99	A.J.H.	A.J.H.	P.J.P.	P.J.P.	D.R.R. D.R.R. ORIGINAL ISSUE
B	07/07/99	D.P.	A.J.H.	D.R.R.	D.R.R.	COMMS POLARITY REVERSED
C	14/09/10	D.B.F.	P.P.	M.M.	M.M.	SI760 MODIFICATIONS

PLANT	IMMINGHAM STORAGE Co. - EAST TERMINAL
TITLE	4-EAST RAIL LOADING SYSTEM PANEL LOGIC DRAWING 4
CLIENT DRG. No.	IMMINGHAM STORAGE Co. Ltd. IMMINGHAM EAST TERMINAL, IMMINGHAM DOCK, IMMINGHAM, SOUTH HUMBERSIDE
	<b>P &amp; I DESIGN</b> P & I Design Ltd Tel. 01642 617444 www.ptdesign.co.uk
	SHEET 1 OF 1
	P&I DRG No. SI039005_DWG

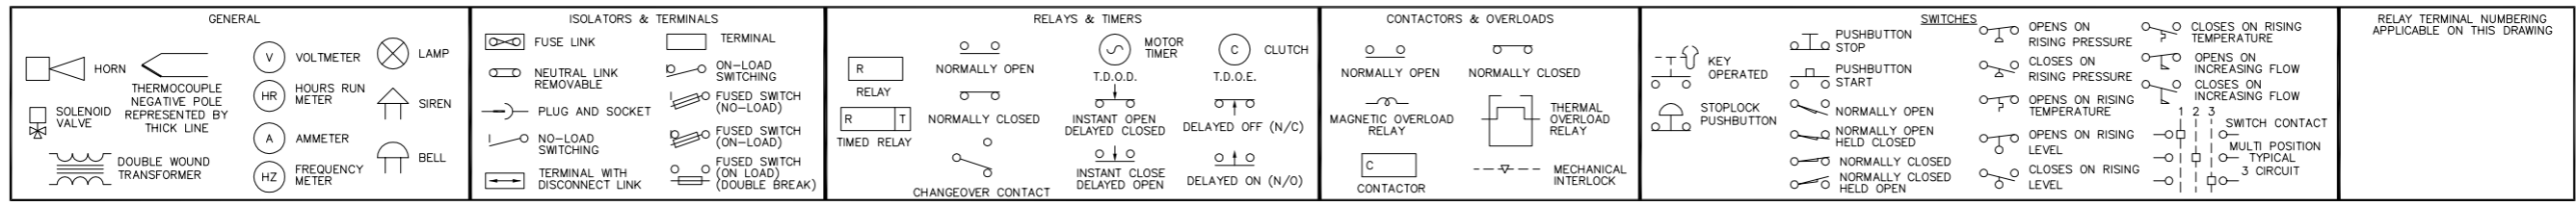

**MUX 3 (NORTH SIDING)**

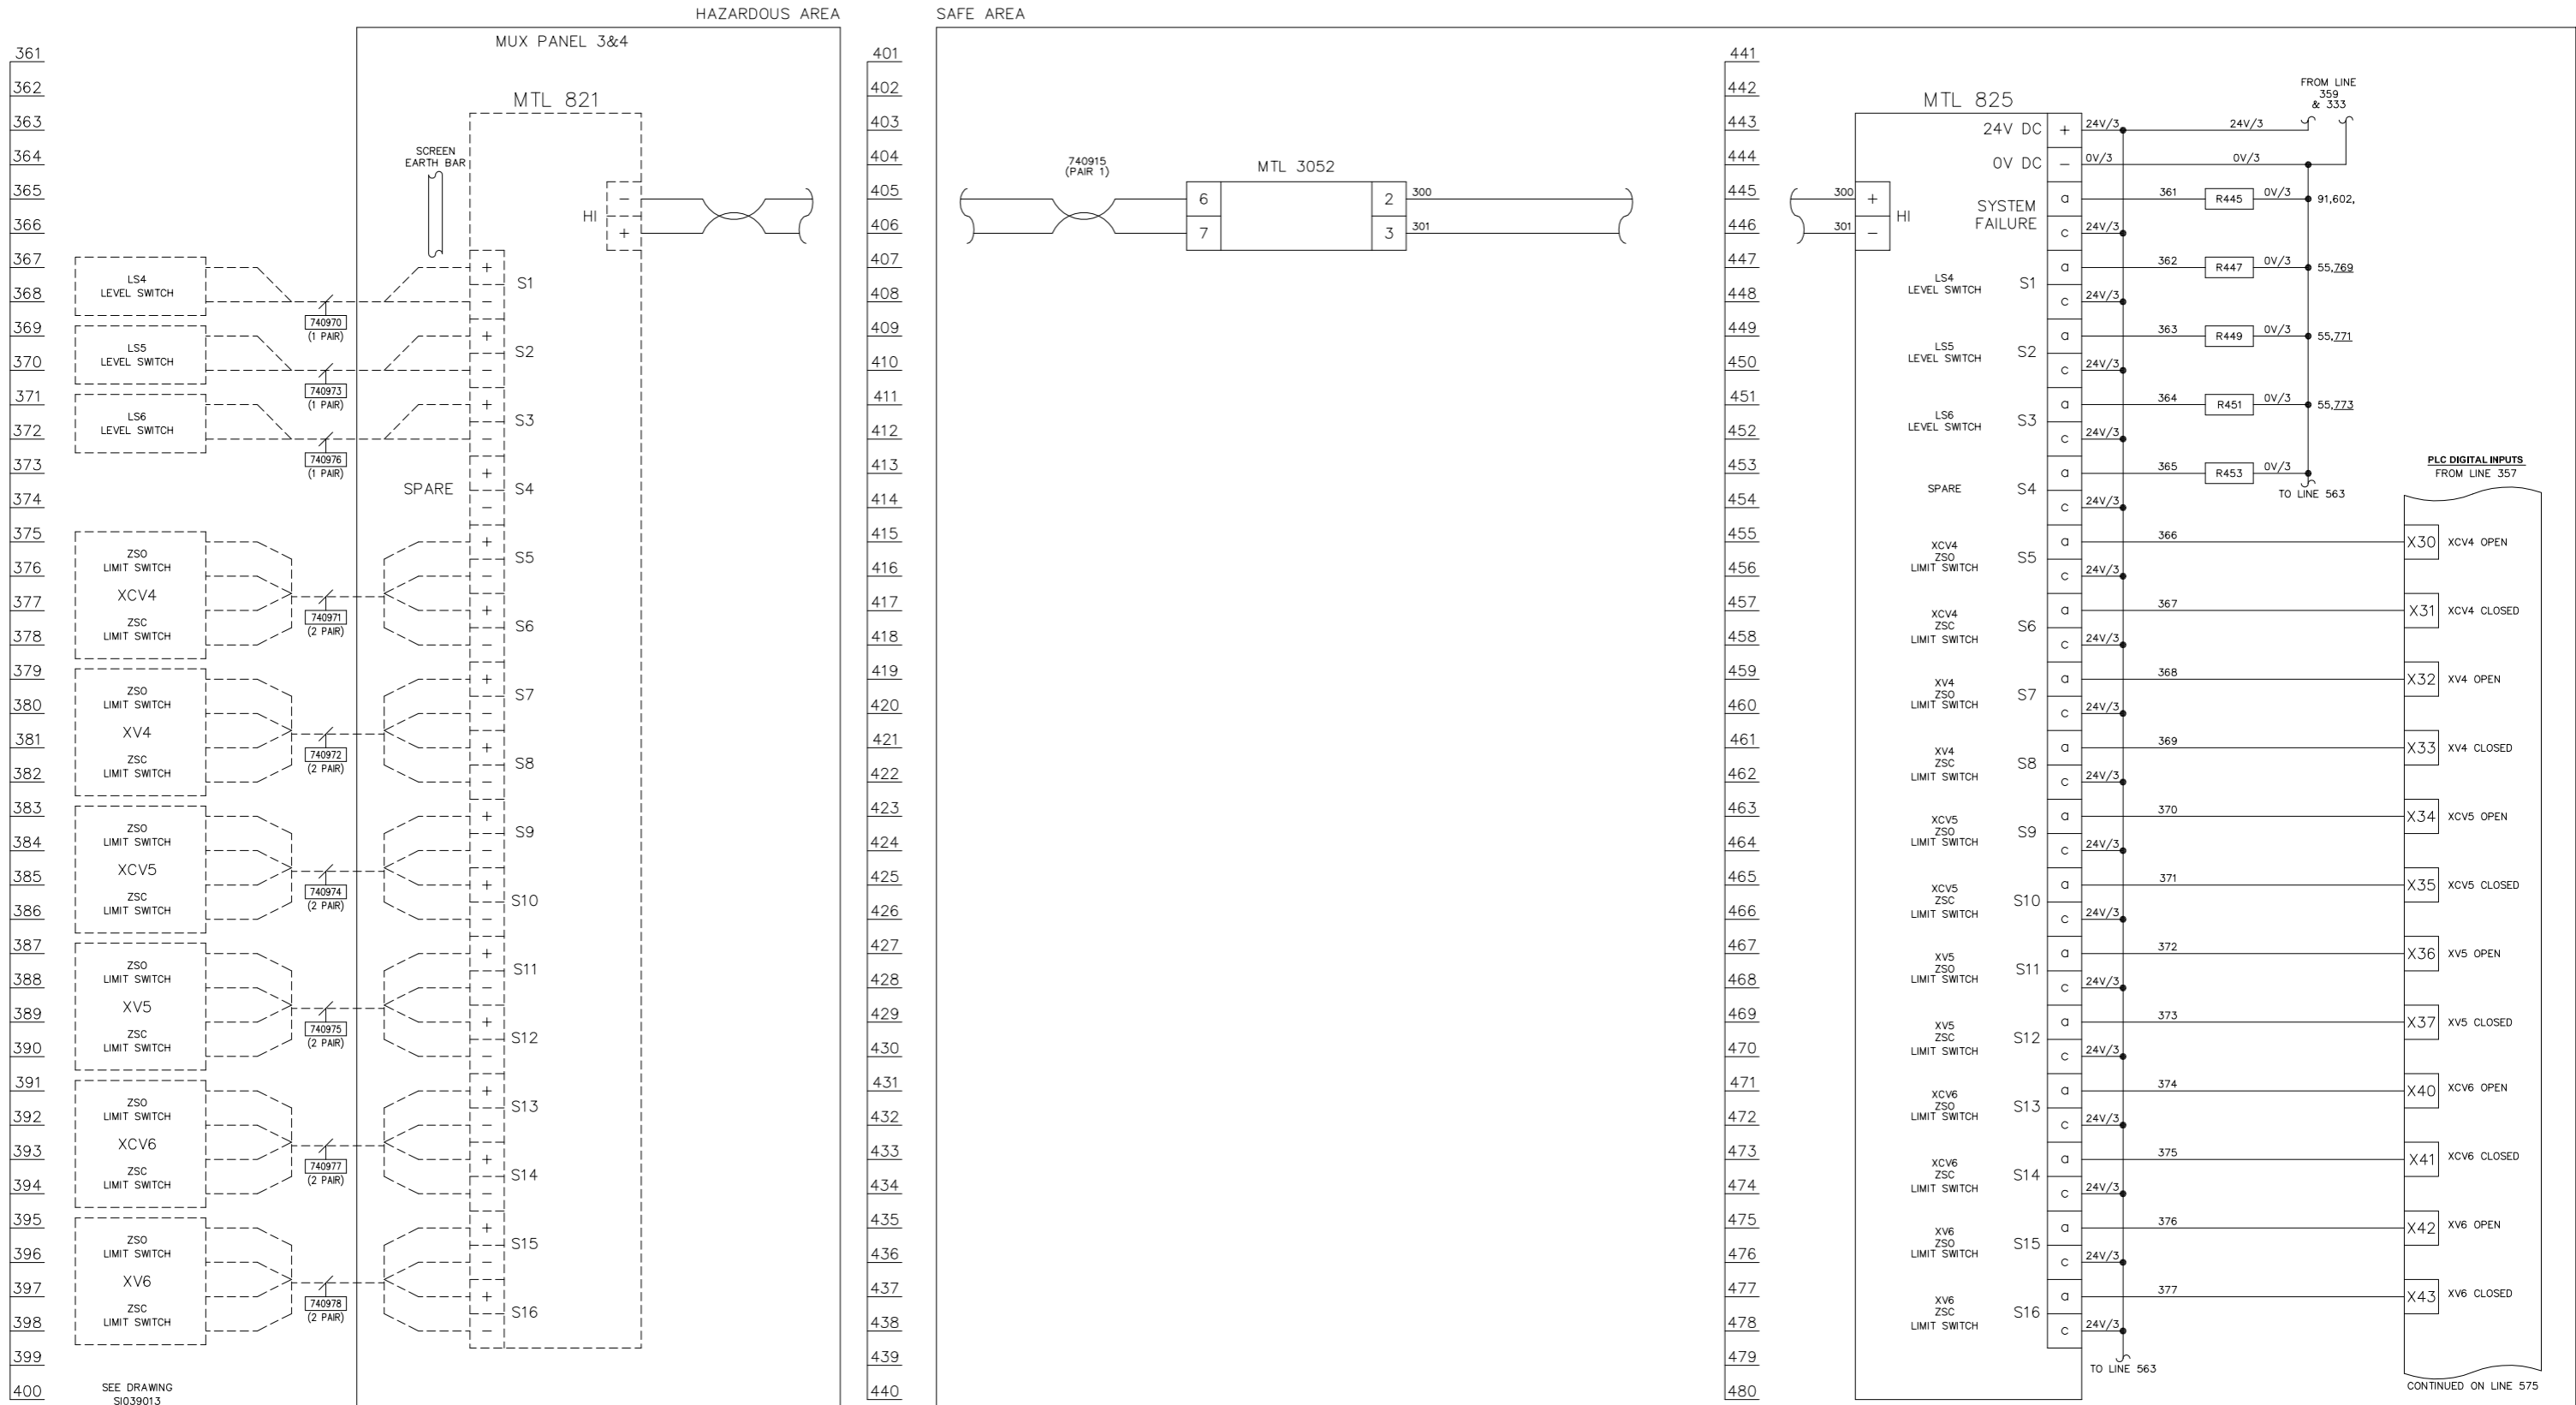


LAST NUMBER USED: 301  
 SPARE TO: 360

LAST NUMBER USED: 377  
 SPARE TO: 399


REV	DATE	BY	DRN	CHK'D	APP'D	DESCRIPTION	PLANT	FINA DERV RAIL LOADING SYSTEM
A	04/03/99	A.J.H.	A.J.H.	P.J.P.	P.J.P.	ORIGINAL ISSUE	TITLE	LOGIC 4
B	02/07/99	D.P.	A.J.H.	D.R.R.	D.R.R.	COMMS POLARITY REVERSED		02/07/99

**Simon Storage** IMMINGHAM STORAGE Co Ltd, IMMINGHAM EAST TERMINAL, IMMINGHAM DOCK, IMMINGHAM, SOUTH HUMBERSIDE  
**P & I DESIGN**  
 ELECTRICAL SCHEMATIC TEMPLATE SHEET 01 OF 01  
 CLIENT DRG. No. P&I DRG No. SI039005

LEGEND OF GRAPHICAL SYMBOLS (ALL CONTACTS SHOWN IN THE DE-ENERGISED STATE)

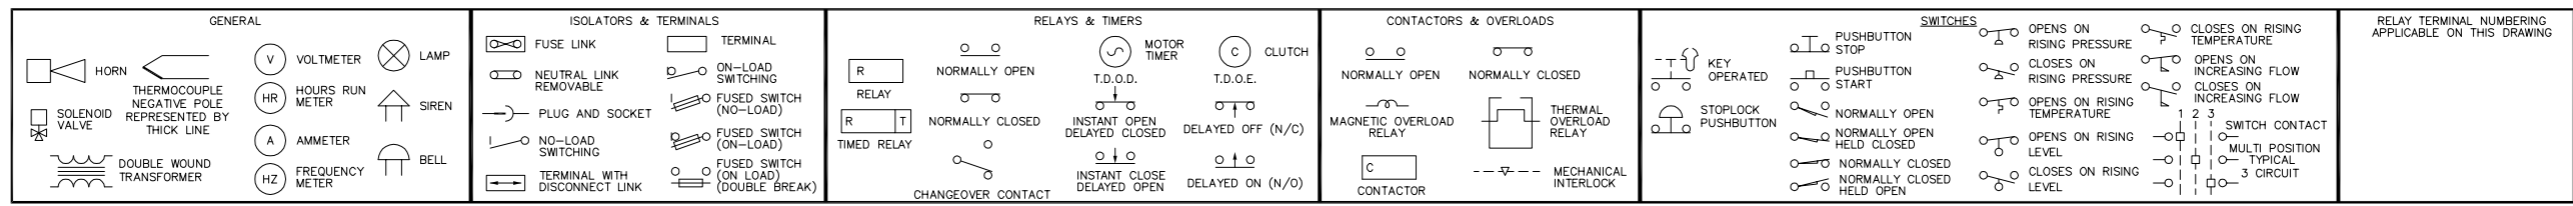

**MUX 4 (SOUTH SIDING)**

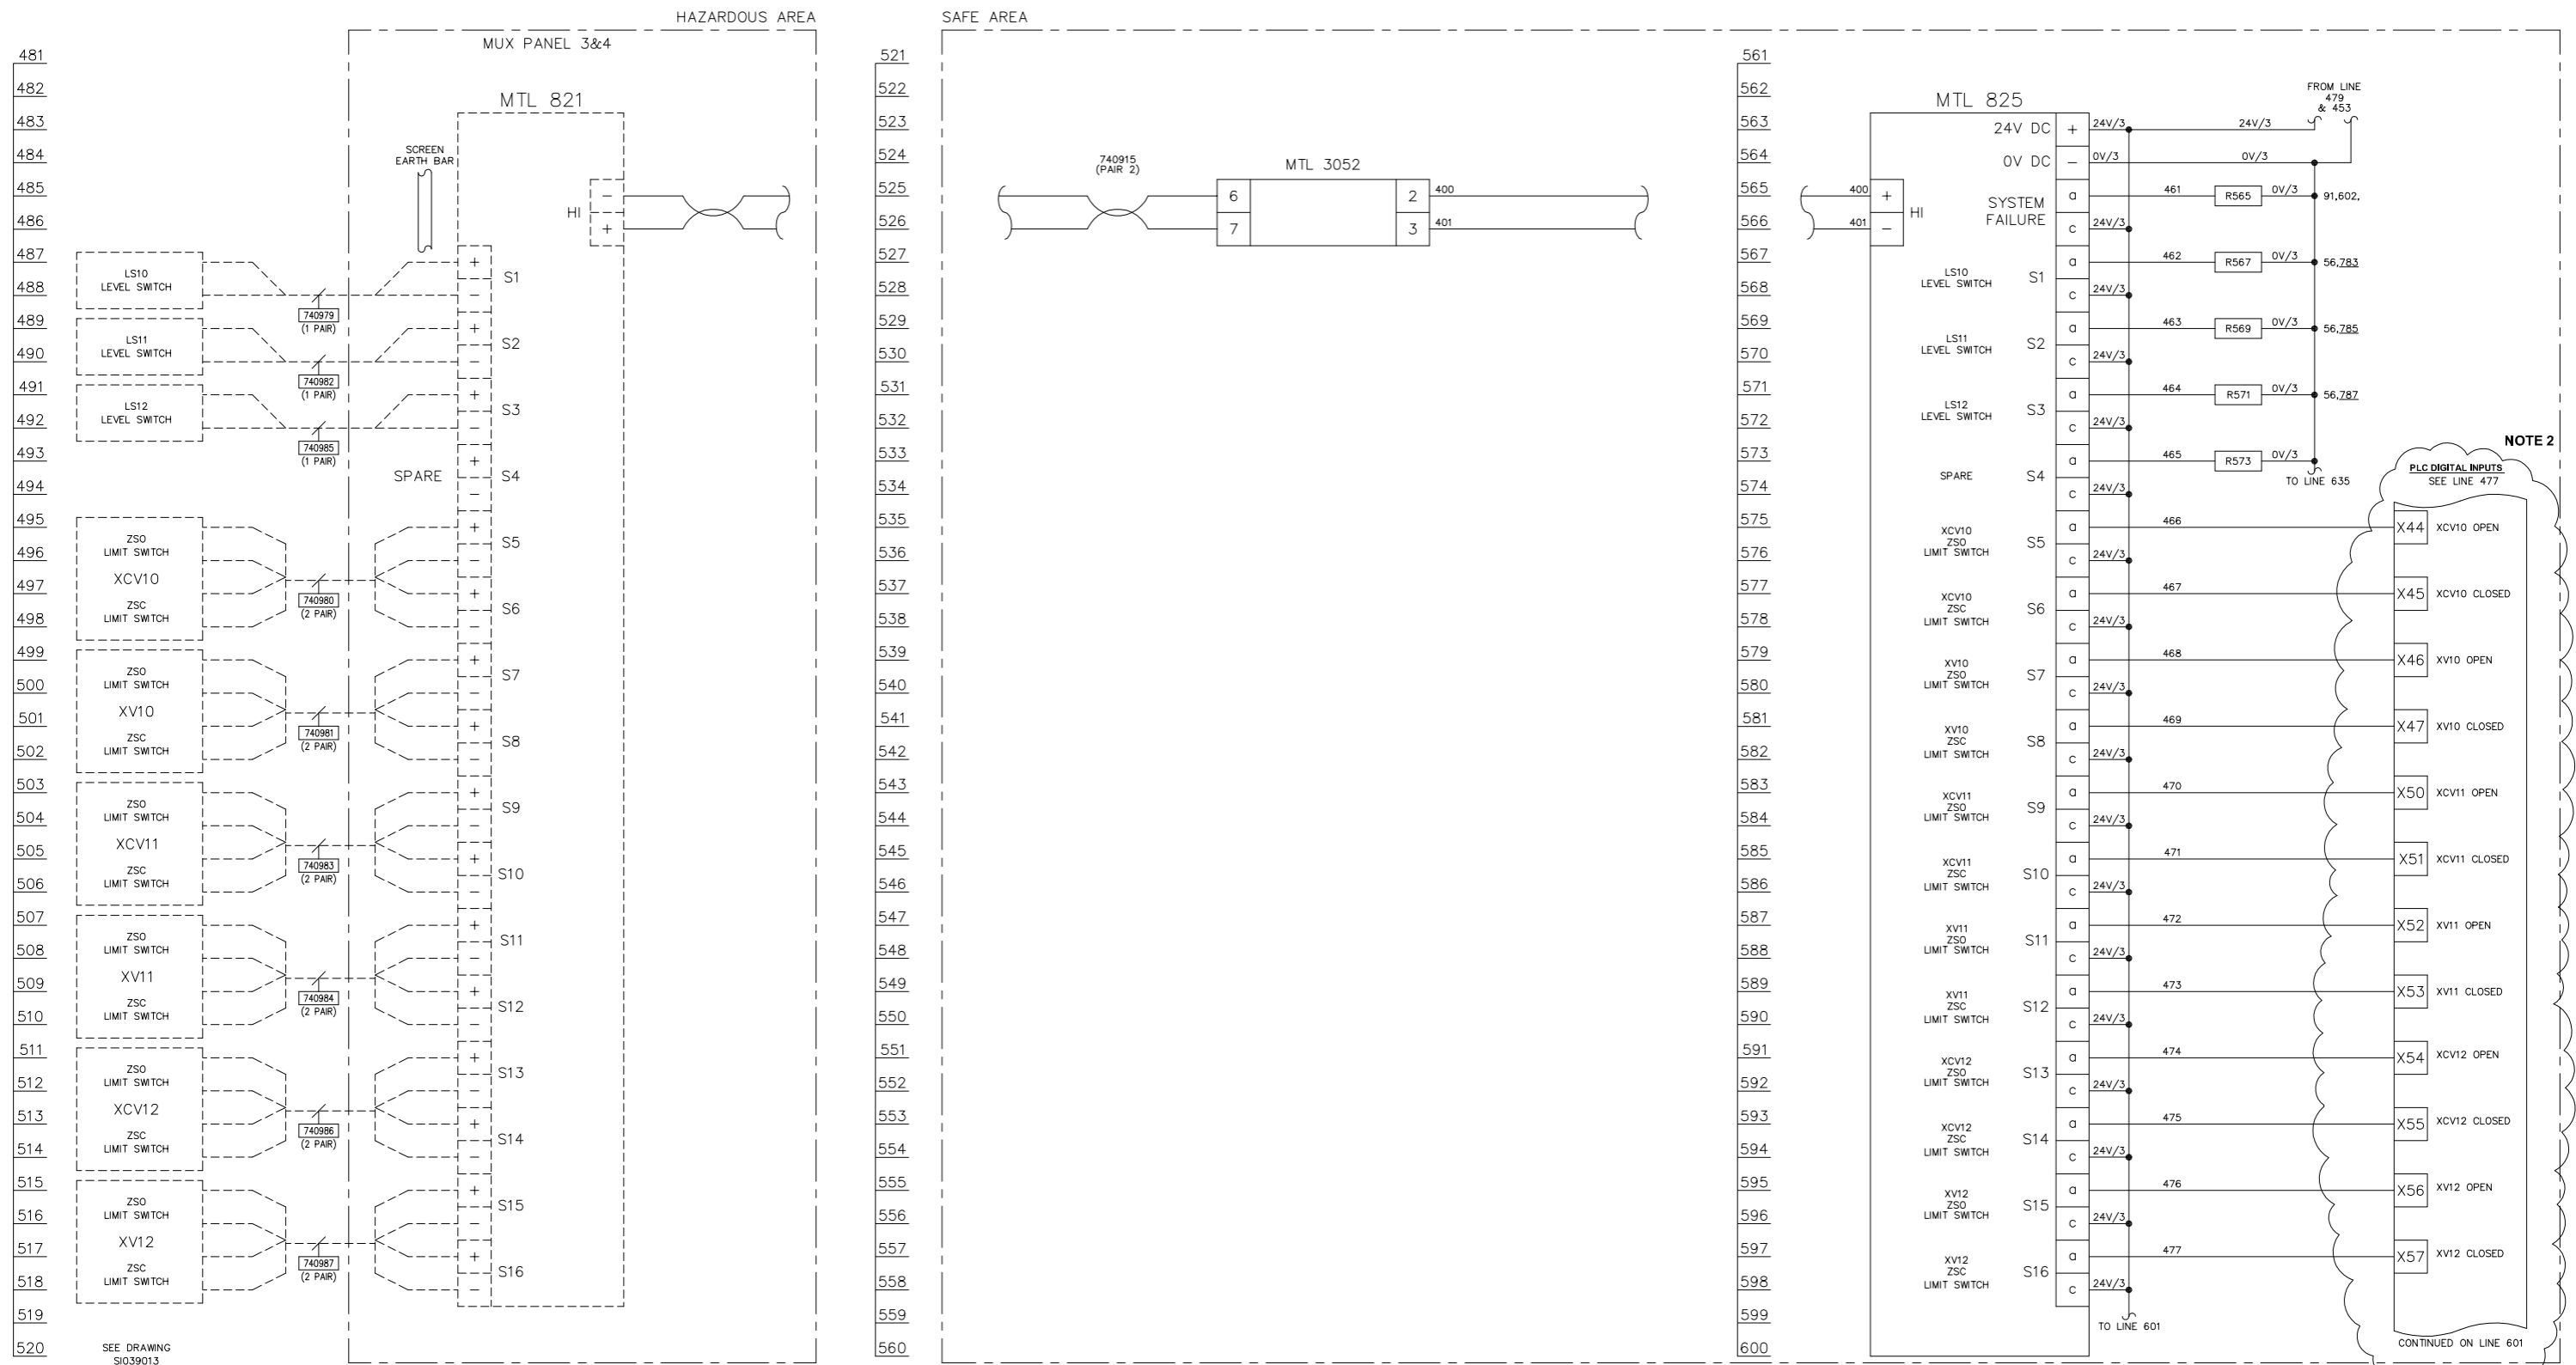

LAST NUMBER USED: 401  
SPARE TO: 460

LAST NUMBER USED: 477  
SPARE TO: 499

- NOTES**
- SCREEN EARTHS NOT SHOWN FOR CLARITY.
  - DECOMMISSIONED BATCHING SYSTEM. INPUTS NOT USED IN PLC




IF NOT SIGNED THIS DOCUMENT IS UNCONTROLLED


REV	DATE	BY	DRN	CHK'D	APP'D	DESCRIPTION
A	11/03/99	A.J.H.	A.J.H.	P.J.P.	P.J.P.	D.R.R. ORIGINAL ISSUE
B	07/07/99	D.P.	A.J.H.	D.R.R.	D.R.R.	COMMS POLARITY REVERSED
C	14/09/10	D.B.F.	P.P.	M.M.	M.M.	SI760 MODIFICATIONS

PLANT	IMMINGHAM STORAGE Co. - EAST TERMINAL
TITLE	4-EAST RAIL LOADING SYSTEM PANEL LOGIC DRAWING 5
CLIENT DRG. No.	P&I Design Ltd IMMINGHAM STORAGE Co. Ltd. IMMINGHAM EAST TERMINAL, IMMINGHAM DOCK, IMMINGHAM, SOUTH HUMBERSIDE
	P&I Design Ltd Tel. 01642 617444 www.ptdesign.co.uk
	SHEET 1 OF 1
	P&I DRG No. SI039006_DWG

LEGEND OF GRAPHICAL SYMBOLS (ALL CONTACTS SHOWN IN THE DE-ENERGISED STATE)

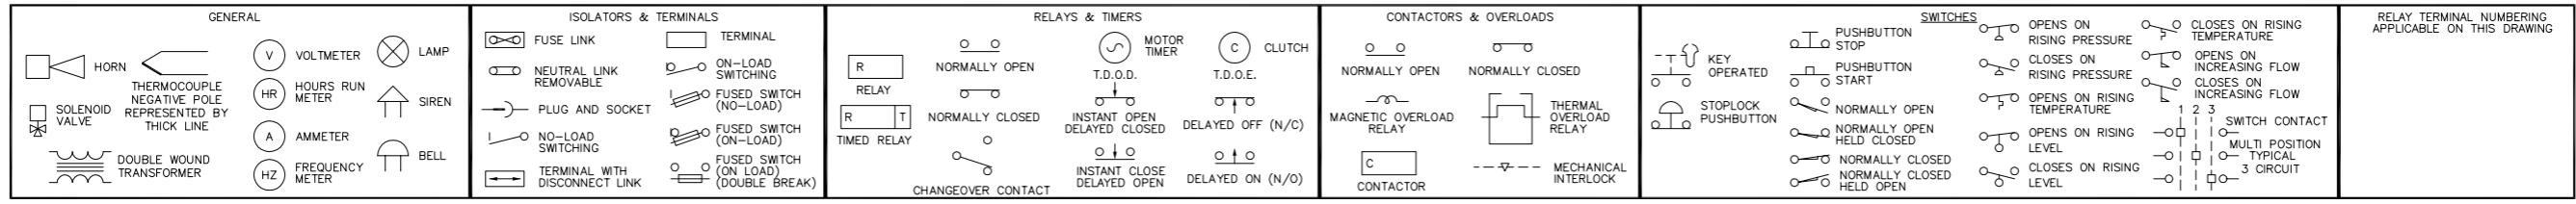

MUX 4 (SOUTH SIDING)

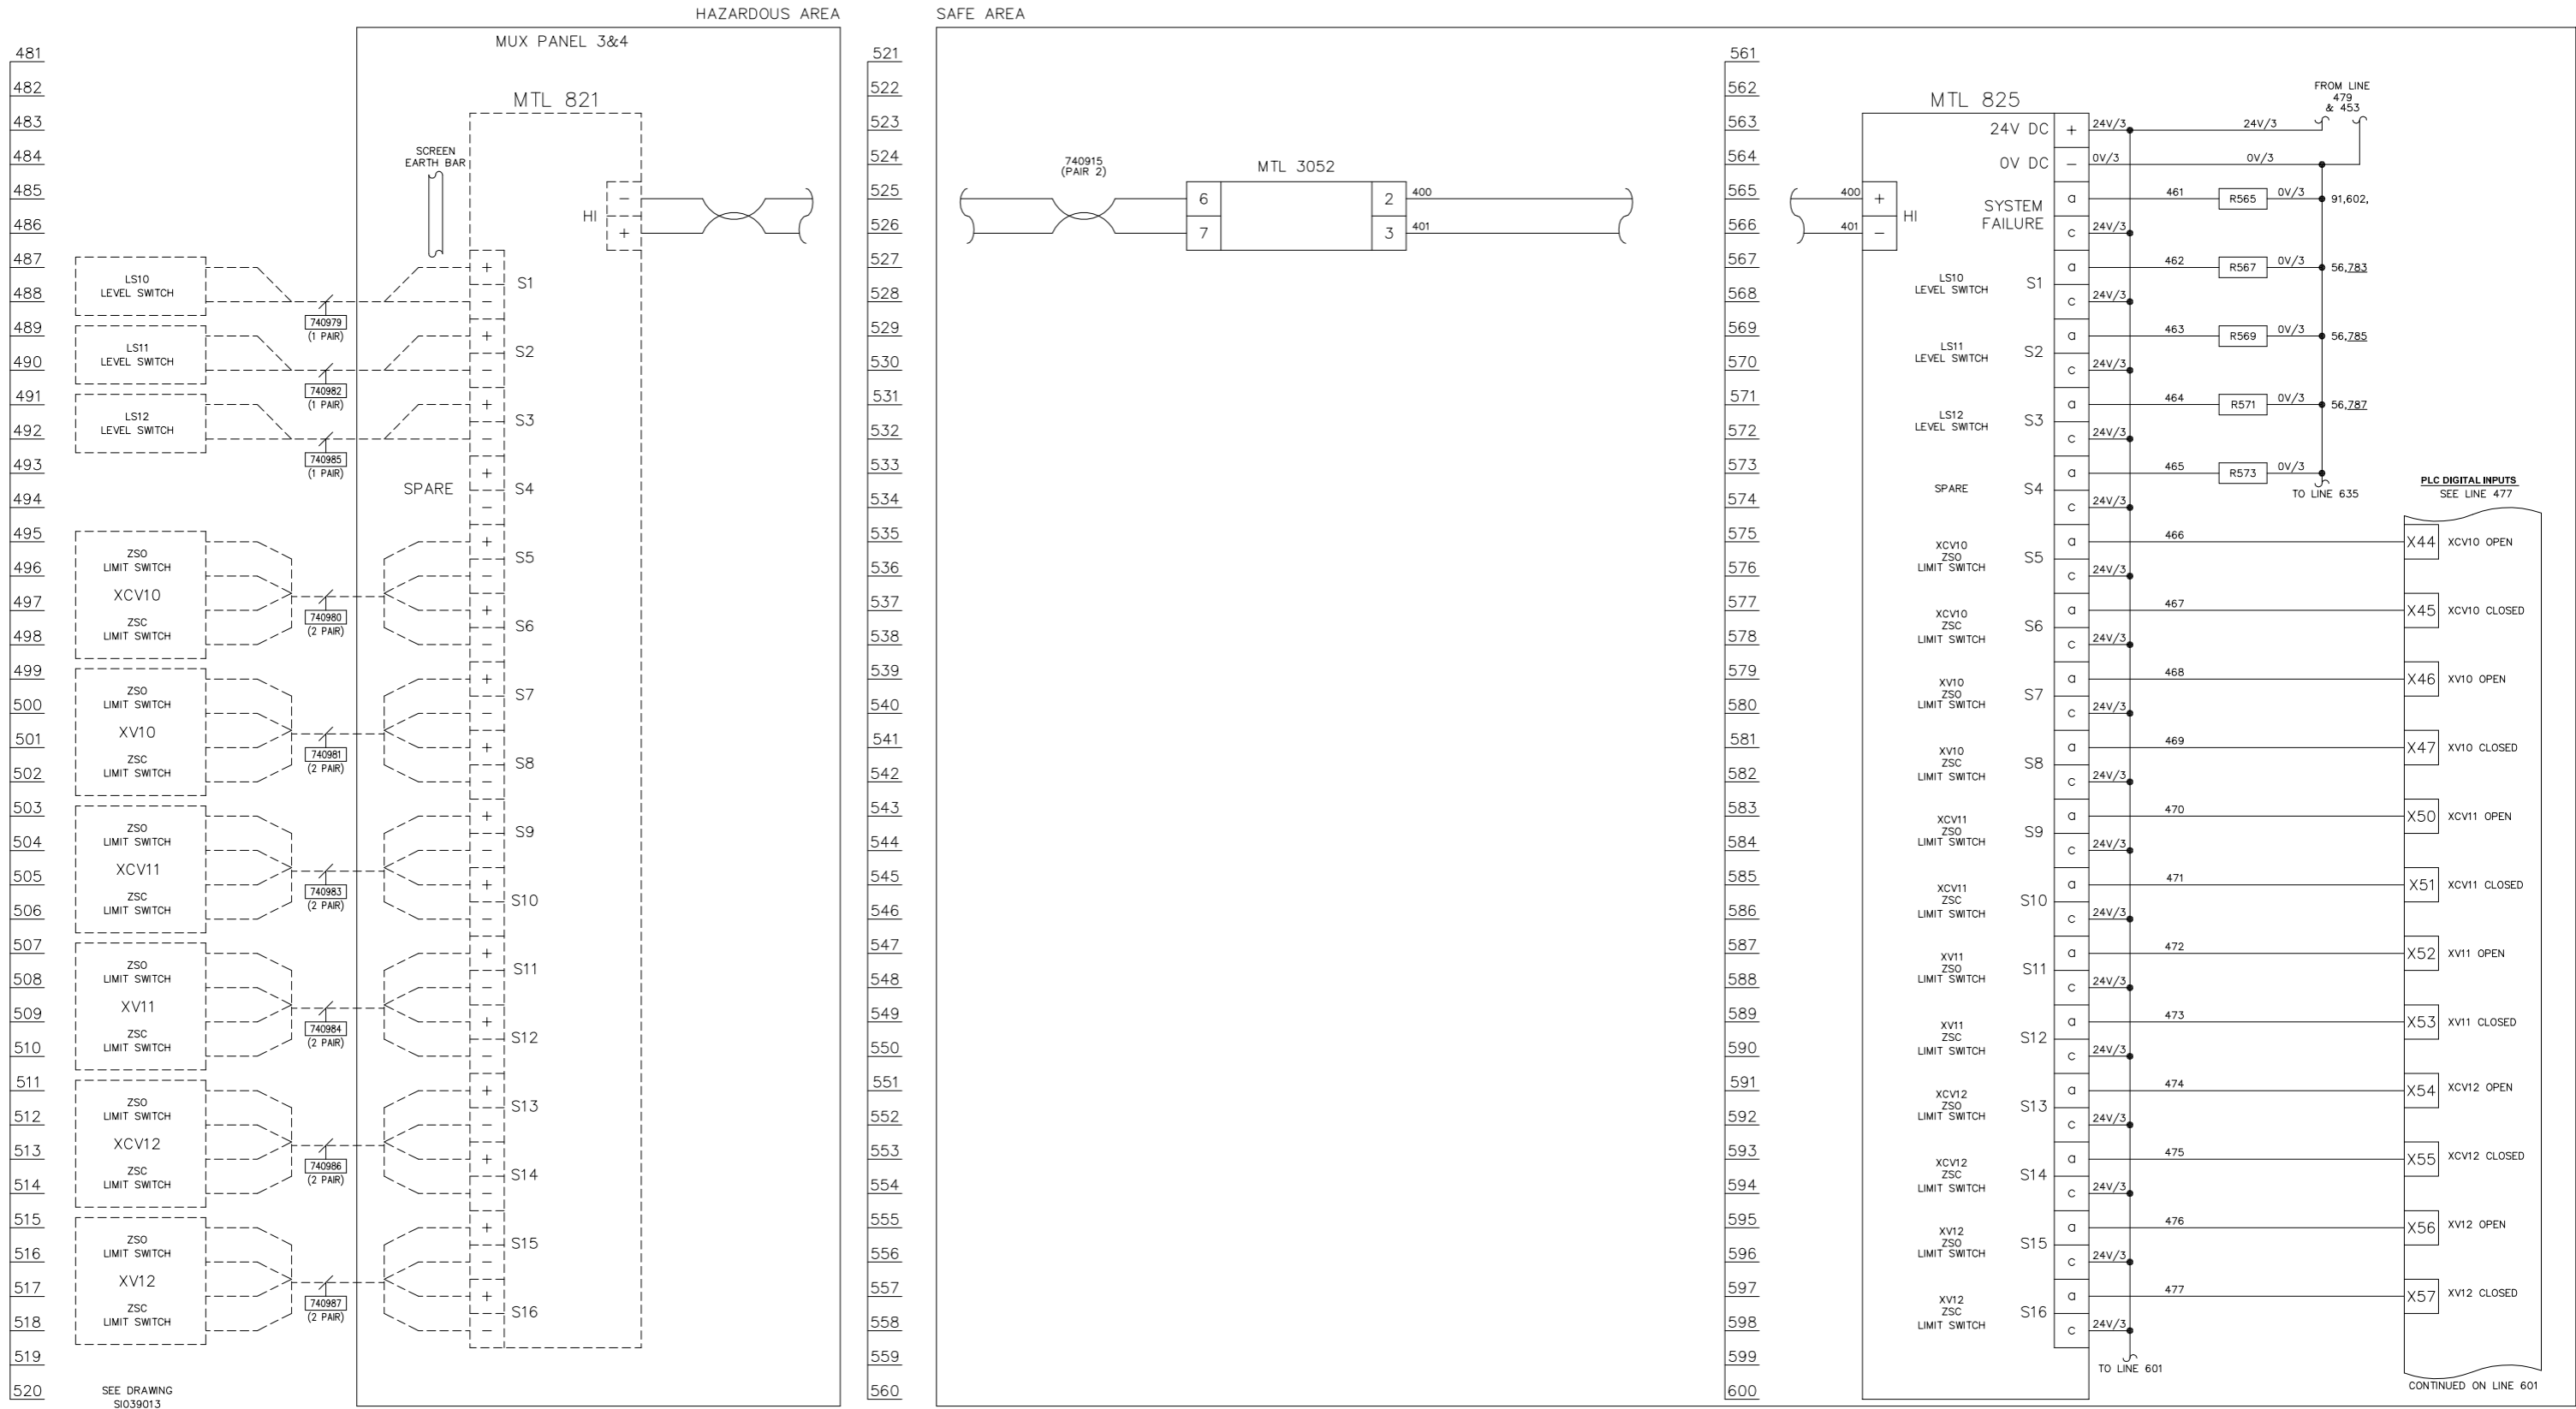

LAST NUMBER USED: 401  
 SPARE TO: 460

LAST NUMBER USED: 477  
 SPARE TO: 499


NOTES

REV	DATE	BY	DRN	CHK'D	APP'D	DESCRIPTION	PLANT	FINA DERV RAIL LOADING SYSTEM
A	11/03/99	A.J.H	A.J.H	P.J.P	P.J.P	ORIGINAL ISSUE	LOGIC 5	
B	02/07/99	D.P.	A.J.H	D.R.R	D.R.R	COMMS POLARITY REVERSED		02/07/99


**Simon Storage Terminals** IMMINGHAM STORAGE Co Ltd, IMMINGHAM EAST TERMINAL, IMMINGHAM DOCK, IMMINGHAM, SOUTH HUMBERSIDE  
 ELECTRICAL SCHEMATIC TEMPLATE SHEET 1 OF 01  
 CLIENT DRG. No. P&I DRG No. SI039006




LEGEND OF GRAPHICAL SYMBOLS (ALL CONTACTS SHOWN IN THE DE-ENERGISED STATE)

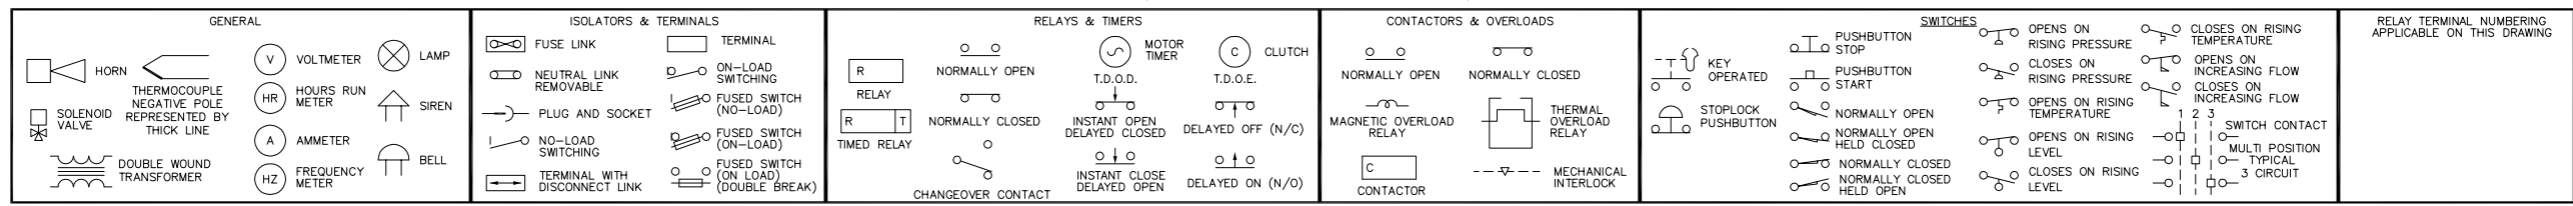


PLC DIGITAL INPUTS

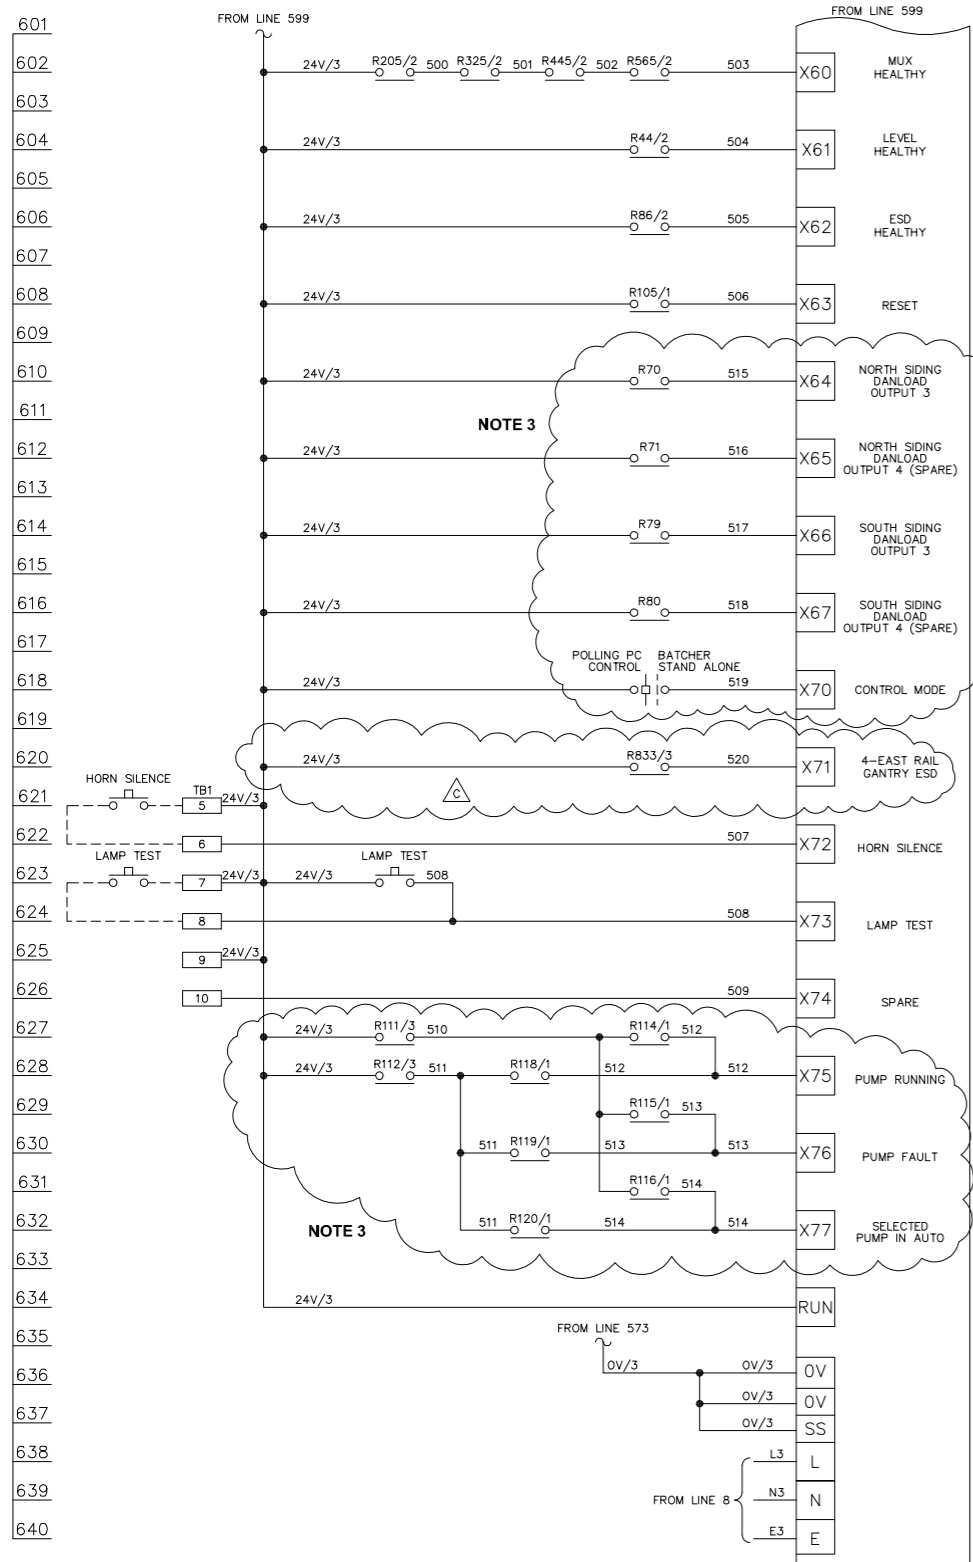

PLC DIGITAL OUTPUTS

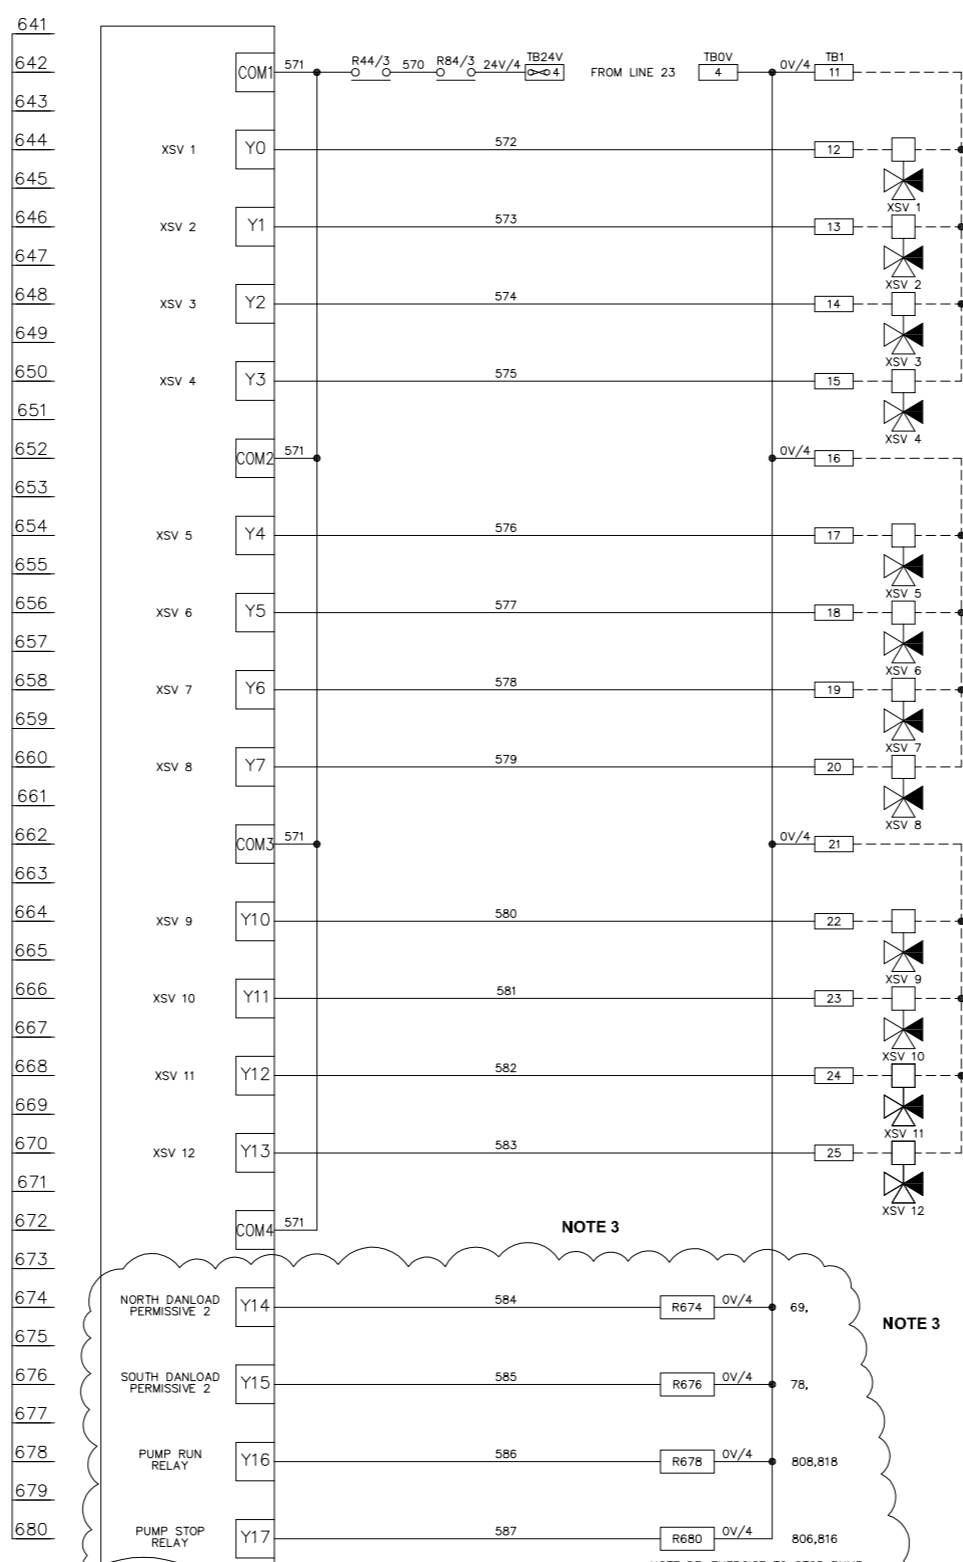

PLC DIGITAL OUTPUTS

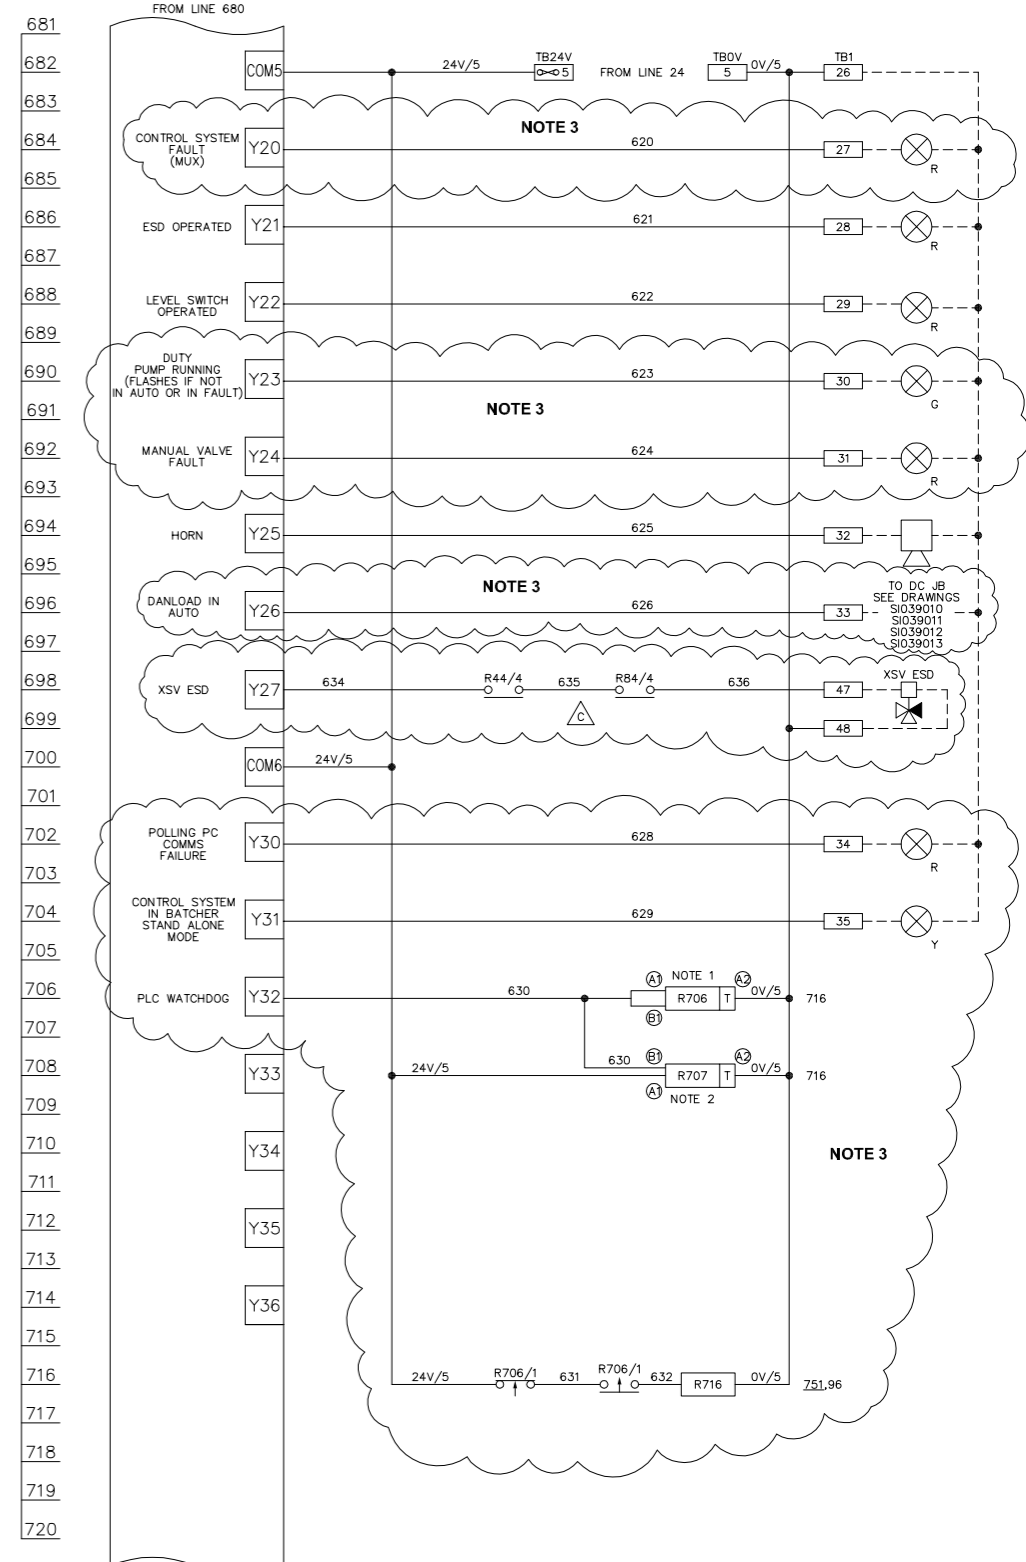

- NOTES
1. TIMER RELAY OMRON M3DE-M1 MODE A SET @ 1 SEC.
  2. TIMER RELAY OMRON M3DE-M1 MODE D SET @ 1 SEC
  3. DECOMMISSIONED BATCHING SYSTEM. INPUTS NOT USED IN PLC




IF NOT SIGNED THIS DOCUMENT IS UNCONTROLLED


REV	DATE	BY	DRN	CHK'D	APP'D	DESCRIPTION
A	07/04/99	A.J.H.	A.J.H.	D.R.R.	D.R.R.	ORIGINAL ISSUE
B	02/07/99	D.P.	A.J.H.	D.R.R.	D.R.R.	PANEL TEST MODS
C	14/09/10	D.B.F.	P.P.	M.M.	M.M.	SI760 MODIFICATIONS

PLANT	IMMINGHAM STORAGE Co. - EAST TERMINAL
TITLE	4-EAST RAIL LOADING SYSTEM PANEL LOGIC DRAWING 6
CLIENT DRG. No.	IMMINGHAM STORAGE Co. Ltd. IMMINGHAM EAST TERMINAL, IMMINGHAM DOCK, IMMINGHAM, SOUTH HUMBERSIDE
SHEET 1 OF 1	P&I Design Ltd Tel. 01642 617444 www.ptdesign.co.uk
P&I DRG No.	SI039007_DWG


LEGEND OF GRAPHICAL SYMBOLS (ALL CONTACTS SHOWN IN THE DE-ENERGISED STATE)

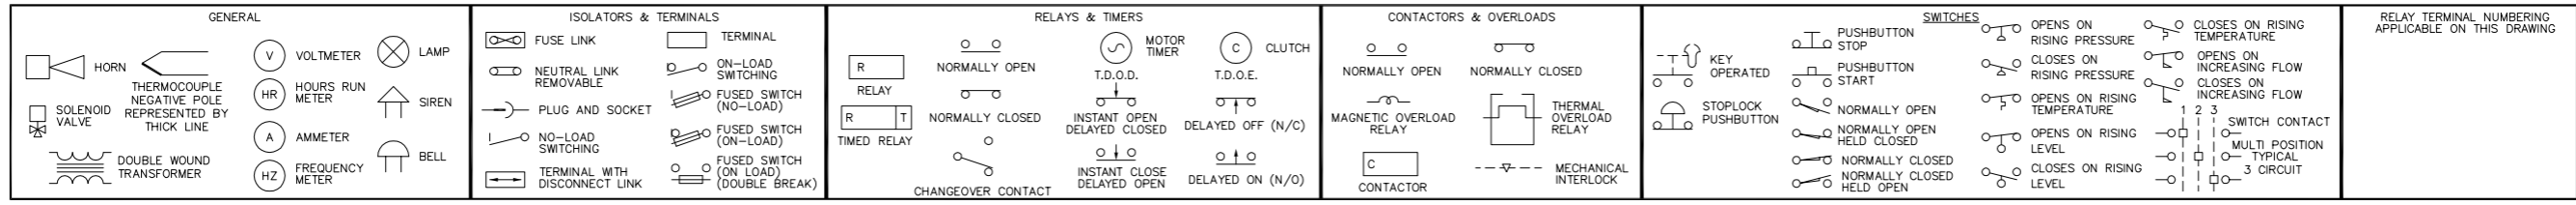


PLC DIGITAL INPUTS

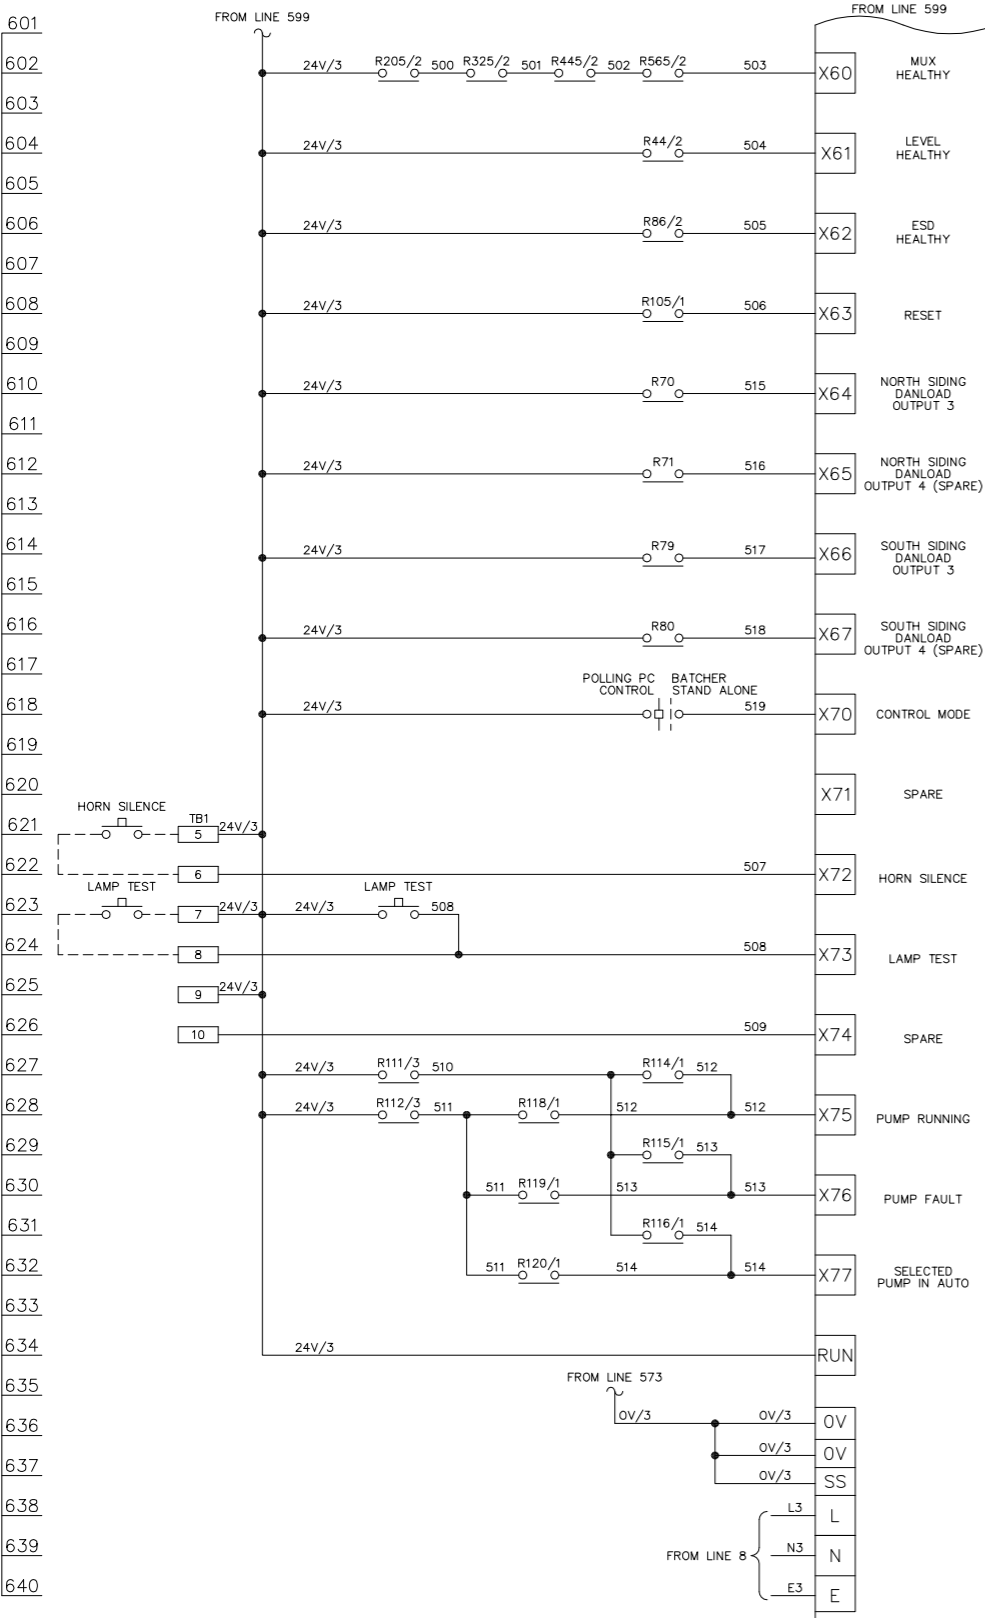


PLC DIGITAL OUTPUTS

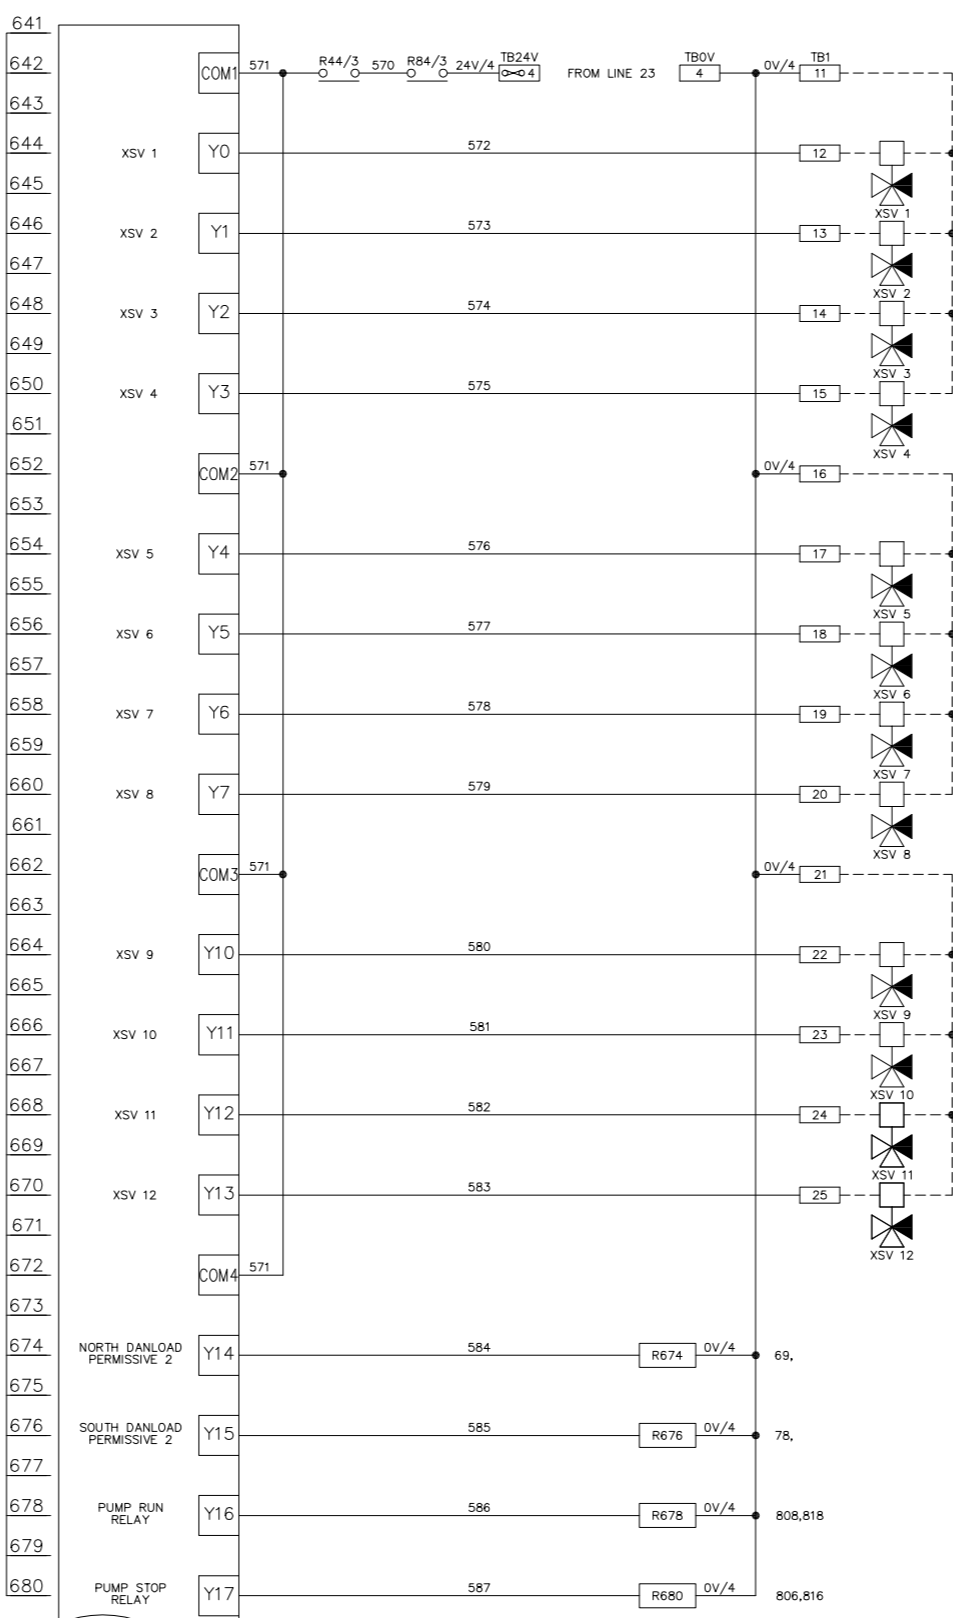

LEGEND OF GRAPHICAL SYMBOLS (ALL CONTACTS SHOWN IN THE DE-ENERGISED STATE)

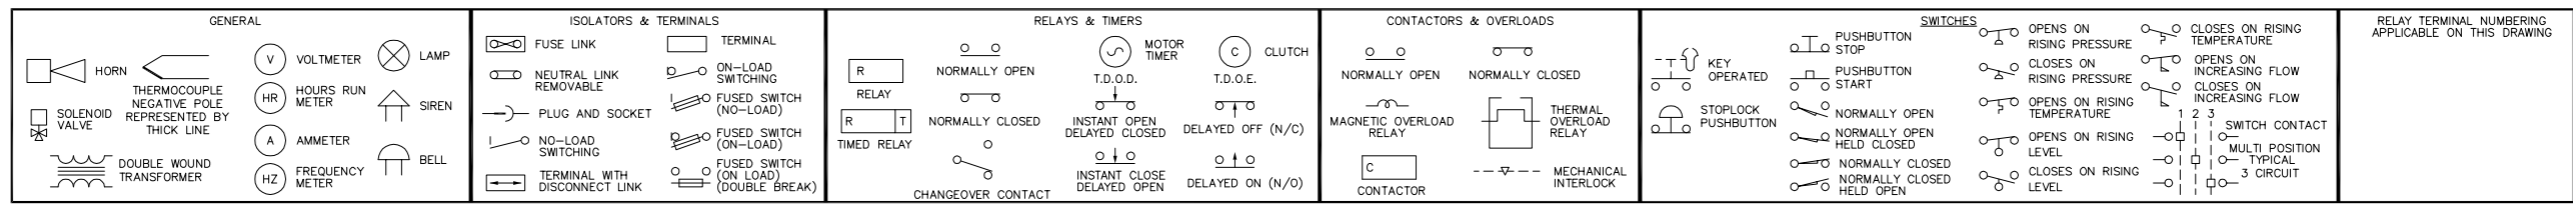


PLC DIGITAL OUTPUTS

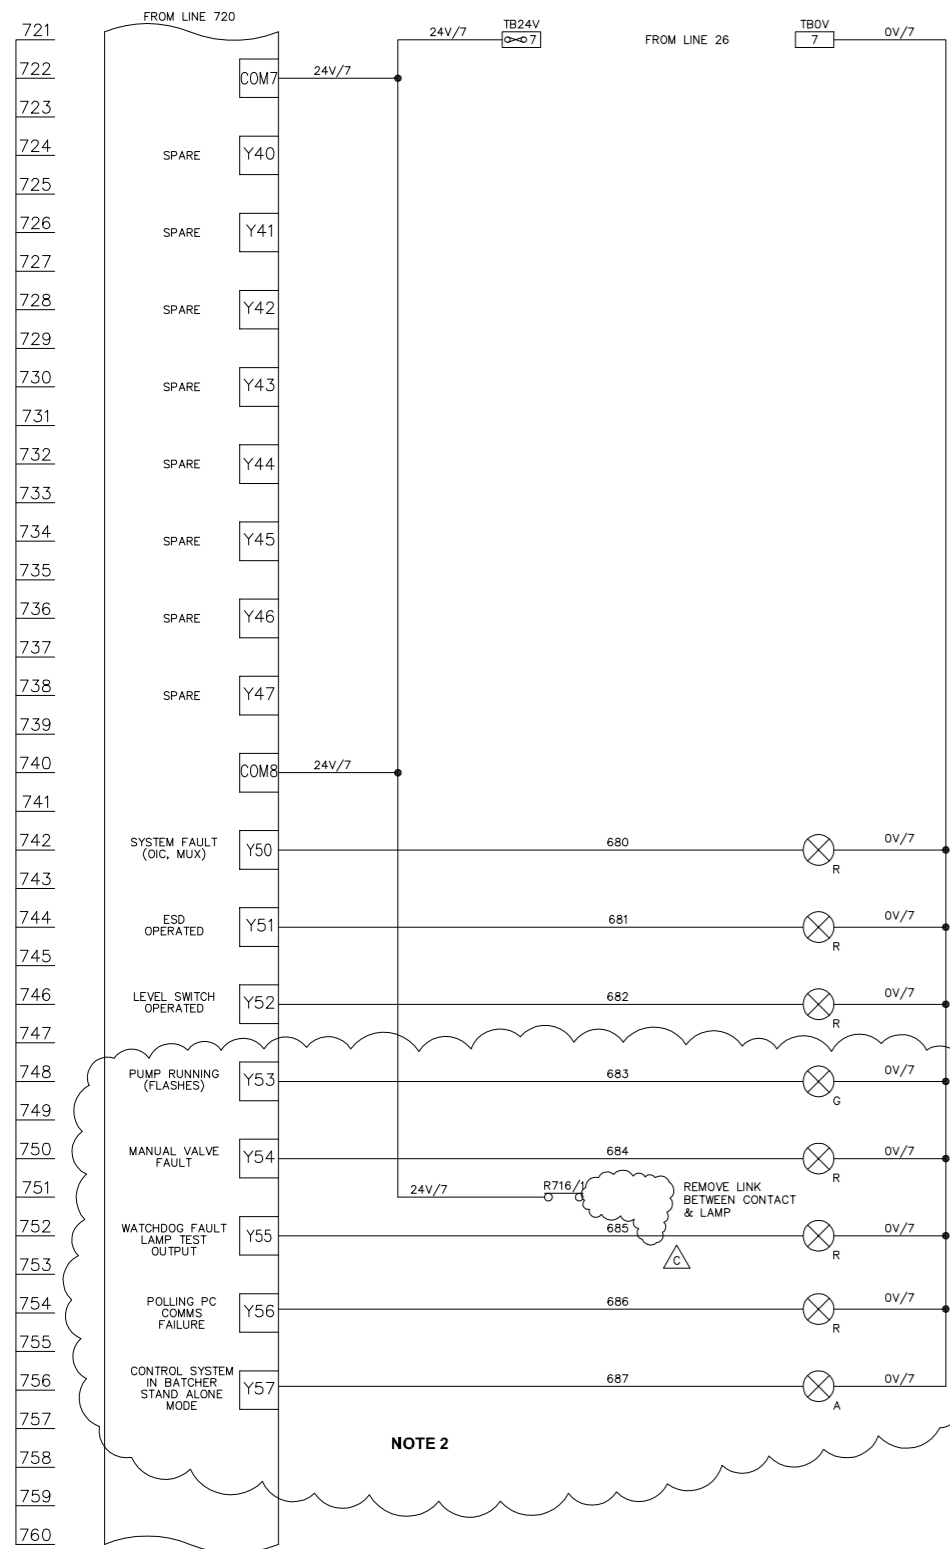


LAST NUMBER USED: 687  
SPARE TO: 749

PLC DIGITAL OUTPUTS

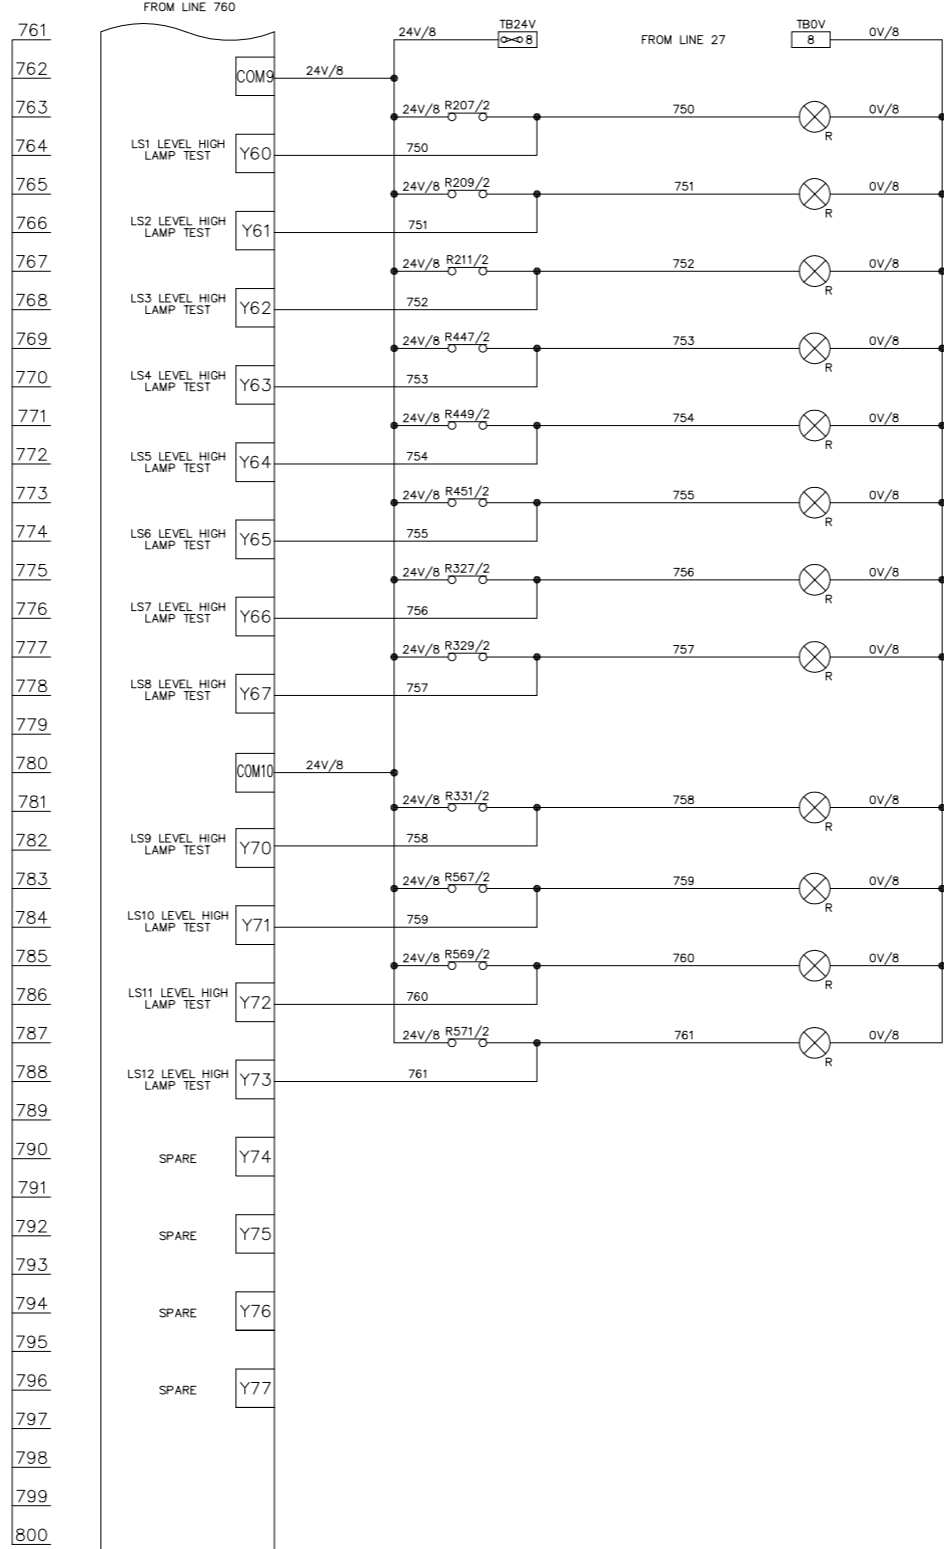

LAST NUMBER USED: 761  
SPARE TO: 849

PUMP CONTROLS (240V)

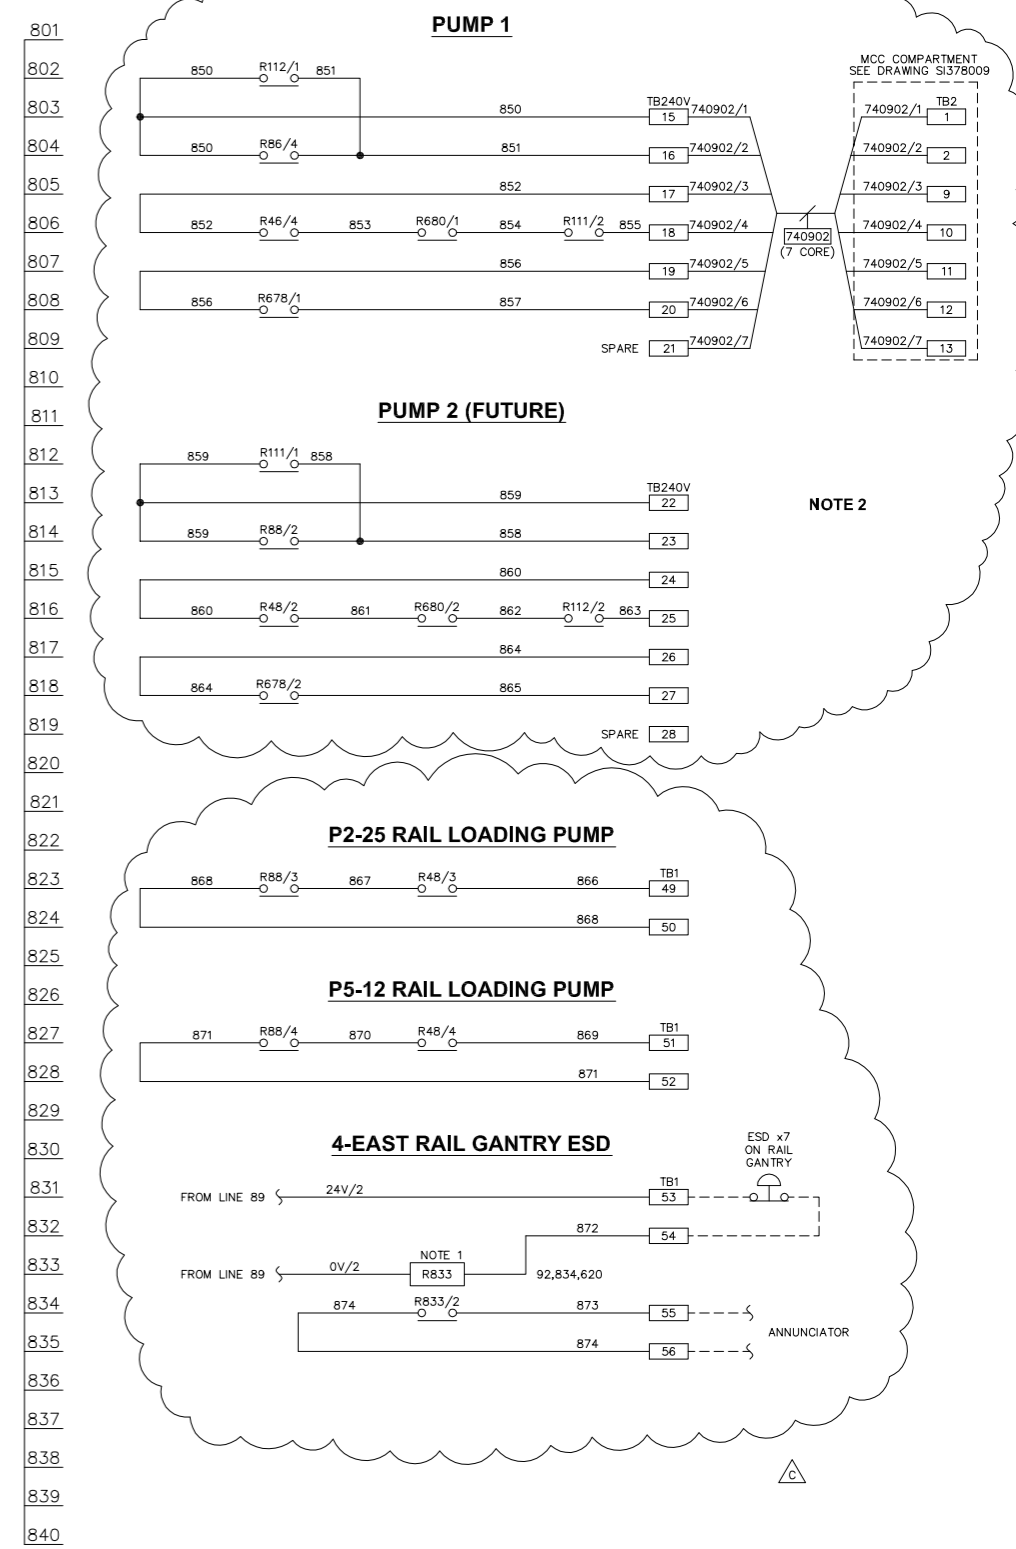

LAST NUMBER USED: 874  
SPARE TO: 899

- NOTES
- OMRON G7S-4A2B GUIDED CONTACT RELAY (RS260-4373).
  - DECOMMISSIONED BATCHING SYSTEM. INPUTS NOT USED IN PLC




IF NOT SIGNED THIS DOCUMENT IS UNCONTROLLED							PLANT	IMMINGHAM STORAGE Co. - EAST TERMINAL
REV	DATE	BY	DRN	CHK'D	APP'D	DESCRIPTION	TITLE	4-EAST RAIL LOADING SYSTEM PANEL LOGIC DRAWING 7
A	07/04/99	A.J.H.	A.J.H.	D.R.R.	D.R.R.	D.R.R.	ORIGINAL ISSUE	
B	02/07/99	D.P.	A.J.H.	D.R.R.	D.R.R.	D.R.R.	PANEL TEST MODS	
C	14/09/10	D.B.F.	P.P.	M.M.	M.M.		SI760 MODIFICATIONS	
							CLIENT DRG. No.	P&I DRG No. SI039008_DWG




SHEET 1 OF 1  
P&I DRG No. SI039008\_DWG




LEGEND OF GRAPHICAL SYMBOLS (ALL CONTACTS SHOWN IN THE DE-ENERGISED STATE)

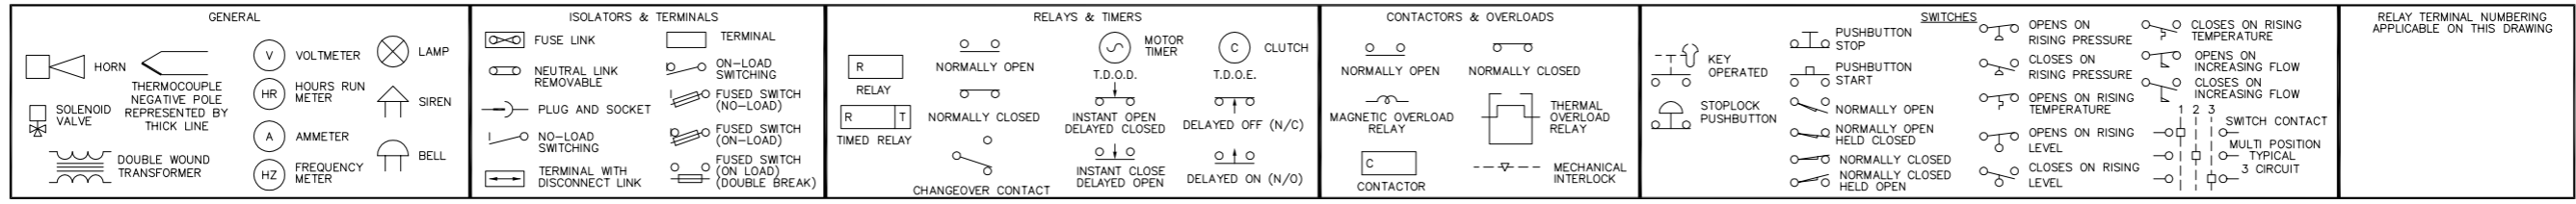


PLC DIGITAL OUTPUTS

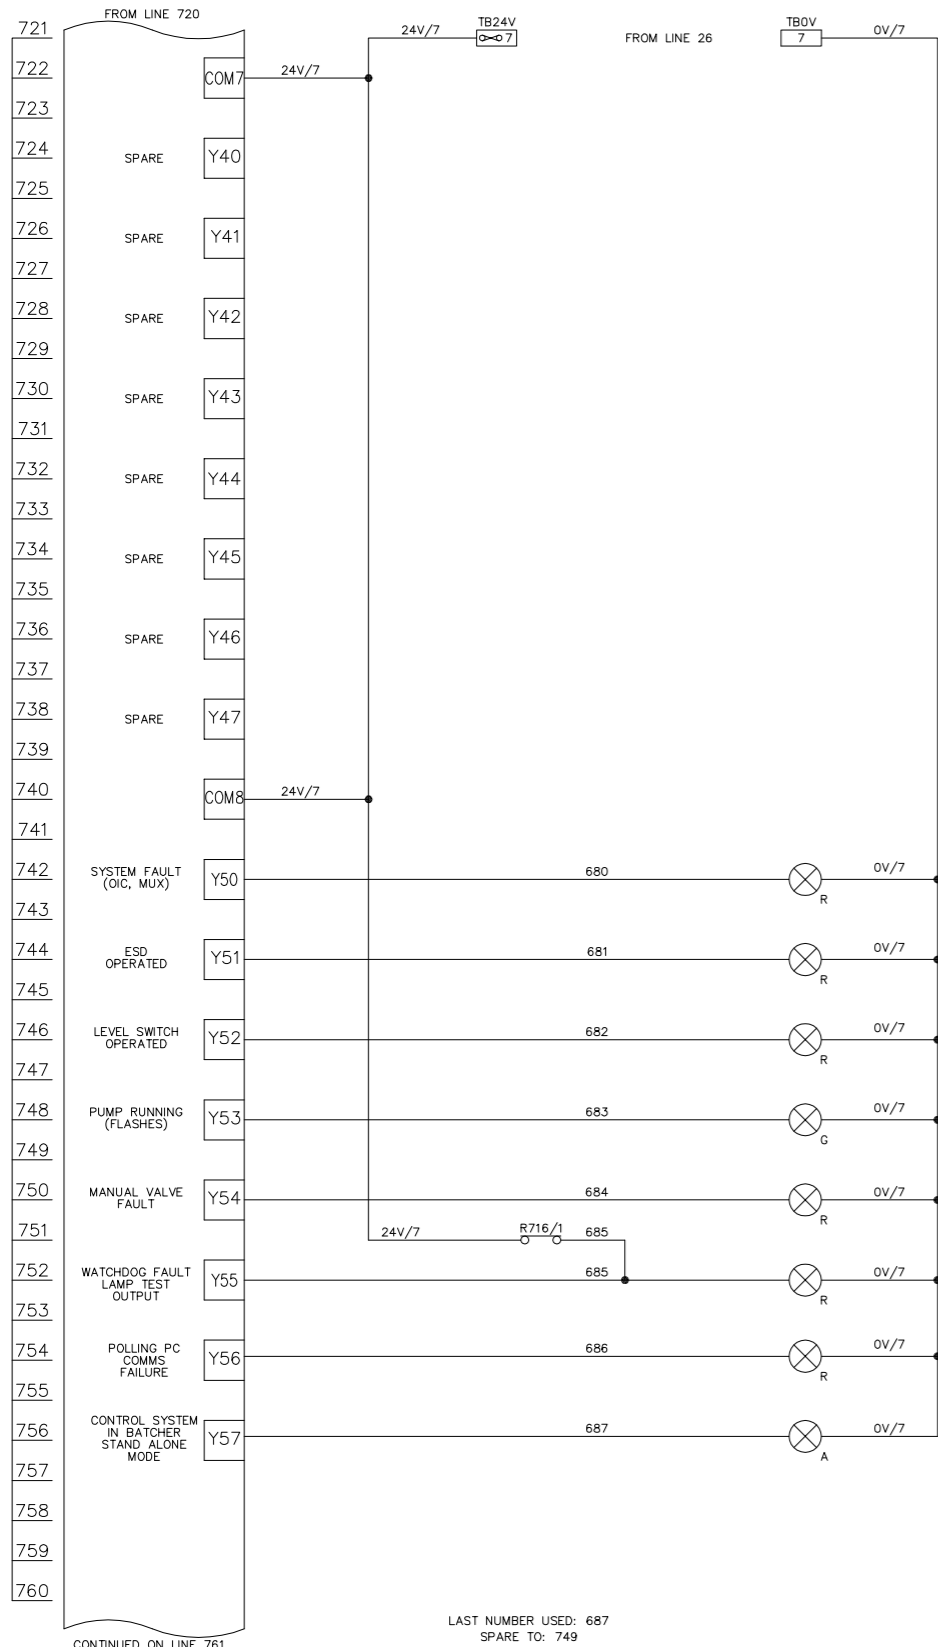

PLC DIGITAL OUTPUTS

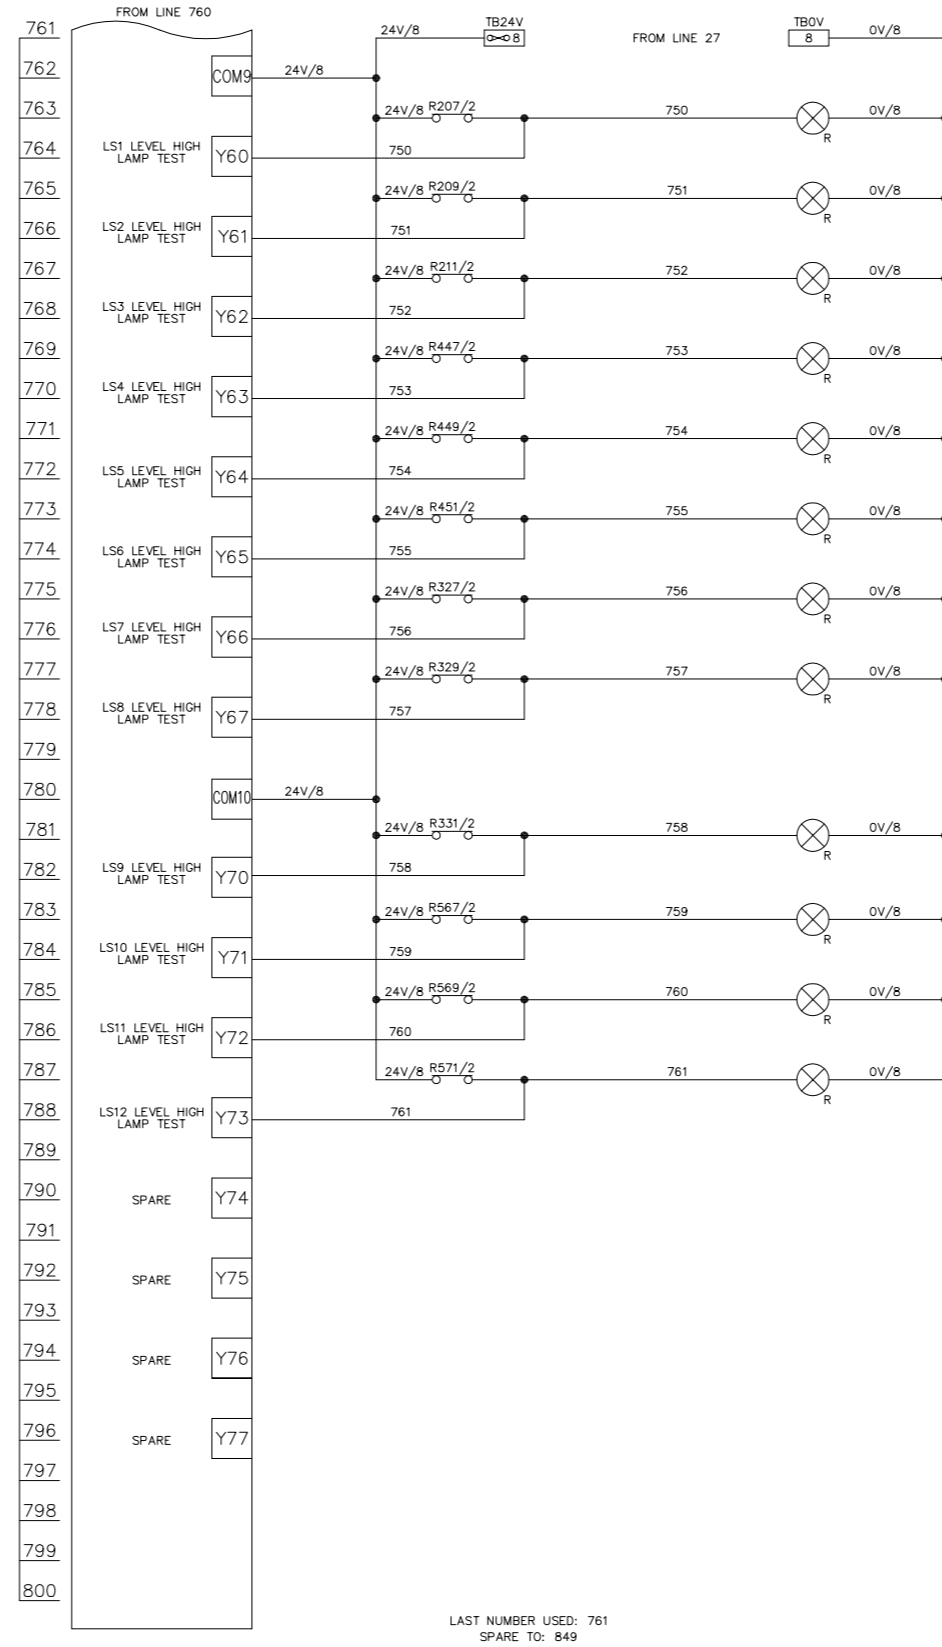

PUMP CONTROLS (240V)

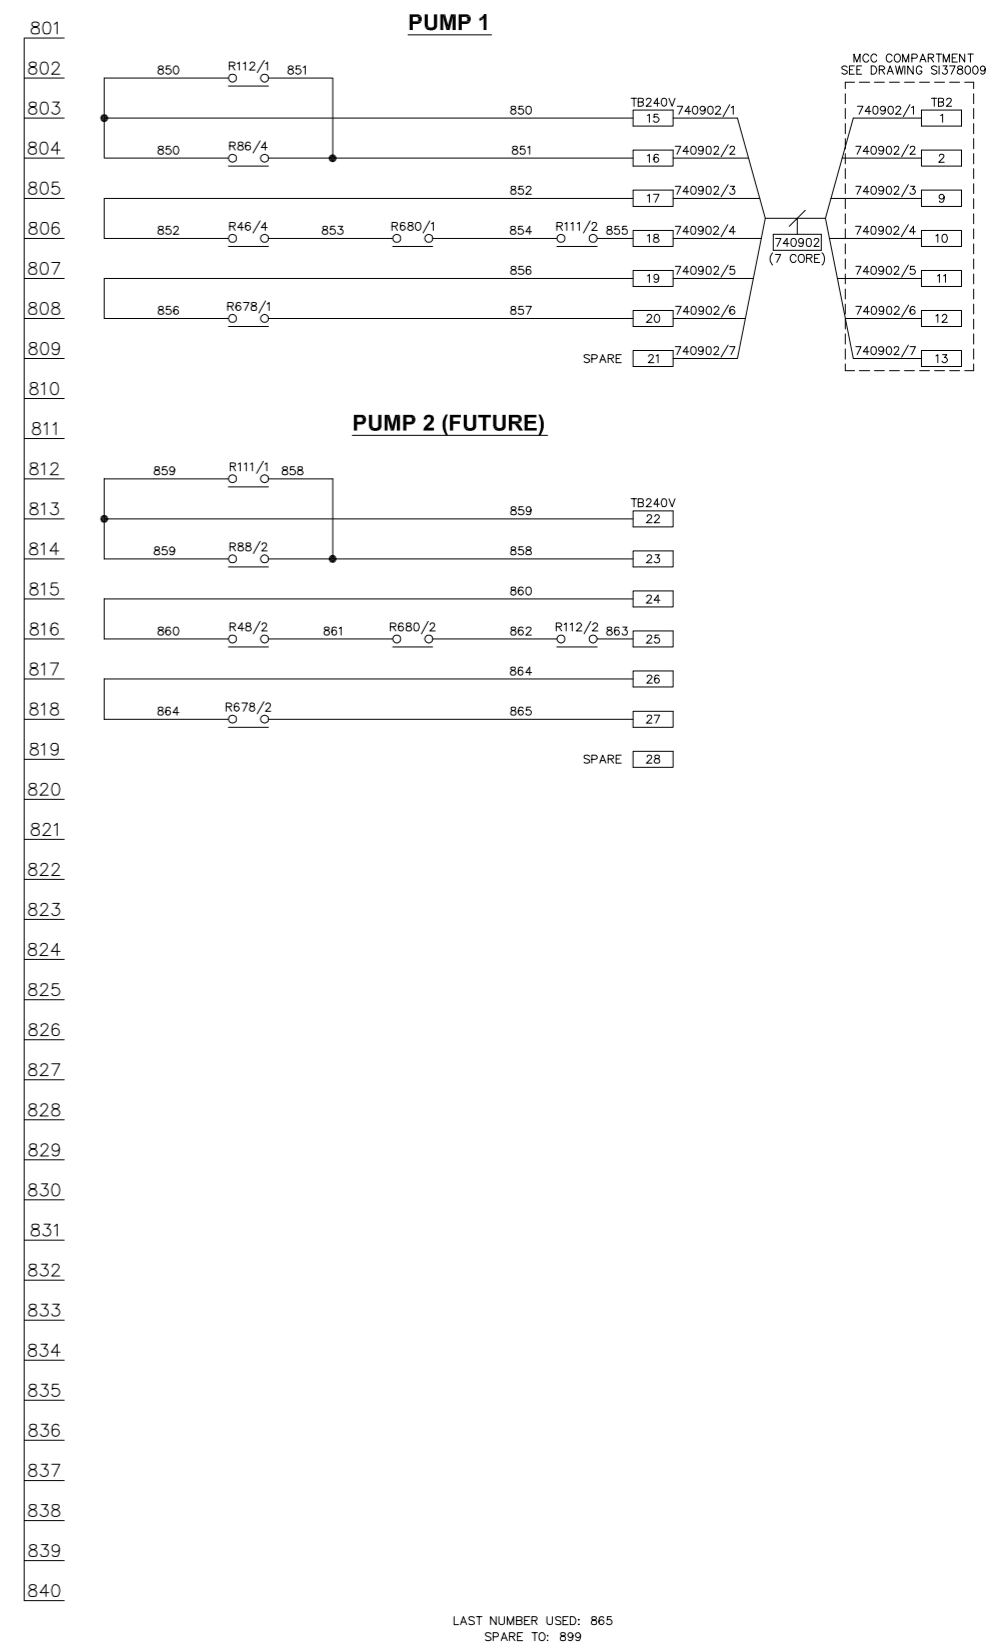

REV	DATE	BY	DRN	CHK'D	APP'D	DESCRIPTION	PLANT	FINA DERV RAIL LOADING SYSTEM
A	07/04/99	A.J.H	A.J.H	D.R.R	D.R.R	D.R.R	LOGIC 7	ORIGINAL ISSUE
B	02/07/99	D.P.	A.J.H	D.R.R	D.R.R	D.R.R		PANEL TEST MODS


02/07/99

**Simon Storage** IMMINGHAM STORAGE Co Ltd, IMMINGHAM EAST TERMINAL, SOUTH HUMBERSIDE

**P & I DESIGN**

ELECTRICAL SCHEMATIC TEMPLATE SHEET 01 OF 01

CLIENT DRG. No. P&I DRG No. SI039008

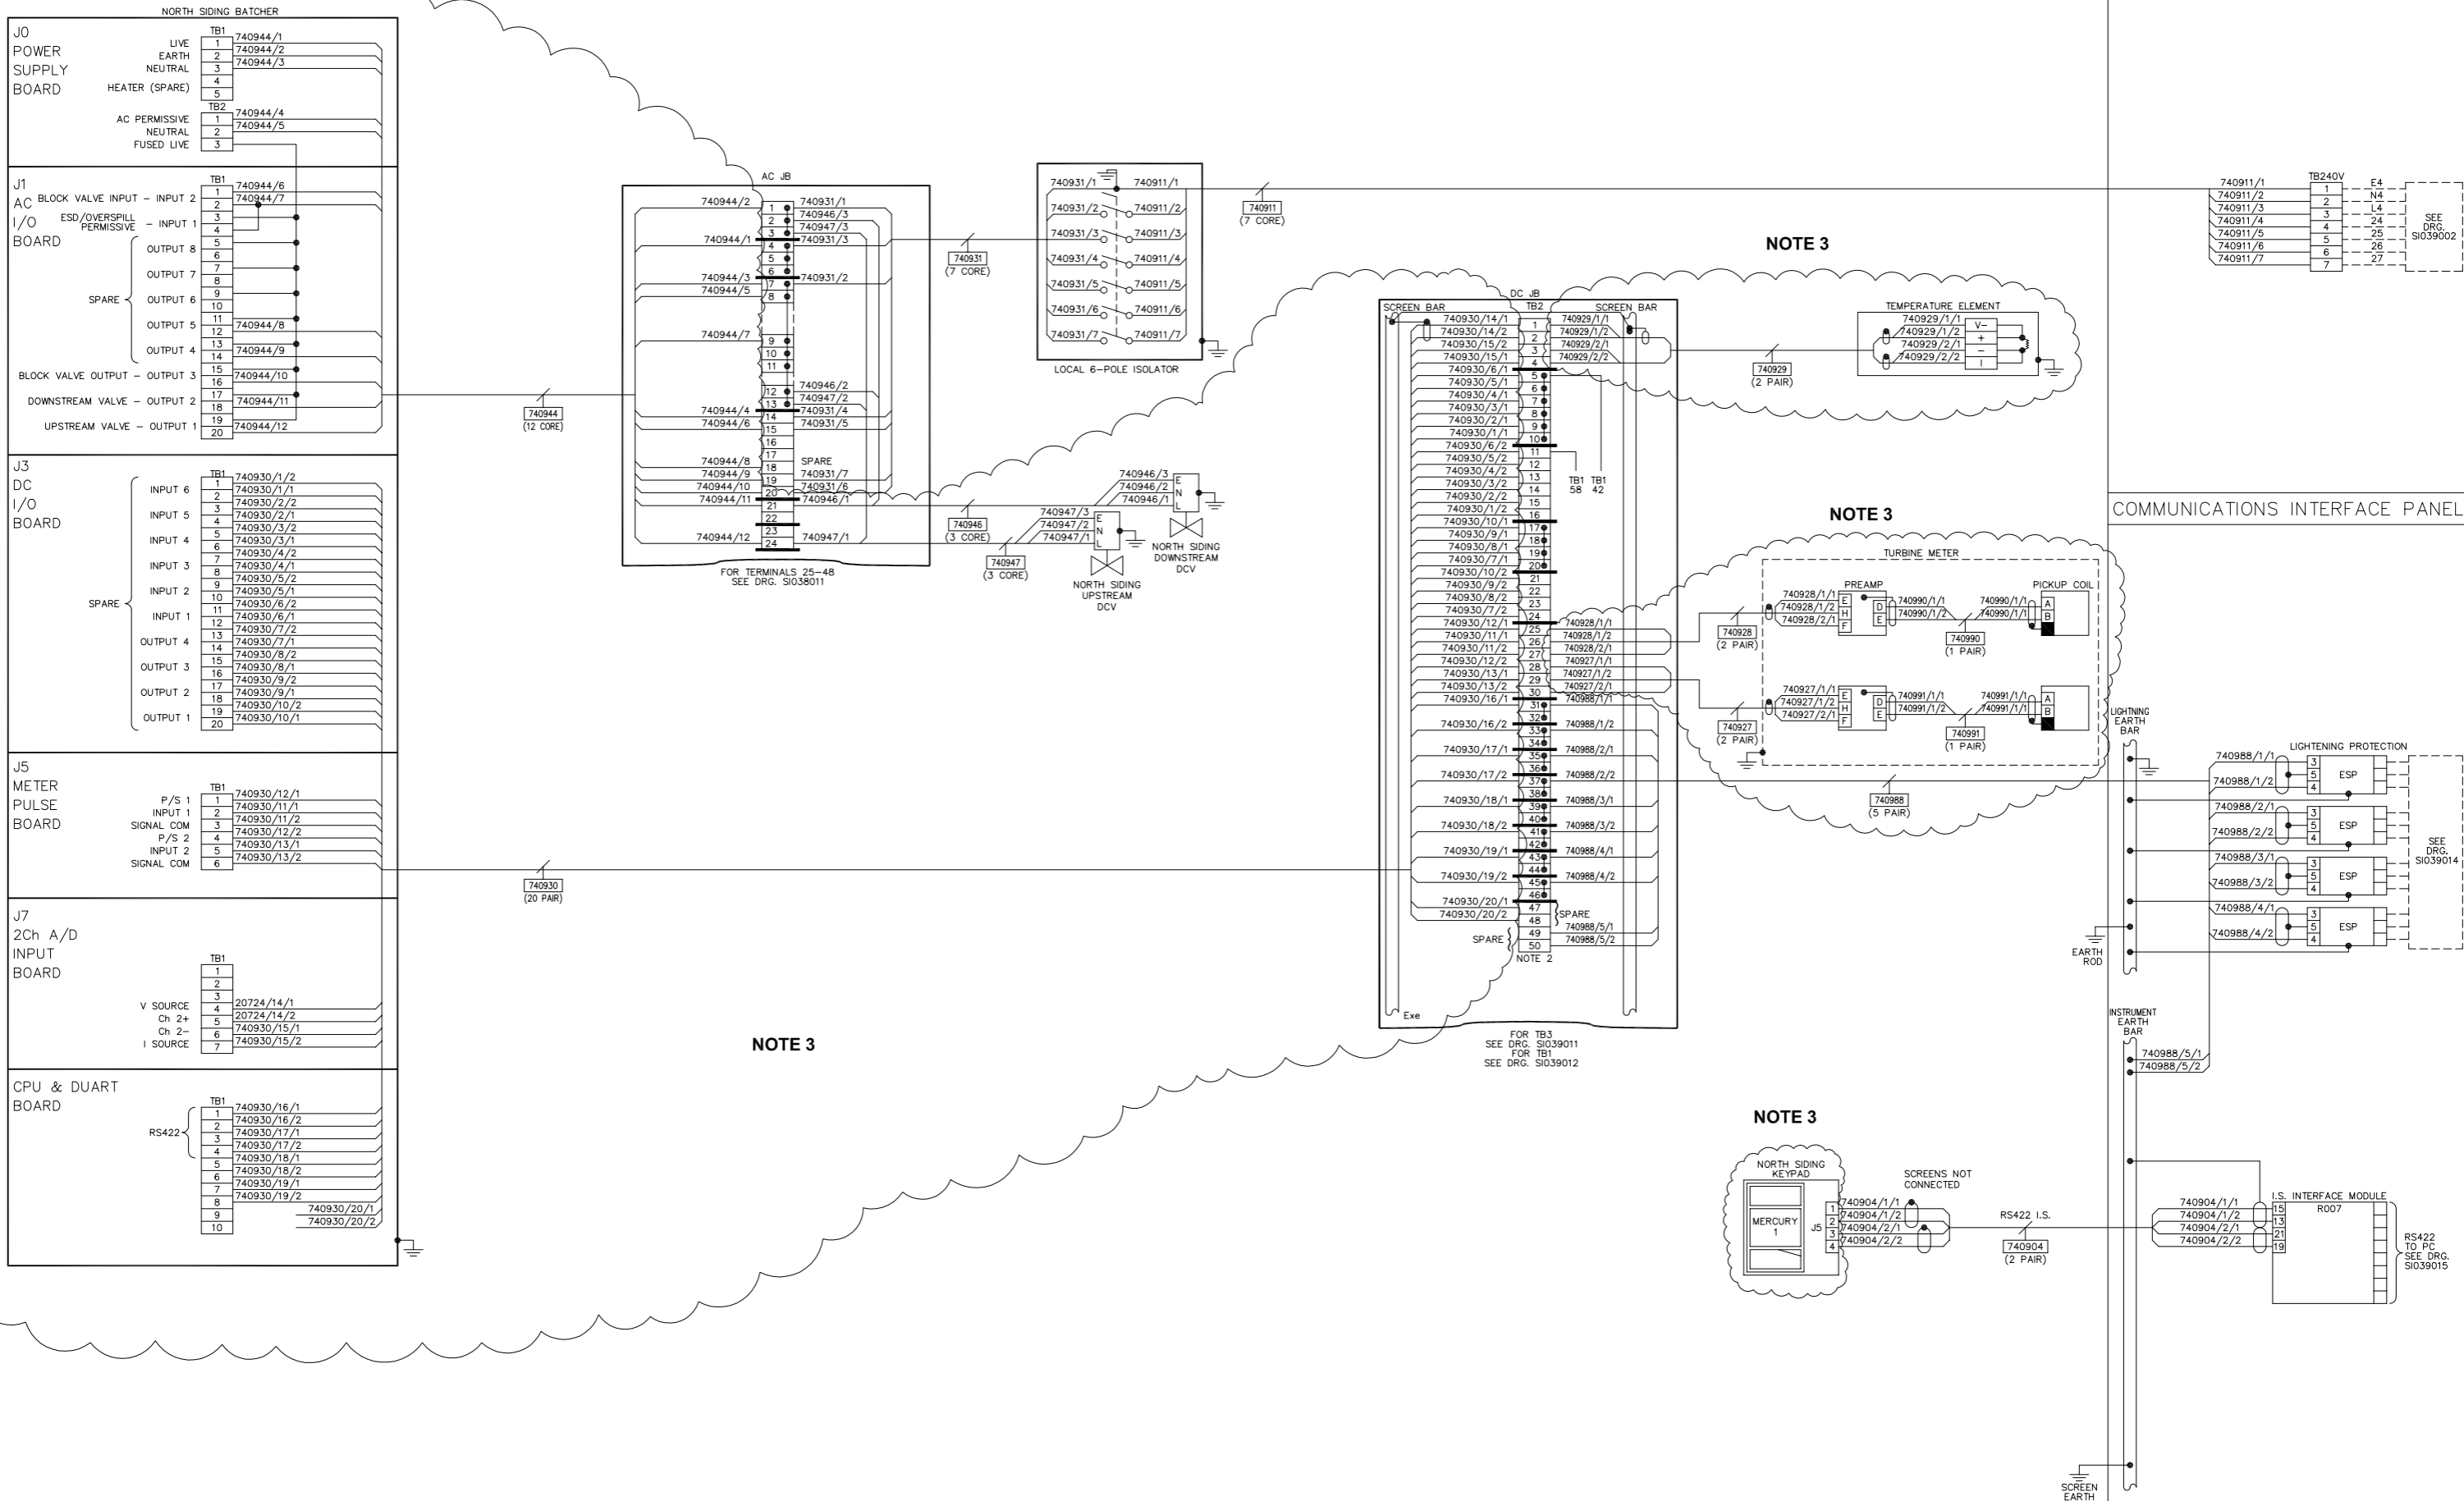

NOTE 3

NOTE 3

NOTE 3

NOTE 3

- NOTES**
1. ALL SCREENS NOT SHOWN FOR CLARITY.
  2. FOR COMMUNICATION INTERCONNECTIONS SEE DRAWING SI039014.
  3. DECOMMISSIONED BATCHING SYSTEM. FIELD EQUIPMENT REMOVED.



IF NOT SIGNED THIS DOCUMENT IS UNCONTROLLED






REV	DATE	BY	DRN	CHK'D	APP'D	DESCRIPTION	
A	08/04/99	A.J.H.	A.J.H.	D.R.R.	D.R.R.	D.R.R.	ORIGINAL ISSUE
B	02/07/99	D.P.	A.J.H.	D.R.R.	D.R.R.	D.R.R.	GENERAL UPDATE
C	29/06/00	D.P.	A.B.	D.R.R.	D.R.R.	D.R.R.	ON SITE CHANGES
D	14/09/10	D.B.F.	P.P.	M.M.	M.M.		SI760 MODIFICATIONS

PLANT	IMMINGHAM STORAGE Co. - EAST TERMINAL
TITLE	4-EAST RAIL LOADING SYSTEM NORTH SIDING BATCHING SYSTEM LOOP
CLIENT DRG. No.	P&I DRG No. SI039010_DWG


SAFETY PROTECTION	FLAMEPROOF & INCREASED SAFETY		CERTIFIED EQUIPMENT				CERTIFIED EQUIPMENT					
	REQUIRED	ACHIEVED	TAG No.	CERTIFICATE No.	CERTIFICATION AUTHORITY	TAG No.	CERTIFICATE No.	CERTIFICATION AUTHORITY	TAG No.	CERTIFICATE No.	CERTIFICATION AUTHORITY	
AREA CLASS	ZONE 1	XXXX	FQ01	93C.105.11123	EExd IIB T6	BASEEFA	AC JB	84B3299X	EE*x* IIC T6	BASEEFA		
GAS GROUP	IIB	XXXX	TE01	831045X	EExd IIC T6	BASEEFA						
TEMPERATURE CLASS	T3	XXXX	FT01	86B1336	EExd IIC T6	BASEEFA						
			DCV01A	TBA	TBA	TBA						
			DCV01B	TBA	TBA	TBA						
			DC JB	84B3299X	EE*x* IIC T6	BASEEFA						

FIELD

CONTROL PANEL

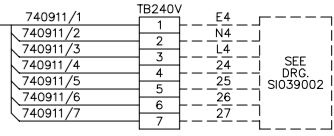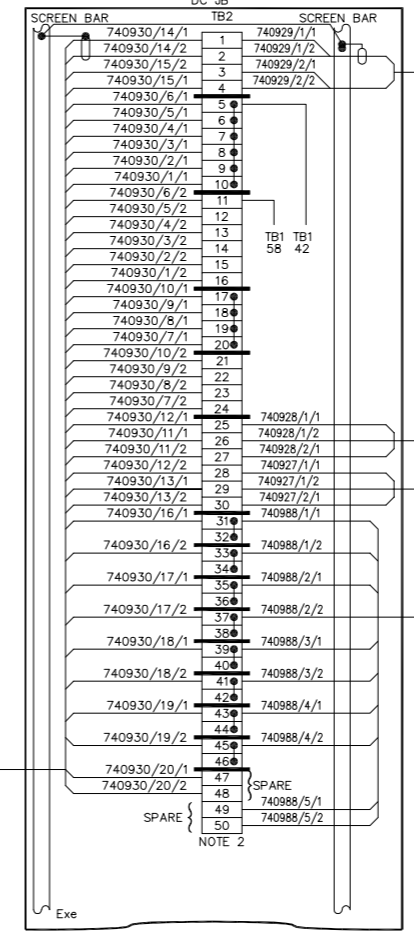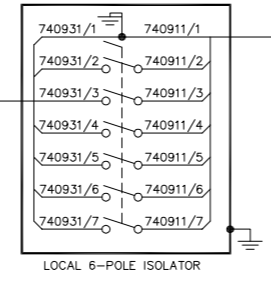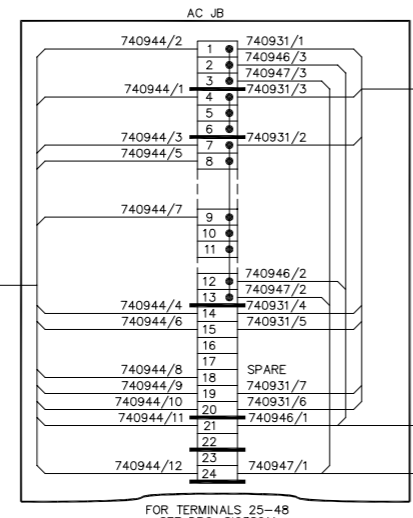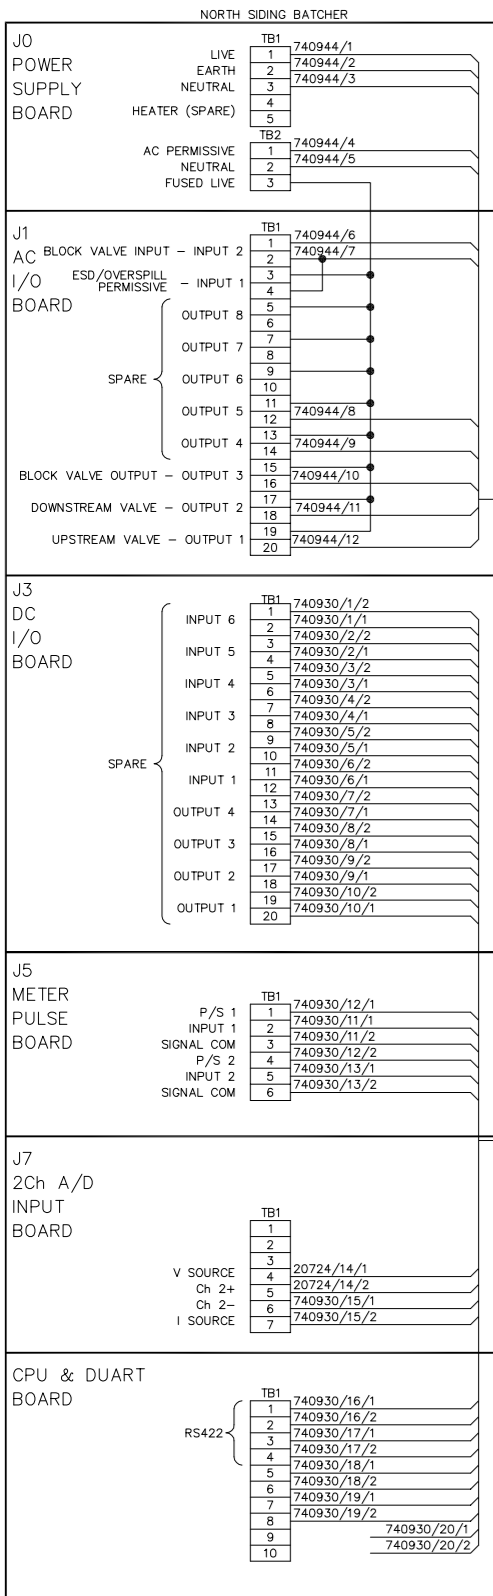

COMMUNICATIONS INTERFACE PANEL

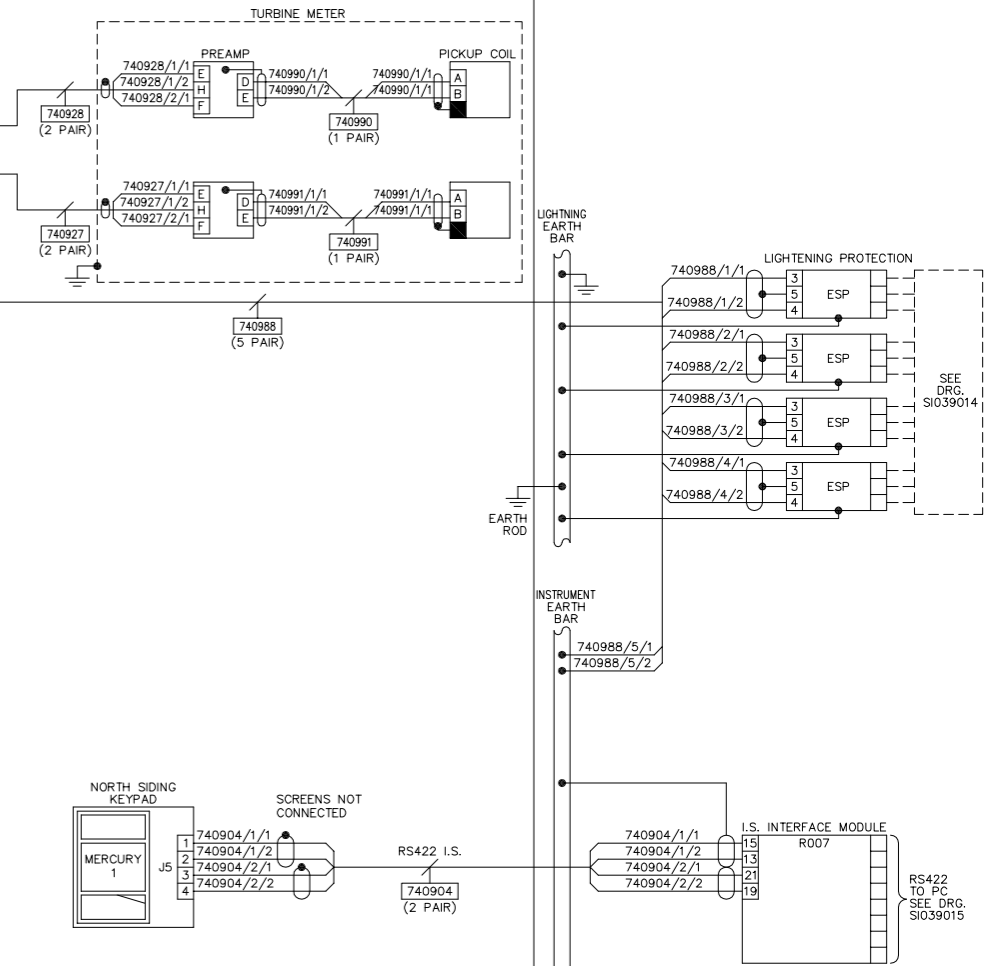

FLAMEPROOF & INCREASED SAFETY	CERTIFIED EQUIPMENT				CERTIFIED EQUIPMENT				
	REQUIRED	Achieved	TAG No.	CERTIFICATE No.	CERTIFICATION AUTHORITY	TAG No.	CERTIFICATE No.	CERTIFICATION AUTHORITY	
AREA CLASS ZONE 1	XXXX	FQ01	93C.105.11123	EExd IIB T6	BASEEFA	AC JB	84B3299X	EE'x'e' IIC T6	BASEEFA
GAS GROUP	IIB	TE01	831045X	EExd IIC T6	BASEEFA				
TEMPERATURE CLASS	PI	FT01	86B1336	EExd IIC T6	BASEEFA				
	T3	DCV01A	TBA	TBA	TBA				
		DCV01B	TBA	TBA	TBA				
		DC JB	84B3299X	EE'x'e' IIC T6	BASEEFA				

**NOTES**

1. ALL SCREENS NOT SHOWN FOR CLARITY

2. FOR COMMUNICATION INTERCONNECTIONS SEE DRAWING SIO39014

REV	DATE	BY	DRN	CHK'D	APP'D	DESCRIPTION
A	08/04/99	A.J.H.	A.J.H.	D.R.R.	D.R.R.	ORIGINAL ISSUE
B	02/07/99	D.P.	A.J.H.	D.R.R.	D.R.R.	GENERAL UPDATE
C	29/06/00	D.P.	A.B.	D.R.R.	D.R.R.	ON SITE CHANGES


PLANT	FINA DERV RAIL LOADING SYSTEM
TITLE	NORTH SIDING BATCHING SYSTEM LOOP
DATE	29/06/00
CLIENT DRG. No.	P&I DRG No. SIO39010

IMMINGHAM STORAGE Co Ltd, IMMINGHAM EAST TERMINAL, IMMINGHAM DOCK, IMMINGHAM, SOUTH HUMBERSIDE

INSTRUMENT LOOP SHEET FOR USE IN HAZARDOUS AREA

SHEET 01 OF 01

P & I DESIGN

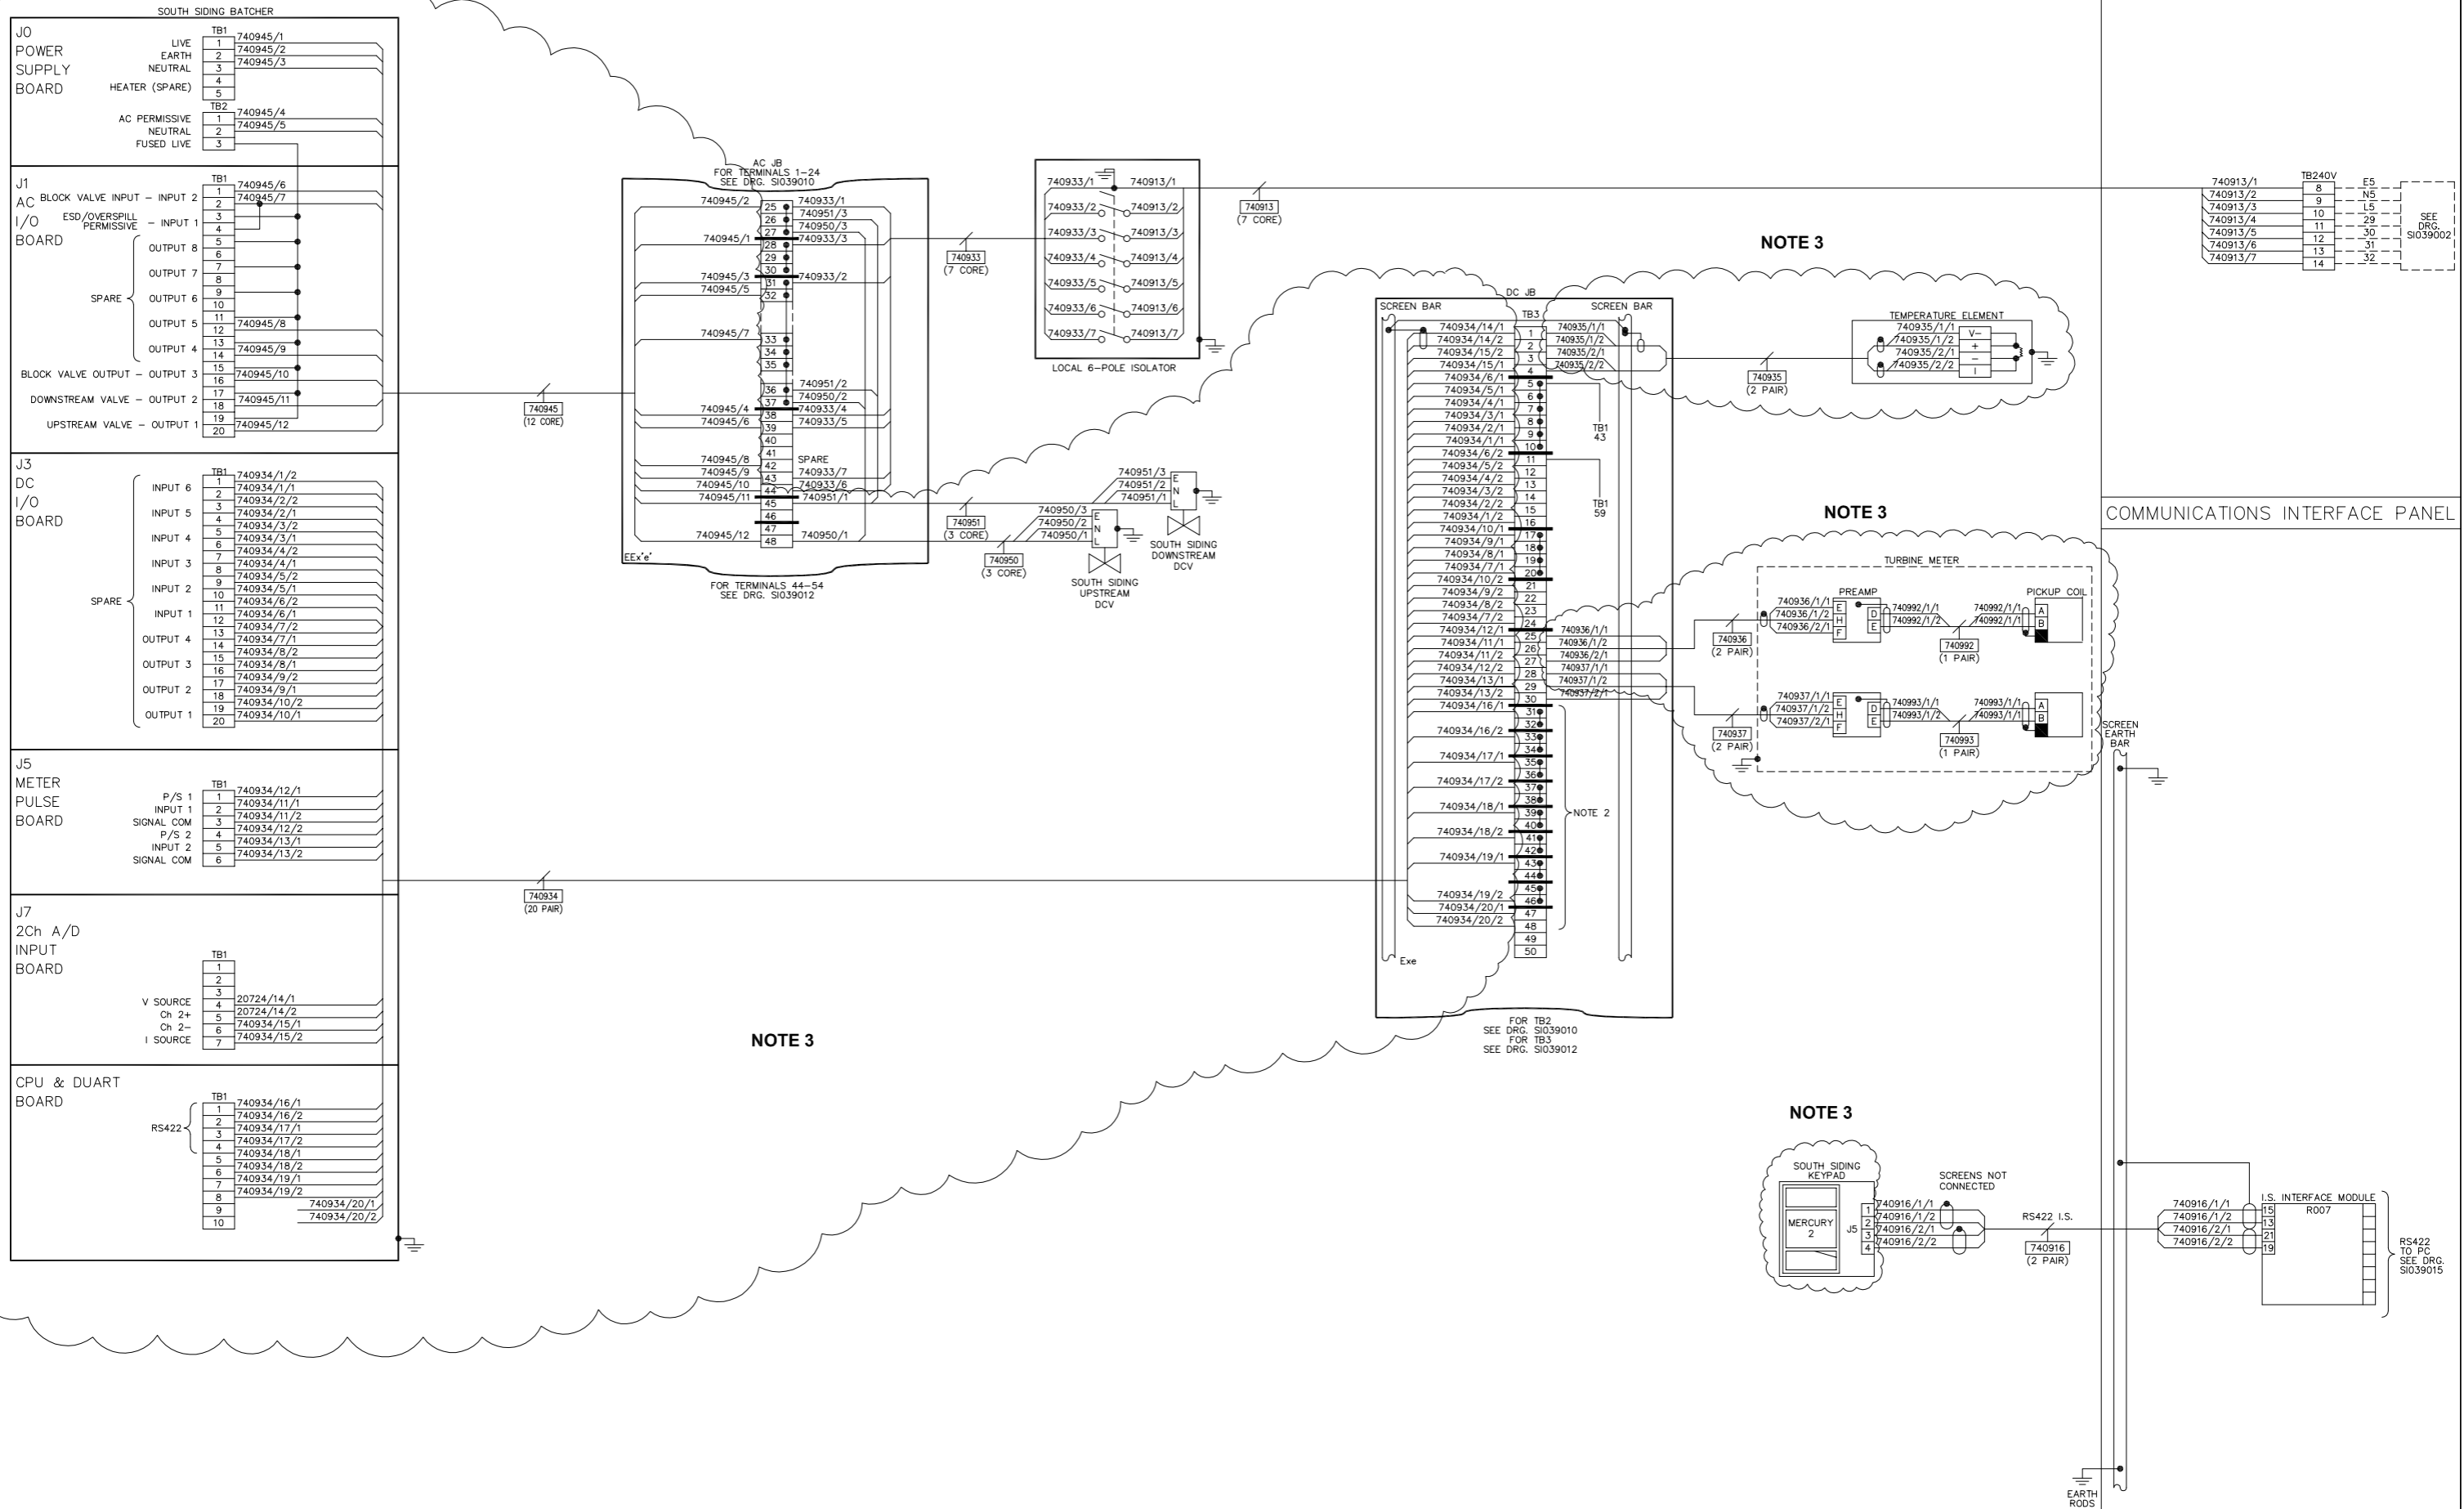

NOTE 3

NOTE 3

NOTE 3

NOTE 3

- NOTES
1. ALL SCREENS NOT SHOWN FOR CLARITY.
  2. FOR COMMUNICATION INTERCONNECTIONS SEE DRAWING SI039014.
  3. DECOMMISSIONED BATCHING SYSTEM. FIELD EQUIPMENT REMOVED.



IF NOT SIGNED THIS DOCUMENT IS UNCONTROLLED






REV	DATE	BY	DRN	CHK'D	APP'D	DESCRIPTION
A	08/04/99	A.J.H.	A.J.H.	D.R.R.	D.R.R.	ORIGINAL ISSUE
B	02/07/99	D.P.	A.J.H.	D.R.R.	D.R.R.	GENERAL UPDATE
C	29/06/00	D.P.	A.B.	D.R.R.	D.R.R.	ON SITE CHANGES
D	14/09/10	D.B.F.	P.P.	M.M.	M.M.	SI760 MODIFICATIONS

PLANT	IMMINGHAM STORAGE Co. - EAST TERMINAL
TITLE	4-EAST RAIL LOADING SYSTEM SOUTH SIDING BATCHING SYSTEM LOOP
CLIENT DRG. No.	P&I DRG No. SI039011_DWG


SAFETY PROTECTION	FLAMEPROOF & INCREASED SAFETY		CERTIFIED EQUIPMENT				CERTIFIED EQUIPMENT			
	REQUIRED	ACHIEVED	TAG No.	CERTIFICATE No.	CERTIFICATION AUTHORITY	TAG No.	CERTIFICATE No.	CERTIFICATION AUTHORITY		
AREA CLASS	ZONE 1	XXXX	FQ01	93C105.11123	EExd IIB T6	BASEEFA	AC JB	84B3299X	EE'x' IIC T6	BASEEFA
GAS GROUP	IIB	XXXX	TE01	831045X	EExd IIC T6	BASEEFA				
TEMPERATURE CLASS	T3	XXXX	FT01	86B1336	EExd IIC T6	BASEEFA				
			DCV02A	TBA	TBA	TBA				
			DCV02B	TBA	TBA	TBA				
			DC JB	84B3299X	EE'x' IIC T6	BASEEFA				

FIELD

CONTROL PANEL

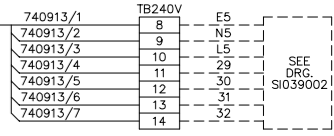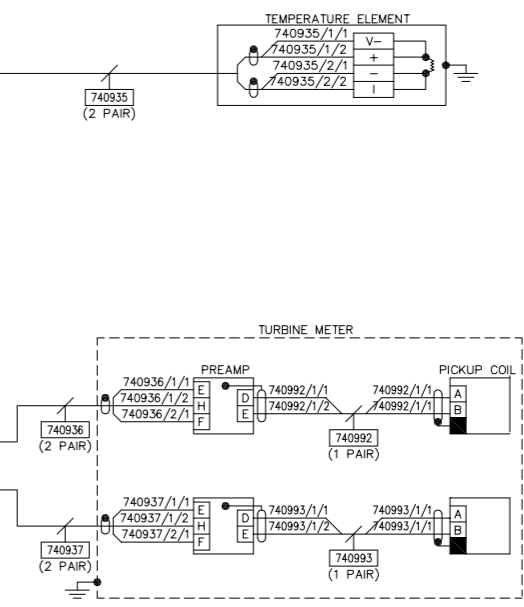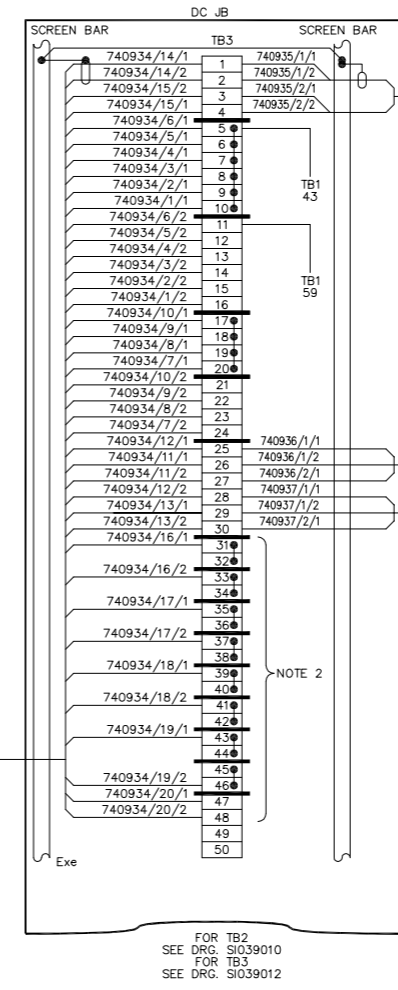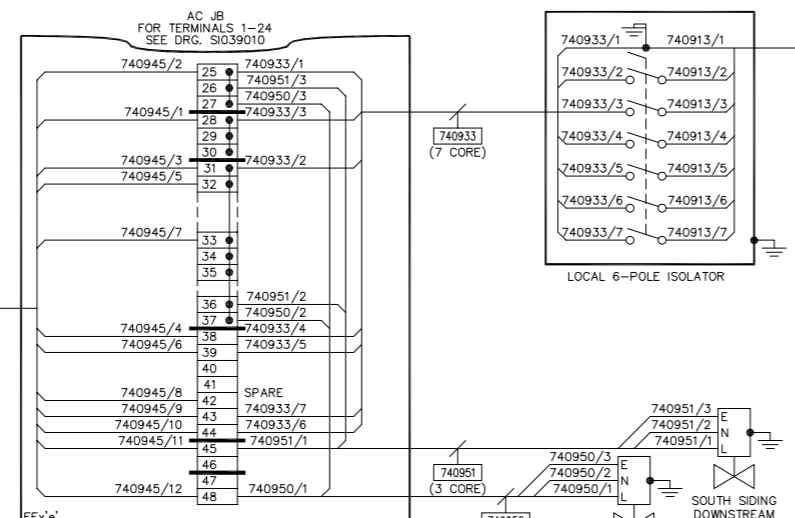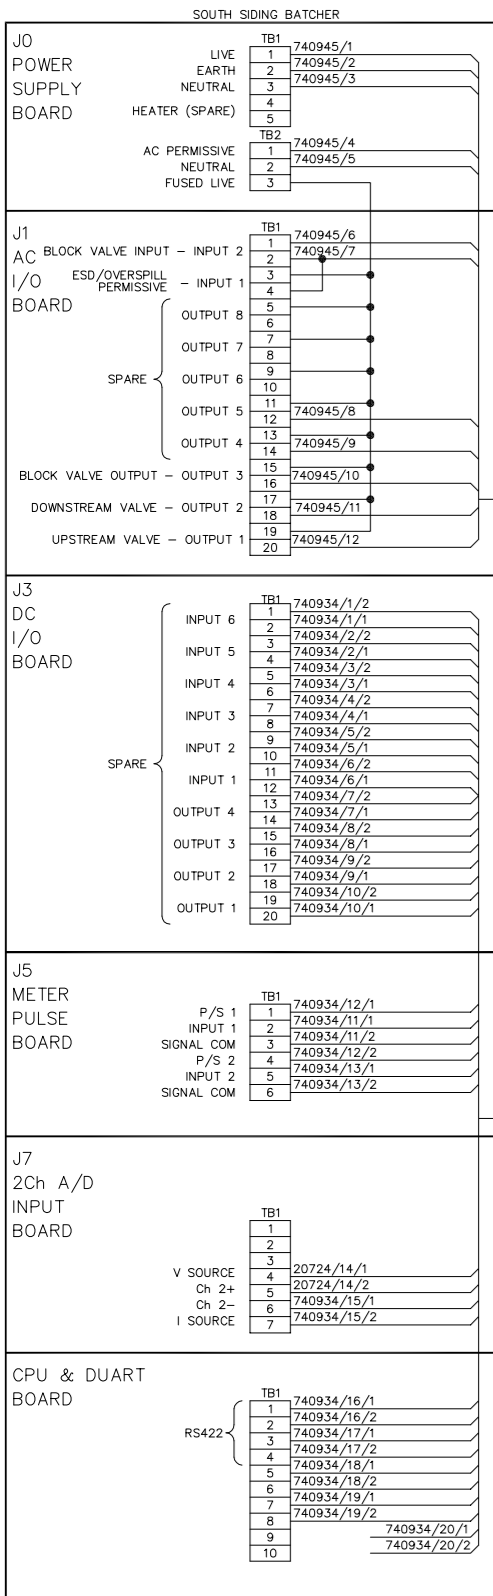

COMMUNICATIONS INTERFACE PANEL

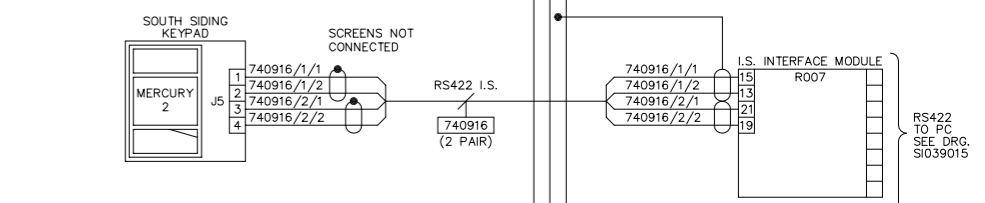


SAFETY PROTECTION	FLAMEPROOF & INCREASED SAFETY		CERTIFIED EQUIPMENT				CERTIFIED EQUIPMENT			
	REQUIRED	ACHIEVED	TAG No.	CERTIFICATE No.	CERTIFICATION	AUTHORITY	TAG No.	CERTIFICATE No.	CERTIFICATION	AUTHORITY
AREA CLASS	ZONE 1	XXXX	FQ01	93C.105.11123	EExd IIB T6	BASEEFA	AC JB	84B3299X	EEx'e' IIC T6	BASEEFA
GAS GROUP	IIB	XXXX	TE01	831045X	EExd IIC T6	BASEEFA				
TEMPERATURE CLASS	PI	XXXX	FT01	86B1336	EExd IIC T6	BASEEFA				
			DCV02A	TBA	TBA	TBA				
			DCV02B	TBA	TBA	TBA				
			DC JB	84B3299X	EEx'e' IIC T6	BASEEFA				

NOTES  
 1. ALL SCREENS NOT SHOWN FOR CLARITY  
 2. FOR COMMUNICATIONS INTERCONNECTIONS SEE DRAWING SI039014

REV	DATE	BY	DRN	CHK'D	APP'D	DESCRIPTION
A	08/04/99	A.J.H.	A.J.H.	P.J.P.	P.J.P.	D.R.R. ORIGINAL ISSUE
B	02/07/99	D.P.	A.J.H.	D.R.R.	D.R.R.	D.R.R. GENERAL UPDATE
C	29/06/00	D.P.	A.B.	D.R.R.	D.R.R.	D.R.R. ON SITE CHANGES

PLANT	FINA DERV RAIL LOADING SYSTEM
TITLE	SOUTH SIDING BATCHING SYSTEM LOOP
DATE	29/06/00
CLIENT DRG. No.	P&I DRG No. SI039011

INSTRUMENT LOOP SHEET FOR USE IN HAZARDOUS AREA  
 SHEET 01 OF 01

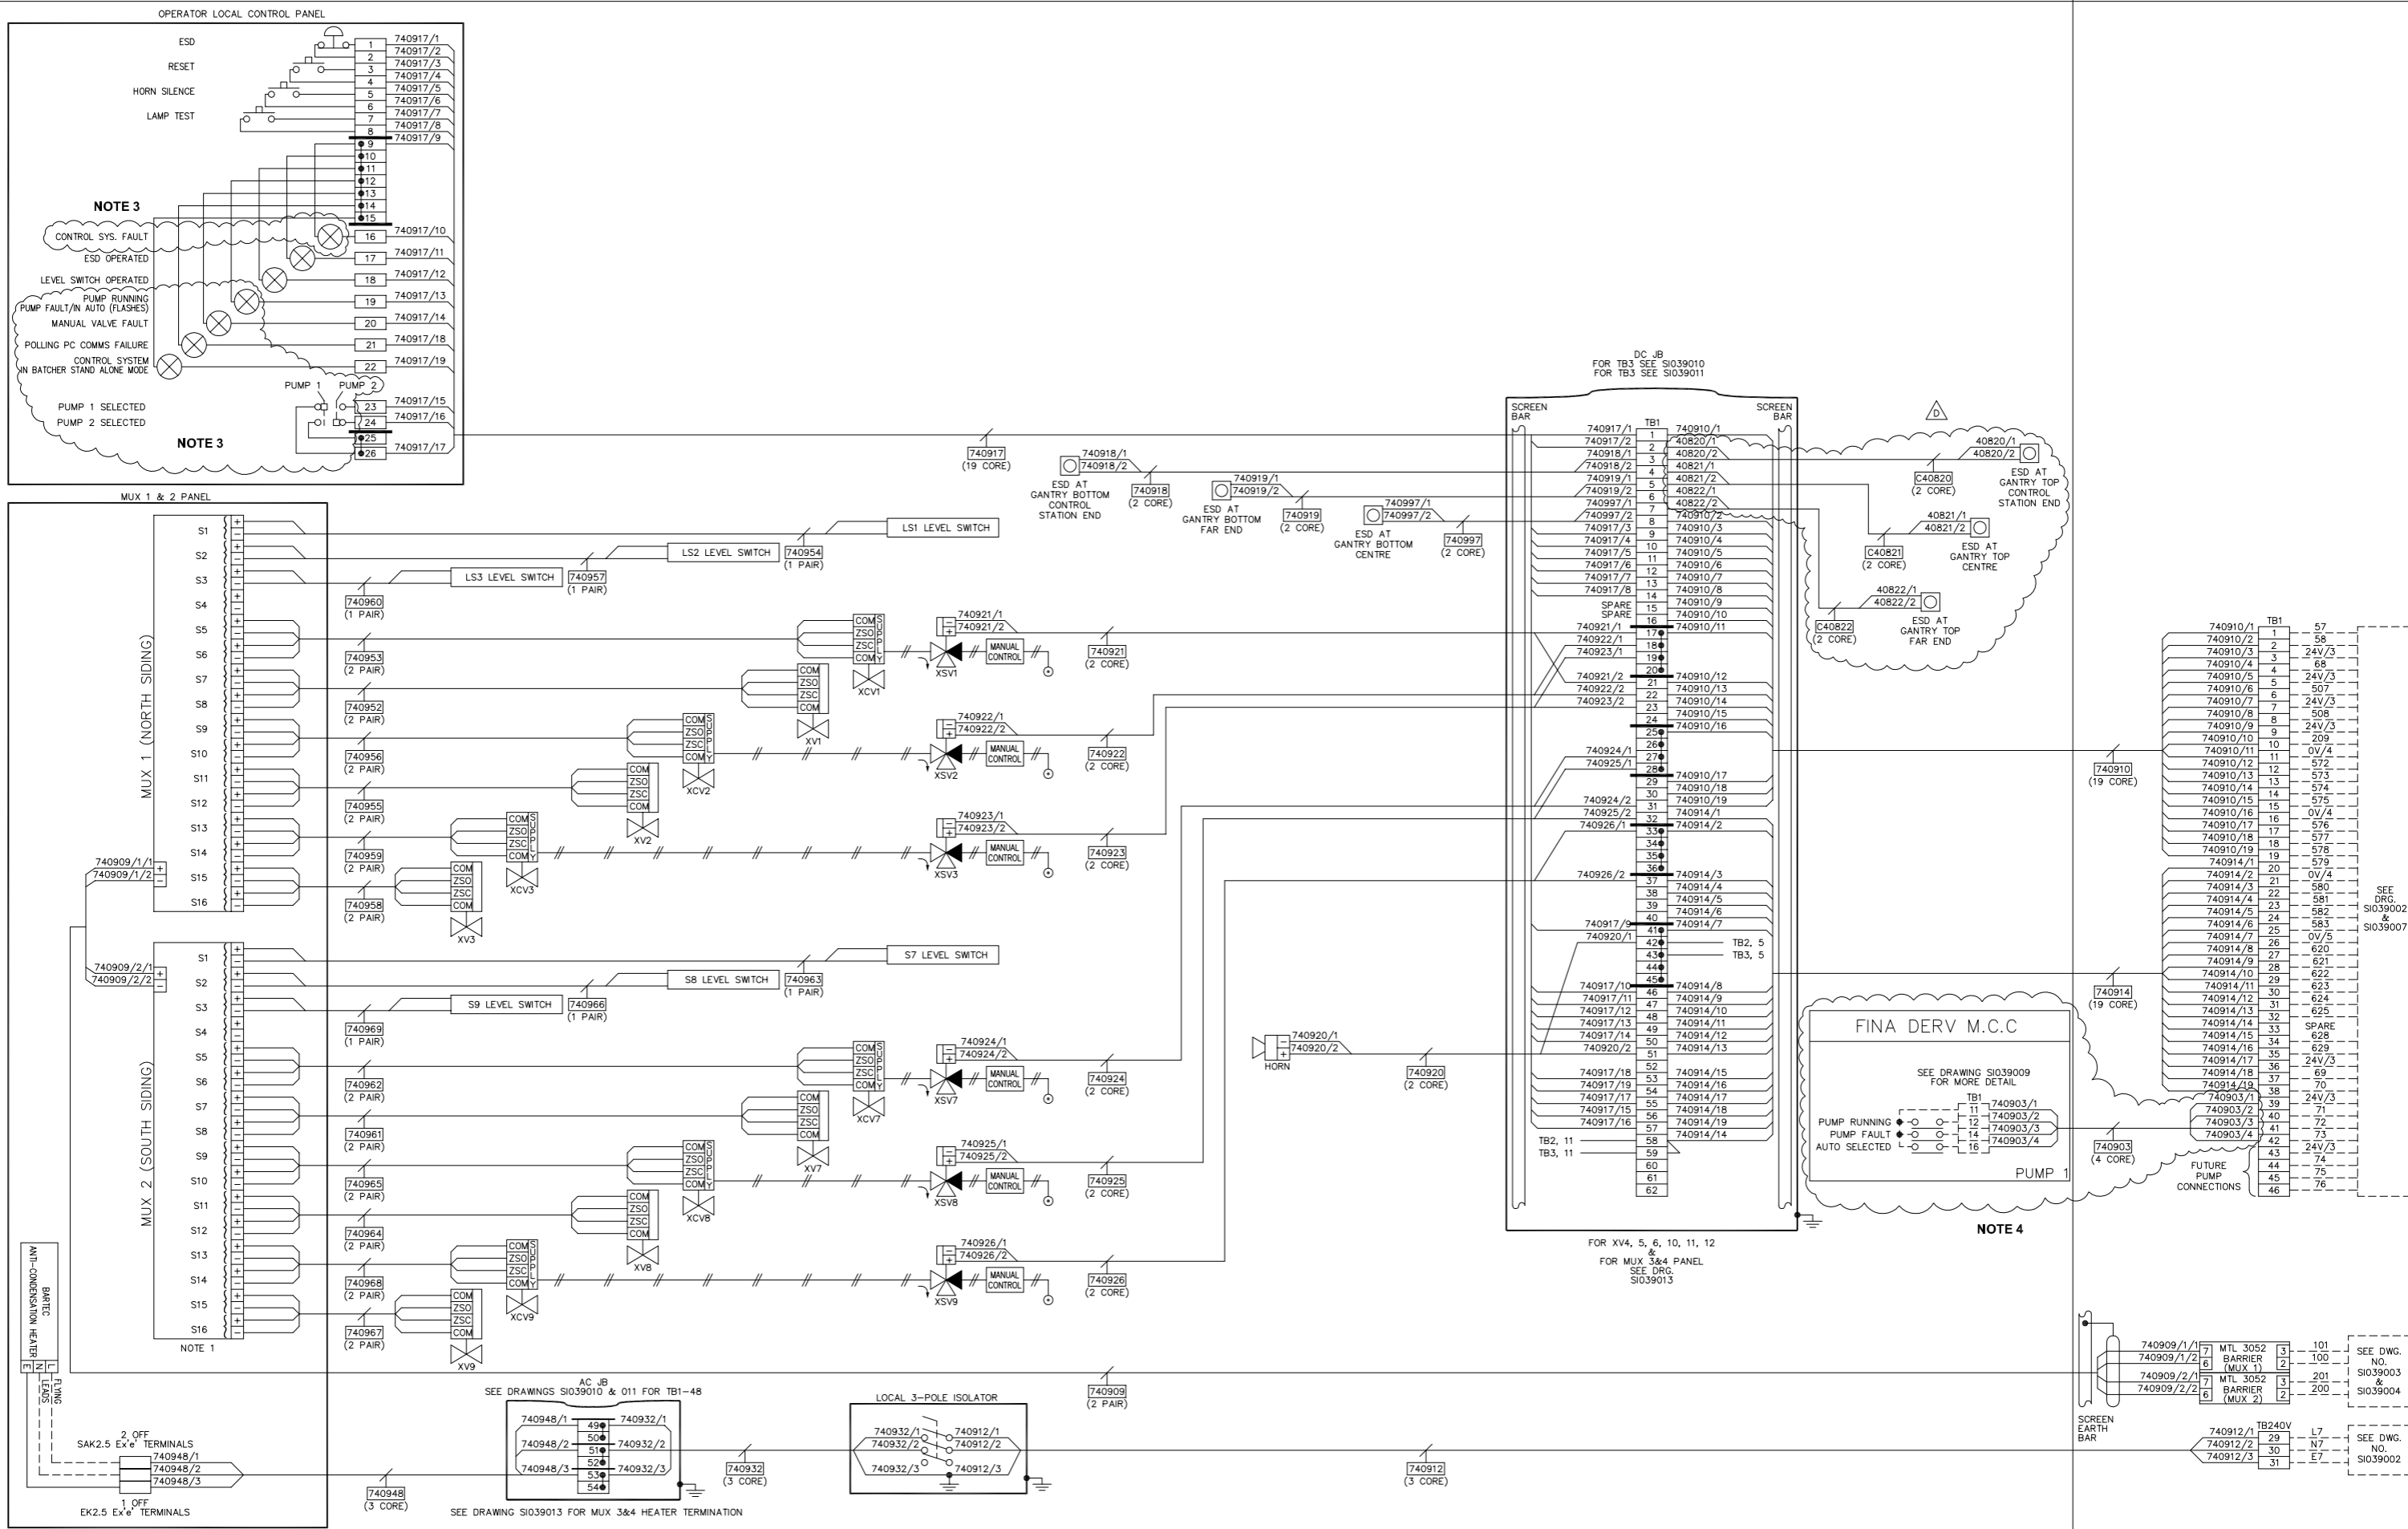

DC JB  
FOR TB3 SEE SIO39010  
FOR TB3 SEE SIO39011

FINA DERV M.C.C  
SEE DRAWING SIO39009  
FOR MORE DETAIL

NOTE 4

FOR XV4, 5, 6, 10, 11, 12  
FOR MUX 3&4 PANEL  
SEE DRG.  
SIO39013

AC JB  
SEE DRAWINGS SIO39010 & 011 FOR TB1-48

SEE DRAWING SIO39013 FOR MUX 3&4 HEATER TERMINATION

SEE DRAWING SIO39003 & 4 FOR MORE DETAIL

SAFETY PROTECTION REQUIRED ZONE 1	FLAMEPROOF & INCREASED SAFETY	CERTIFIED EQUIPMENT			CERTIFIED EQUIPMENT		
	ACHIEVED XXXX	TAG No.	CERTIFICATE No.	CERTIFICATION AUTHORITY	TAG No.	CERTIFICATE No.	CERTIFICATION AUTHORITY
GAS GROUP IIB	XXXX						
TEMPERATURE CLASS T3	PI XXXX						

- NOTES
1. ALL SCREENS NOT SHOWN FOR CLARITY.
  2. FOR COMMUNICATION INTERCONNECTIONS SEE DRAWING SIO39014.
  3. LAMPS, SELECTOR SWITCH & ASSOCIATED WIRING HIGHLIGHTED TO BE REMOVED FROM THE LOCAL CONTROL PANEL & THE HOLES BLANKED.
  4. DECOMMISSIONED BATCHING SYSTEM.







IF NOT SIGNED THIS DOCUMENT IS UNCONTROLLED

REV	DATE	BY	DRN	CHK'D	APP'D	DESCRIPTION
A	08/04/99	A.J.H.	A.J.H.	D.R.R.	D.R.R.	ORIGINAL ISSUE
B	15/04/99	A.J.H.	A.J.H.	D.R.R.	D.R.R.	MUX BOX UPDATED
C	02/07/99	D.P.	A.J.H.	D.R.R.	D.R.R.	GENERAL UPDATE
D	14/09/10	D.B.F.	P.P.	M.M.	M.M.	SI760 MODIFICATIONS

PLANT	IMMINGHAM STORAGE Co. - EAST TERMINAL
TITLE	4-EAST RAIL LOADING SYSTEM MUX 1 & 2 PANEL LOOP
CLIENT DRG. No.	P&I DRG. No. SIO39012_DWG

SHEET 1 OF 1  
P&I DESIGN Ltd  
Tel. 01642 617444  
www.pidedesign.co.uk

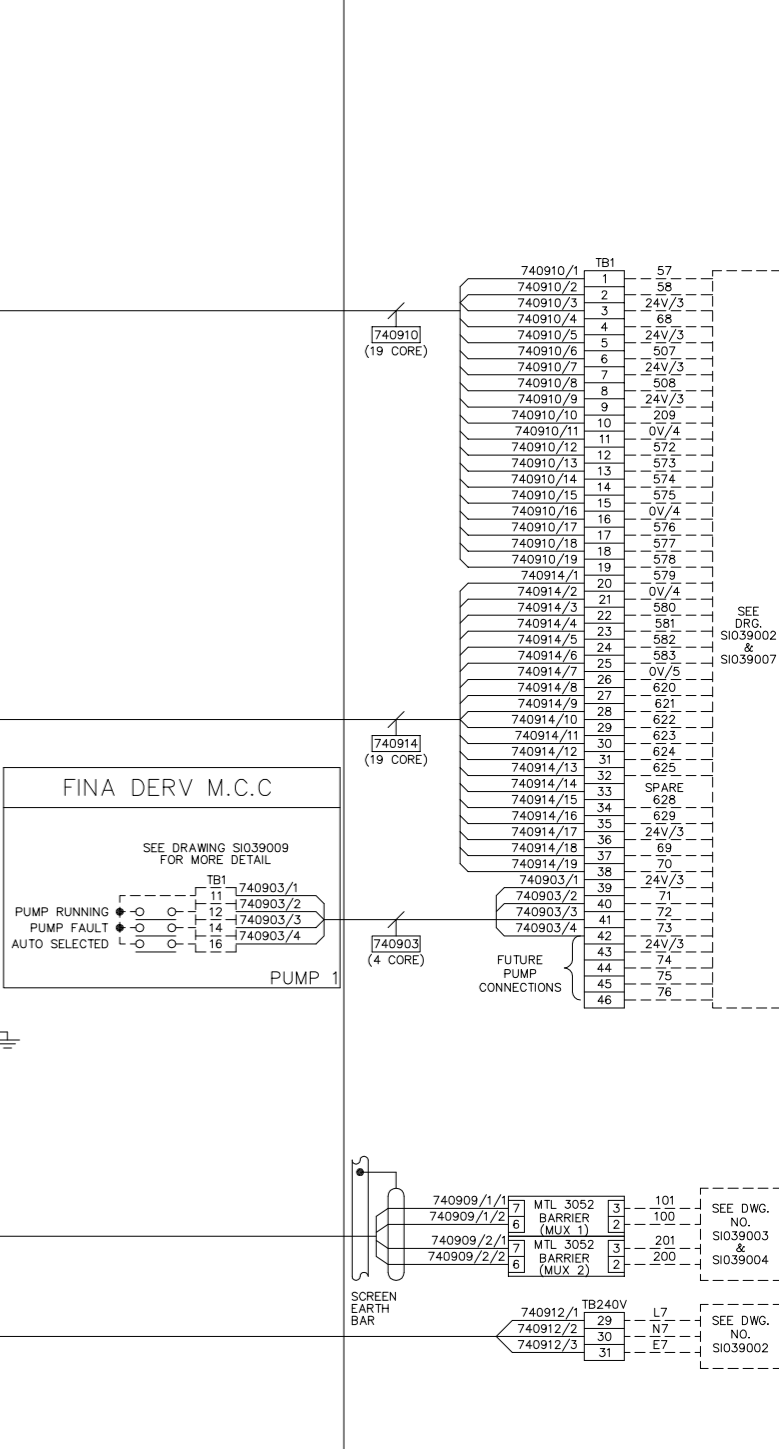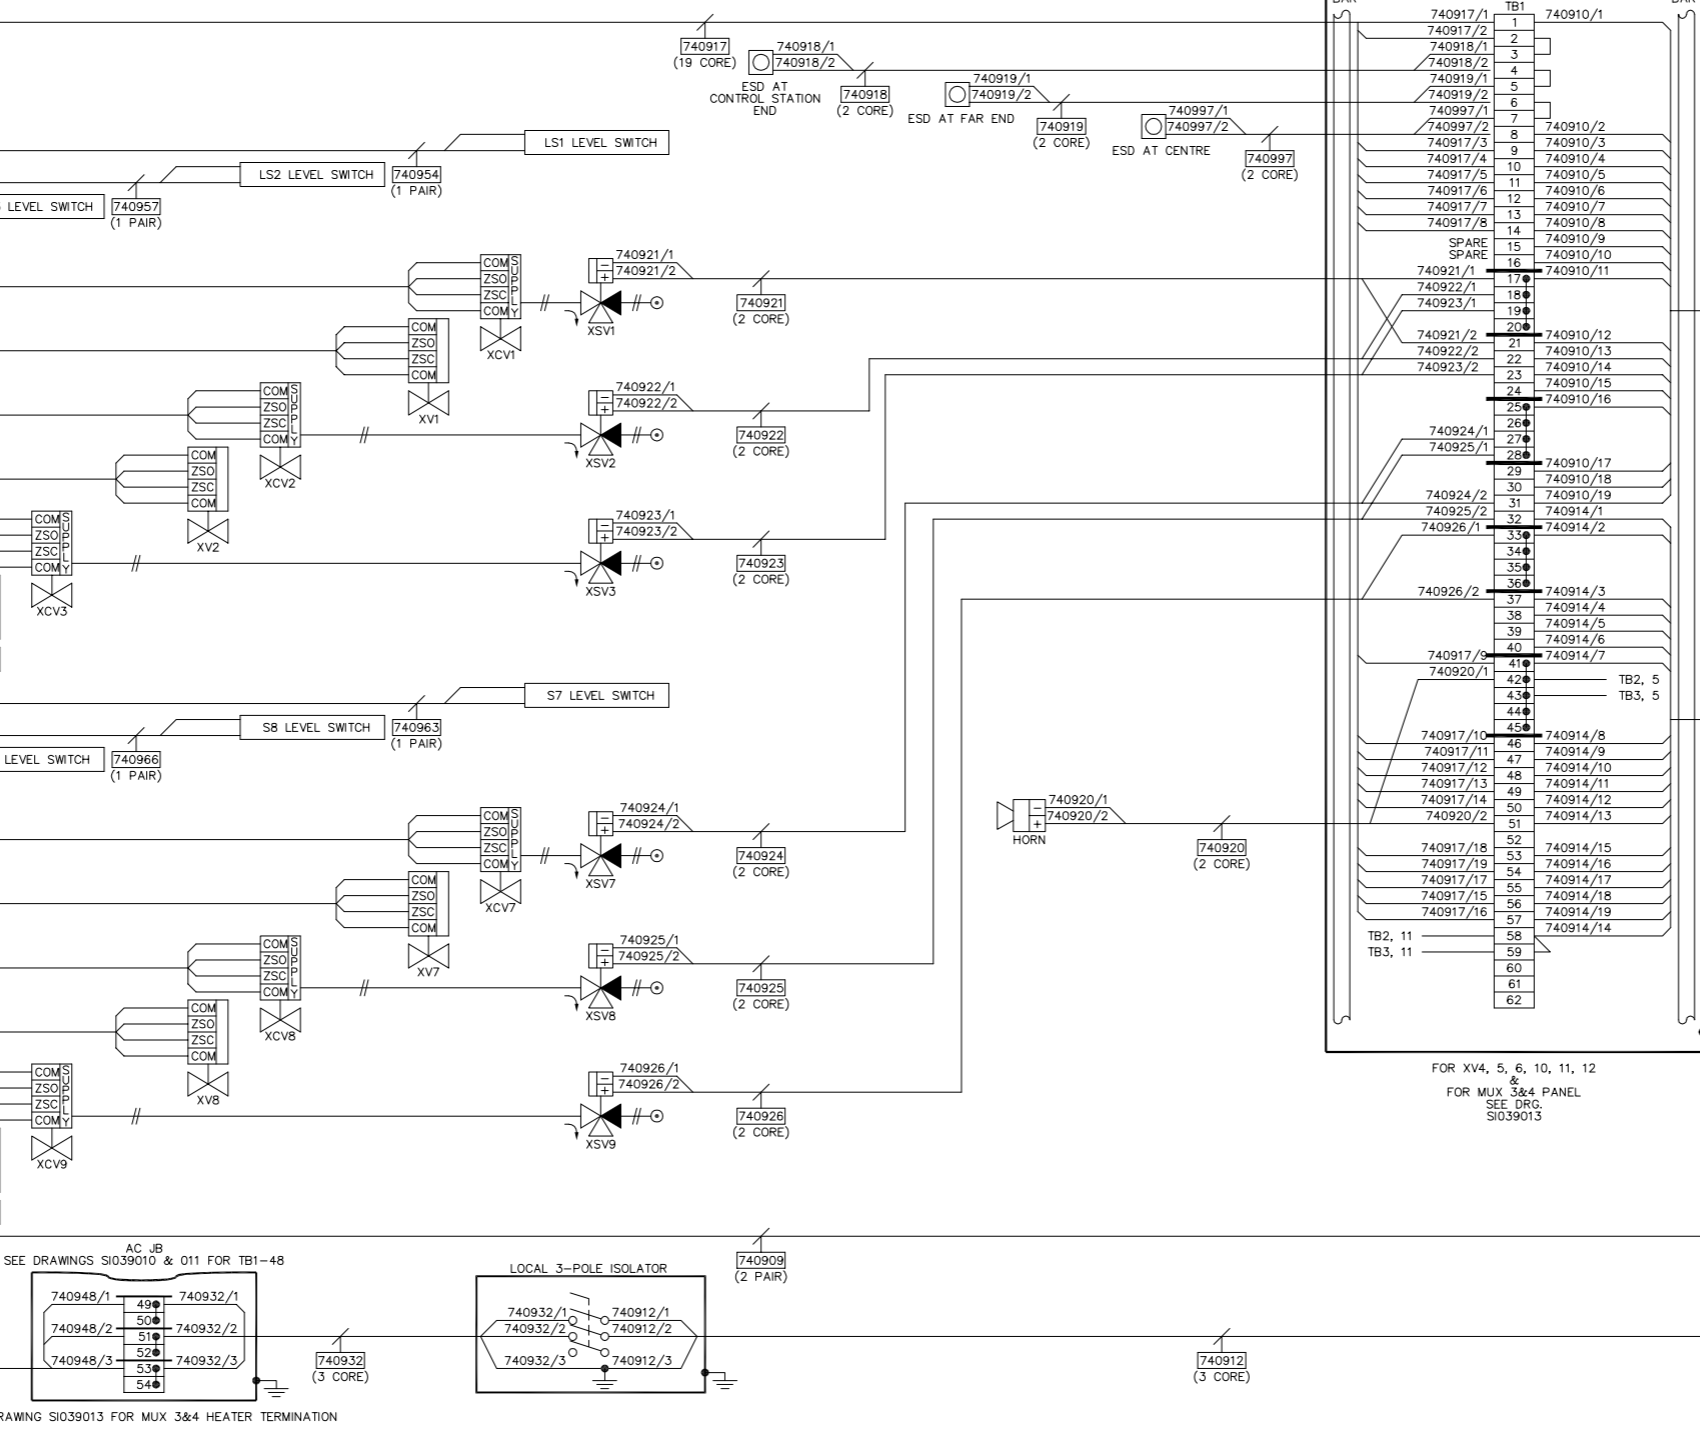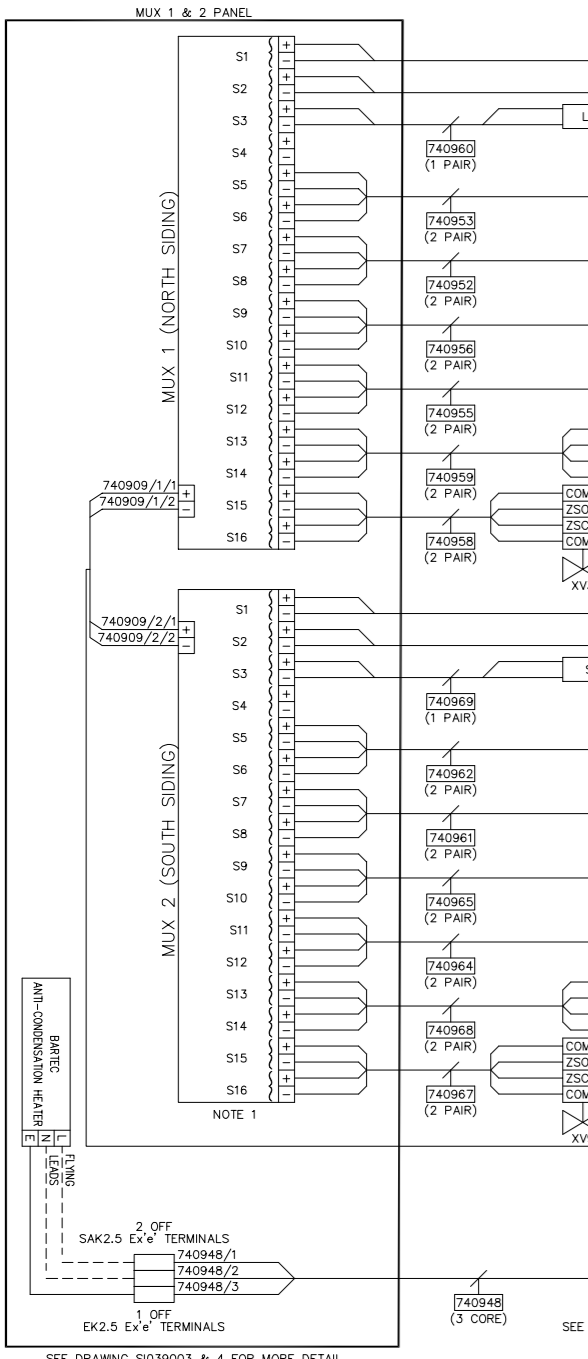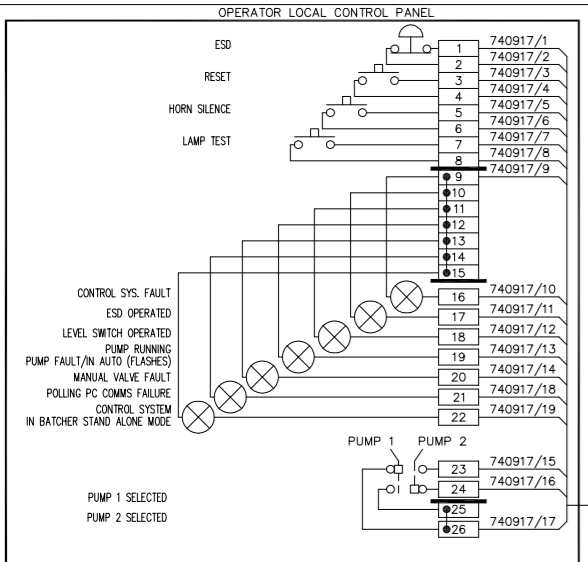


FLAMEPROOF & SAFETY PROTECTION INCREASED SAFETY	CERTIFIED EQUIPMENT	CERTIFIED EQUIPMENT
REQUIRED	Achieved	Achieved
AREA CLASS	ZONE 1	XXXX
GAS GROUP	IIB	XXXX
TEMPERATURE CLASS	T3	XXXX

REV	DATE	BY	DRN	CHK'D	APP'D	DESCRIPTION
A	08/04/99	A.J.H.	A.J.H.	D.R.R.	D.R.R.	ORIGINAL ISSUE
B	15/04/99	A.J.H.	A.J.H.	D.R.R.	D.R.R.	MUX_BOX UPDATED
C	02/07/99	D.P.	A.J.H.	D.R.R.	D.R.R.	GENERAL UPDATE

PLANT	FINA DERV RAIL LOADING SYSTEM
TITLE	MUX 1 & 2 PANEL LOOP
DATE	02/07/99
<b>Simon Storage</b> IMMINGHAM STORAGE Co Ltd, IMMINGHAM EAST TERMINAL, IMMINGHAM DOCK, IMMINGHAM, SOUTH HUMBERSIDE	<b>P &amp; I DESIGN</b> INSTRUMENT LOOP SHEET FOR USE IN HAZARDOUS AREA CLIENT DRG. No. P&I DRG No. SI039012
SHEET	01 OF 01

NOTES  
 1. ALL SCREENS NOT SHOWN FOR CLARITY  
 2. FOR COMMUNICATIONS INTERCONNECTIONS SEE DRAWING SI039014

SEE DWG. NO. SI039003 & SI039004  
 SEE DWG. NO. SI039002

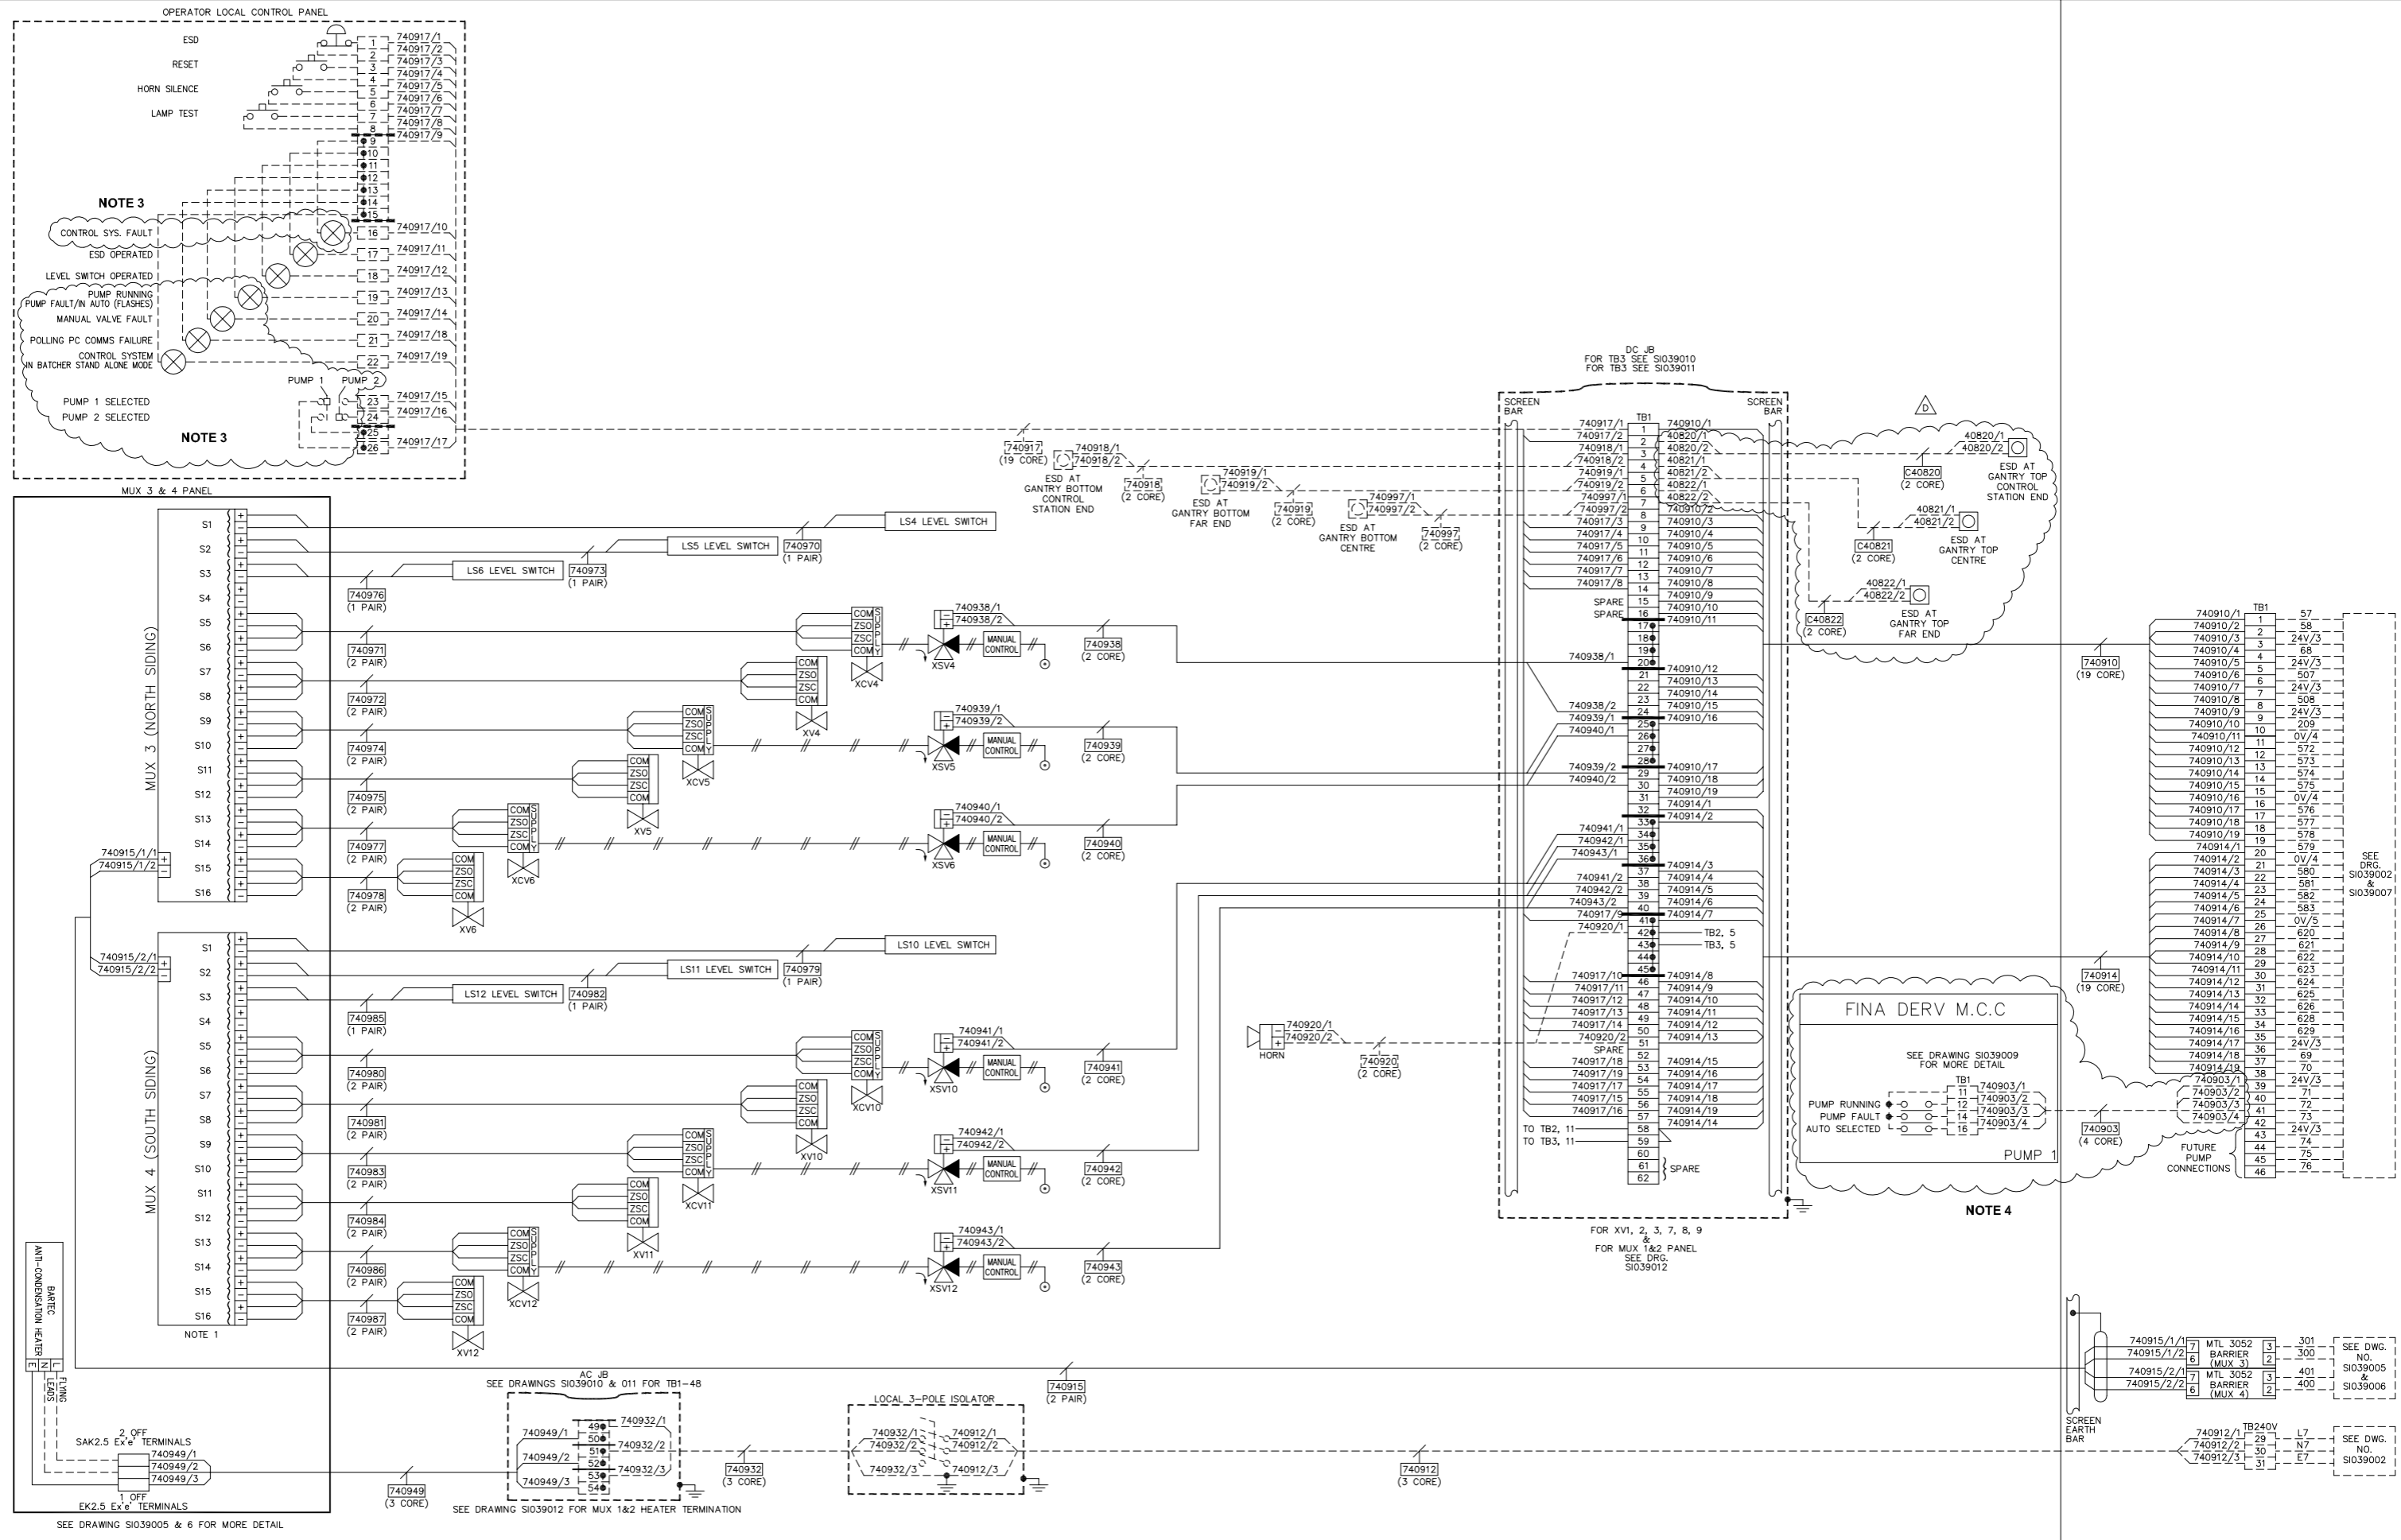

SAFETY PROTECTION REQUIRED	FLAMEPROOF & INCREASED SAFETY	CERTIFIED EQUIPMENT				CERTIFIED EQUIPMENT				
	ACHIEVED	TAG No.	CERTIFICATE No.	CERTIFICATION AUTHORITY	TAG No.	CERTIFICATE No.	CERTIFICATION AUTHORITY	TAG No.	CERTIFICATE No.	CERTIFICATION AUTHORITY
AREA CLASS	ZONE 1	XXXX								
GAS GROUP	IIB	XXXX								
TEMPERATURE CLASS	T3	XXXX								

- NOTES**
- ALL SCREENS NOT SHOWN FOR CLARITY.
  - FOR COMMUNICATION INTERCONNECTIONS SEE DRAWING SI039014.
  - LAMPS, SELECTOR SWITCH & ASSOCIATED WIRING HIGHLIGHTED TO BE REMOVED FROM THE LOCAL CONTROL PANEL & THE HOLES BLANKED.
  - DECOMMISSIONED BATCHING SYSTEM.




IF NOT SIGNED THIS DOCUMENT IS UNCONTROLLED

REV	DATE	BY	DRN	CHK'D	APP'D	DESCRIPTION
A	08/04/99	A.J.H.	A.J.H.	D.R.R.	D.R.R.	ORIGINAL ISSUE
B	15/04/99	A.J.H.	A.J.H.	D.R.R.	D.R.R.	MUX BOX UPDATED
C	02/07/99	D.P.	A.J.H.	D.R.R.	D.R.R.	GENERAL UPDATE
D	14/09/10	D.B.F.	P.P.	M.M.	M.M.	SI760 MODIFICATIONS


PLANT	IMMINGHAM STORAGE Co. - EAST TERMINAL
TITLE	4-EAST RAIL LOADING SYSTEM MUX 3 & 4 PANEL LOOP
CLIENT DRG. No.	IMMINGHAM STORAGE Co. Ltd. IMMINGHAM EAST TERMINAL, IMMINGHAM, SOUTH HUMBERSIDE
	P & I DESIGN Ltd. Tel: 01642 617444 www.pidesign.co.uk

SHEET 1 OF 1  
P&I DRG No. SI039013\_DWG



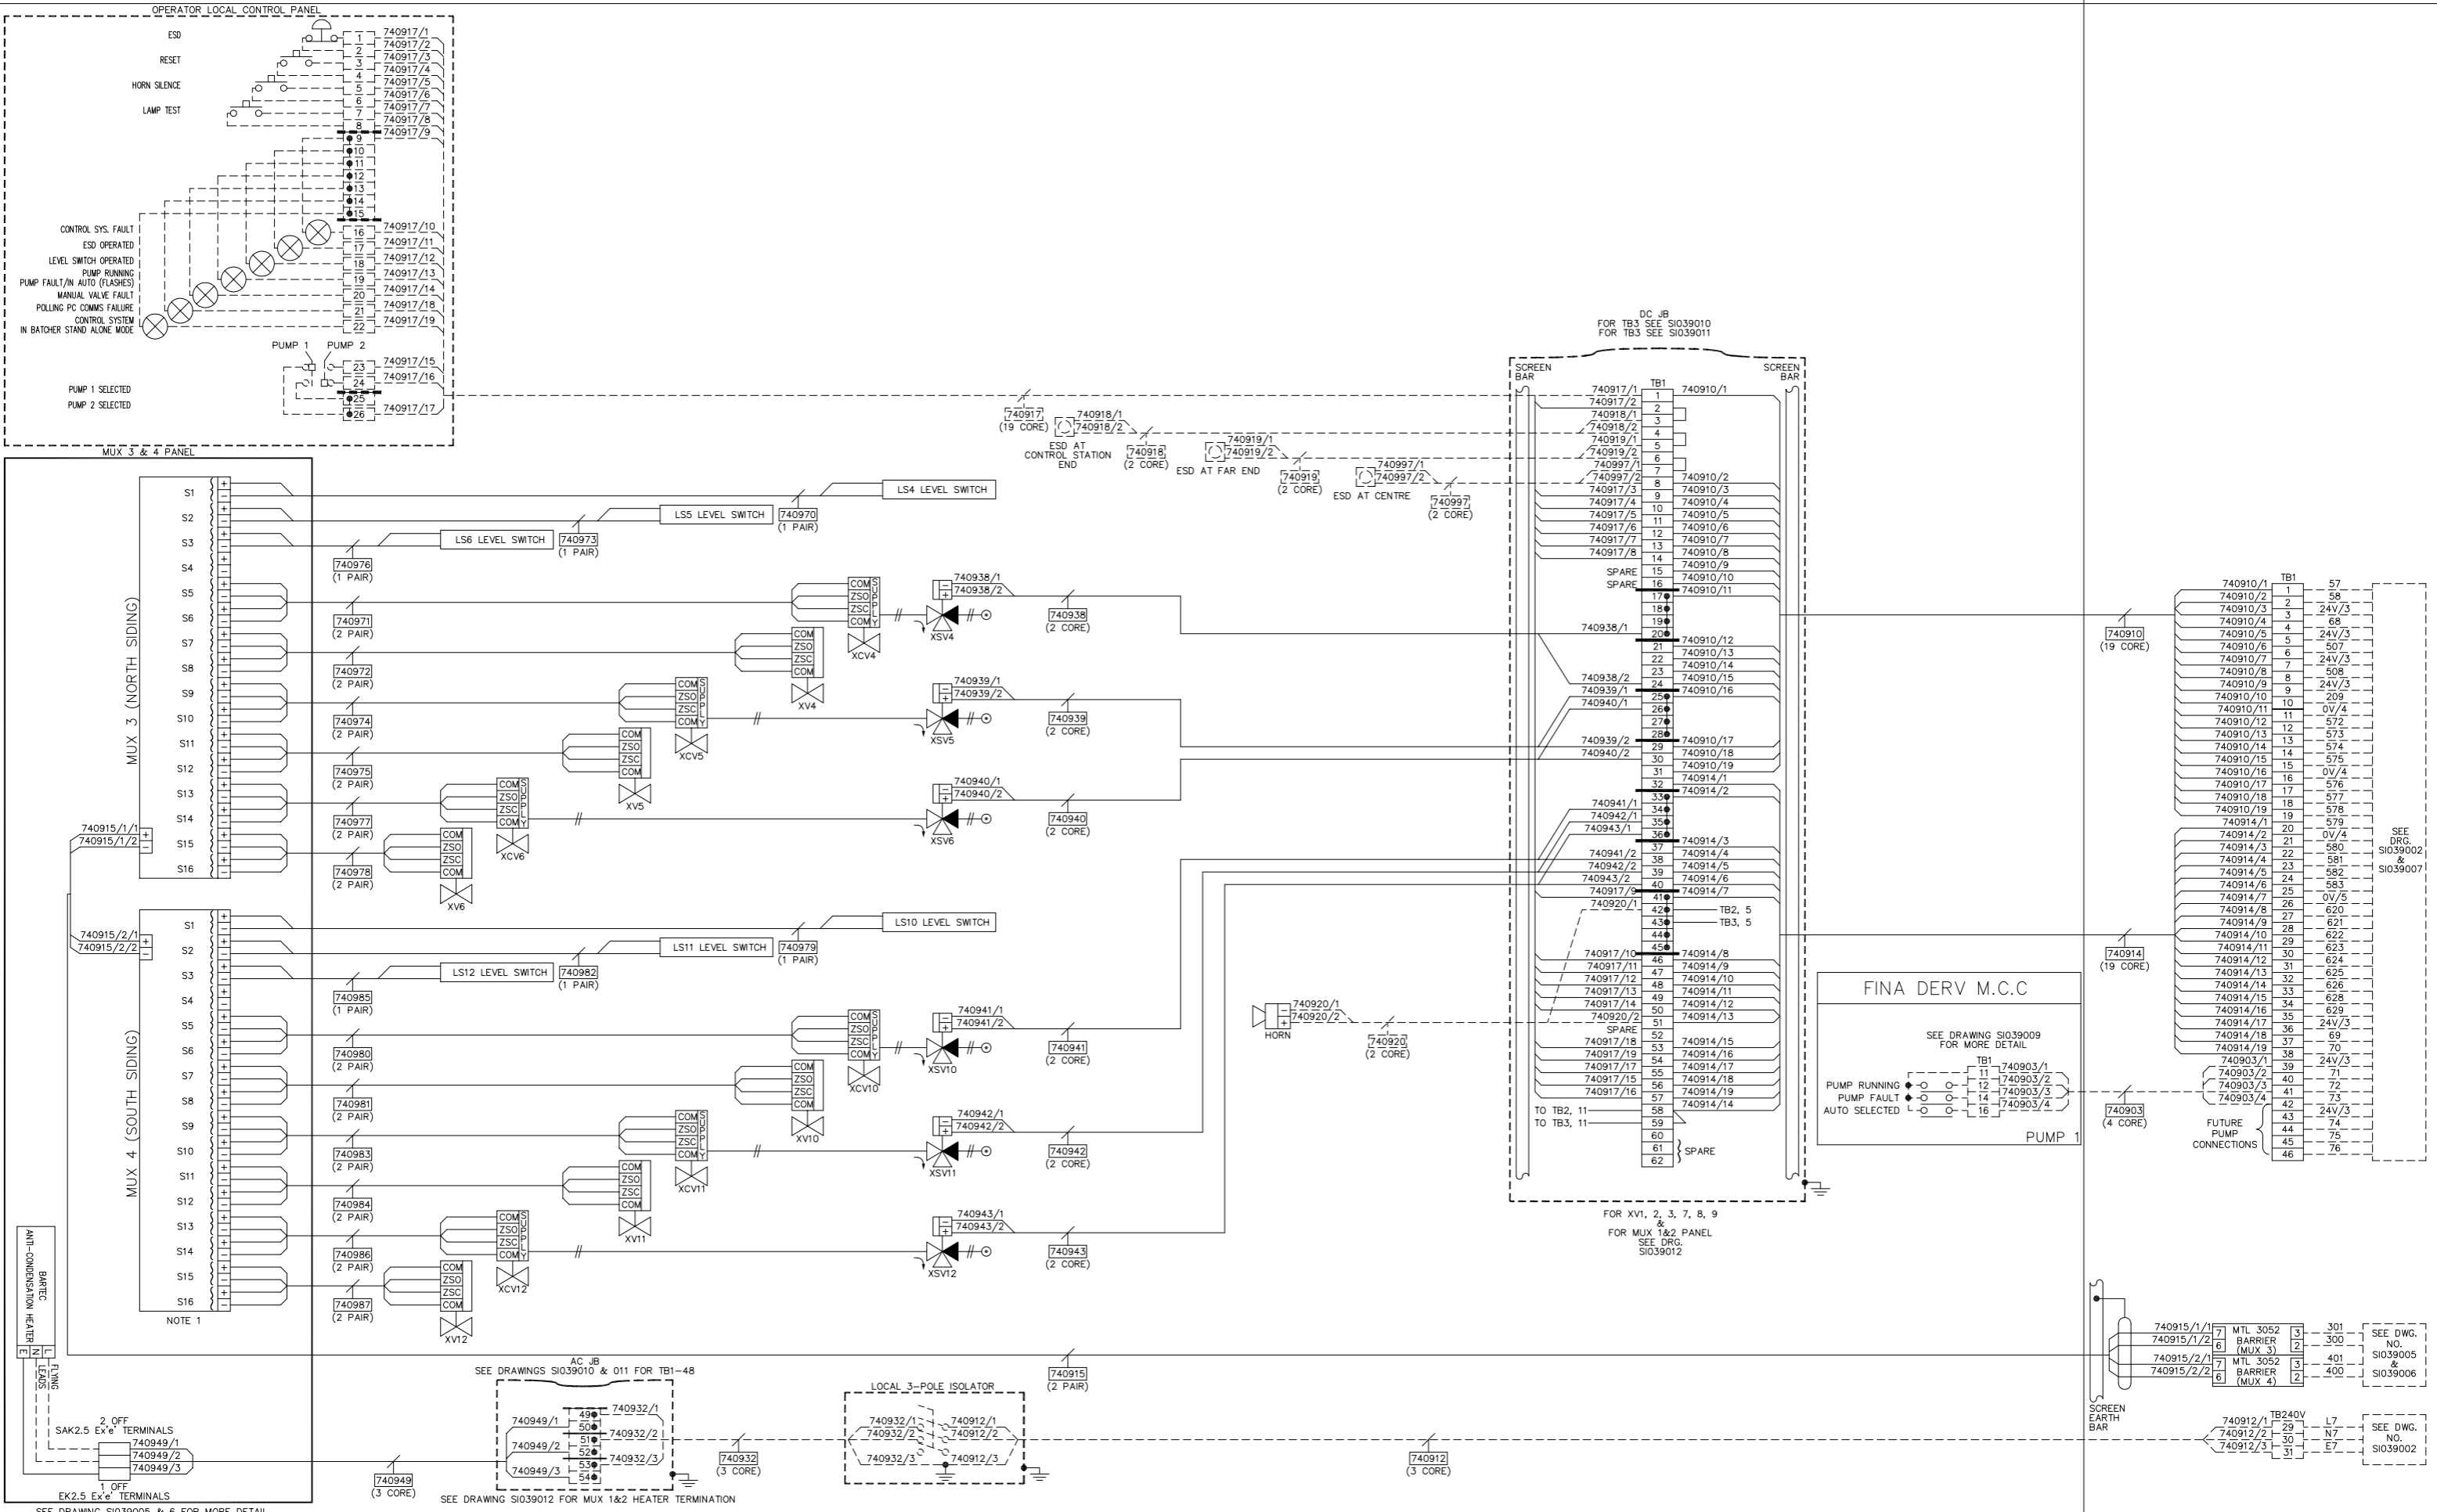

SEE DRAWING SIO39005 & 6 FOR MORE DETAIL



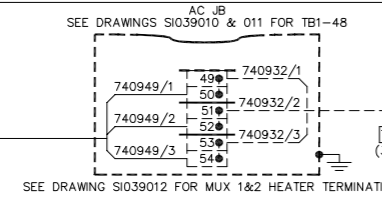


FLAMEPROOF & SAFETY PROTECTION INCREASED SAFETY	REQUIRED	Achieved	XXXX
AREA CLASS	ZONE 1		XXXX
GAS GROUP	IIB		XXXX
TEMPERATURE CLASS	T3		XXXX

CERTIFIED EQUIPMENT				CERTIFIED EQUIPMENT			
TAG No.	CERTIFICATE No.	CERTIFICATION AUTHORITY		TAG No.	CERTIFICATE No.	CERTIFICATION AUTHORITY	

NOTES  
 1. ALL SCREENS NOT SHOWN FOR CLARITY  
 2. FOR COMMUNICATIONS INTERCONNECTIONS SEE DRAWING SIO39014

DC JB  
 FOR TB3 SEE SIO39010  
 FOR TB3 SEE SIO39011

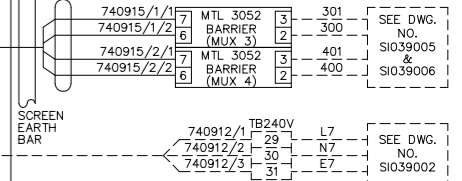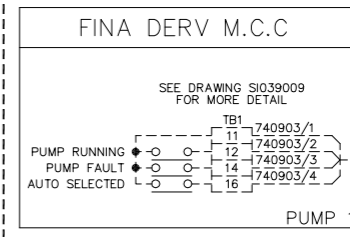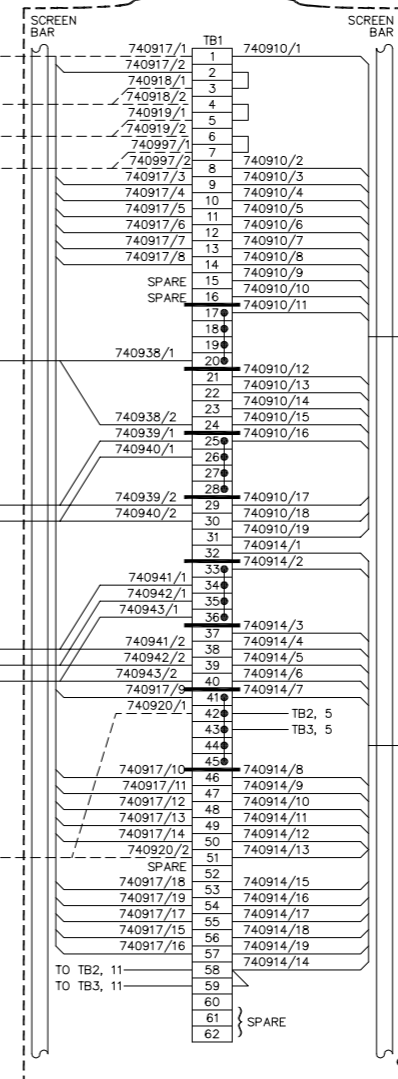

PLANT	FINA DERV RAIL OFFLOADING SYSTEM
TITLE	MUX 3 & 4 PANEL LOOP
DATE	02/07/99
CLIENT DRG. No.	P&I DRG No. SIO39013

FOR XVI, 2, 3, 7, 8, 9  
 &  
 FOR MUX 1&2 PANEL  
 SEE DRG. SIO39012

SEE DRG. SIO39002 & SIO39007

SEE DWG. NO. SIO39005 & SIO39006

SEE DWG. NO. SIO39002

Simon Storage Terminals  
 INSTRUMENT LOOP SHEET FOR USE IN HAZARDOUS AREA  
 SHEET 01 OF 01  
 P & I DESIGN

REV	DATE	BY	DRN	CHK'D	APP'D	DESCRIPTION
A	08/04/99	A.J.H.	A.J.H.	D.R.R.	D.R.R.	ORIGINAL ISSUE
B	15/04/99	A.J.H.	A.J.H.	D.R.R.	D.R.R.	MUX_BOX UPDATED
C	02/07/99	D.P.	A.J.H.	D.R.R.	D.R.R.	GENERAL UPDATE

RAIL LOADING SIDING


COMMUNICATIONS INTERFACE PANEL

DANLOAD 6000

DC JUNCTION BOX

LINE TERMINATION CABINET

PROTOCOL MANAGEMENT UNIT

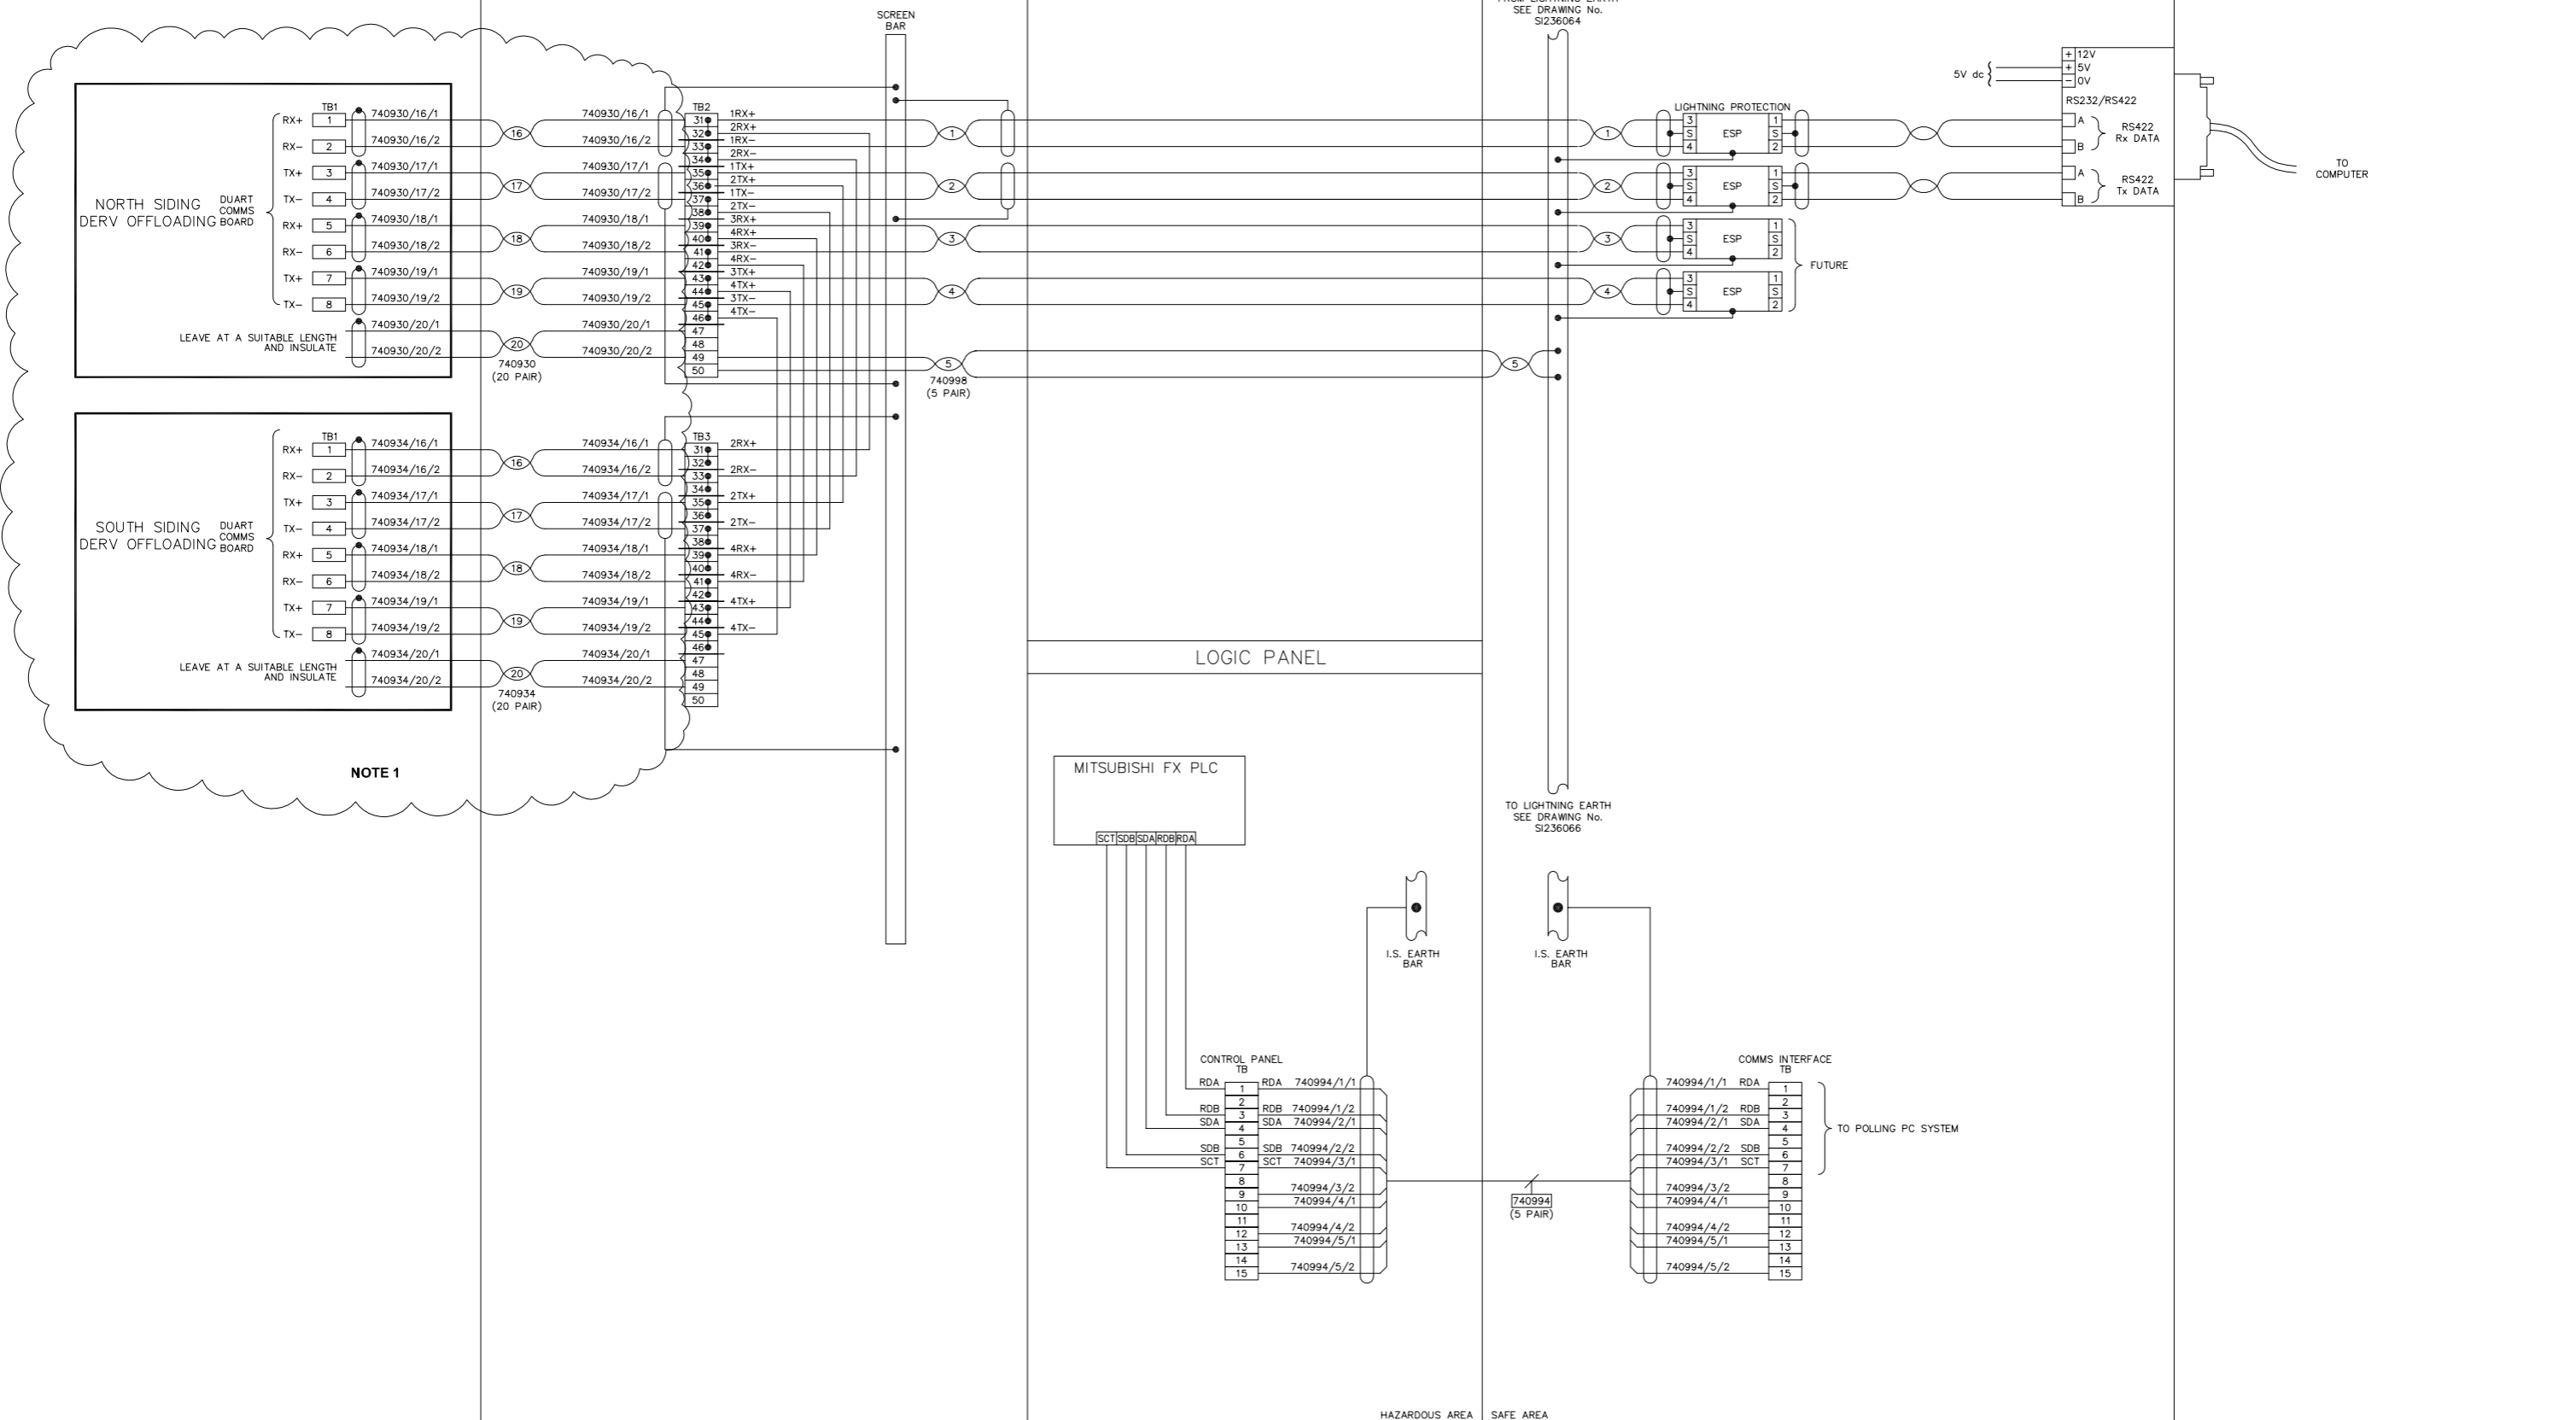

NOTE 1

NOTES  
1. DECOMMISSIONED BATCHING SYSTEM. FIELD EQUIPMENT REMOVED.



IF NOT SIGNED THIS DOCUMENT IS UNCONTROLLED

REV	DATE	BY	DRN	CHK'D	APP'D	DESCRIPTION
A	07/04/99	A.J.H	A.J.H	D.R.R	D.R.R	ORIGINAL ISSUE
B	13/07/99	A.J.H	A.J.H	D.R.R	D.R.R	CABLE 740994 ADDED
C	14/09/10	D.B.F	P.P.	M.M.	M.M.	SI760 MODIFICATIONS

PLANT	IMMINGHAM STORAGE Co. - EAST TERMINAL
TITLE	4-EAST RAIL LOADING SYSTEM DANLOAD TO PC COMMUNICATIONS DIAGRAM
CLIENT DRG. No.	IMMINGHAM STORAGE Co. Ltd. IMMINGHAM EAST TERMINAL, IMMINGHAM DOCK, IMMINGHAM, SOUTH HUMBERSIDE
	<b>P &amp; I DESIGN</b> P & I Design Ltd Tel. 01642 617444 www.pidesign.co.uk
	SHEET 1 OF 1
	P&I DRG No. SI039014_DWG

RAIL LOADING SIDING






COMMUNICATIONS INTERFACE PANEL

DANLOAD 6000

DC JUNCTION BOX

LINE TERMINATION CABINET

PROTOCOL MANAGEMENT UNIT

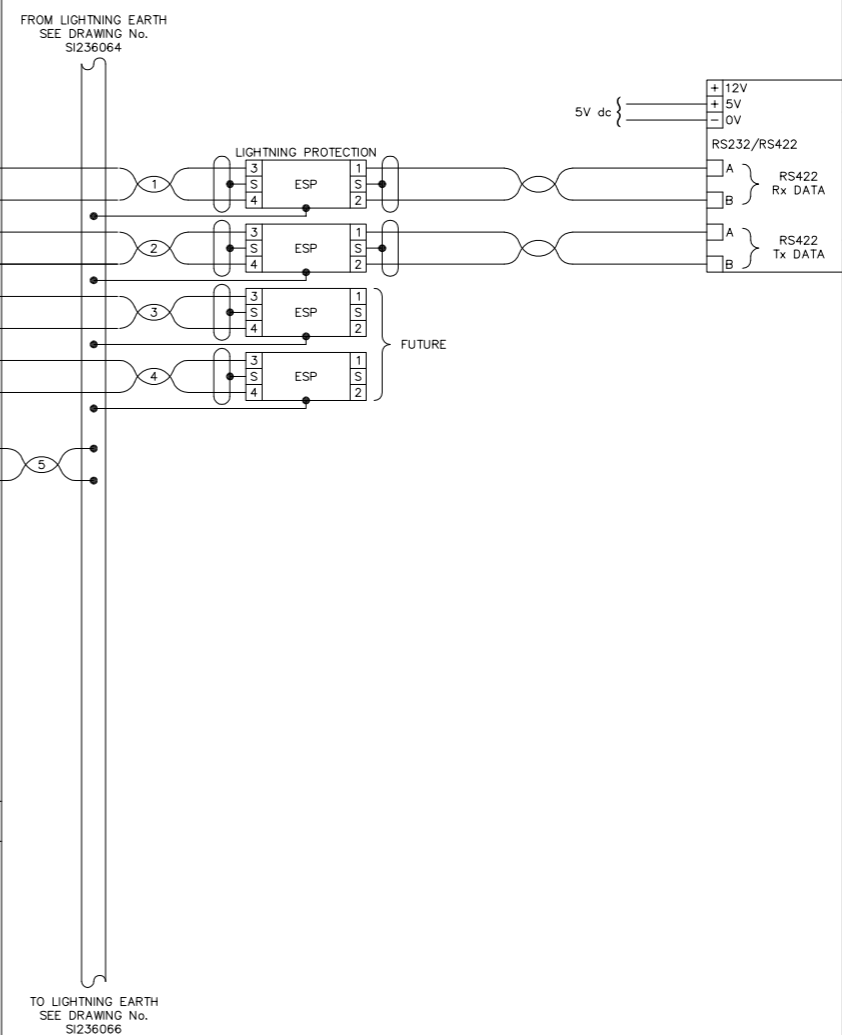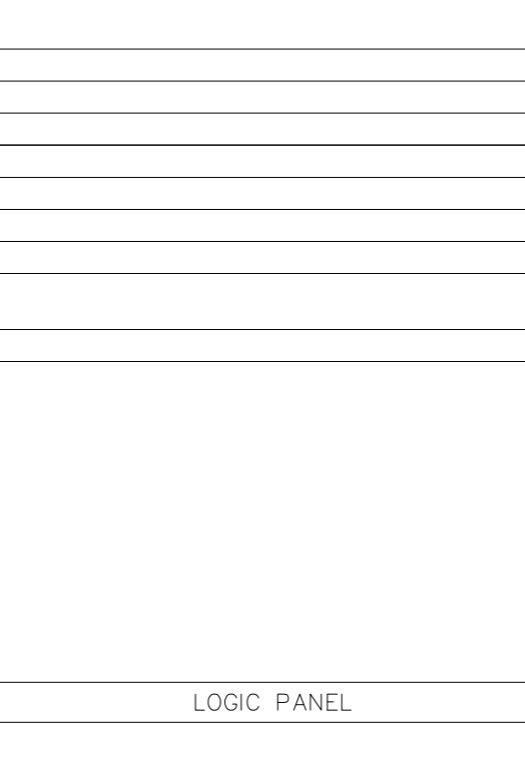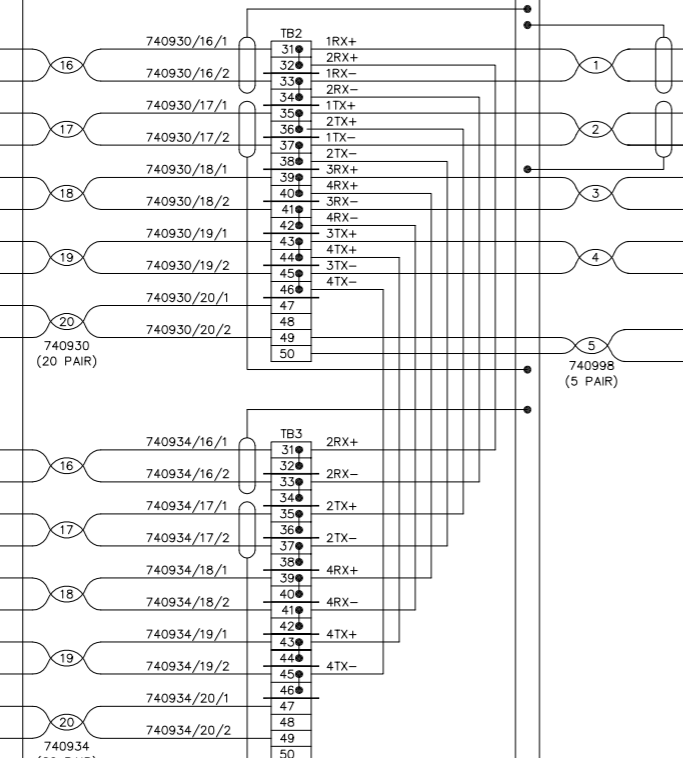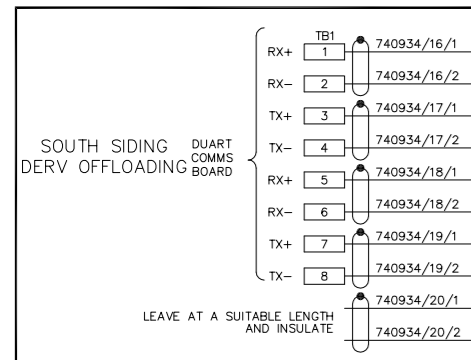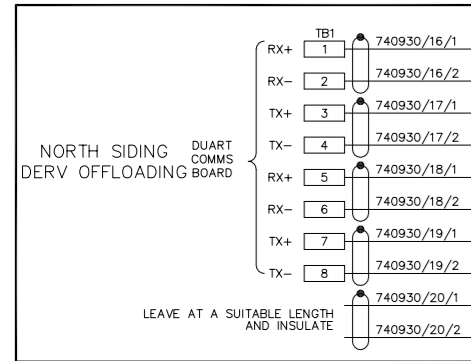

HAZARDOUS AREA SAFE AREA

REV	DATE	BY	DRN	CHK'D	APP'D	DESCRIPTION	PLANT	FINA DERV RAIL LOADING SYSTEM
A	07/04/99	A.J.H	A.J.H	D.R.R	D.R.R	ORIGINAL ISSUE	TITLE	DANLOAD TO PC COMMUNICATIONS DIAGRAM
B	13/07/99	A.J.H	A.J.H	D.R.R	D.R.R	CABLE 740994 ADDED	13/07/99	

<b>Simon Storage</b>	IMMINGHAM STORAGE Co Ltd, IMMINGHAM EAST TERMINAL, IMMINGHAM DOCK, IMMINGHAM, SOUTH HUMBERSIDE	<b>P &amp; I DESIGN</b>
SHEET 01 OF 01		CLIENT DRG. No. P&I DRG No. SIO39014




No.5 SWITCHROOM

FIELD

MCC 5/2 COMPARTMENT A1

JB5/61

PUMP RAFT

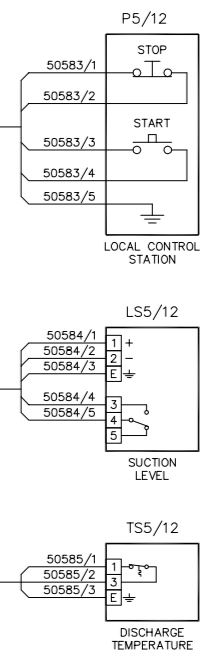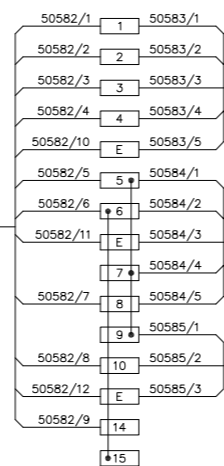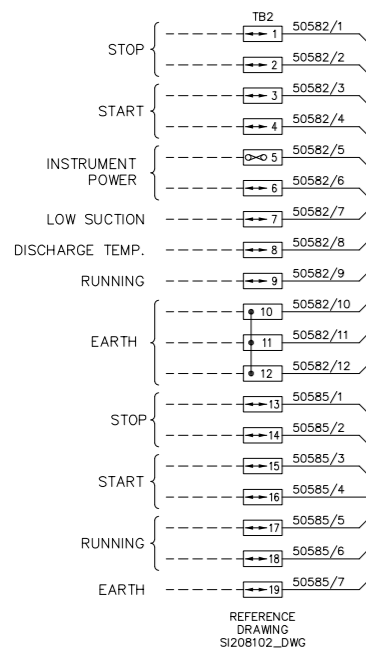

4-EAST RAIL LOADING GANTRY





No.4 SWITCHROOM

GANTRY TOP – BUFFER END CONTROL STATION

GANTRY TOP – CENTRE CONTROL STATION

GANTRY TOP – FAR END CONTROL STATION

4E RAIL LOADING LOGIC PANEL

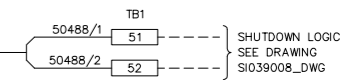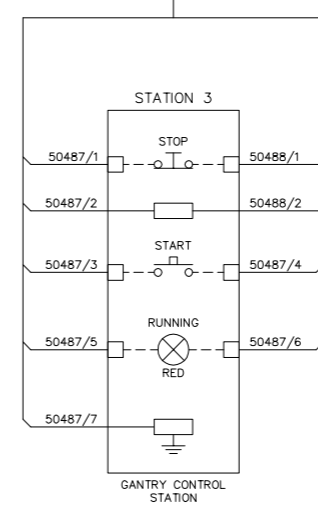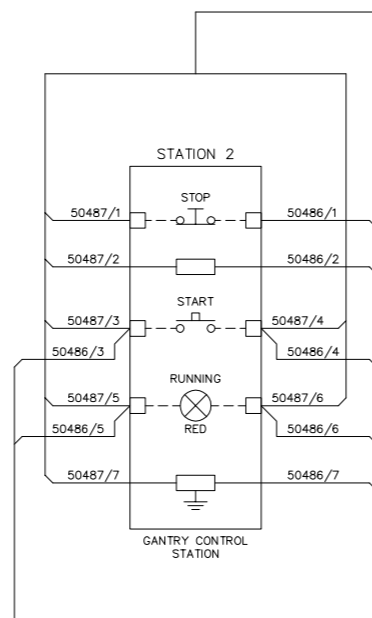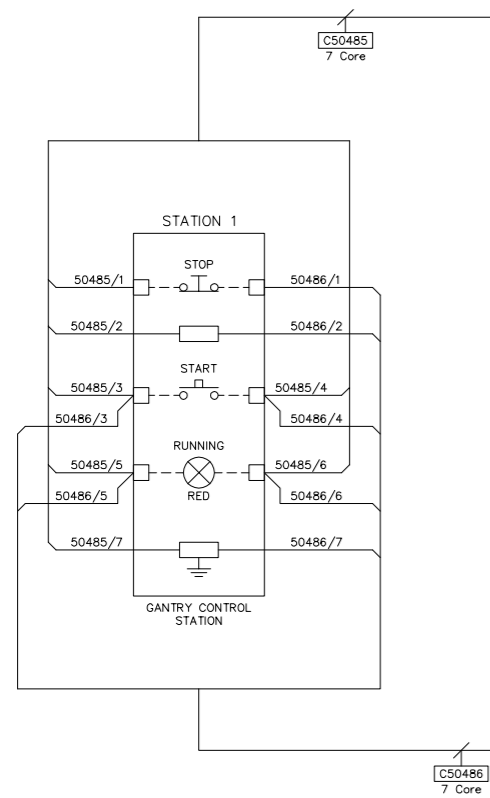

NOTES  
1)





IF NOT SIGNED THIS DOCUMENT IS UNCONTROLLED

REV	DATE	BY	DRN	CHK'D	APP'D	DESCRIPTION
A	01/10/10	P.P.	P.P.	D.B.F	M.M.	ISSUED FOR CONSTRUCTION

PLANT	IMMINGHAM STORAGE Co. – EAST TERMINAL
TITLE	4-EAST RAIL LOADING SYSTEM – PUMP P5/12 CONTROL JUNCTION BOX INTERCONNECTION DETAILS
CLIENT DRG. No.	P&I DRG No. SI76002_DWG

SHEET 1 OF 1

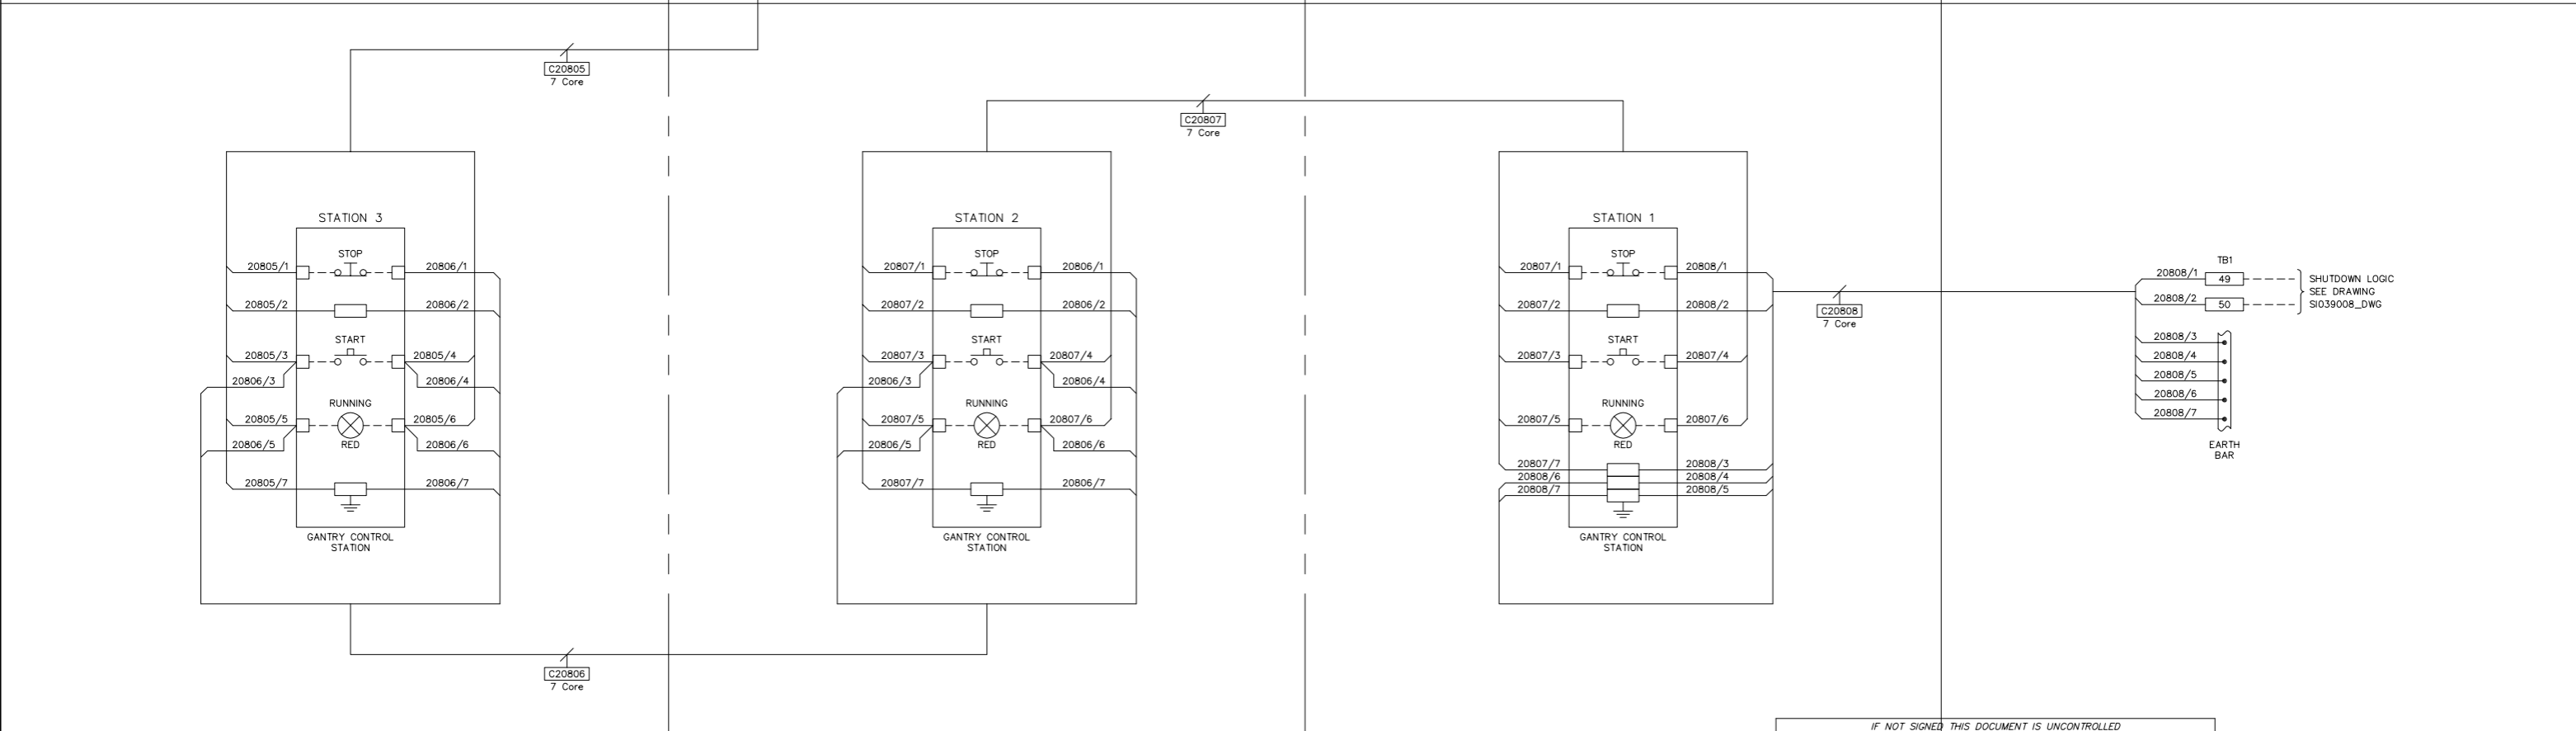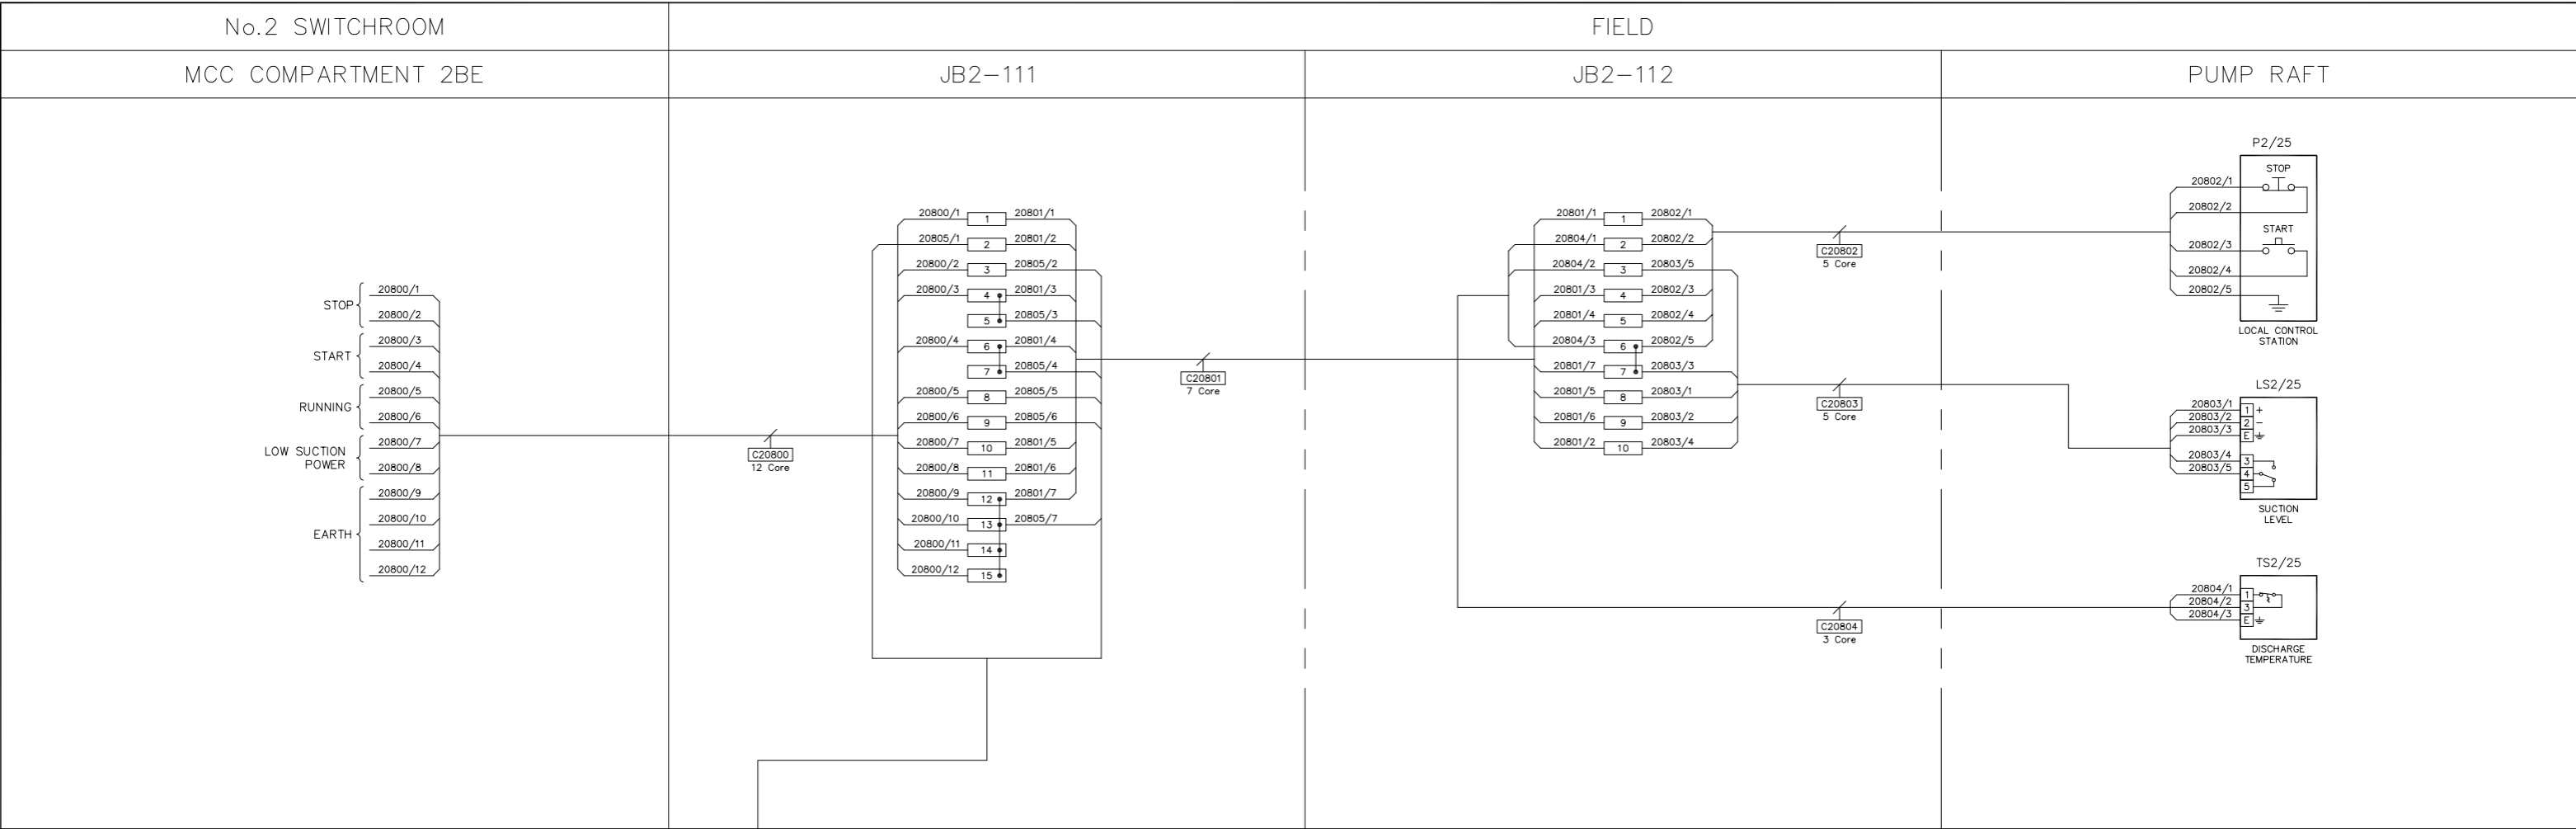

NOTES  
1)




IF NOT SIGNED THIS DOCUMENT IS UNCONTROLLED


REV	DATE	BY	DRN	CHK'D	APP'D	DESCRIPTION
A	01/10/10	P.P.	P.P.	D.B.F	M.M.	ISSUED FOR CONSTRUCTION

PLANT	IMMINGHAM STORAGE Co. - EAST TERMINAL
TITLE	4-EAST RAIL LOADING SYSTEM - PUMP P2/25 CONTROL JUNCTION BOX INTERCONNECTION DETAILS
CLIENT DRG. No.	P&I DRG No. SI760001_DWG

SHEET 1 OF 1

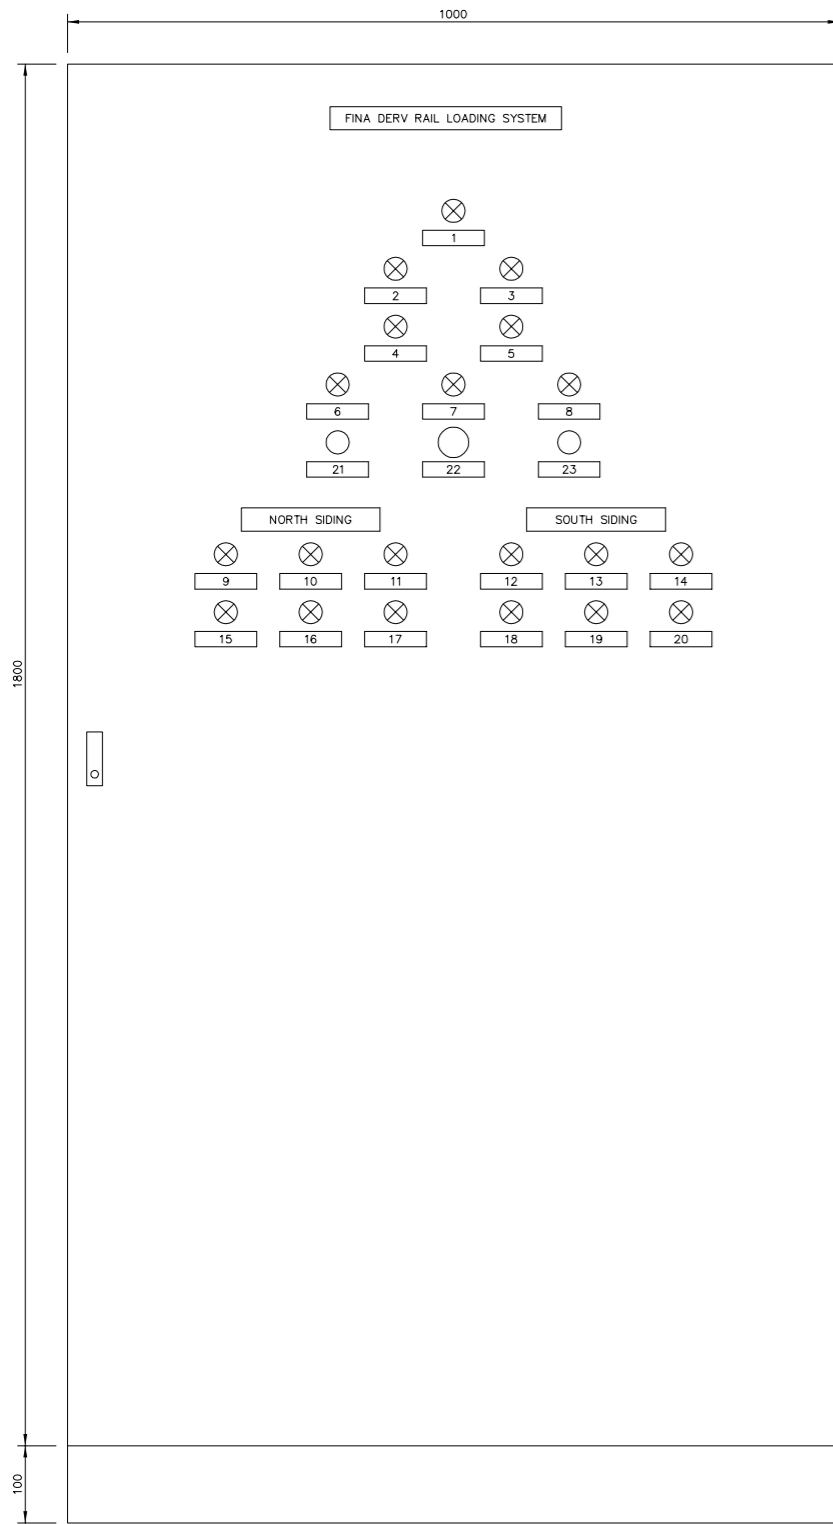


RITTAL ES 5084.600  
FRONT OF PANEL LAYOUT

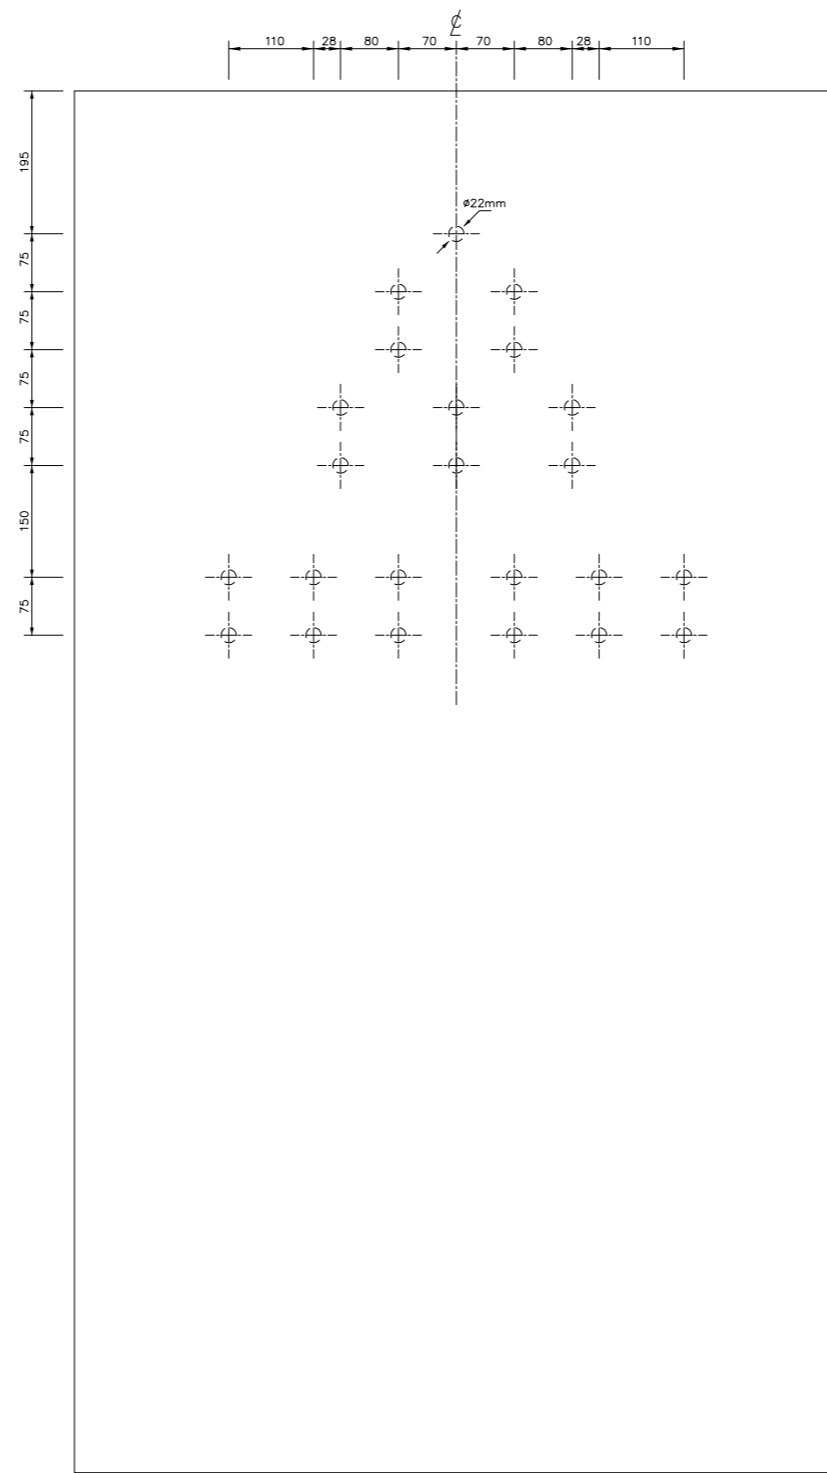

CUT-OUT DETAILS

LOCATION	QUANTITY	DESCRIPTION	STOCK CODE
A	38	RS 4-POLE RELAYS, 24Vdc COIL	RS 213-0793
B	1	RS 4-POLE TIMER RELAYS, 24Vdc COIL (ON DELAY)	RS 328-140
C	1	RS 4-POLE TIMER RELAYS, 24Vdc COIL (OFF DELAY)	RS 328-140
D	15	ASK1	XXXX
E	15	SAK 2.5	XXXX
F	12	ASK1	XXXX
G	12	SAK2.5	XXXX
H	12	EK2.5	XXXX
I	4	MTL 3052	XXXX
J	1	ISOLATOR 25A	XXXX
K	4	RS 4 POLE SAFETY RELAYS, 24Vdc COIL	RS 260-4373
L	6	RS 4-POLE RELAYS, 240VAC COIL	RS 213-0838

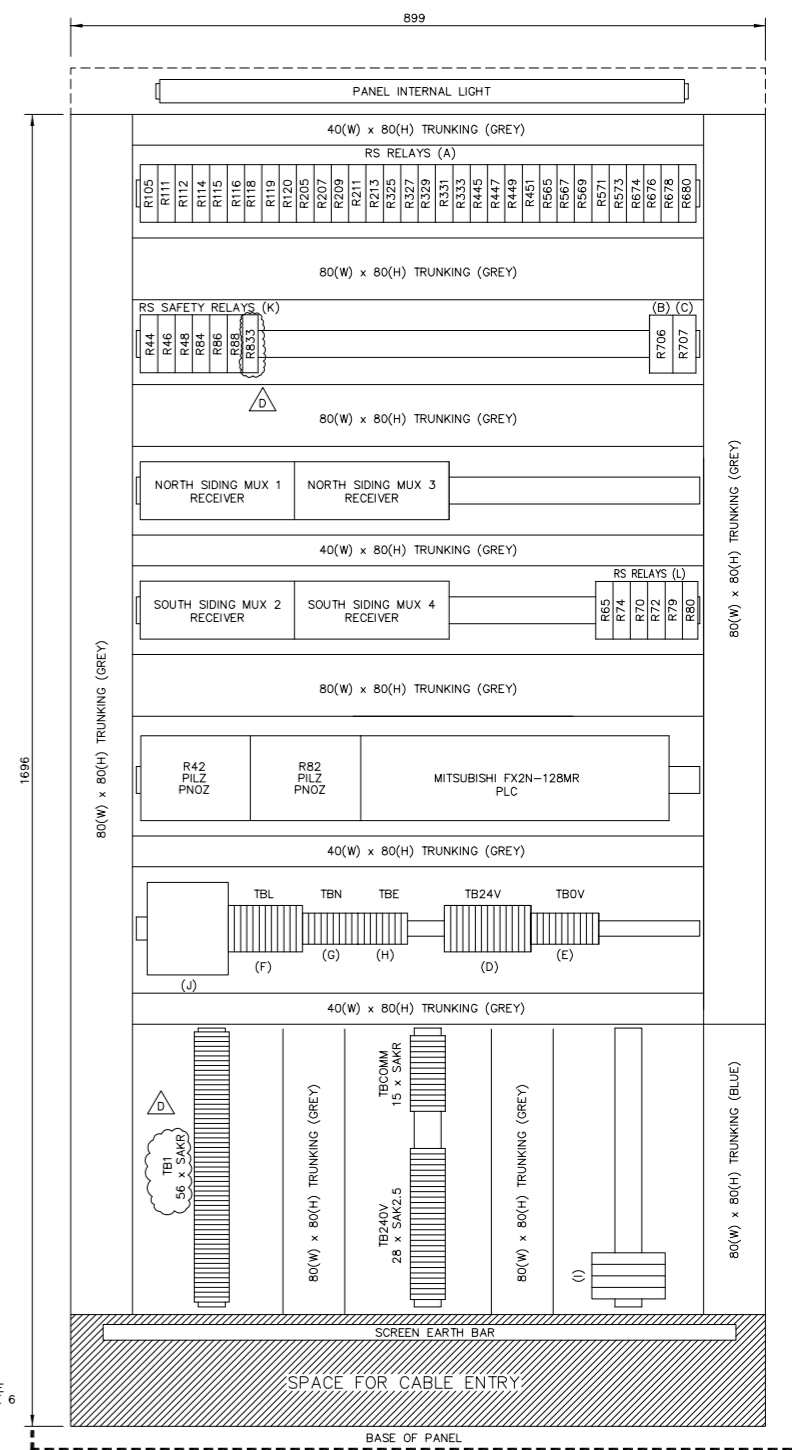

BACKPLATE

LOCATION	LABELS	DETAILS
1		PUMP RUNNING (FLASHES IF NOT IN AUTO OR IN FAULT)
2		POLLING PC COMMS FAILURE
3		CONTROL SYSTEM IN BATCHER STAND ALONE
4		MANUAL VALVE FAULT
5		LEVEL SWITCH OPERATED
6		SYSTEM FAULT
7		ESD OPERATED
8		WATCHDOG FAULT
9		LEVEL SWITCH 1 OPERATED
10		LEVEL SWITCH 2 OPERATED
11		LEVEL SWITCH 3 OPERATED
12		LEVEL SWITCH 7 OPERATED
13		LEVEL SWITCH 8 OPERATED
14		LEVEL SWITCH 9 OPERATED
15		LEVEL SWITCH 4 OPERATED
16		LEVEL SWITCH 5 OPERATED
17		LEVEL SWITCH 6 OPERATED
18		LEVEL SWITCH 10 OPERATED
19		LEVEL SWITCH 11 OPERATED
20		LEVEL SWITCH 12 OPERATED
21		STAND ALONE MODE
22		ESD
23		LAMP TEST

DO NOT SCALE: CONTRACTOR TO CHECK DIMENSIONS AND REPORT ANY OMISSIONS OR ERRORS

- NOTES
- ALL DIMENSIONS IN mm UNLESS OTHERWISE STATED.
  - INGRESS PROTECTION: IP 56
  - CABLE ENTRY: BOTTOM
  - PANEL DEPTH: 400
  - LABELS TO BE WHITE TRAFFOLYTE WITH BLACK ENGRAVING
  - 2-GANG 240VAC SOCKET & COUTANT LAMBDA DRP240-1 PSU TO BE MOUNTED ON THE PANEL SIDE.




IF NOT SIGNED THIS DOCUMENT IS UNCONTROLLED


REV	DATE	BY	DRN	CHK'D	APP'D	DESCRIPTION	
A	08/04/99	A.J.H	A.J.H	D.R.R	D.R.R	D.R.R	ORIGINAL ISSUE
B	14/03/99	A.J.H	A.J.H	D.R.R	D.R.R	D.R.R	GENERAL UPDATE
C	02/07/99	D.P.	A.J.H	D.R.R	D.R.R	D.R.R	TB COMMS ADDED
D	14/09/10	D.B.F	P.P.	M.M.	M.M.		SI760 MODIFICATIONS

PLANT	IMMINGHAM STORAGE Co. - EAST TERMINAL
TITLE	4-EAST RAIL LOADING SYSTEM CONTROL PANEL LAYOUT
CLIENT DRG. No.	P&I DRG No. SI039016_DWG



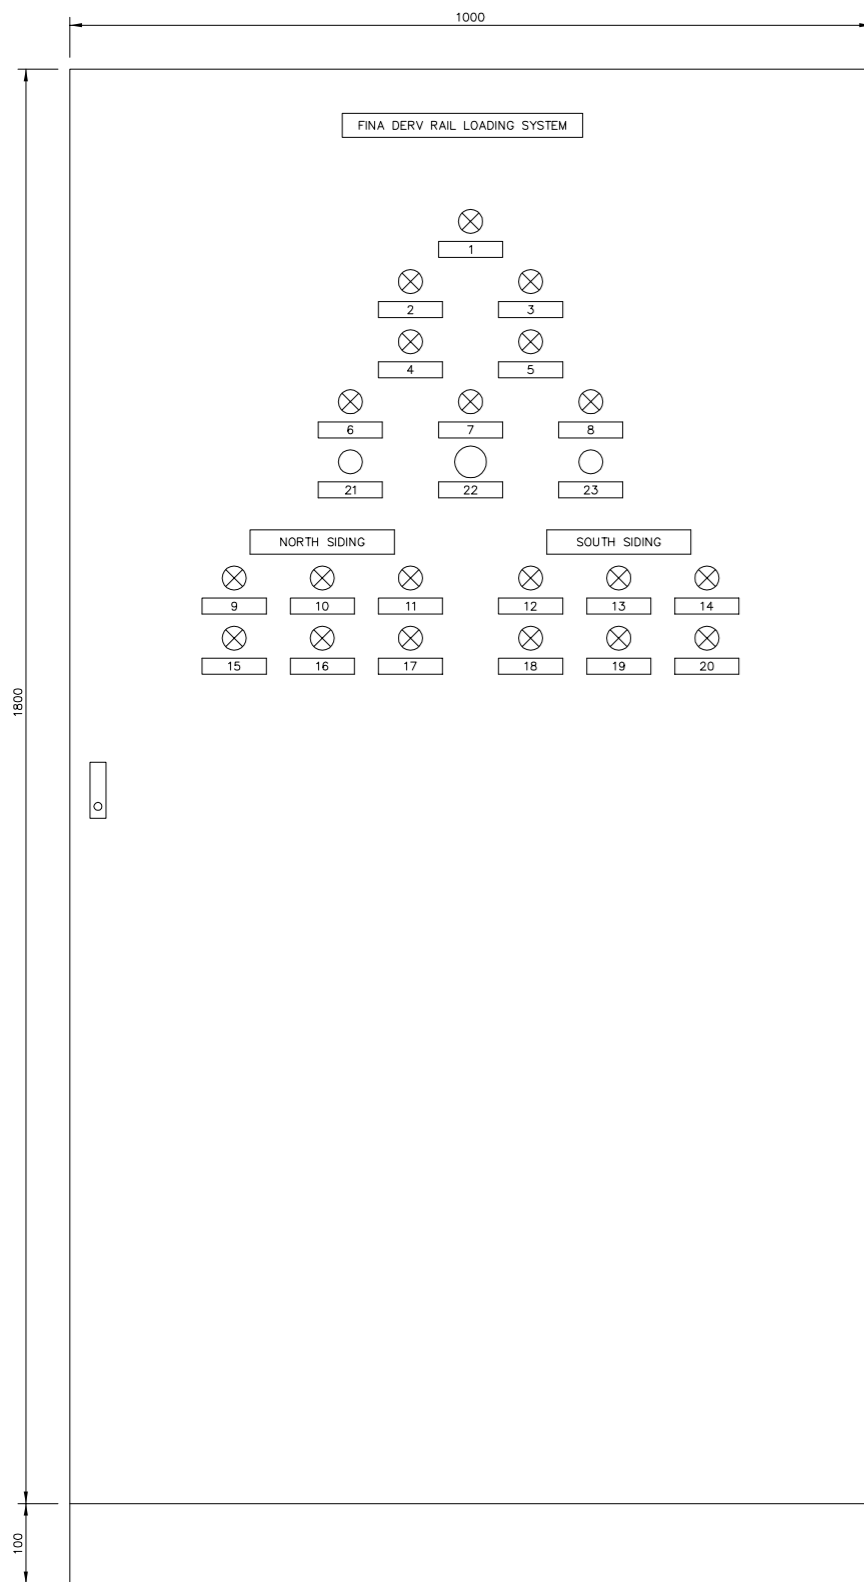


RITTAL ES 5084.600  
FRONT OF PANEL LAYOUT

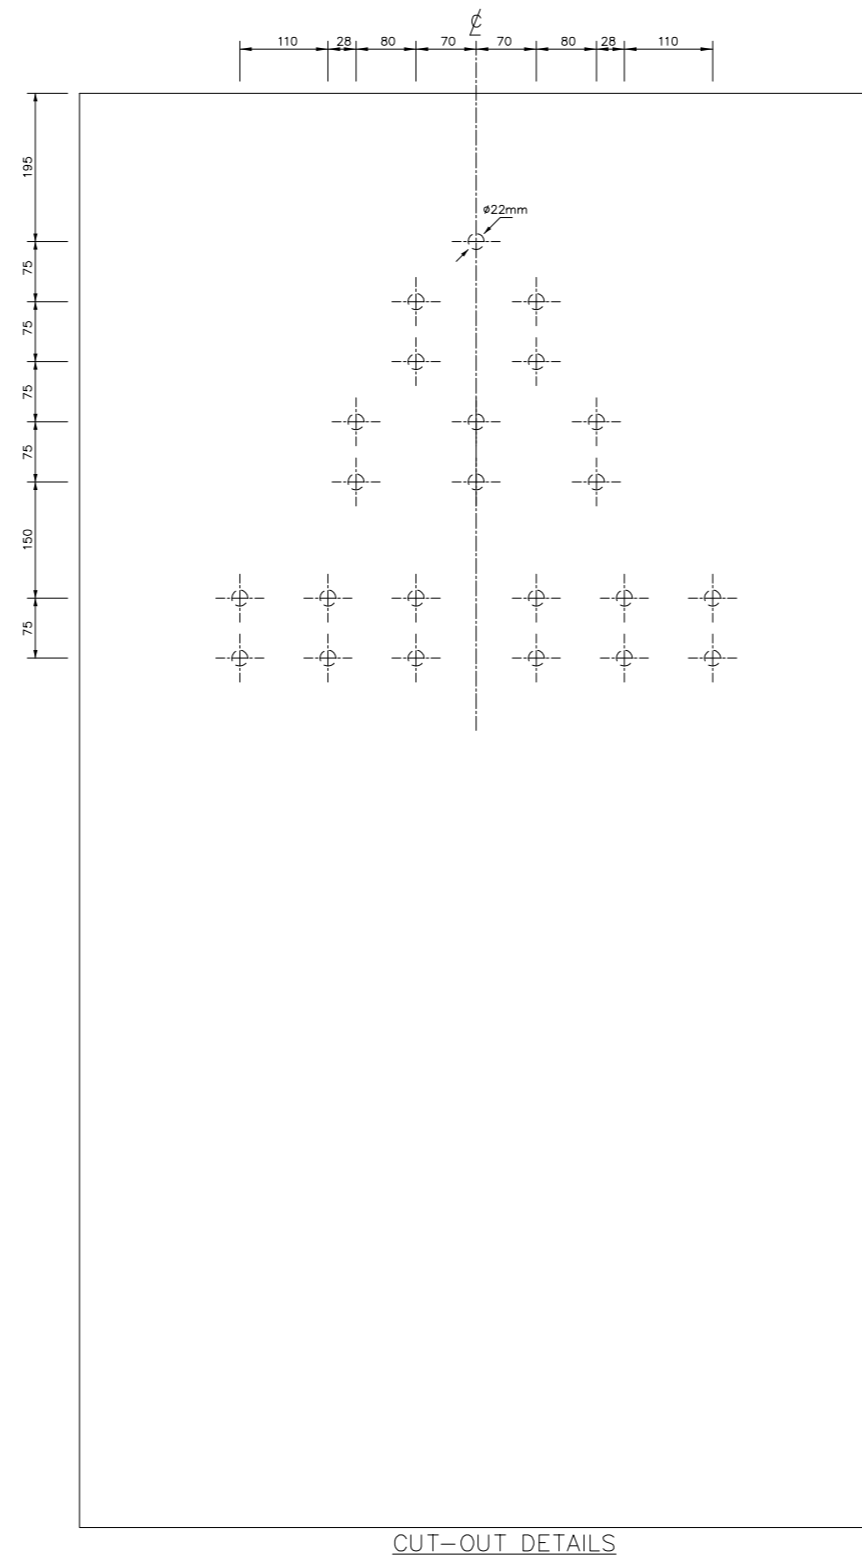

CUT-OUT DETAILS

LOCATION	QUANTITY	ITEMS	STOCK CODE
A	38	RS 4-POLE RELAYS, 24Vdc COIL	RS 213-0793
B	1	RS 4-POLE TIMER RELAYS, 24Vdc COIL (ON DELAY)	RS 328-140
C	1	RS 4-POLE TIMER RELAYS, 24Vdc COIL (OFF DELAY)	RS 328-140
D	15	ASK1	XXXX
E	15	SAK 2.5	XXXX
F	12	ASK1	XXXX
G	12	SAK2.5	XXXX
H	12	EK2.5	XXXX
I	4	MIL 3052	XXXX
J	1	ISOLATOR 25A	XXXX
K	4	RS 4 POLE SAFETY RELAYS, 24Vdc COIL	RS 260-4373
L	6	RS 4-POLE RELAYS, 240VAC COIL	RS 213-0838

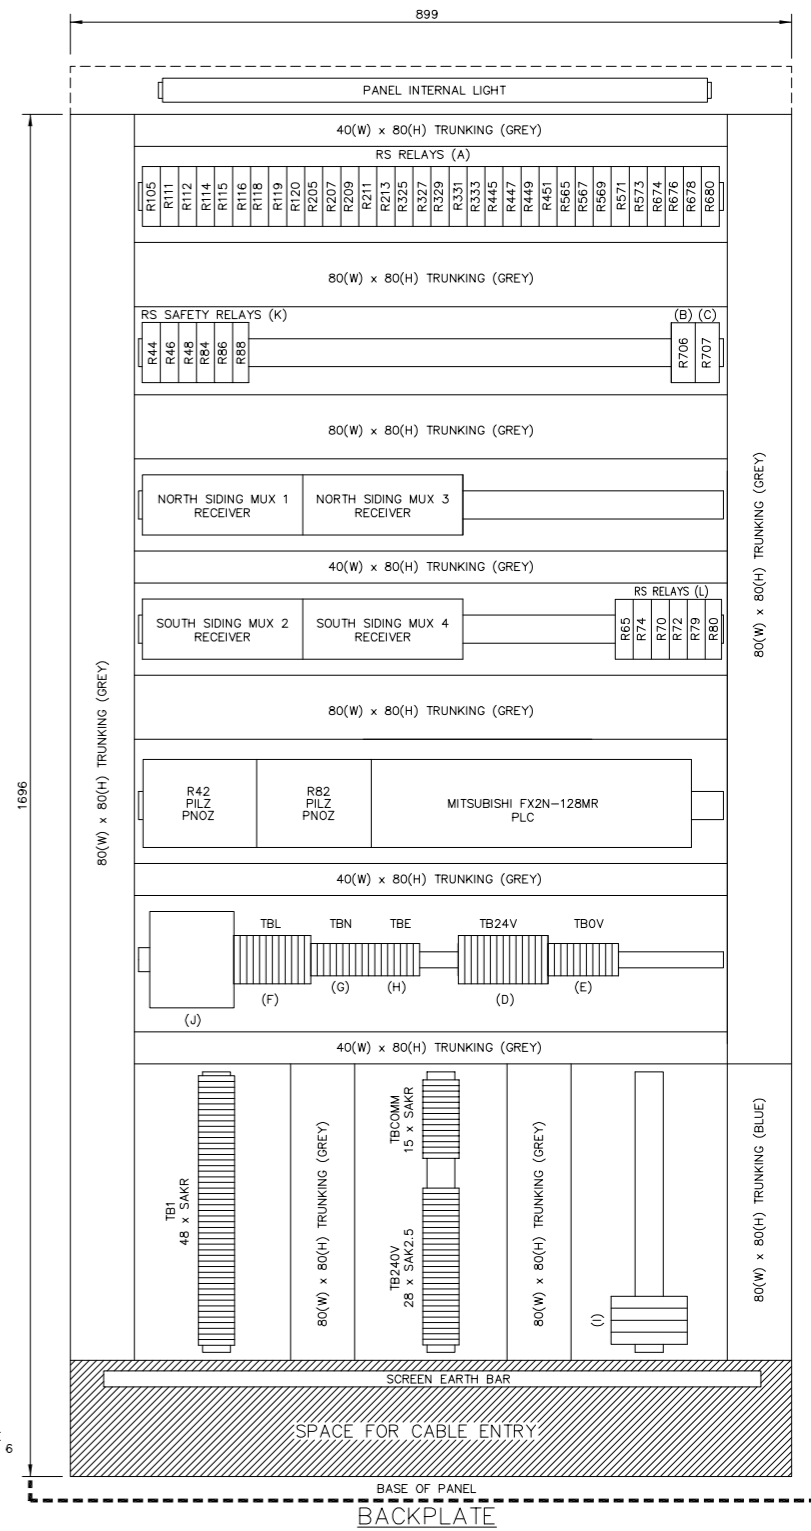

SEE NOTE 6

LOCATION	DETAILS
1	PUMP RUNNING (FLASHES IF NOT IN AUTO OR IN FAULT)
2	POLLING PC COMMS FAILURE
3	CONTROL SYSTEM IN BATCHER STAND ALONE
4	MANUAL VALVE FAULT
5	LEVEL SWITCH OPERATED
6	SYSTEM FAULT
7	ESD OPERATED
8	WATCHDOG FAULT
9	LEVEL SWITCH 1 OPERATED
10	LEVEL SWITCH 2 OPERATED
11	LEVEL SWITCH 3 OPERATED
12	LEVEL SWITCH 7 OPERATED
13	LEVEL SWITCH 8 OPERATED
14	LEVEL SWITCH 9 OPERATED
15	LEVEL SWITCH 4 OPERATED
16	LEVEL SWITCH 5 OPERATED
17	LEVEL SWITCH 6 OPERATED
18	LEVEL SWITCH 10 OPERATED
19	LEVEL SWITCH 11 OPERATED
20	LEVEL SWITCH 12 OPERATED
21	STAND ALONE MODE
22	ESD
23	LAMP TEST

DO NOT SCALE: CONTRACTOR TO CHECK DIMENSIONS AND REPORT ANY OMISSIONS OR ERRORS

- NOTES
- ALL DIMENSIONS IN mm UNLESS OTHERWISE STATED.
  - INGRESS PROTECTION: IP 56
  - CABLE ENTRY: BOTTOM
  - PANEL DEPTH: 400
  - LABELS TO BE WHITE TRAFFOLYTE WITH BLACK ENGRAVING
  - 2-GANG 240VAC SOCKET & COULANT LAMBDA DRP240-1 PSU TO BE MOUNTED ON THE PANEL SIDE.

SCALE 1:5  
WHEN PRINTED TO FULL A1  
SIZE ONLY

REV	DATE	BY	DRN	CHK'D	APP'D	DESCRIPTION	PLANT	FINA RAIL LOADING SYSTEM
A	08/04/99	A.J.H.	A.J.H.	D.R.R.	D.R.R.	D.R.R.	ORIGINAL ISSUE	
B	14/04/99	A.J.H.	A.J.H.	D.R.R.	D.R.R.	D.R.R.	GENERAL UPDATE	
C	02/07/99	D.P.	A.J.H.	D.R.R.	D.R.R.		TB COMMS ADDED	

02/07/99

**Simon** Storage Terminals

IMMINGHAM STORAGE Co Ltd,  
IMMINGHAM EAST TERMINAL,  
IMMINGHAM DOCK, IMMINGHAM,  
SOUTH HUMBERSIDE

**P & I DESIGN**

SHEET 01 OF 01

CLIENT DRG. No. P&I DRG No. SIO39016

## **Appendix II**

### **Schedules**

Cable Schedule  
SI760001\_SCH\_A





# INSTRUMENT/ELECTRICAL CABLE SCHEDULE

CABLE		CONDUCTORS		CABLE ROUTE				APPROX. LENGTH METRES	REMARKS
REFERENCE	TYPE	AREA mm <sup>2</sup>	No.	FROM	GLAND TYPE	TO	GLAND TYPE		
<b>P2-25</b>									
M20132	J04	70	4 Core	No.2 Switchroom MCC Compartment 2BE	ATEX II 2 G EExed	P2-25 - Bund R Rail Loading Pump	ATEX II 2 G EExed	100	Cable Extended
M20132/1	J04	70	4 Core	No.2 Switchroom MCC Compartment 2BE	ATEX II 2 G EExed	P2-25 - Bund R Rail Loading Pump	ATEX II 2 G EExed	160	Extension
C20133	J04	N/A	4 Core	No.2 Switchroom MCC Compartment 2BE	ATEX II 2 G EExed	P2-25 Local Controls	ATEX II 2 G EExed	100	Remove
C20134	J02	N/A	2 Core	P2-25 Local Controls	ATEX II 2 G EExed	TS2-25 Discharge Temperature Switch	ATEX II 2 G EExed	5	Remove
C20800	J12	1.5	12 Core	No.2 Switchroom MCC Compartment 2BE	ATEX II 2 G EExed	JB2/111 - P2-25 Junction Box	ATEX II 2 G EExed	100	
C20801	J07	1.5	7 Core	JB2/111 - P2-25 Junction Box	ATEX II 2 G EExed	JB2/112 - P2-25 Local Junction Box	ATEX II 2 G EExed	5	
C20802	J05	1.5	5 Core	JB2/112 - P2-25 Local Junction Box	ATEX II 2 G EExed	P2-25 Stop/Start Station	ATEX II 2 G EExed	5	
C20803	J05	1.5	5 Core	JB2/112 - P2-25 Local Junction Box	ATEX II 2 G EExed	LS2-25 Dry Run Protection Switch	ATEX II 2 G EExed	5	
C20804	J03	1.5	3 Core	JB2/112 - P2-25 Local Junction Box	ATEX II 2 G EExed	TS2-25 Discharge Temperature Switch	ATEX II 2 G EExed	5	
C20805	J07	1.5	7 Core	JB2/111 - P2-25 Junction Box	ATEX II 2 G EExed	P2-25 Stop/Start/Run Station 3 at 4 East Rail Gantry	ATEX II 2 G EExed	Reuse C40279	Station 3 @ Far End
C20806	J07	1.5	7 Core	P2-25 Stop/Start/Run Station 3 at 4 East Rail Gantry	ATEX II 2 G EExed	P2-25 Stop/Start/Run Station 2 at 4 East Rail Gantry	ATEX II 2 G EExed	40	Station 2 @ Centre
C20807	J07	1.5	7 Core	P2-25 Stop/Start/Run Station 2 at 4 East Rail Gantry	ATEX II 2 G EExed	P2-25 Stop/Start/Run Station 1 at 4 East Rail Gantry	ATEX II 2 G EExed	40	Station 1 @ Control End
C20808	J02	1.5	2 Core	P2-25 Stop/Start/Run Station 1 at 4 East rail Gantry	ATEX II 2 G EExed	4 East Switch Room Rail Loading Logic Panel	ATEX II 2 G EExed	TBC	Re-use C40279 7c Option
<b>P5-12</b>									
C50485	J07	1.5	7 Core	No.5 Switchroom MCC 5/2 Compartment A1	ATEX II 2 G EExed	P5-12 Stop/Start/Run Station 1 at 4 East Rail Gantry	ATEX II 2 G EExed	TBC	Station 1 @ Control End
C50486	J07	1.5	7 Core	P5-12 Stop/Start/Run Station 1 at 4 East Rail Gantry	ATEX II 2 G EExed	P5-12 Stop/Start/Run Station 2 at 4 East Rail Gantry	ATEX II 2 G EExed	40	Station 2 @ Centre
C50487	J07	1.5	7 Core	P5-12 Stop/Start/Run Station 2 at 4 East Rail Gantry	ATEX II 2 G EExed	P5-12 Stop/Start/Run Station 3 at 4 East Rail Gantry	ATEX II 2 G EExed	40	Station 3 @ Far End
C50488	J02	1.5	2 Core	P5-12 Stop/Start/Run Station 3 at 4 East Rail Gantry	ATEX II 2 G EExed	4 East Switch Room Rail Loading Logic Panel	ATEX II 2 G EExed	TBC	Re-use X40356 1 Pr Option
<b>4 EAST RAIL GANTRY</b>									
C40820	J03	1.5	3 Core	JB 4-86 DC Junction Box	ATEX II 2 G EExed	ESD @ Gantry Top Control End	ATEX II 2 G EExed	TBC	
C40821	J03	1.5	3 Core	JB 4-86 DC Junction Box	ATEX II 2 G EExed	ESD @ Gantry Top Centre	ATEX II 2 G EExed	TBC	
C40822	J03	1.5	3 Core	JB 4-86 DC Junction Box	ATEX II 2 G EExed	ESD @ Gantry Top Far End	ATEX II 2 G EExed	TBC	
C40823	J03	1.5	3 Core	No.4 Switchroom Rail Loading Control Panel	ATEX II 2 G EExed	ESD Valve Solenoid	ATEX II 2 G EExed	TBC	
<b>4 EAST SWITCHROOM</b>									
C40824	J02	1.5	2 Core	No.4 Switchroom Rail Loading Control Panel	ATEX II 2 G EExed	No.4 Switchroom Extension Annunciator Node Panel	ATEX II 2 G EExed	30	
C40825	J02	1.5	2 Core	No.4 Switchroom Rail Loading Control Panel	ATEX II 2 G EExed	No.4 Switchroom Dupline Panel	ATEX II 2 G EExed	20	
TOTAL								695	

**NOTES:**

1) Refer to P&I Design Cable Specifications for details on Cable Type.

- Denotes Cable Modified
- Denotes Cable Deleted
- Denotes Cable Added
- Future Cables

**IF NOT SIGNED THIS DOCUMENT IS UNCONTROLLED**

REV	DATE	BY	DRN	CHK'D	APP'D	DESCRIPTION	PLANT	TITLE
A	30/09/10	DBF	DBF	MM	MM	Issued for Tender	Immingham East - 4 East	4 East Rail Loading Cable Schedule



## Appendix III

### Cable Specifications

Type 'E'

Type 'J'



<b>TYPE</b>	J
<b>DESCRIPTION</b>	XLPE Insulated Power Cable - Armoured
<b>MANUFACTURING SPECIFICATION</b>	BS5467
<b>SERVICE</b>	Power Distribution / Control (Max. 440V ac.)
<b>VOLTAGE</b>	600/1000V.
<b>CONDUCTORS</b>	Stranded Copper
<b>INSULATION</b>	XLPE (Cross Linked Polyethylene)
<b>CORE COLOUR CODE</b>	1 core    Brown 2 cores    Brown, Blue 3 cores    Brown, Black, Grey 4 cores    Brown, Black, Grey, Blue 5 cores    Brown, Black, Grey, Blue, Green/Yellow 7 cores    } 12 cores         White insulation with core number indelibly marked at 19 cores         regular maximum intervals of 50mm 27 cores    } 37 cores      48 cores    }
<b>SHEATH</b>	Black PVC
<b>ARMOUR BEDDING</b>	PVC
<b>ARMOUR</b>	Single Core - Aluminium Wire Multi Core - Galvanised Steel Wire
<b>NOTES</b>	The cable type shall be followed by a number that defines the number of cores within a given cable.  e.g. J12 indicates a twelve core type J cable.

<b>TYPE</b>	E				
<b>DESCRIPTION</b>	Twisted Pairs, Collectively Screened - Armoured One pair, Two pair, Five pair, Ten pair or Twenty pair.				
<b>MANUFACTURING SPECIFICATION</b>	BS5308 Part 1 Type 2				
<b>SERVICE</b>	24V dc (Nominal) Digital, Pulse and Analogue Instrument Signals				
<b>CONDUCTORS</b>	Stranded Copper 0.5mm <sup>2</sup> to 1.5 mm <sup>2</sup>				
<b>INSULATION</b>	Polyethylene, with one core black and one core blue.				
<b>MULTI-PAIR IDENTIFICATION</b>	Both cores of each pair shall be indelibly numbered with the pair number at regular maximum intervals of 50mm				
<b>LAYING UP</b>	Cores twisted together in pairs.				
<b>COLLECTIVE SCREEN</b>	Laminated tape with the metallic side down and in continuous contact with a tinned copper drain wire.				
<b>ARMOUR BEDDING</b>	Polyethylene				
<b>ARMOUR</b>	Galvanised Steel Wire				
<b>SHEATH</b>	PVC For intrinsically safe circuits the sheath colour shall be blue, for other circuits the sheath colour shall be black (See Notes).				
<b>NOTES</b>	The cable type shall be followed by a number that defines the number of cores / pairs / triads within a given cable.  In addition a suffix may be added where applicable as follows.  <table><thead><tr><th>Suffix</th><th>Description</th></tr></thead><tbody><tr><td>I</td><td>Intrinsically Safe Circuit</td></tr></tbody></table> e.g. E10I indicates a ten pair type E cable with a blue sheath.	Suffix	Description	I	Intrinsically Safe Circuit
Suffix	Description				
I	Intrinsically Safe Circuit				

## **Appendix IV**

### **Standard Specification for Instrument & Electrical installations**

SI003001\_INS\_A



# *P & I Design Ltd*

Process Instrumentation Consultancy & Design

2 Reed Street, Gladstone Industrial Estate,  
Thornaby, TS17 7AF, United Kingdom.  
Tel. +44 (0) 1642 617444 Fax. +44 (0) 1642 616447  
Web Site: [www.pidesign.co.uk](http://www.pidesign.co.uk)

**SIMON STORAGE LTD.**

**IMMINGHAM EAST TERMINAL**

**STANDARD SPECIFICATION FOR  
INSTRUMENT & ELECTRICAL INSTALLATION**

Rev	Date	By	Checked	Approved	Description	Client Ref.
A	17/02/09	DBF	MM	MM	Original Issue	
						Document No. SI003001.INS
						<b>Page 1 of 14</b>

*IF NOT SIGNED THIS DOCUMENT IS UNCONTROLLED*

## CONTENTS

- 1 Introduction
- 2 General Requirements
- 3 Methods of Work and Materials

## APPENDICES

- I Applicable Standards



## 1 INTRODUCTION

This document details the specifications required to install instrument and electrical equipment and associated systems at Simon Storage Ltd. ISCO East Terminal. This document covers all aspects of industrial instrument and electrical installation work and may contain sections that may not be relevant to every project.

## 2 GENERAL REQUIREMENTS

The Contractor is to supply all labour, cables, cable tray/ladder racking, equipment and materials necessary to complete the works detailed.

### 2.1 General Conditions of Contract

The Contractor is required to work to the Employer's Condition of Contract;

### 2.2 Requirement of Contract

To carry out works to install the instrument and electrical element of the project. Works will be carried out while surrounding systems are under construction and care must be taken to avoid any clash with other trades. It may be necessary to carry out some of the works during agreed shutdowns. The Engineer will liaise closely with the Contractor to ensure that the required systems are made available.

### 2.3 Safety

The Contractor is required to work to the Employer's Safety Conditions.

Following Tender assessment, the successful Tenderer will be required to attend a meeting and participate fully in the formulation and regular update of the final Health and Safety Plan for the Project.

### 2.4 Installation

All labour, including unskilled, skilled and supervisory staff involved in the off-loading of equipment at the site and in the complete installation, assembly and testing of all the items included in the contract.

All materials required for the contract including earth conductors and furse clamp/fixings, cable ladder, tray, channel, supports, cable as detailed in the schedules.

All tools and equipment, including lifting equipment, scaffolding, general plant required in the performance of the contract and all necessary testing equipment.

The provision of all site facilities and any temporary electricity supplies.

All builders work including drilling and fixing to the civil structure, any necessary grouting and the sealing of holes, ducts and trenches after cable installations. All fixings, nuts, bolts,





2.4 *Installation (Cont.)*

studs, washers, gaskets and any other appurtenances necessary to provide a complete and operational installation.



### **3 METHODS OF WORK AND MATERIALS**

#### **3.1 Installation Standards**

Equipment and installation shall comply with all relevant standards, statutory instruments, regulations and authorities current and governing at the time, with particular reference to those detailed in Appendix IV.

If interpretation of the standards shall prejudice any part of this specification, where requirements may be in excess of those called for in the standards, the Purchaser's standards shall apply.

#### **3.2 Materials**

All materials used in manufacture, construction or installation shall be new and specifically suited for their duty or purpose.

The Contractor shall provide all miscellaneous materials, not of free-issue nor specifically defined by the Company, which are necessary to complete any installation to the required standard.

#### **3.3 Electrical Contractor**

All work carried out shall be performed by a qualified electrical contractor, approved by the National Inspection Council for Electrical Installation (NICEIC). Work shall comply with the relevant British Standards. The contractor shall ensure that either:-

All electricians employed on the project have suitable experience of working on hazardous area equipment or a qualification for working on Electrical Equipment in Hazardous Areas (CompEx),

or,

that the complete installation is checked and certified by a CompEx certified person.

#### **3.4 Position of Electrical Equipment and Appliances**

The approximate positions of electrical apparatus such as motors, instruments, and distribution boards are shown on the drawings, but their exact positions shall be determined on site by an appointed representative of the Engineer.

The position of electrical apparatus shown on the drawings shall be assumed to be correct for the purposes of tendering, but they may be reasonably varied without extra cost.

The Contractor shall ascertain on site that his work will not foul other engineering services or equipment and any work which has to be re-done, due to negligence, in this respect shall be his responsibility.



### 3.5 Segregation of Service

All cable supports and cables shall be prevented from coming into contact with process equipment and piping by a spacing of 150mm.

Cables operating at a voltage of 110V AC and above shall be segregated from cables operating at a voltage of 24V DC and below.

Intrinsically safe circuits shall not share multicore cables with none intrinsically safe circuits.

### 3.6 Fixings

No structural steelwork shall be drilled for any purposes without the approval of the Engineer. In general, all fixing to steelwork shall be by means of studs welded to the steelwork or by clamp brackets or hook bolts. Permission shall be obtained from the Engineer for any other type of fixing. Any protective coating damaged by welding, etc. should be made good by a method approved by the Engineer.

The supply and fixing of all support brackets, clamps and spacers and any other steelwork, whether or not shown in detail on the drawings or otherwise, which may be required for the proper and effective fixing of any equipment shall be considered to be included in the material and labour for the supply and fixing of that equipment, unless this work is specifically detailed in the Schedules.

Where PVC sheathed cable is used, cable cleats and supports shall be as recommended by the cable manufacturer. They shall be designed to avoid any damage to the PVC sheaths by sharp edges and excess pressure.

Cables erected on walls or steelwork shall, so far as is practicable, be so supported that no flexing can occur. Generally cables shall be supported on cleats which clamp the cables to prevent longitudinal movement.

Lightweight equipment and conduit saddles may be fixed to the building structure by means of screws in metal or plastic plugs. Wood or fibre plugs shall not be used.

Fixing to brickwork shall be made in the bricks and not in the joint. If it is not possible to make all the fixings in the brickwork, then the equipment shall be positioned to enable the upper fixings to be made in the brickwork.

Shot fixing bolts shall not be used.

Any additional scaffolding required will be included within the Contractor's Scope of Work. Note: Existing scaffold in place to assist with the Mechanical Pipework Installation may be used.



### 3.7 Clean Up

During and on completion of installation work the Contractor shall remove all surplus equipment and material and leave areas in a 'brush clean' condition. Refuse shall be disposed of as directed by the Engineer.

Prior to testing (where damage could arise) and before offering any part of the installation for acceptance, the Contractor shall clean out all electrical enclosures and wipe down painted surfaces. If necessary, damage to paintwork shall be made good by touch-up.

Before finally leaving the site, the Contractor shall remove all his accommodation, plant, tackle and tools of the trade to the satisfaction of the Engineer.

### 3.8 Earthing

#### 3.8.1 General Soil Conditions

No information is available.

#### 3.8.2 System Earthing

The neutral shall not be regarded as an earth conductor.

In areas where earth rods are to be driven into the ground, it shall be the contractors responsibility to ensure that there are no other underground services in the immediate vicinity.

#### 3.8.3 Equipment Earthing

The main earthing bar as identified in the specific project documentation will be connected by a separate earth conductor to its main earth point. All non-live metalwork shall be directly or indirectly bonded to the main earth bar. Such metalworks will include electrical equipment enclosures, motor frames, tray/ladder rack to be continuously bonded, cable armouring and glands. All glands which are through clearance holes require an earth tag and connection to the earth system by 6 sq.mm cable. Care must be taken to ensure that paint, etc. is cleaned away from under earth connections so that there is good earth continuity.

Direct bonding shall be taken to mean dedicated earth conductors within, or separate from, plant cable. Separate conductors shall be multi-stranded copper with a green/yellow sheath, size as specified in the drawings. Indirect bonding shall be taken as earth paths through armouring.

Note: (Dedicated earth conductors preferred).

However, a combination of both may be employed, providing that the value of the earth loop impedance allows flow of fault current sufficient to rupture associated protective fuses within five (5) seconds.



### 3.8.4 Lightning Protection

Lightning protection is not anticipated for the plant.

## 3.9 Cabling

### 3.9.1 General

The schedules detail the cables with the estimated lengths for tendering purposes only. It is the Installation contractors responsibility to site measure prior to any cable installation and any cost variation must be advised to the Engineer for approval before installation.

All cables above 16 sq mm section shall have shaped conductors.

Before any armoured cable is installed, triplicate copies of the test certificate giving details of these tests shall be submitted to the Engineer for approval.

When delivered to site, each coil of cable shall have attached the manufacturer's test certificate.

When cables are steel wire armoured, the conductance of the armour shall be not less than 50% of the conductance of one phase core.

### 3.9.2 Installation

Bending radii shall conform to the maker's recommendations but in no case shall be less than:

8 x OD for armoured cables.

Cables shall be identified with durable, non-corrodible tags, of the Critchley K type or equivalent, inscribed with the reference number allocated in the cable schedules and fixed securely to the cable.

All cables shall be tagged as follows:

- a. At each termination.
- b. Where they enter and leave underground ducts.
- c. At each side of any barrier through which they run.
- d. Where they rise from one level to another.

All cores shall be terminated using approved crimped lugs of appropriate size. Spare cores shall be made off to unused terminals.

The cores of cables of section larger than 4mm<sup>2</sup> shall be connected by a means approved by the Engineer.



### 3.9.2 *Installation (Cont.)*

Cable joints shall not be used unless specified or on the written authority of the Engineer.

Cores shall be marked to comply with the references given in the cable schedules using Critchley Z type or equivalent. They shall be identified having black characters reading from the terminals outwards. Clip-on ferrules will not be accepted.

Insulated cables shall have standard compression type gland of the appropriate size. Particular ATEX certification requirements will be detailed on cable schedules.

Each gland shall be bonded to its cable armouring, where applicable and unless otherwise specified, and to be complete with earth tag and locknut.

Cables shall be protected against mechanical damage at vulnerable points. This particularly applies in exposed locations where cables emerge from ground or floor.

### 3.9.3 Cables in Ground

When excavating trenches for underground cables, due account shall be taken of ground conditions. Cables in normal ground shall be laid in trenches 500mm deep minimum unless agreed otherwise. Before any excavation starts, the Contractor shall check if there is any record of other underground services along the route.

Trench bottoms shall be cleared of irregular and sharp objects before applying bedding.

Cables shall be laid the appropriate distance apart (dictated by rating factors) on a bed of clean, dry, builders' sand, 75mm deep.

Cables shall be blinded with a similar layer as soon as possible after installation.

The trench shall be backfilled a further 150mm with riddled, excavated spoil.

Interlocking cable tiles or continuous marker tape, giving clear warning or danger, shall be placed over each cable or closely associated groups of cables.

Backfill to surface shall be allowed to settle before final topping and grading.

Approved route markers shall be installed where cables enter or leave buildings, at changes of direction and at appropriate intermediate intervals.

Pilot cables shall run continuously with their associated main cable, where the route is common.



### 3.10 CABLE SUPPORTS

#### 3.10.1 Cable Ladder

Cable ladder should be installed as required in this specification.

The ladder shall be Swift type which is Hot Dip Galvanised to BS729:1971.

Standard metric widths shall be used.

Radius bends, tees, sets, reducers or other fittings shall be proprietary type by the ladder manufacturer and his installation instructions shall be followed. Earth Continuity connectors are to be fitted to all racking.

It shall be the contractors responsibility to provide the main supports for the racks as well as the fixing of the racks to the main supports.

Non Standard fittings will only be allowed where expressly agreed.

Cables shall not be tiered more than two deep, in which case the larger should be nearer to the end of the ladder.

Ladders shall be supported over their full width and secured to each support.

All bolts, nuts or washers shall be metric and sheradised, plated or otherwise effectively protected against corrosion.

Excessive bolt projections which may make the removal of nuts at a later date difficult will not be accepted.

When fully loaded, no span shall have a sag detectable by the eye.

Ladder runs shall be completely erected before cable laying commences and any rags, burrs or raw edges suitable treated.



### 3.10.2 Cable Trays

Cable trays shall be heavy-duty pattern formed from galvanised sheet steel. The tray shall have side flanges not less than 25mm deep with returned edges and be coated fabrication. Material gauge shall be 1.5mm (16 SWG) minimum except that for tray widths less than 400mm, the gauge may be reduced subject to the flange depth and the approval of the engineer. Factory made tee sections and bends shall be used where possible.

The cutting of trays shall be kept to a minimum but where unavoidable, the edges shall be suitably treated. Fasteners shall not present any obstruction on the tray. Capacity amounting to 25% usable tray area shall be left spare.

For those portions of cable route where the cables are to be laid on cable tray, they shall be laid flat and straight and shall be properly dressed into position and fastened to the tray at intervals not greater than 500mm. Where the tray is run horizontally but arranged in the vertical plane, fastener spacing shall be as detailed in the IEE Regulations. Care shall be taken to space the cables to allow adequate cooling in accordance with the IEE Wiring Regulations and not more than two layers of cables shall be run on one tray.

### 3.10.3 Channel

"Unistrut" type channel may be used for individual cable runs. Where cables are installed in the channel, capping is to be fitted. The channel and capping are to be of the galvanised type.

Where channel is to be used it must be with the approval of the Engineer.

### 3.10.4 Routes

Specific routing will be influenced by local circumstances.

Final details of all routes shall also be agreed with the Engineer before commencing pulling.

In all cases particular attention shall be paid to installation to as to prevent:

- a. Cable support fixings adversely affecting the strength of structures to which they are attached.
- b. Cable routes fouling access to other equipment and plant areas.
- c. Cables being at risk of damage caused by normal circumstances.





### 3.11 Testing and Commissioning

#### 3.11.1 Testing

On completion of any installation work the Contractor shall carry out tests to ensure that it has been correctly executed and is safe to commission. This section provides a guide to the minimum normal requirements. Additional or special testing of particular equipment or components may be necessary and if so shall be carried out in accordance with any applicable instructions or recommendations.

On completion of the installation, an inspection of hazardous area equipment is to be conducted as detailed in EN60079-17 Type: Initial, Grade: Detailed. All results are to be fully recorded. These tests must be carried out by a CompEx or equivalent certified person.

Safety Procedures, for any tests which may involve danger to personnel, the Contractor shall 'tape off' the area and display warning notices.

Earth Tests, as soon as possible after establishment, the value of the plant earth(s) shall be measured, preferably using an instrument specifically for this purpose. Tests shall preferably be carried out in dry weather.

Continuity of all earth paths shall be checked, loop impedance values shall be measured and recorded for all or sample circuits at the discretion of the Engineer. Any sample testing shall involve circuits furthest from the point of supply.

Insulation Tests, insulation tests shall be carried out on all cables and equipment using a 'Megger' of appropriate voltage. Low voltage devices (e.g. electronic circuitry) which could suffer damage thereby, shall be disconnected prior to testing.

Di-electric tests on insulating oil shall be carried out only if required by the Engineer.

Pressure Tests, it may be assumed that pressure testing (over-potential) of equipment will have taken place at works prior to despatch and need be repeated only if required by the Engineer.

In general and unless expressly excluded, all HV cables shall undergo a site pressure test prior to energising.

Injection Tests, injection tests on protective relays shall be carried out at the discretion of the Engineer.

Phase Rotation, supplies to principle load centres shall be checked for correct phase rotation.



3.11.1 *Testing (Cont.)*

Rotating Machines, all motors shall be 'jogged' on agreement with the Engineer, for direction then run on light load (with overload relays set low) to check for noise and vibration. Any drain plugs shall be removed to check for condensation, then replaced.

Lighting Levels, illumination levels shall be measured against specification in the absence of daylight.

Noise Levels, will not normally require measuring unless required by the Engineer.

Witnessing, the Contractor shall give reasonable notice of testing to the Engineer who may wish to witness same.

Records, all test results shall be recorded.

3.11.2 Commissioning

Electrical

The installation shall be pre-commissioned by carrying out full functional tests at rated voltages.

These operations will normally be carried out jointly by the Engineer and the Contractor and will include:-

Prolonged running of rotating machines (on load if possible) to check for smooth operation and temperature rise. During these tests the Contractor shall check metered currents, where applicable, and set overload relays and ammeter markers to suit conditions.

Active tests on all circuits to ensure that all components are operating correctly.

Sequence tests on all circuits to prove interlock and alarm features.

If required by the Engineer, the Contractor shall provide qualified assistance on a standby basis during full plant commissioning under process conditions.

Rates would be agreed in advance, in this event.



## APPENDIX I

### Applicable Standards

Specifications and Codes of Practice of the BSI

Regulations under the Electricity Acts

Requirements of HM Factory Inspectorate

Any applicable requirements of other National or Local Authorities

Simon Storage Safety Regulations for Contractors

Simon Storage General Conditions of Contract. (Latest Edition)

The Contractor is to request a copy of Simon Storage Regulations and Conditions of contract if not already in possession.

British Standard EN60079-14 Electrical Installation in hazardous areas.

British Standard EN60079-17 Inspection and Maintenance of electrical installations in hazardous areas.

British Standard BS7671:2008 Requirements for Electrical Installations (IEE Wiring Regulations 17th Edition)



# *P & I Design Ltd*

Process Instrumentation Consultancy & Design

2 Reed Street, Gladstone Industrial Estate,  
Thornaby, TS17 7AF, United Kingdom.  
Tel. +44 (0)1642 617444 Fax. +44 (0)1642 616447  
Web Site: www.pidesign.co.uk

**IMMINGHAM STORAGE Co LTD**

**ISCo EAST TERMINAL**

**INSTRUMENT & ELECTRICAL INSTALLATION**

**INSTALLATION SCOPE OF WORK**

**600 SERIES ROVOVs**

<b>Rev</b>	<b>Date</b>	<b>By</b>	<b>Checked</b>	<b>Approved</b>	<b>Description</b>	<b>Client Ref.</b>
A	02.12.10	D.B.Faulkner	MM	MM	Issued for Construction	
						Document No. SI760002_INS
						<b>Page 1 of 3</b>

*IF NOT SIGNED THIS DOCUMENT IS UNCONTROLLED*

## CONTENTS

- 1 INTRODUCTION
- 2 SCOPE OF WORK
  - 2.1 Scope of Work – No.2 Switchroom
  - 2.2 Scope of Work – Field
  - 2.3 Contractor Supplied Equipment
  - 2.4 Free Issue Equipment

## APPENDIX

- I Cable Overview Drawings
- II Schedules & Specifications

### Revision History

Revision A – Original issue



## 1 INTRODUCTION

This document details the scope of work to provide the Instrument/electrical installation works for 600 series tank 601, 602 & 603 rail loading export ROSOVs at ISCo East Terminal. It is to be read in conjunction with specification SI003001\_INS - Standard Specification for Instrument & Electrical Installations.

This scope is a variation to the main installation contract defined in document SI760001\_INS. All terms and conditions applicable to the main contract apply to these variation works also.

## 2 SCOPE OF WORK

The scope of work is as detailed in the following sections and as shown on the documentation listed below.

Cable Schedules	SI760002_SCH_A
Junction Box Schedules	SI277010_SCH_C
Loop Sheets	SI760005_DWG_A
MCC Drawing	SI478006_DWG_H

### 2.1 Scope of Work – No2 Switchroom

Modifications and tie ins to MCC compartments B2E & B2F.

### 2.2 Scope of Work – Field

Cables and containment to be installed from No.2 switchroom MCC panel to new valve assemblies XV60103, XV60203 & XV60303. Valve assemblies will be mechanically installed by others. Air lines to be installed from air header within 10 meters of the valves. JB4/89 is existing, contractor to modify or replace.

Note - 24Vdc power in JB4/89 from No4 switchroom SIS logic panel, contractor to apply relevant warning label and comply with SIS modification procedures.

### 2.3 Contractor Supplied Equipment

The contractor shall supply and install the following equipment. All equipment shall be suitably rated for the environment in which it is to be installed (site hazardous area drawing available on request). Where not fully specified, equipment shall conform with normal site standards for similar installations.

#### ROSOV Local Controls

- 3 off Pneumatic Open/Close Stations
- 1 off JB4/89 See section 2.2

#### Switchroom Equipment

- 1 off PILZ PNOZ s2 Safety relay.
- Terminals & Fuses

### 2.4 Free Issue Equipment

No Free Issue equipment.



## Appendix I

### Drawings

SI760005\_DWG\_A  
SI478006\_DWG\_H




600 SERIES TANK FARM

SAFE AREA


TANK 601 RAIL LOADING VALVE XV60103

JB4/89  
TANK ISOLATION PUSHBUTTON JUNCTION BOX



No.2 SWITCHROOM - MCC COMPARTMENT B2F

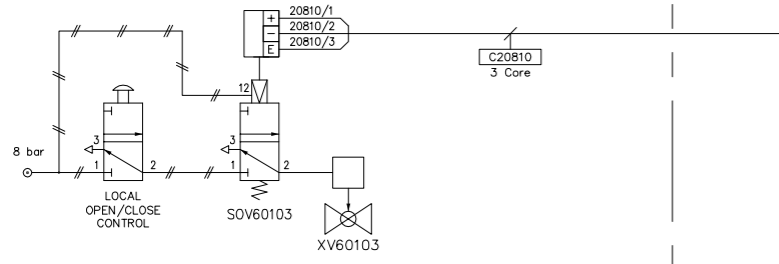


TANK 602 RAIL LOADING VALVE XV60203

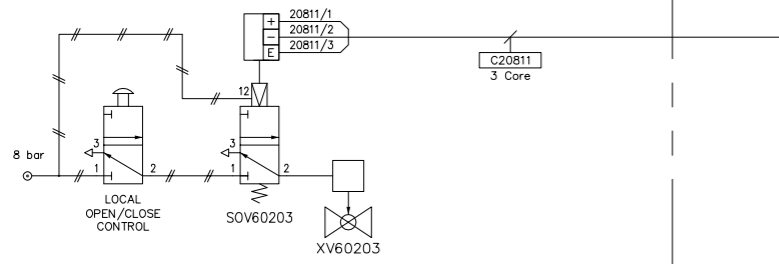

TANK 603 RAIL LOADING VALVE XV60303

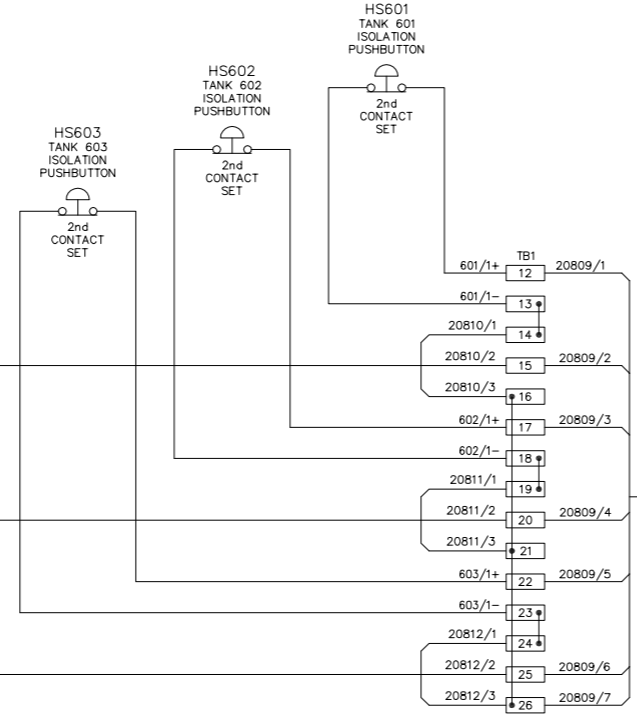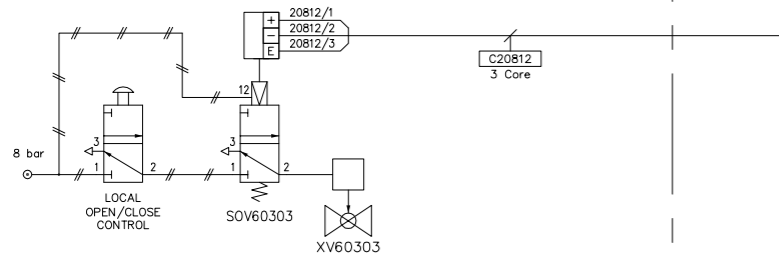

**NOTE**  
PUSHBUTTON CONTACT SET 1 IS FED FROM No.4 SWITCHROOM AND IS PART OF THE SIS SYSTEM

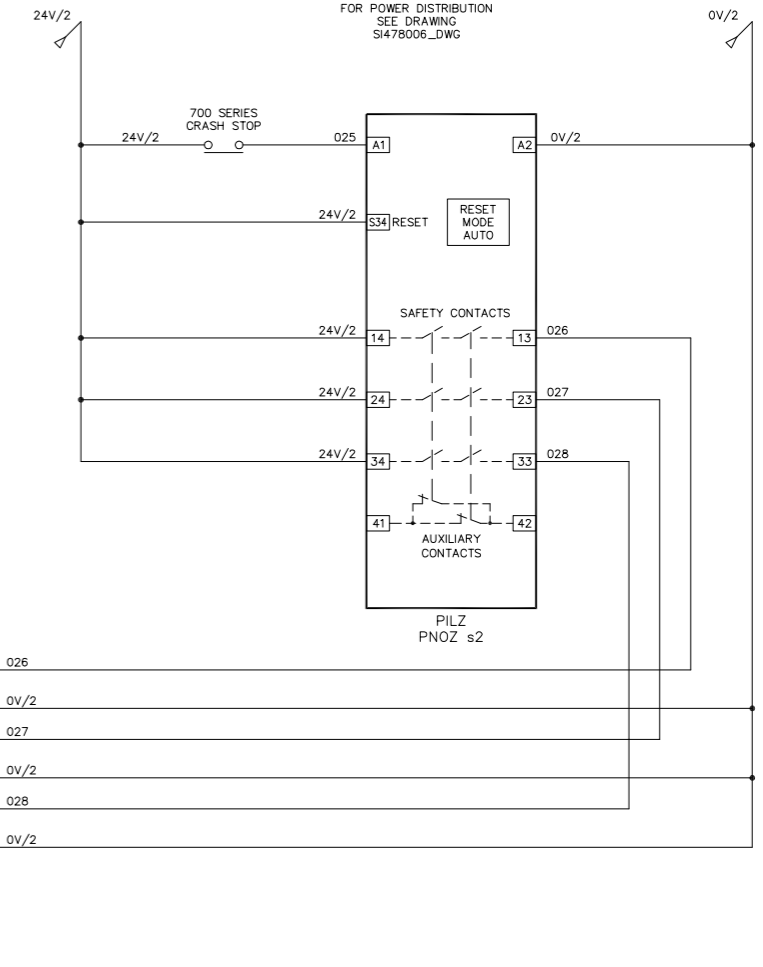

NOTES  
1)



REV	DATE	BY	DRN	CHK'D	APP'D	DESCRIPTION
A	30/11/10	P.P.	P.P.	D.B.F	M.M.	ISSUED FOR CONSTRUCTION

PLANT	IMMINGHAM STORAGE Co. - EAST TERMINAL
TITLE	4-EAST RAIL LOADING SYSTEM TANK 601, 602 & 603 RAIL LOADING VALVE LOOP SHEET
CLIENT DRG. No.	P&I DRG No. SI760005_DWG




IMMINGHAM STORAGE Co. Ltd.  
IMMINGHAM EAST TERMINAL,  
IMMINGHAM DOCK,  
IMMINGHAM,  
SOUTH HUMBERSIDE  
Tel. 01642 617444  
www.pidesign.co.uk

SHEET 1 OF 1



No.2 SWITCHROOM - MCC COMPARTMENT B2E

FIELD

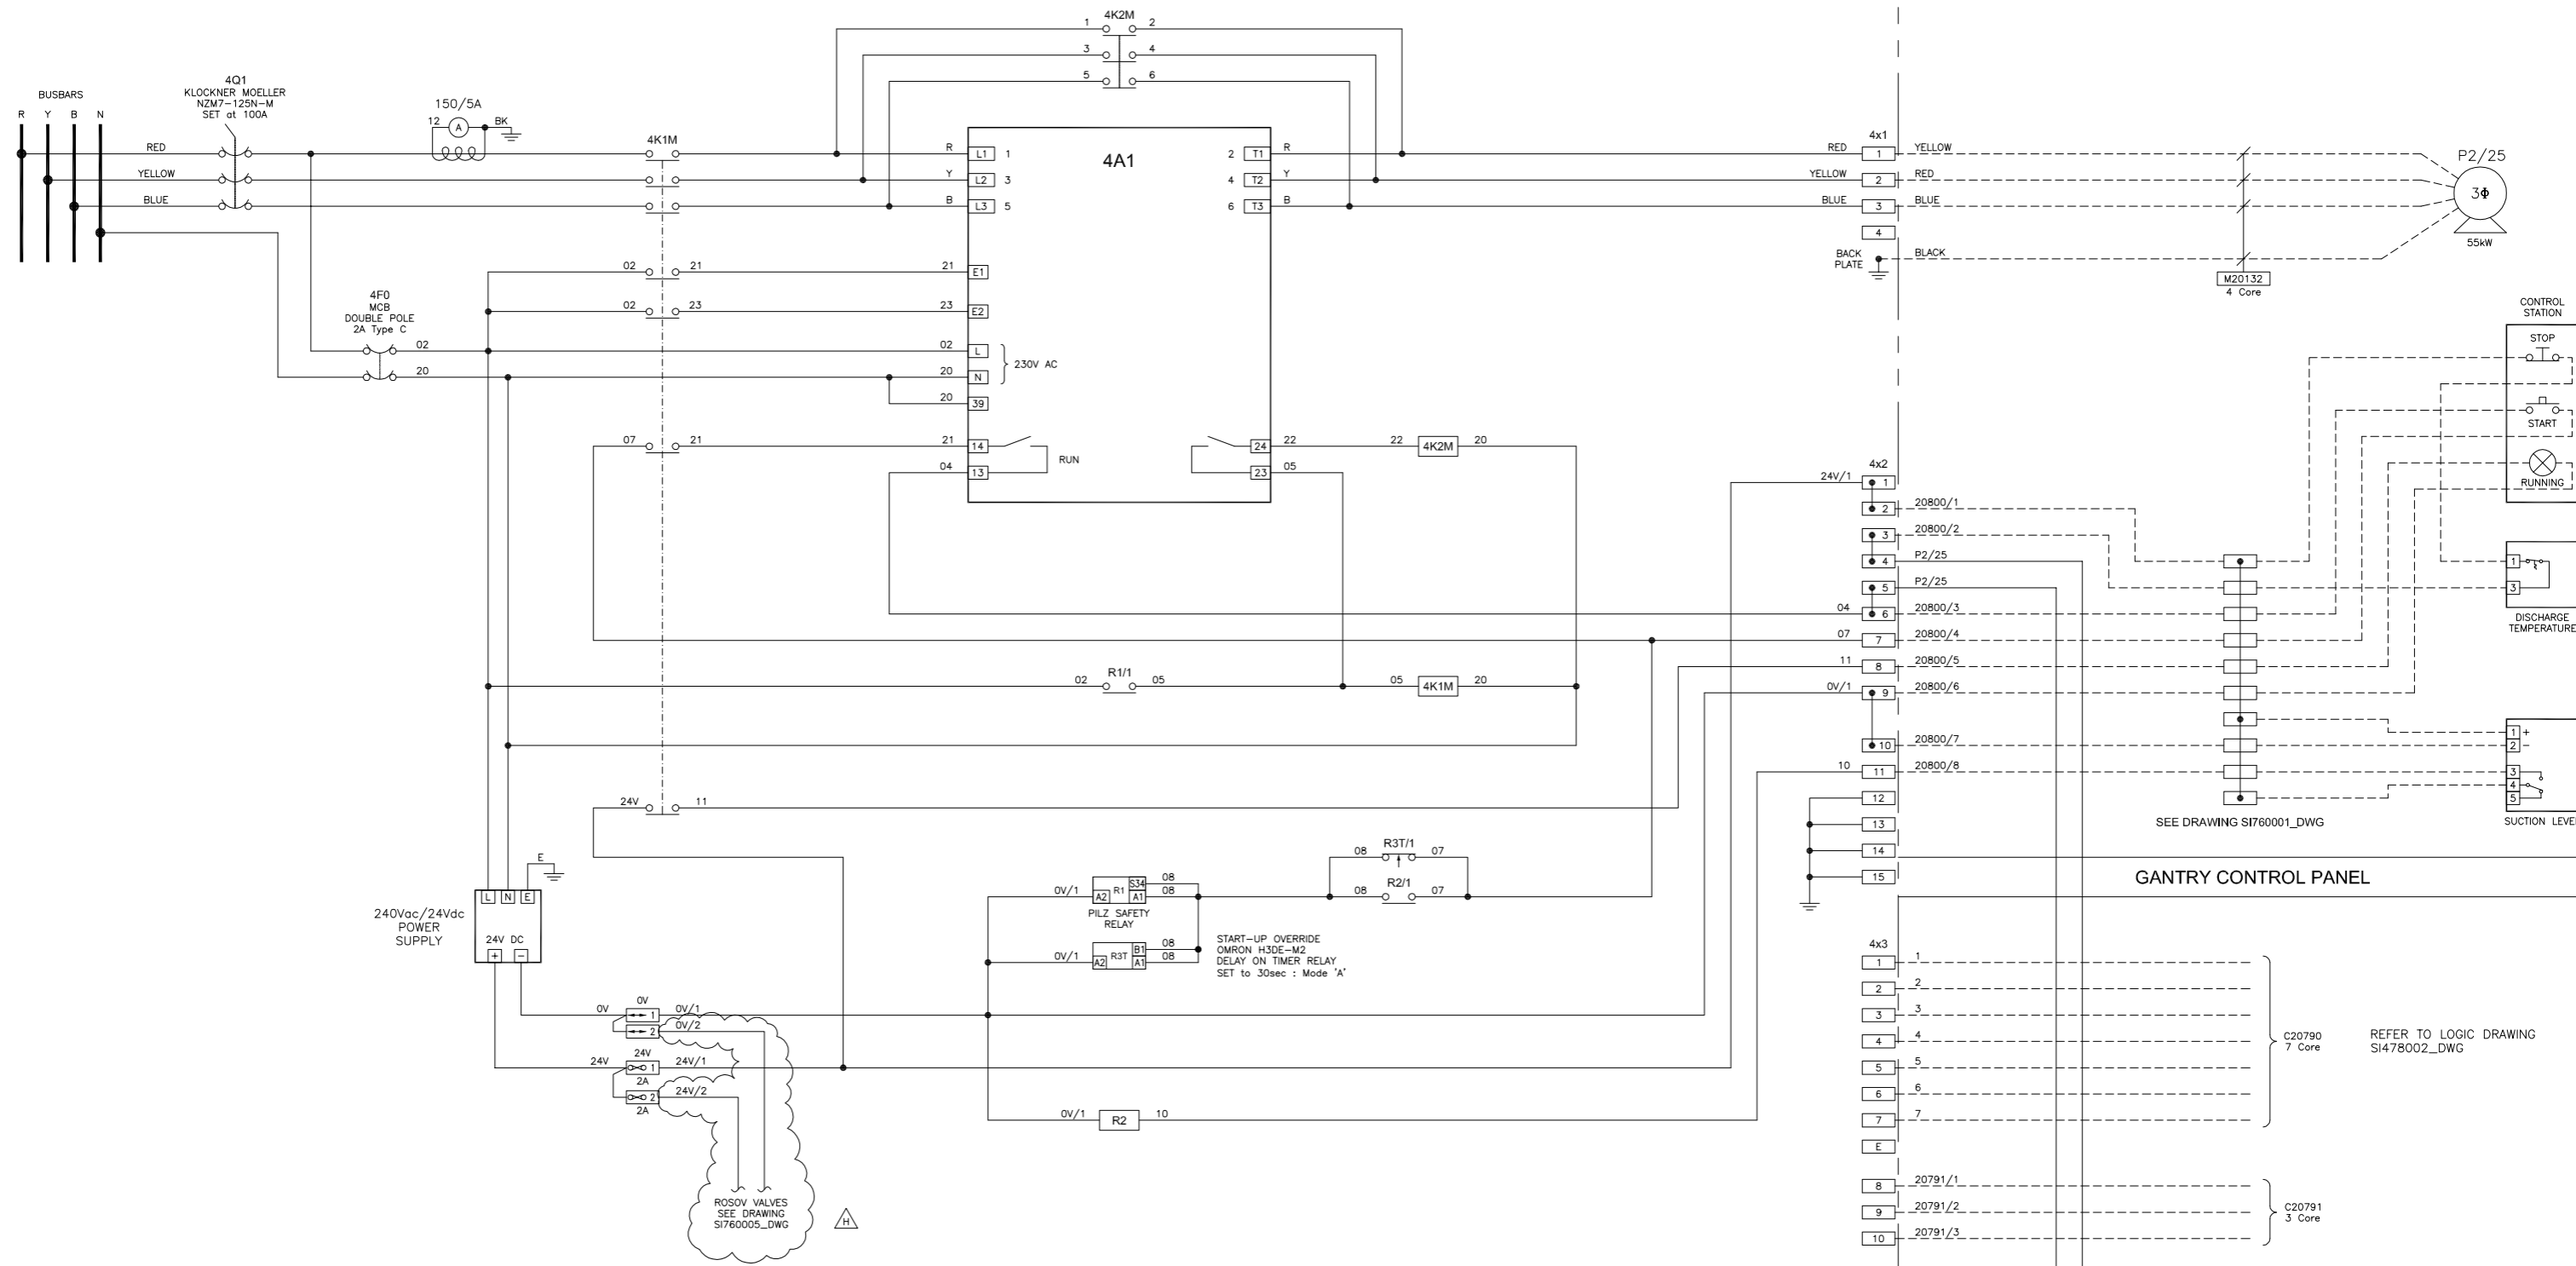

No.2 SWITCHROOM - MCC COMPARTMENT B2F

- NOTES
- 1) JETTY STOP – RELAY ENERGIZED TO STOP DRIVE.
  - 2) THIS DRAWING REPLACES SITE DRAWING SPW-03-688.DWG



REV	DATE	BY	DRN	CHK'D	APP'D	DESCRIPTION	REV	DATE	BY	DRN	CHK'D	APP'D	DESCRIPTION	
H	30/11/10	P.P.	P.P.	D.B.F	M.M.	ROSOV VALVE POWER ADDED	A	10/12/98	A.J.H	A.J.H	D.R.R	D.R.R	D.R.R	ORIGINAL ISSUE
							B	19/01/99	A.J.H	A.J.H	D.R.R	D.R.R	D.R.R	GENERAL UPDATE
							C	01/02/99	A.J.H	A.J.H	D.R.R	D.R.R	D.R.R	SOFT START CHANGED
							D	17/03/99	A.J.H	A.J.H	D.R.R	D.R.R	D.R.R	PANEL TEST MODS.
							E	23/06/00	M.M.	A.B.	D.R.R	D.R.R	D.R.R	SOFT START MODS.
							F	19/10/10	P.P.	P.P.	D.B.F	D.R.R	M.M.	COMPARTMENT RE-WIRED
							G	28/10/10	P.P.	P.P.	D.B.F	D.R.R	M.M.	PUMP CONTROLS REVISED

IF NOT SIGNED THIS DOCUMENT IS UNCONTROLLED		PLANT	IMMINGHAM STORAGE Co. – EAST TERMINAL
TITLE	P2/25 PUMP MCC DIAGRAM		
			P&I Design Ltd Tel: 01642 617444 www.pidesign.co.uk
CLIENT DRG. No.	SHEET 1 OF 1		
	P&I DRG No. SI478006_DWG		

## Appendix II

### Schedules & Specifications

SI760002\_SCH\_A  
SI277010\_SCH\_C



# INSTRUMENT/ELECTRICAL CABLE SCHEDULE

CABLE		CONDUCTORS		CABLE ROUTE				APPROX. LENGTH METRES	REMARKS
REFERENCE	TYPE	AREA mm <sup>2</sup>	No.	FROM	GLAND TYPE	TO	GLAND TYPE		
C20809	J07	1.5	7 Core	No.2 Switchroom MCC Compartment B2F	ATEX II 2 G EExed	JB4_89 Tank Isolation Pushbutton Junction Box	ATEX II 2 G EExed	100	Note 2
C20810	J03	1.5	3 Core	JB4_89 Tank Isolation Pushbutton Junction Box	ATEX II 2 G EExed	Tank 601 Rail Loading Valve - XSV60103 Soleniod	ATEX II 2 G EExed	220	
C20811	J03	1.5	3 Core	JB4_89 Tank Isolation Pushbutton Junction Box	ATEX II 2 G EExed	Tank 602 Rail Loading Valve - XSV60203 Soleniod	ATEX II 2 G EExed	190	
C20812	J03	1.5	3 Core	JB4_89 Tank Isolation Pushbutton Junction Box	ATEX II 2 G EExed	Tank 603 Rail Loading Valve - XSV60303 Soleniod	ATEX II 2 G EExed	160	
<b>TOTAL</b>								670	

**NOTES:**

1) Refer to P&I Design Cable Specifications for details on Cable Type. 2) Cables to be relocated to ROSOV Control Panel in future, allow spare length.

- Denotes Cable Modified
- Denotes Cable Deleted
- Denotes Cable Added
- Future Cables

*IF NOT SIGNED THIS DOCUMENT IS UNCONTROLLED*

REV	DATE	BY	DRN	CHK'D	APP'D	DESCRIPTION	PLANT	TITLE
A	30/11/10	DBF	DBF	MM	MM	Issued for Construction	Immingham East - 2 East	600 Series ROSOVs Cable Schedule



FIELD							JB4/89					SWITCHROOM 4 - TANK OVERFILL MONITORING PANEL (SIS)											
FIELD INSTRUMENT	TERMINAL No.	CABLE DETAILS					TERMINAL No.	JUNCTION BOX DETAILS					TERMINAL No.	PANEL TERMINATION DETAILS					INST. TERMINAL No.	INST. LOOP DIAGRAM	REMARKS		
		CABLE No.	TYPE	CORE No.	FERRULE No.	LENGTH METRES		CABLE No.	TYPE	CORE No.	FERRULE No.	LENGTH METRES		CABLE No.	TYPE	CORE No.	FERRULE No.	LENGTH METRES					
							<b>TB1</b>																
<b>HS601</b>	12		1 Core		601+		1	X40358	E05	Pr 1+	40358/1+		<b>TB3</b>	27									
	11		1 Core		601-		2			Pr 1-	40358/1-			28								Tank 601 Isolation	
<b>HS602</b>	12		1 Core		602+		3			Pr 2+	40358/2+			29									Tank 602 Isolation
	11		1 Core		602-		4			Pr 2-	40358/2-			30									Tank 602 Isolation
<b>HS603</b>	12		1 Core		603+		5			Pr 3+	40358/3+			31									Tank 603 Isolation
	11		1 Core		603-		6			Pr 3-	40358/3-			32									Tank 603 Isolation
							7			Pr 4+	40358/4+		Earth Bar										Spare
							8			Pr 4-	40358/4-		Earth Bar										Spare
							9			Pr 5+	40358/5+		Earth Bar										Spare
							10			Pr 5-	40358/5-		Earth Bar										Spare
							11			SCN	40358/SCN		Earth Bar										Screen

FIELD							JB4/89					SWITCHROOM 2 - 600 SERIES ROSOV CONTROL PANEL												
FIELD INSTRUMENT	TERMINAL No.	CABLE DETAILS					TERMINAL No.	JUNCTION BOX DETAILS					TERMINAL No.	PANEL TERMINATION DETAILS					INST. TERMINAL No.	INST. LOOP DIAGRAM	REMARKS			
		CABLE No.	TYPE	CORE No.	FERRULE No.	LENGTH METRES		CABLE No.	TYPE	CORE No.	FERRULE No.	LENGTH METRES		CABLE No.	TYPE	CORE No.	FERRULE No.	LENGTH METRES						
							<b>TB1</b>						<b>TB1</b>											
<b>HS601</b>	22		1 Core		601/1+		12	C20809	J07	Core 1	20809/1		1											Tank 601 Solenoid +ve
	21		1 Core		601/1-		13																	
<b>XSV60103</b>	+	C20910	3 Core	1	20810/1		14																	
	-			2	20810/2		15			Core 2	20809/2		2											Tank 601 Solenoid -ve
	E			3	20810/3		16																	
<b>HS602</b>	22		1 Core		602/1+		17			Core 3	20809/3		3											Tank 602 Solenoid +ve
	21		1 Core		602/1-		18																	
<b>XSV60203</b>	+	C20911	3 Core	1	20811/1		19																	
	-			2	20811/2		20			Core 4	20809/4		4											Tank 602 Solenoid -ve
	E			3	20811/3		21																	
<b>HS603</b>	22		1 Core		603/1+		22			Core 5	20809/5		5											Tank 603 Solenoid +ve
	21		1 Core		603/1-		23																	
<b>XSV60303</b>	+	C20912	3 Core	1	20812/1		24																	
	-			2	20812/2		25			Core 6	20809/6		6											Tank 603 Solenoid -ve
	E			3	20812/3		26			Core 7	20809/7		Earth Bar											Earth

*IF NOT SIGNED THIS DOCUMENT IS UNCONTROLLED*

ABBREVIATIONS	REFERENCE DRAWINGS	REV	DATE	BY	DRN	CHECKED	APPROVED	DESCRIPTION	PLANT	ISCO EAST - TANK OVERFILL SIS	
Revision C Modifications	SI277120_DWG	A	27/03/08	P.P.	P.P.	D.S.R	D.S.R	Issued for Tender	TITLE	JB4/89 TANK ISOLATION PUSHBUTTON J/B CONNECTION SCHED.	
	SI277121_DWG	B	24/04/08	P.P.	P.P.	D.S.R	D.S.R	Issued for Construction			
	SI277122_DWG	C	30.11.10	DBF	DBF	MM	MM	Issued for Construction			
	SI277123_DWG										
	SI277124_DWG										
	SI277125_DWG										
	SI760005_DWG								CLIENT DRG No.		SHEET 1 OF 1



# P & I Design Ltd

Process Instrumentation Consultancy & Design

2 Reed Street, Gladstone Industrial Estate  
Thornaby, TS17 7AF.

Tel: +44 (0) 1642 617444 Fax: +44 (0) 1642 616447  
Website: www.pidesign.co.uk

## Instrument Calibration Certificate

Certificate Number: **LS2-25-0**

<b>Client:</b>	Immingham Storage Co. Ltd	<b>Tag No:</b>	LS2-25	<b>Date:</b>	12/10/2010
<b>Location:</b>	Simon Terminals	<b>Service:</b>	Pump Dry Run Protection		
<b>Manufacturer:</b>	Endress & Hauser	<b>Model No:</b>	FTL51-IAE2JB(200mm)4G7A	<b>Serial No:</b>	DA00BC01027
<b>Job No:</b>	760	<b>Type:</b>	Vibronic Level Switch	<b>Asset No:</b>	

<u>Cap No</u>	<u>Serial No</u>	<u>Test Equipment</u>	<u>Traceability Certificate No.</u>
1 022	90810090	Digital Multimeter	INLB54191
2			
3			
4			

Test Equipment Traceable to NPL Standards.

### Calibration Details

Input: \_\_\_\_\_ to \_\_\_\_\_ units      Output: \_\_\_\_\_ to \_\_\_\_\_ units

Square Root Extraction

Required Accuracy: \_\_\_\_\_ %

Rising Inputs				Falling Inputs			
Input	Output		%Error FSD	Input	Output		%Error FSD
	Desired	Actual			Desired	Actual	

Remarks

Adjustments Made

Calibration Failed

Function checked by immersion in water.

Switch settings MIN and 0.7

Calibration Frequency: 12 (Months)

Next Calibration: 12/10/2011

Calibrated By: A.Newton



Witnessed By:

Document QSF216  
Issue: A Date: 03.03.98  
Page 1 of 1



# ARMMAH Switchgear Ltd.

**A Powerful Force Protecting Supplies**

7 Parsons Road, Parsons Industrial Estate, District 2, Washington, Tyne & Wear NE37 1EZ  
 Telephone: (0191) 419 2000 Fax: (0191) 419 1000

## TEST CERTIFICATE

<b>CUSTOMER</b>	P & I DESIGN		
<b>ORDER No.</b>	039/6169		
<b>WORKS REF.</b>	C861A		
<b>DRAWING No.</b>	S1039016		
<b>DESCRIPTION</b>	FINA DERV RAIL LOADING SYSTEM LOGIC PANEL		
<b>SUPPLY VOLTAGE</b>	240V 50Hz	<b>CONTROL VOLTAGE</b>	24Vdc
<b>PHYSICAL INSPECTION</b>	R Hewitson	<i>R A Hewitson</i>	
<b>REMARKS</b>	Panel in unmarked condition		
<b>INSTRUMENTATION</b>	N/A		
<b>OPERATIONAL TEST</b>	All safety circuits operated		
	All I/O operated		
<b>REMARKS</b>	All connections checked for tightness		
<b>INSPECTED / DATE</b>	R Hewitson	<i>R A Hewitson</i>	17/05/1999
<b>WITNESSED</b>	D Pearson	<i>D Pearson</i>	17/05/1999
<b>TESTED / DATE</b>	R Hewitson	<i>R A Hewitson</i>	17/05/1999
<b>FINAL REMARKS</b>	Panel passed final inspection prior to delivery		



# ARMMAH Switchgear Ltd.

**A Powerful Force Protecting Supplies**

7 Parsons Road, Parsons Industrial Estate, District 2, Washington, Tyne & Wear NE37 1EZ  
Telephone: (0191) 419 2000 Fax: (0191) 419 1000

## TEST CERTIFICATE

<b>CUSTOMER</b>	P & I DESIGN		
<b>ORDER No.</b>	039/6169		
<b>WORKS REF.</b>	C861B		
<b>DRAWING No.</b>	S1039009		
<b>DESCRIPTION</b>	DERV OFF LOADING PUMP 1 MCC		
<b>SUPPLY VOLTAGE</b>	3Ph & N 50Hz	<b>CONTROL VOLTAGE</b>	240Vac
<b>PHYSICAL INSPECTION</b>	R Hewitson	<i>R A Hewitson</i>	
<b>REMARKS</b>	Panel in unmarked condition		
<b>INSTRUMENTATION</b>	N/A		
<b>OPERATIONAL TEST</b>	Full operational test carried out		
<b>REMARKS</b>	All connections checked for tightness		
<b>INSPECTED / DATE</b>	R Hewitson	<i>R A Hewitson</i>	17/05/1999
<b>WITNESSED</b>	D Pearson	<i>D Pearson</i>	17/05/1999
<b>TESTED / DATE</b>	R Hewitson	<i>R A Hewitson</i>	17/05/1999
<b>FINAL REMARKS</b>	Panel passed final inspection prior to delivery		

<b>CLIENT: ISCo East</b>	<b>PROJECT REF: PO100</b>	<b>DOC REF: PO100001_HDR</b>
<b>PROJECT: Mabanft Rail Loading</b>	<b>LOCATION: Immingham East</b>	<b>DATE: 26/08/10</b>
<b>PLANT SECTION: 4 East</b>	<b>PLANT UNIT: Rail Loading</b>	<b>PAGE: 1 OF 1</b>

**This certificate covers the functional testing of the following Equipment :-**

All loading arm actuated valves function tested and found to physically open and close, air lines blown clear prior to testing. The following systems had the faults listed –

- XSV2 – Solenoid valve grub screw U/S.
- XSV3 - Solenoid valve grub screw U/S, solenoid terminal block corroded.
- XSV4 – Solenoid U/S.
- XSV5 – Solenoid terminal block corroded.
- XSV6 – Solenoid valve grub screw U/S. Air supply line leak.
- XSV7 – Solenoid terminal block corroded.
- XSV8 – Solenoid valve grub screw U/S. No internal inspection carried out.
- XSV9 – Solenoid valve grub screw U/S.
- XSV11 – Solenoid terminal block corroded.
- XSV12 – Solenoid U/S.

All rail car high level float switches function tested. The following systems had the faults listed –

All floats require cleaning, 3off found to be initially stuck when immersed in water.

Switch 3 U/S

Switches 1, 2, 3, 6, 7 & 9 all found to have water ingress in JB, water drained and dried.

Switch 6 needs physical repair to protection tube.

Switches 2 & 4 only have 2 locating screws in protection tube.

All switches left at ground level.


All gantry ESD pushbuttons function tested, no faults found.

All gantry control panel lamps and pushbuttons (lamp test, horn silence etc) function tested, no faults found.

Gantry horn function tested and found correct.

**Approvals**

P & I DESIGN LTD: D.B.Faulkner

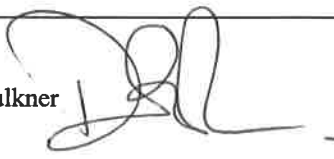

DATE: 26.08.10

CLIENT:

DATE: