


HAMMONDS NORTH


823 HAMMONDS FERRY RD
SUITE A-J
LINTHICUM, MD 21090

Building Key Plan

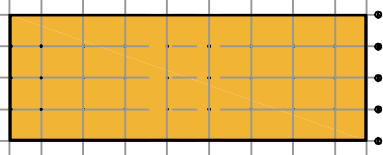

TOTAL SF AVAILABLE - 40,800 SF
OFFICE - 7,222 SF
WAREHOUSE SF - 33,578 SF

LOADING

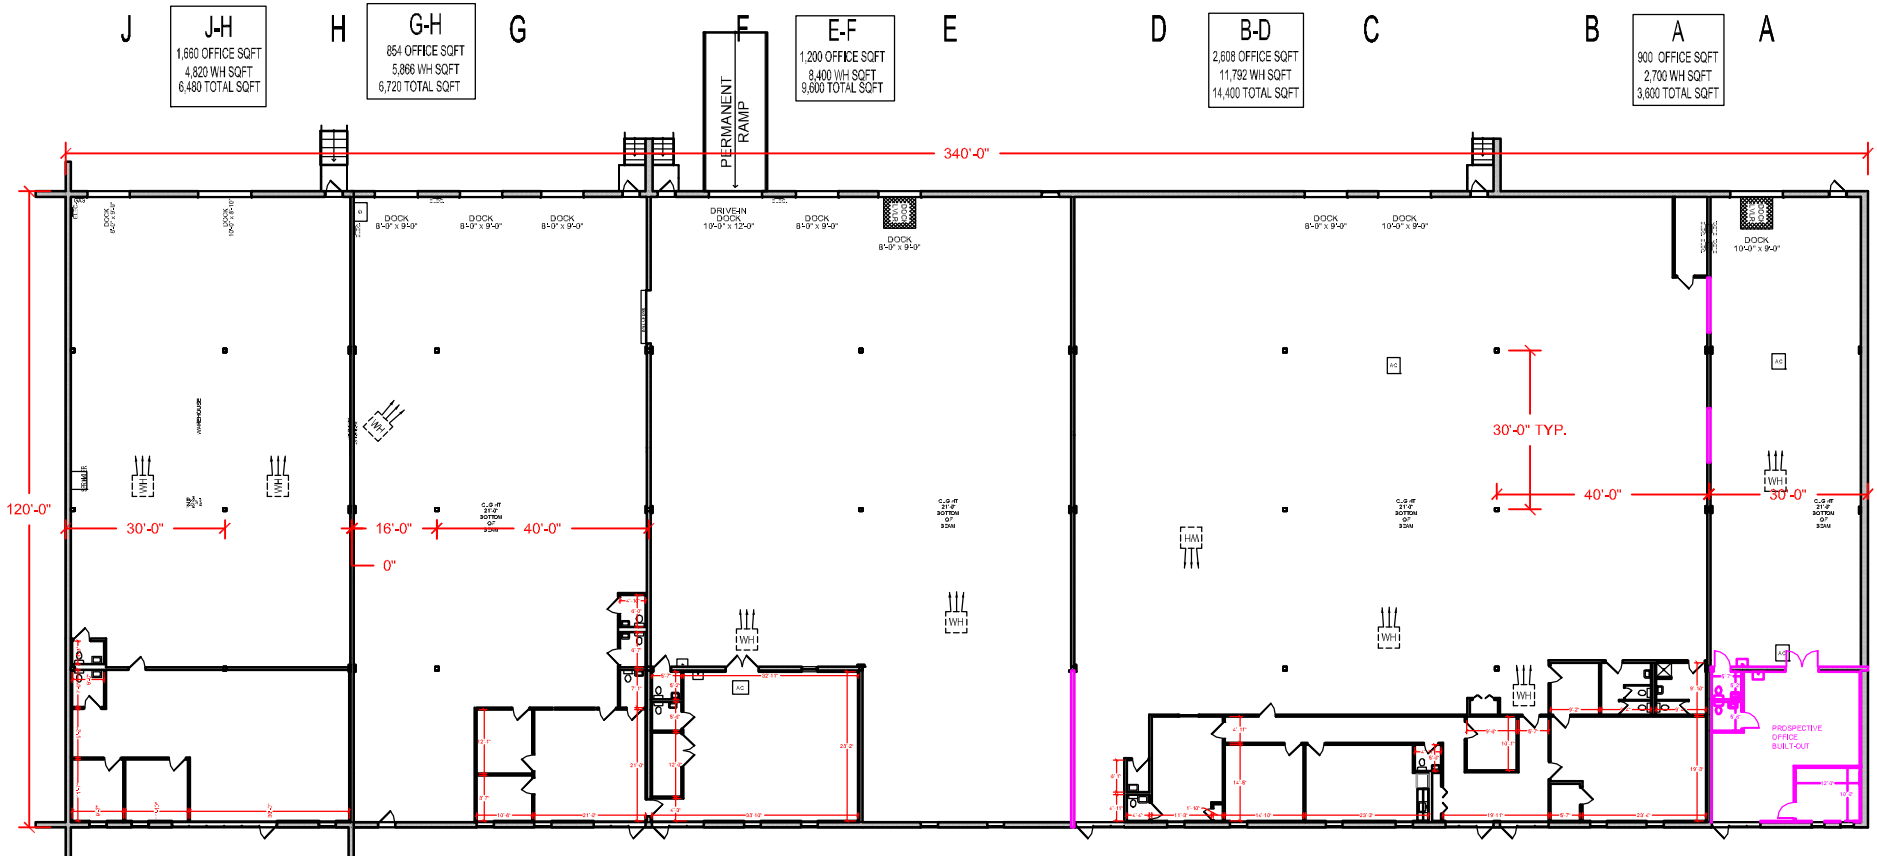

PLAN NOT TO SCALE - THIS IS NOT A CONSTRUCTION DOCUMENT

DRAWING #: MP1-823-A-J

ASBUILT DATE:

A Development of Merritt Properties

410.298.2600 / MerrittProperties.com